

STRIP FOOTINGS -

FOR SINGLES & SEMIS UP TO 2 STOREY

8" OR 10" FOUNDATION WALLS WITH 2"x8" / 2"x10" FLOOR JOISTS
20"x6" CONCRETE STRIP FOOTINGS BELOW FOUNDATION WALLS.
24"x8" CONCRETE STRIP FOOTINGS BELOW PARTY WALLS.

FOUNDATION WALLS WITH ENGINEERED JOISTS OVER 16' SPANS
24"x8" CONCRETE STRIP FOOTINGS BELOW FOUNDATION WALLS.

FOOTINGS ON ENGINEERED FILL

24"x8" CONCRETE STRIP FOOTINGS WITH REINFORCING
BELOW EXTERIOR WALLS.

30"x8" CONCRETE STRIP FOOTINGS WITH REINFORCING
BELOW PARTY WALLS.

(REFER TO FOOTING DETAILS ON ENGINEERED FILL)

ASSUME THE LARGER FOOTING SIZE
WHEN TWO CONDITIONS APPLY

ASSUMED 120 KPa (18 p.s.f.) SOIL BEARING CAPACITY OR 90 KPa
ENGINEERED SOIL FILL, TO BE VERIFIED ON SITE.

PAD FOOTINGS

120 KPa NATIVE SOIL

F1 = 42"x42"x18" CONCRETE PAD
F2 = 36"x36"x18" CONCRETE PAD
F3 = 30"x30"x12" CONCRETE PAD
F4 = 24"x24"x12" CONCRETE PAD
F5 = 16"x16"x8" CONCRETE PAD

30 KPa ENGINEERED FILL SOIL

F1 = 48"x48"x20" CONCRETE PAD
F2 = 40"x40"x16" CONCRETE PAD
F3 = 34"x34"x14" CONCRETE PAD
F4 = 28"x28"x12" CONCRETE PAD
F5 = 18"x18"x8" CONCRETE PAD

(REFER TO FLOOR PLAN FOR UNUSUAL SIZE PADS NOT ON CHART)

WHEN VENEER CUT IS GREATER THAN 26" A 10" POURED CONC.
FOOTING WALL IS REQUIRED.

ALL GARAGE SLABS, PORCH SLABS, STAIRS (EXPOSED CONC.
FLAT WORK) TO BE 32 MPa WITH 5-8% AIR ENTRAINMENT

BRICK VENEER LINTELS

ML1 = 3-1/2"x3-1/2"x1/4" (100x90x10) + 2-2"x8" SPR. No.2
ML2 = 4"x3-1/2"x1/4" (100x90x10) + 2-2"x8" SPR. No.2
ML3 = 5"x3-1/2"x1/4" (125x90x10) + 2-2"x10" SPR. No.2
ML4 = 6"x3-1/2"x1/4" (150x90x10) + 2-2"x12" SPR. No.2
ML5 = 6"x4"x3/8" (150x100x10) + 2-2"x12" SPR. No.2
ML6 = 5"x3-1/2"x1/4" (125x90x10) + 2-2"x12" SPR. No.2
ML7 = 5"x3-1/2"x1/4" (125x90x10) + 3-2"x10" SPR. No.2
ML8 = 5"x3-1/2"x1/4" (125x90x10) + 3-2"x12" SPR. No.2
ML9 = 6"x4"x3/8" (150x100x10) + 3-2"x12" SPR. No.2

WOOD LINTELS AND BEAMS

WB1 = 2-2"x8" SPR. No.2 (2-38x104 SPR. No.2)
WB2 = 3-2"x8" SPR. No.2 (3-38x104 SPR. No.2)
WB3 = 2-2"x10" SPR. No.2 (2-38x125 SPR. No.2)
WB4 = 3-2"x10" SPR. No.2 (3-38x125 SPR. No.2)
WB5 = 2-2"x12" SPR. No.2 (2-38x146 SPR. No.2)
WB6 = 3-2"x12" SPR. No.2 (3-38x146 SPR. No.2)
WB7 = 3-2"x12" SPR. No.2 (3-38x146 SPR. No.2)
WB8 = 4-2"x10" SPR. No.2 (4-38x125 SPR. No.2)
WB9 = 4-2"x12" SPR. No.2 (4-38x146 SPR. No.2)

LAMINATED VENEER LUMBER (LVL) BEAMS

LVL1A = 1-1 3/4" x 7 1/4" (1-45x184)
LVL1 = 2-1 3/4" x 7 1/4" (2-45x184)
LVL2 = 3-1 3/4" x 7 1/4" (3-45x184)
LVL3 = 4-1 3/4" x 7 1/4" (4-45x184)
LVL4A = 1-1 3/4" x 9 1/2" (1-45x240)
LVL4 = 2-1 3/4" x 9 1/2" (2-45x240)
LVL5 = 3-1 3/4" x 9 1/2" (3-45x240)
LVL5A = 4-1 3/4" x 9 1/2" (4-45x240)
LVL6A = 1-1 3/4" x 11 1/8" (1-45x300)
LVL6 = 2-1 3/4" x 11 1/8" (2-45x300)
LVL7 = 3-1 3/4" x 11 1/8" (3-45x300)
LVL7A = 4-1 3/4" x 11 1/8" (4-45x300)
LVL8 = 2-1 3/4" x 14" (2-45x356)
LVL9 = 3-1 3/4" x 14" (3-45x356)
LVL10 = 4-1 3/4" x 14" (4-45x356)

LOOSE STEEL LINTELS

L1 = 3-1/2"x3-1/2"x1/4" (100x90x10)
L2 = 4"x3-1/2"x1/4" (100x90x10)
L3 = 5"x3-1/2"x1/4" (125x90x10)
L4 = 6"x3-1/2"x1/4" (150x90x10)
L5 = 6"x4"x3/8" (150x100x10)
L6 = 7"x4"x3/8" (175x100x10)

DOOR SCHEDULE


1 = 2'-10" x 6'-8" (865x2033) - INSULATED ENTRANCE DOOR
1a = 2'-8" x 6'-8" (815x2033) - INSULATED FRONT DOORS
2 = 2'-8" x 6'-8" (815x2033) - WOOD & GLASS DOOR
3 = 2'-8" x 6'-8" x 1-3/4" (815x2033x45) - EXTERIOR SLAB DOOR
4 = 2'-8" x 6'-8" x 1-3/8" (815x2033x35) - INTERIOR SLAB DOOR
5 = 2'-6" x 6'-8" x 1-3/8" (760x2033x35) - INTERIOR SLAB DOOR
6 = 2'-2" x 6'-8" x 1-3/8" (660x2033x35) - INTERIOR SLAB DOOR
7 = 1'-6" x 6'-8" x 1-3/8" (460x2033x35) - INTERIOR SLAB DOOR

SPACE CONVENTIONAL FLOOR JOISTS @ 12"
O.C. BELOW ALL CERAMIC TILE AREAS.
PROVIDE 1 ROW BRIDGING FOR SPANS OF
5'-1", 2 ROWS FOR SPANS GREATER THAN 7'

REFER TO ROOF TRUSS SHOP DRAWINGS FOR
ALL ROOF FRAMING INFORMATION

PLANS NOT DRAWN TO ACTUAL GRADE. REFER
TO FINAL GRADING PLAN.

REFER TO FLOOR FRAMING SHOP DRAWINGS
FOR ENGINEERED FRAMING LAYOUTS

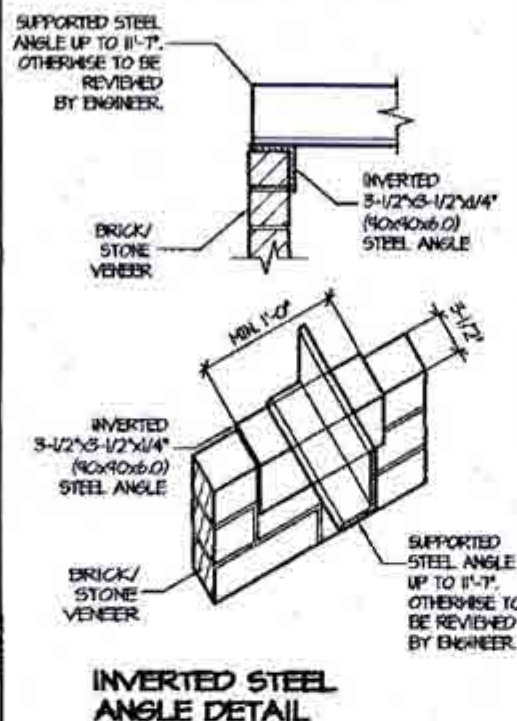

THE MINIMUM THERMAL PERFORMANCE OF BUILDING
ENVELOPE AND EQUIPMENT SHALL CONFORM TO THE
FOLLOWING:

COMPLIANCE PACKAGE "A1"

COMPONENT	NOTE
CEILING WITH ATTIC SPACE MINIMUM RSI (R) VALUE	10.57 (R60)
CEILING WITHOUT ATTIC SPACE MINIMUM RSI (R) VALUE	5.46 (R30)
EXPOSED FLOOR MINIMUM RSI (R) VALUE	5.46 (R30)
WALLS ABOVE GRADE MINIMUM RSI (R) VALUE	3.67 (R22)
BASEMENT WALLS MINIMUM RSI (R) VALUE	3.52 (R20 RIGID)
HEATED SLAB OR SLAB ≤ 600mm BELOW GRADE MINIMUM RSI (R) VALUE	1.76 (R10)
WINDOWS & SLIDING GLASS DOORS MAXIMUM U-VALUE	ENERGY RATING = 25, MAX. U=0.28
SPACE HEATING EQUIPMENT MINIMUM AFUE	92%
HRV MINIMUM EFFICIENCY	75%
HOT WATER TANK	MIN. EF. 0.80

AREA CALCULATIONS

		ELEV. 2
GROUND FLOOR AREA	=	1143 Sq. Ft.
SECOND FLOOR AREA	=	1474 Sq. Ft.
TOTAL FLOOR AREA	=	2617 Sq. Ft.
	=	243.13 Sq. M.
1st FLOOR OPEN AREA	=	0 Sq. Ft.
2nd FLOOR OPEN AREA	=	0 Sq. Ft.
ADD TOTAL OPEN AREAS	=	0 Sq. Ft.
ADD FIN. BASEMENT AREA	=	0 Sq. Ft.
GROSS FLOOR AREA	=	2617 Sq. Ft.
	=	243.13 Sq. M.
GROUND FLOOR COVERAGE	=	1143 Sq. Ft.
GARAGE COVERAGE / AREA	=	353 Sq. Ft.
PORCH COVERAGE / AREA	=	60 Sq. Ft.
TOTAL COVERAGE W/ PORCH	=	1556 Sq. Ft.
	=	144.56 Sq. m.
TOTAL COVERAGE W/O PORCH	=	1496 Sq. Ft.
	=	138.48 Sq. m.

For conventional wood framing
framing shall conform to OBC S.23

All work shall conform to the Ontario
Building Code O. Reg. 332/12 as amended



W Architect Inc.
DESIGN CONTROL REVIEW

NOV 13 2018

FINAL BY: GCTE

This stamp is only for the purposes of design
control and carries no other professional obligations.

It is the builder's complete responsibility to
ensure that all plans submitted for approval
fully comply with the Architectural Guidelines
and all applicable regulations and requirements
including zoning provisions and any provisions
in the subdivision agreement. The Control
Architect is not responsible in any way for
examining or approving site (lotting) plans or
working drawings with respect to any zoning or
building code or permit matter or that any
house can be properly built or located on its lot.

This is to certify that these plans comply
with the applicable Architectural Design
Guidelines approved by the City of
BRAMPTON.

Model
M Plan
18-4113060000
Greenpark Homes
Custom Home



NOV 02 2018

FOR STRUCTURE ONLY

MILLWOOD 12-021

COMPLIANCE PACKAGE "A1"

Greenpark

PROJECT NAME
MINNISALE HOMES CORP.

The undersigned has reviewed and takes responsibility for this
design, and has the qualifications and meets the requirements set
out in the Ontario Building Code to be a designer.

QUALIFICATION INFORMATION
Required unless design is exempt under Division C, Subsection 3.2.5 of the building code

VIKAS GAJJAR
NAME SIGNATURE 28770
BCIN

REGION DESIGN INC.

8700 DUFFERIN ST.

CONCORD, ONTARIO

L4K 4S6

P (416) 736-4096

F (905) 660-0744

REGION
DESIGN
INC.

AREA CHARTS

SCALE 3/16"=1'-0"

BY ZMP

DATE OCT 2018


AREA 2617

CONTRACTOR SHALL CHECK ALL
DIMENSIONS AND ELEVATIONS BEFORE
COMMENCING WITH WORK AND REPORT
ANY DISCREPANCIES TO THE DESIGNER.
PRINTS ARE NOT TO BE SCALED.


PAGE No.

0


REVISIONS	
1. REVISED FOR LOT 21	OCT 2018

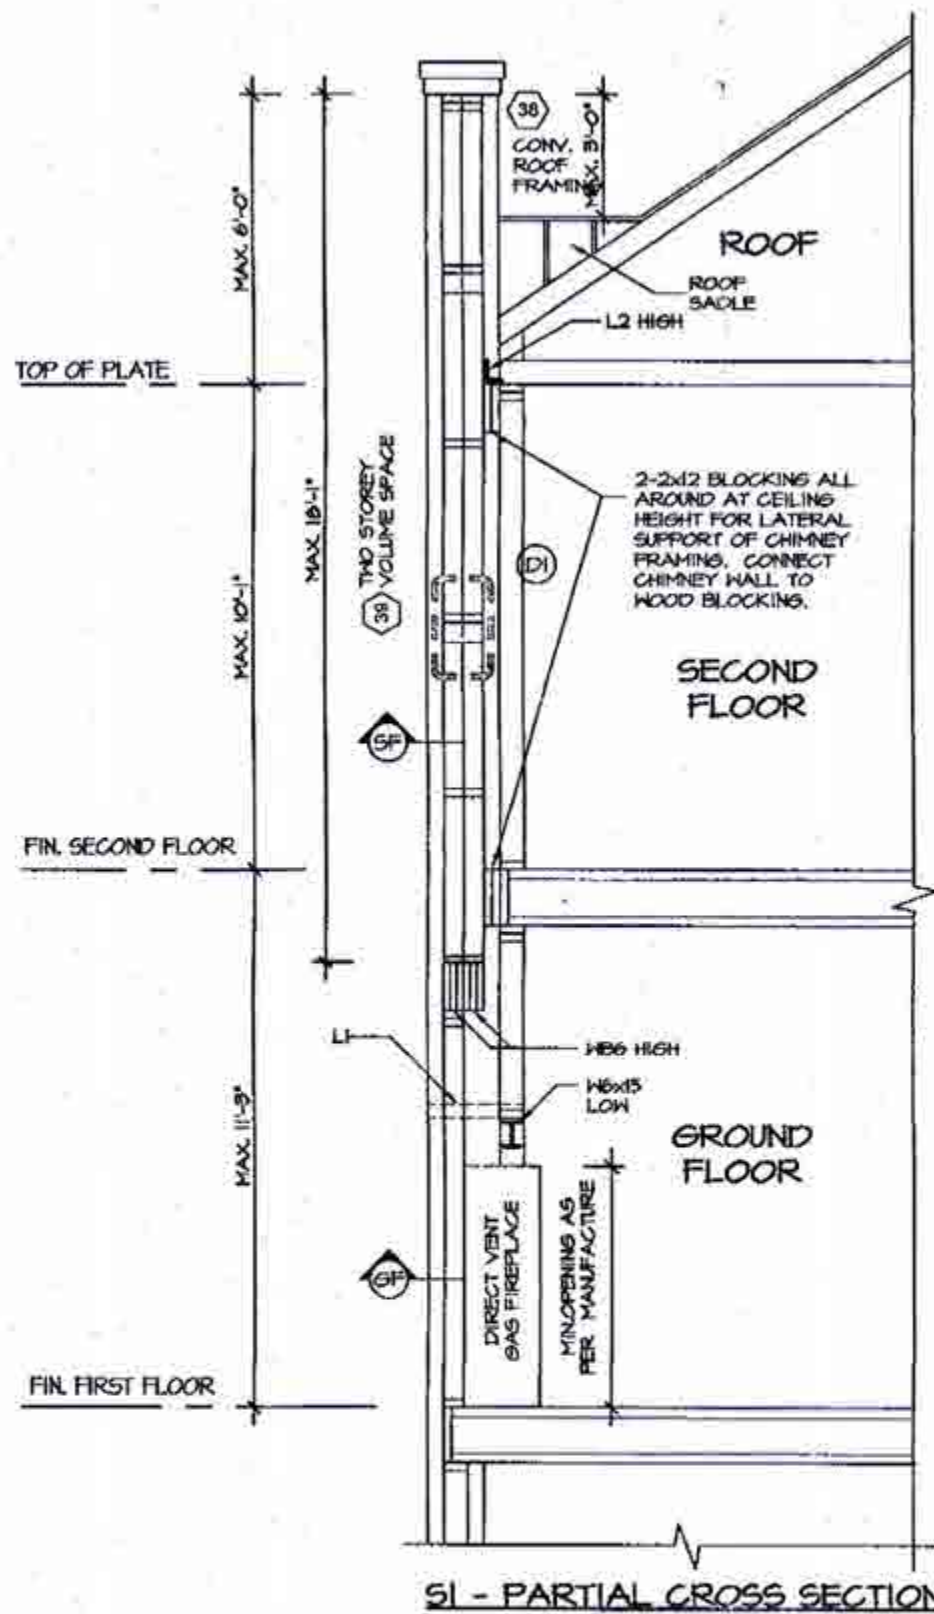


SI - PARTIAL CROSS SECTION

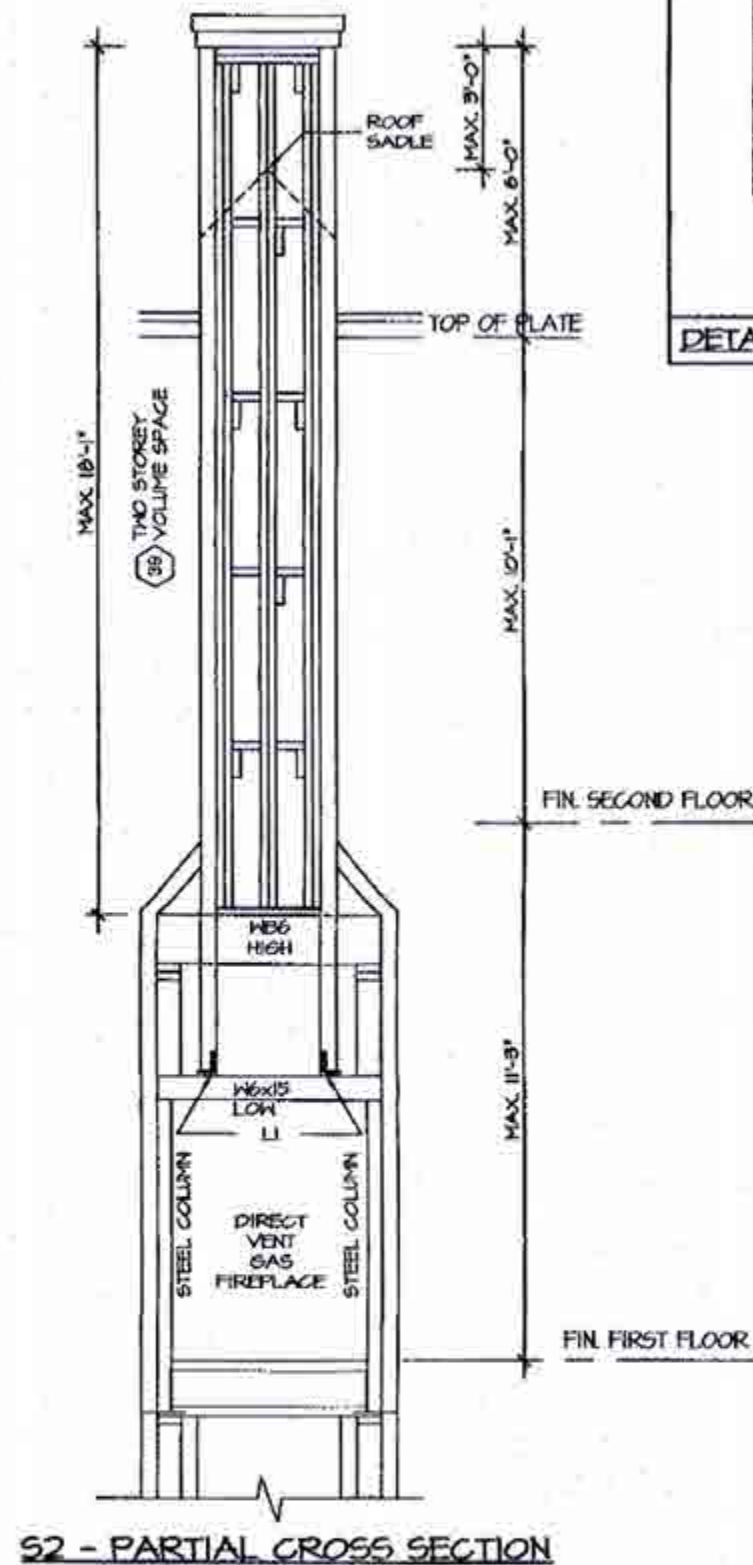

S2 - PARTIAL CROSS SECTION

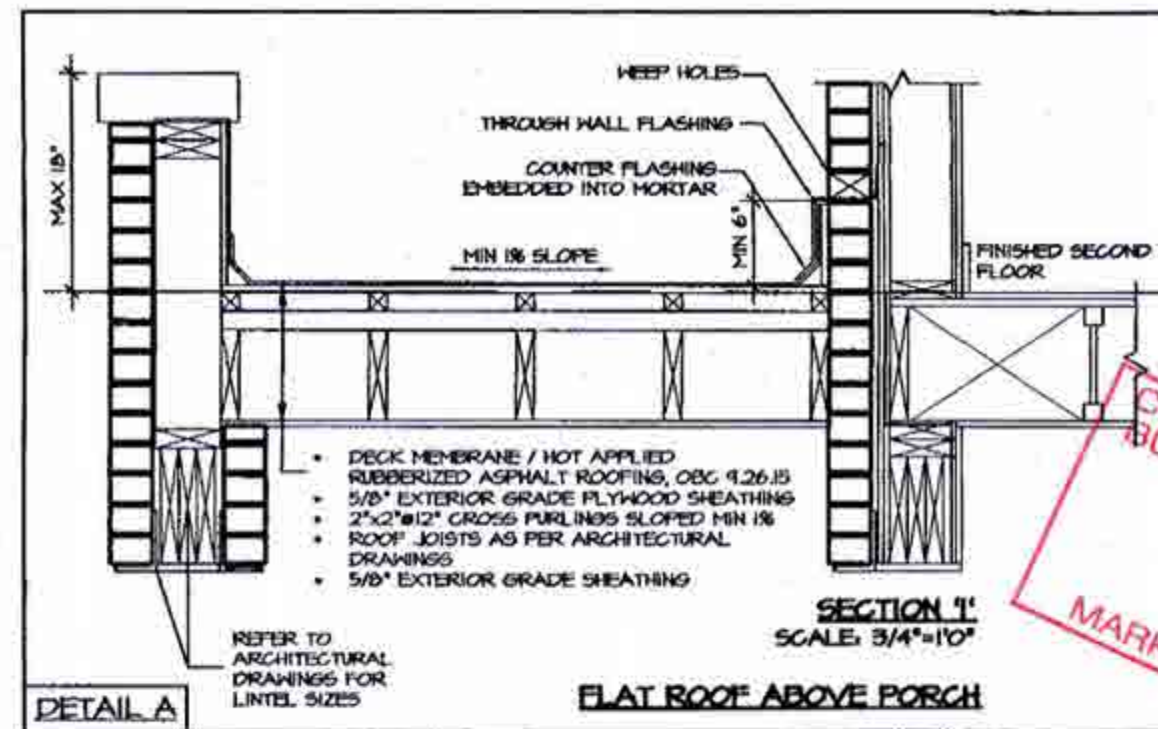

FLAT ROOF ABOVE PORCH

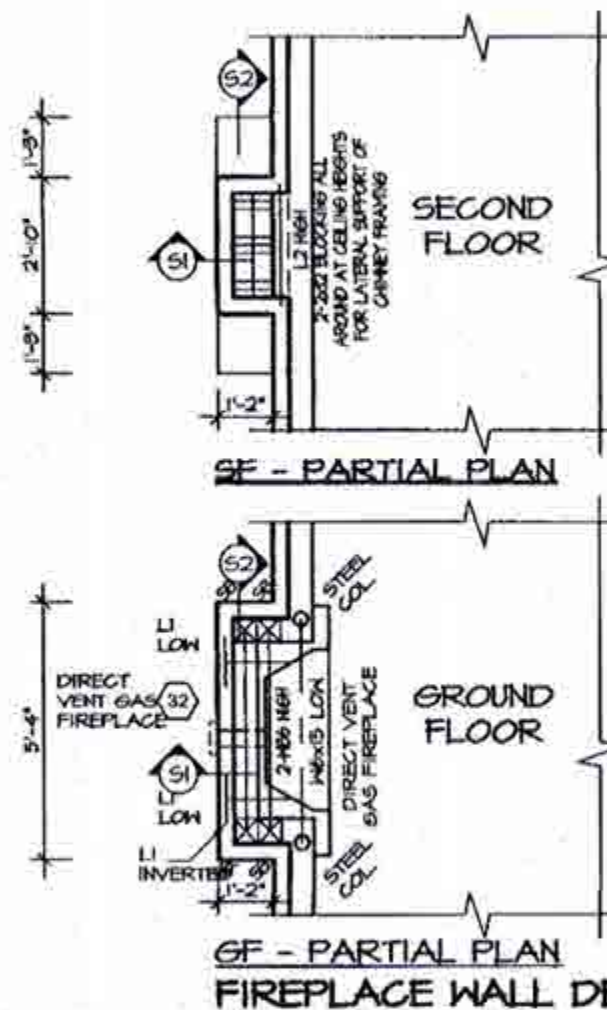

GF - PARTIAL PLAN
FIREPLACE WALL DETAIL

NOTES:

- 32 DIRECT VENT GAS FIREPLACE
DIRECT VENT GAS FIREPLACE.
VENT TO BE A MINIMUM 300mm
(12") FROM ANY OPENING AND
ABOVE FIN. GRADE. REFER TO
GAS UTILIZATION CODE
- 38 CONVENTIONAL ROOF FRAMING
(*SEE OBC 9.23.4.2.1.11)
FOR MAX. 2240mm (7'-4") SPAN,
38x24 (2"x4") RAFTERS @ 400mm
(16") o.c. FOR MAX. 3530mm (11'-7")
SPAN, 38x140 (2"x6") RAFTERS
@ 400mm (16") o.c. RIDGE BOARD
TO BE 51mm (2") DEEPER. 38x34
(2"x4") COLLAR TIES AT MIDSPAN.
CEILING JOISTS TO BE 38x84
(2"x4") @ 400mm (16") o.c. FOR MAX.
2880mm (9'-3") SPAN & 38x140
(2"x6") @ 400 (16") o.c. FOR MAX.
4450mm (14'-7") SPAN. RAFTERS
FOR BUILT-UP ROOF TO BE 38x84
(2"x4") @ 600mm (24") o.c. WITH A
38x84 (2"x4") CENTER POST TO THE
TRUSS BELOW. LATERALLY BRACED
@ 1800mm (6'-0") o.c. VERTICALLY.
- 38 TWO STOREY VOLUME SPACES
FOR A MAXIMUM 5490mm (18'-0")
HEIGHT, PROVIDE 2-38x140
(2-2"x6") CONTINUOUS STUDS
@ 300mm (12") o.c. FOR BRICK AND
400mm (16") o.c. FOR SIDING.
PROVIDE SOLID WOOD BLOCKING
BETWEEN STUDS @ 1220mm (4'-0")
o.c. VERT. 1/8" EXT. PLYWOOD.

It is the builder's complete responsibility to ensure that all plans submitted for approval fully comply with the Architectural Guidelines and all applicable regulations and requirements including zoning provisions and any provisions in the subdivision agreement. The Control Architect is not responsible in any way for examining or approving site (lotting) plans or working drawings with respect to any zoning or building code or permit matter or that any house can be properly built or located on its lot.

This is to certify that these plans comply with the applicable Architectural Design Guidelines approved by the City of BRAMPTON.

W Architect Inc.
DESIGN CONTROL REVIEW

NOV 13 2018

FINAL BY: GGE

This stamp is only for the purposes of design control and carries no other professional obligations.

STRUDET INC.



NOV 02 2018

FOR STRUCTURE ONLY

MILLWOOD 12-021

COMPLIANCE PACKAGE "A1"

Greenpark

PROJECT NAME
MINNISALE HOMES CORP.

5.		
4.		
3.		
2.		
1.	REVISED FOR LOT 21	OCT 2018
REVISIONS		

The undersigned has reviewed and takes responsibility for this design, and has the qualifications and meets the requirements set out in the Ontario Building Code to be a designer.

QUALIFICATION INFORMATION
Required unless design is exempt under Division C, Subsection 3.2.5 of the building code

VIKAS GAJJAR
NAME SIGNATURE 28770
BCIN

REGION DESIGN INC.
8700 DUFFERIN ST.
CONCORD, ONTARIO
L4K 4S8
P (416) 736-4096
F (905) 660-0746

**REGION
DESIGN
INC.**

SHEET TITLE AREA CHARTS	
SCALE 3/16"=1'-0"	BY ZMP
DATE OCT 2018	AREA 2617

CONTRACTOR SHALL CHECK ALL DIMENSIONS AND ELEVATIONS BEFORE COMMENCING WITH WORK AND REPORT ANY DISCREPANCIES TO THE DESIGNER. PRINTS ARE NOT TO BE SCALED.

PAGE No.

0-2

CITY OF BRAMPTON
BUILDING DIVISION
REVIEWED
JAN 08 2019
PLUMBING BY
KOFI MORIEL

CITY OF BRAMPTON
BUILDING DIVISION
REVIEWED
JAN 05 2019
BY
MARK DERKSEN

CITY OF BRAMPTON
BUILDING DIVISION
ZONING REVIEWED
DEC 10 2018
BY
BLEY DAHONICK

It is the builder's complete responsibility to ensure that all plans submitted for approval fully comply with the Architectural Guidelines and all applicable regulations and requirements including zoning provisions and any provisions in the subdivision agreement. The Control Architect is not responsible in any way for examining or approving site (lotting) plans or working drawings with respect to any zoning or building code or permit matter or that any house can be properly built or located on its lot.

This is to certify that these plans comply with the applicable Architectural Design Guidelines approved by the City of BRAMPTON.

STRUDET INC.



FOR STRUCTURE ONLY


NOV 02 2018

MILLWOOD 12-021

COMPLIANCE PACKAGE "A1"

Greenpark.

PROJECT NAME
MINNISALE HOMES CORP.

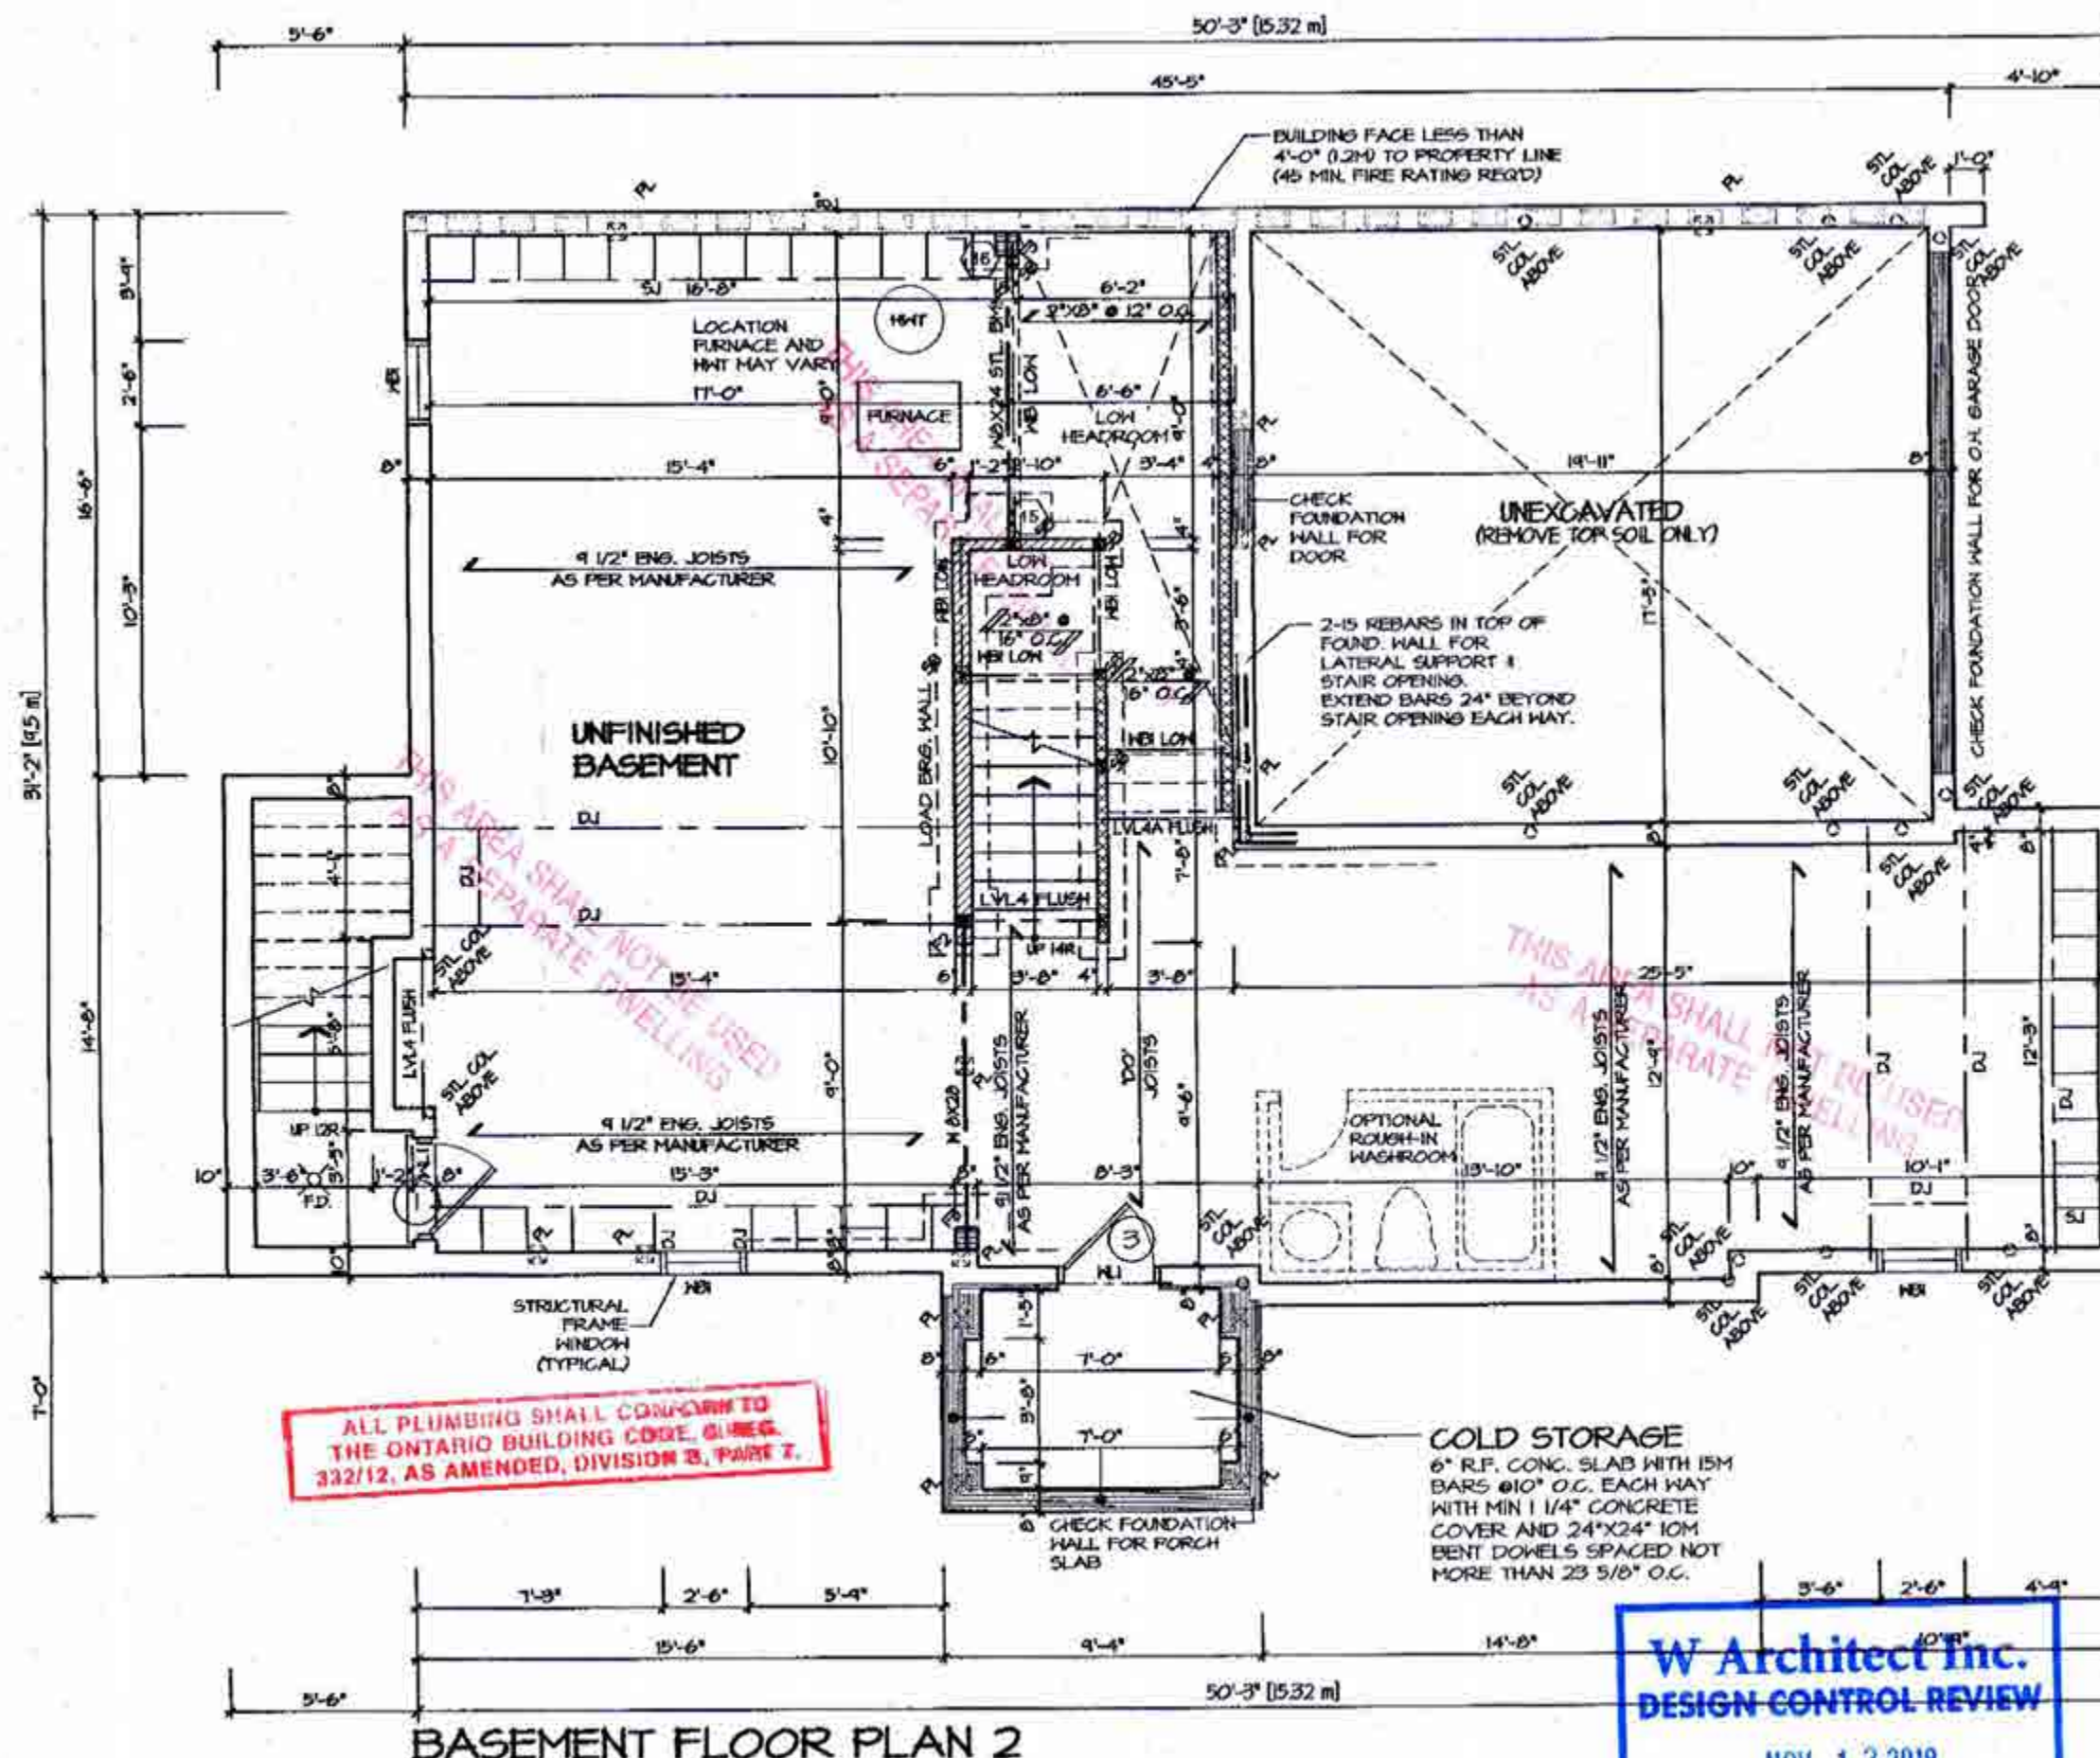

BASEMENT FLOOR PLAN 2

W Architect Inc.
DESIGN CONTROL REVIEW

NOV 13 2018

FINAL BY: *CTGE*

This stamp is only for the purpose of design control and carries no other professional obligation.

REVISIONS	
1. REVISED FOR LOT 21	OCT 2018

The undersigned has reviewed and takes responsibility for this design, and has the qualifications and meets the requirements set out in the Ontario Building Code to be a designer.

QUALIFICATION INFORMATION
Required unless design is exempt under Division C, Subsection 3.2.5 of the building code


VIKAS GAJJAR
NAME
28770
BCIN

REGION DESIGN INC.
8700 DUFFERIN ST.
CONCORD, ONTARIO
L4K 4S6
P (416) 736-4096
F (905) 660-0746

**REGION
DESIGN
INC.**

SHEET TITLE	BASEMENT PLAN 2
SCALE	3/16"=1'-0"
DATE	OCT 2018
BY	ZMP
AREA	2617

CONTRACTOR SHALL CHECK ALL DIMENSIONS AND ELEVATIONS BEFORE COMMENCING WITH WORK AND REPORT ANY DISCREPANCIES TO THE DESIGNER. PRINTS ARE NOT TO BE SCALED.	
PAGE No.	1

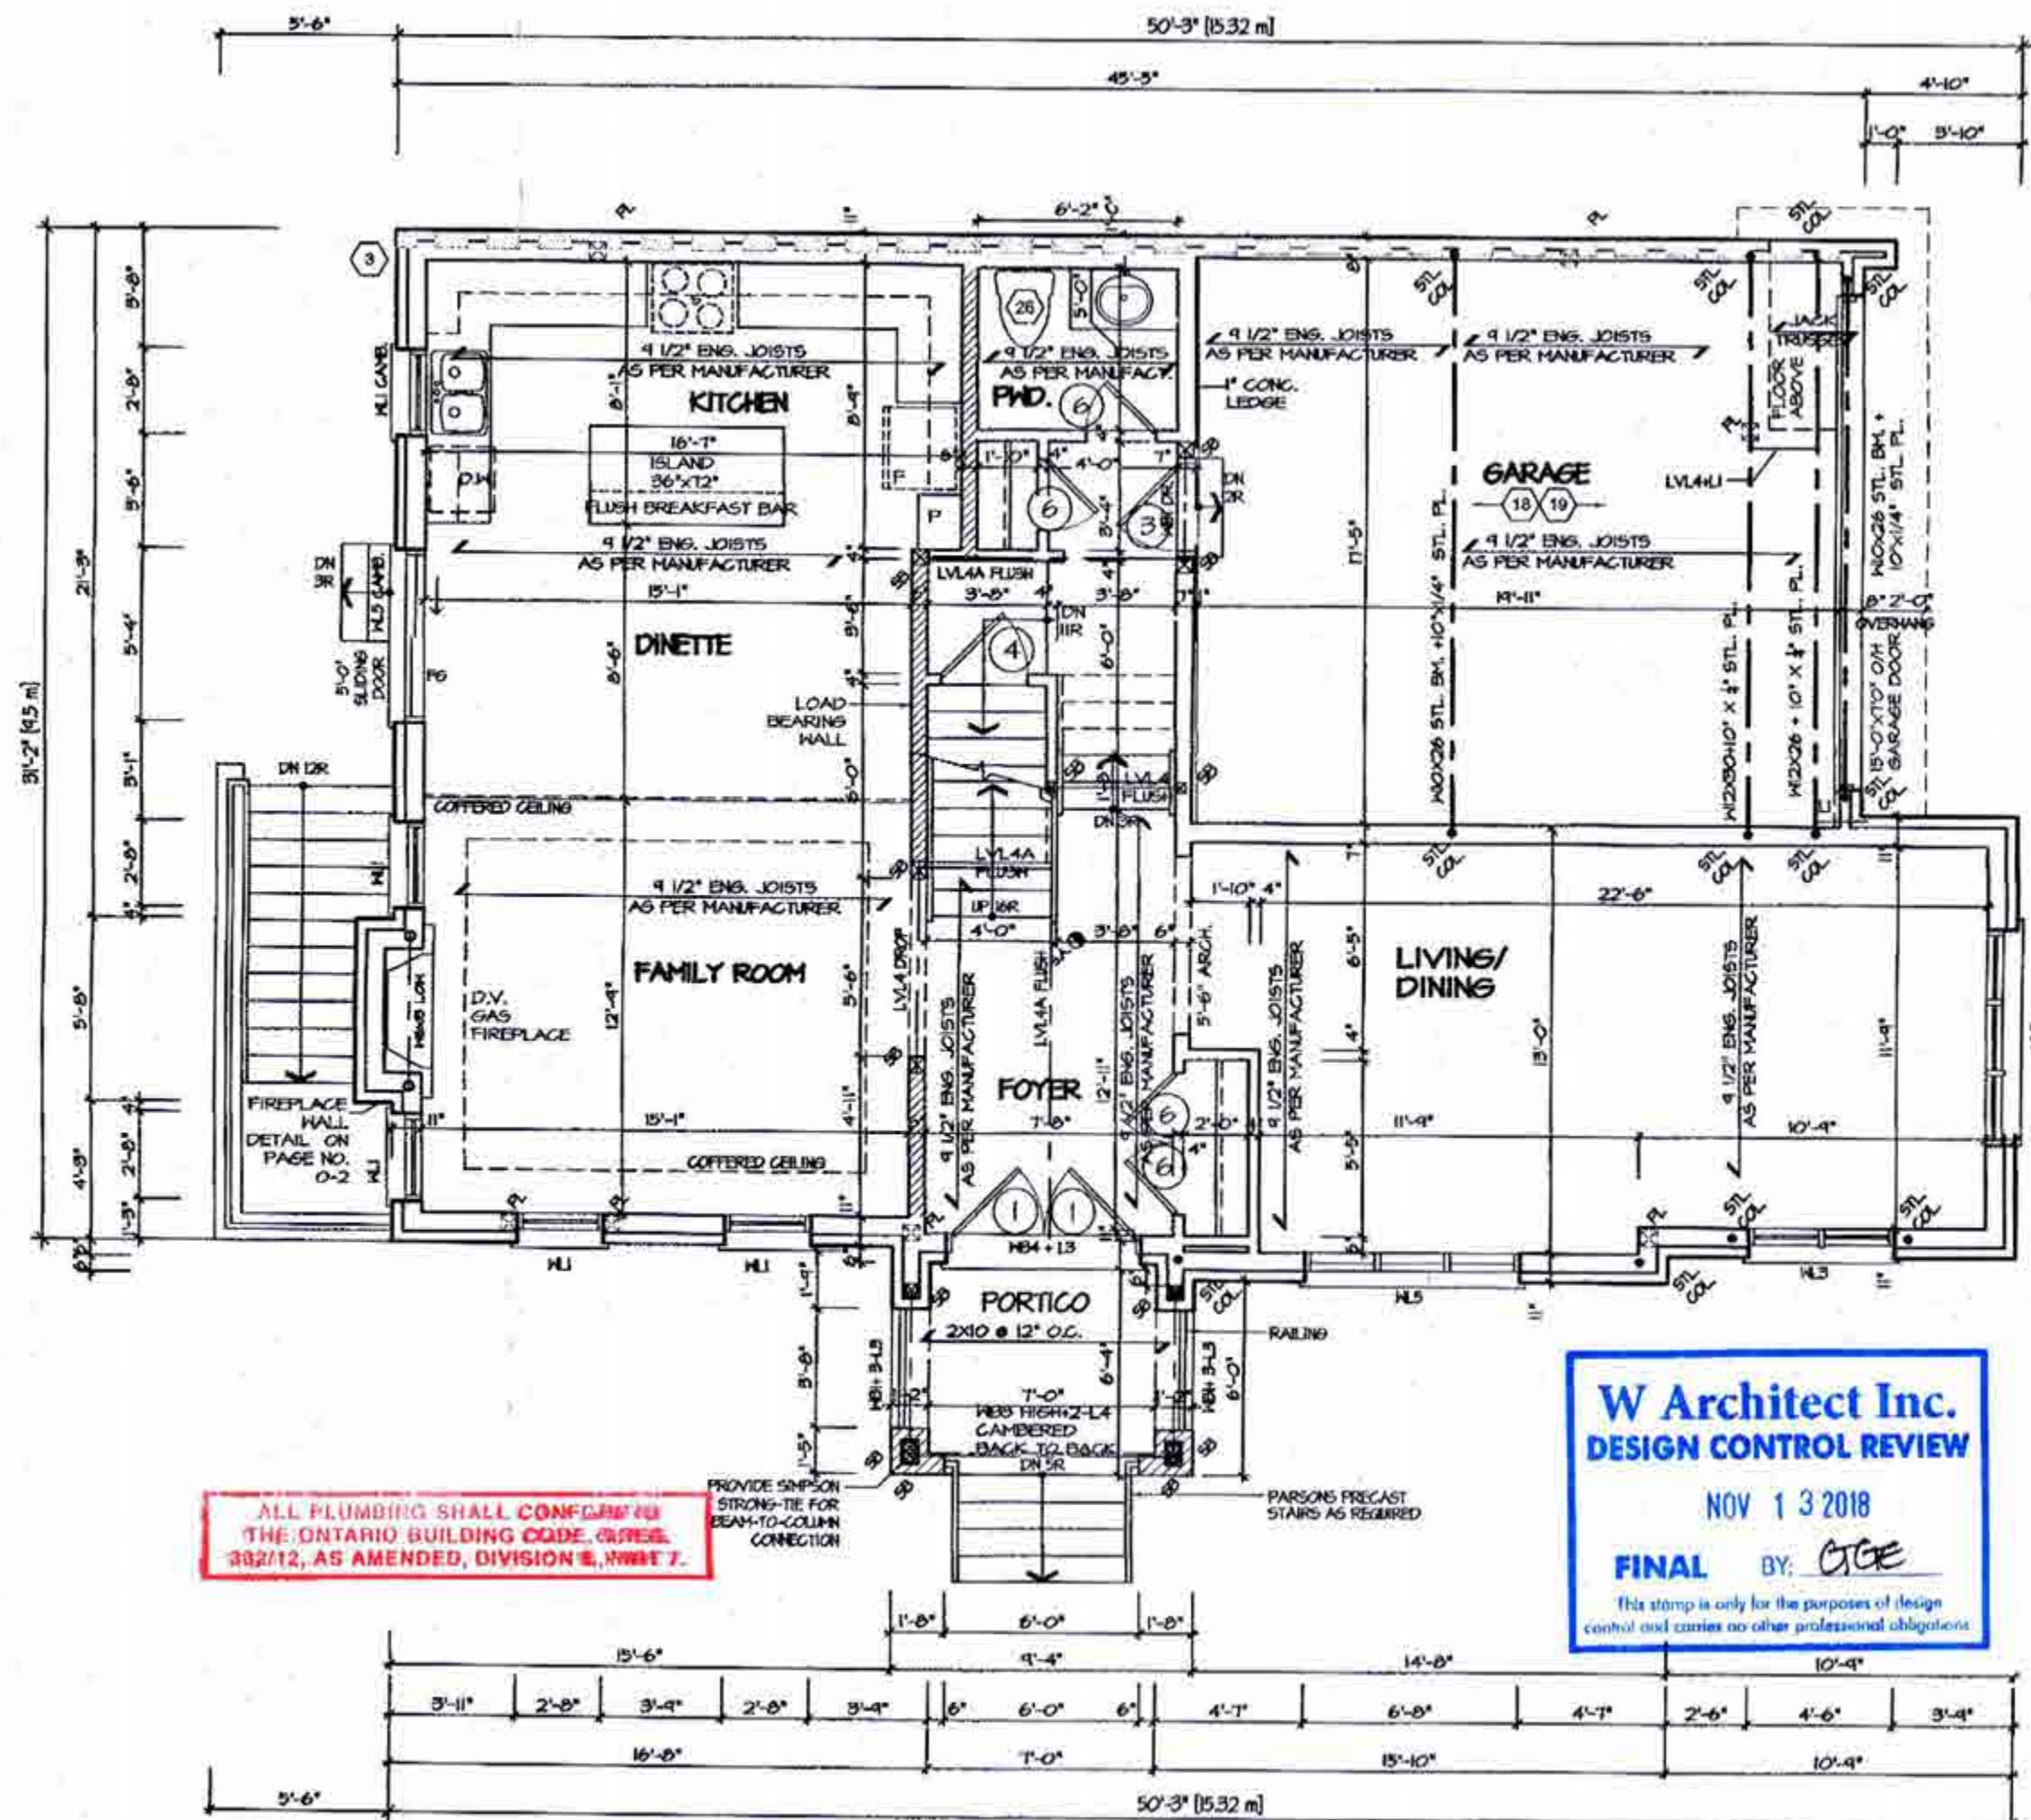

GROUND FLOOR PLAN 2

CITY OF BRAMPTON
BUILDING DIVISION
REVIEWED
JAN 08 2019
PLUMBING BY
KOFI MORIEL

CITY OF BRAMPTON
BUILDING DIVISION
REVIEWED
JAN 05 2019
BY
MARK DERKSEN

CITY OF BRAMPTON
BUILDING DIVISION
REVIEWED
DEC 10 2018
BY
LESLEY DAHONICK

It is the builder's complete responsibility to ensure that all plans submitted for approval fully comply with the Architectural Guidelines and all applicable regulations and requirements including zoning provisions and any provisions in the subdivision agreement. The Control Architect is not responsible in any way for examining or approving site (lotting) plans or working drawings with respect to any zoning or building code or permit matter or that any house can be properly built or located on its lot.

This is to certify that these plans comply with the applicable Architectural Design Guidelines approved by the City of BRAMPTON.

W Architect Inc.
DESIGN CONTROL REVIEW
NOV 13 2018
FINAL BY: *CJG*
This stamp is only for the purposes of design control and carries no other professional obligations.

STRUDET INC.
REGISTERED PROFESSIONAL ENGINEER
MARINKOVIC
PROVINCE OF ONTARIO
FOR STRUCTURE ONLY

NOV 02 2018

MILLWOOD 12-021

COMPLIANCE PACKAGE "A1"

REVISIONS	DATE
1. REVISED FOR LOT 21	OCT 2018

The undersigned has reviewed and takes responsibility for this design, and has the qualifications and meets the requirements set out in the Ontario Building Code to be a designer.

QUALIFICATION INFORMATION
Required unless design is exempt under Division C, Subsection 3.2.5 of the building code

VIKAS GAJJAR
NAME
SIGNATURE
28770
BCIN

REGION DESIGN INC.
6700 DUFFERIN ST.
CONCORD, ONTARIO
L4K 4S6
P (416) 736-4096
F (905) 880-0740

SHEET TITLE
FIRST FLOOR PLAN 2
SCALE
3/16"=1'-0"
DATE
OCT 2018
BY
ZMP
AREA
2617

CONTRACTOR SHALL CHECK ALL DIMENSIONS AND ELEVATIONS BEFORE COMMENCING WITH WORK AND REPORT ANY DISCREPANCIES TO THE DESIGNER. PRINTS ARE NOT TO BE SCALED.

PAGE No.
2

Greenpark.
PROJECT NAME
MINNISALE HOMES CORP.

CITY OF BRAMPTON
BUILDING DIVISION
REVIEWED
JAN 08 2019
PLUMBING BY
KOFI MORIEL

CITY OF BRAMPTON
BUILDING DIVISION
REVIEWED
JAN 05 2019
BY
MARK DERKSEN

It is the builder's complete responsibility to ensure that all plans submitted for approval fully comply with the Architectural Guidelines and all applicable regulations and requirements including zoning provisions and any provisions in the subdivision agreement. The Control Architect is not responsible in any way for examining or approving site (lotting) plans or working drawings with respect to any zoning or building code or permit matter or that any house can be properly built or located on its lot.

This is to certify that these plans comply with the applicable Architectural Design Guidelines approved by the City of BRAMPTON.

CITY OF BRAMPTON
BUILDING DIVISION
ZONING REVIEWED
DEC 10 2018
BY
LESLIE DAHONICK

STRUDET INC.
REGISTERED PROFESSIONAL ENGINEER
B. MARINKOVIC
PROVINCE OF ONTARIO
FOR STRUCTURE ONLY


NOV 02 2018

MILLWOOD 12-021

COMPLIANCE PACKAGE "A1"

Greenpark

PROJECT NAME
MINNISALE HOMES CORP.

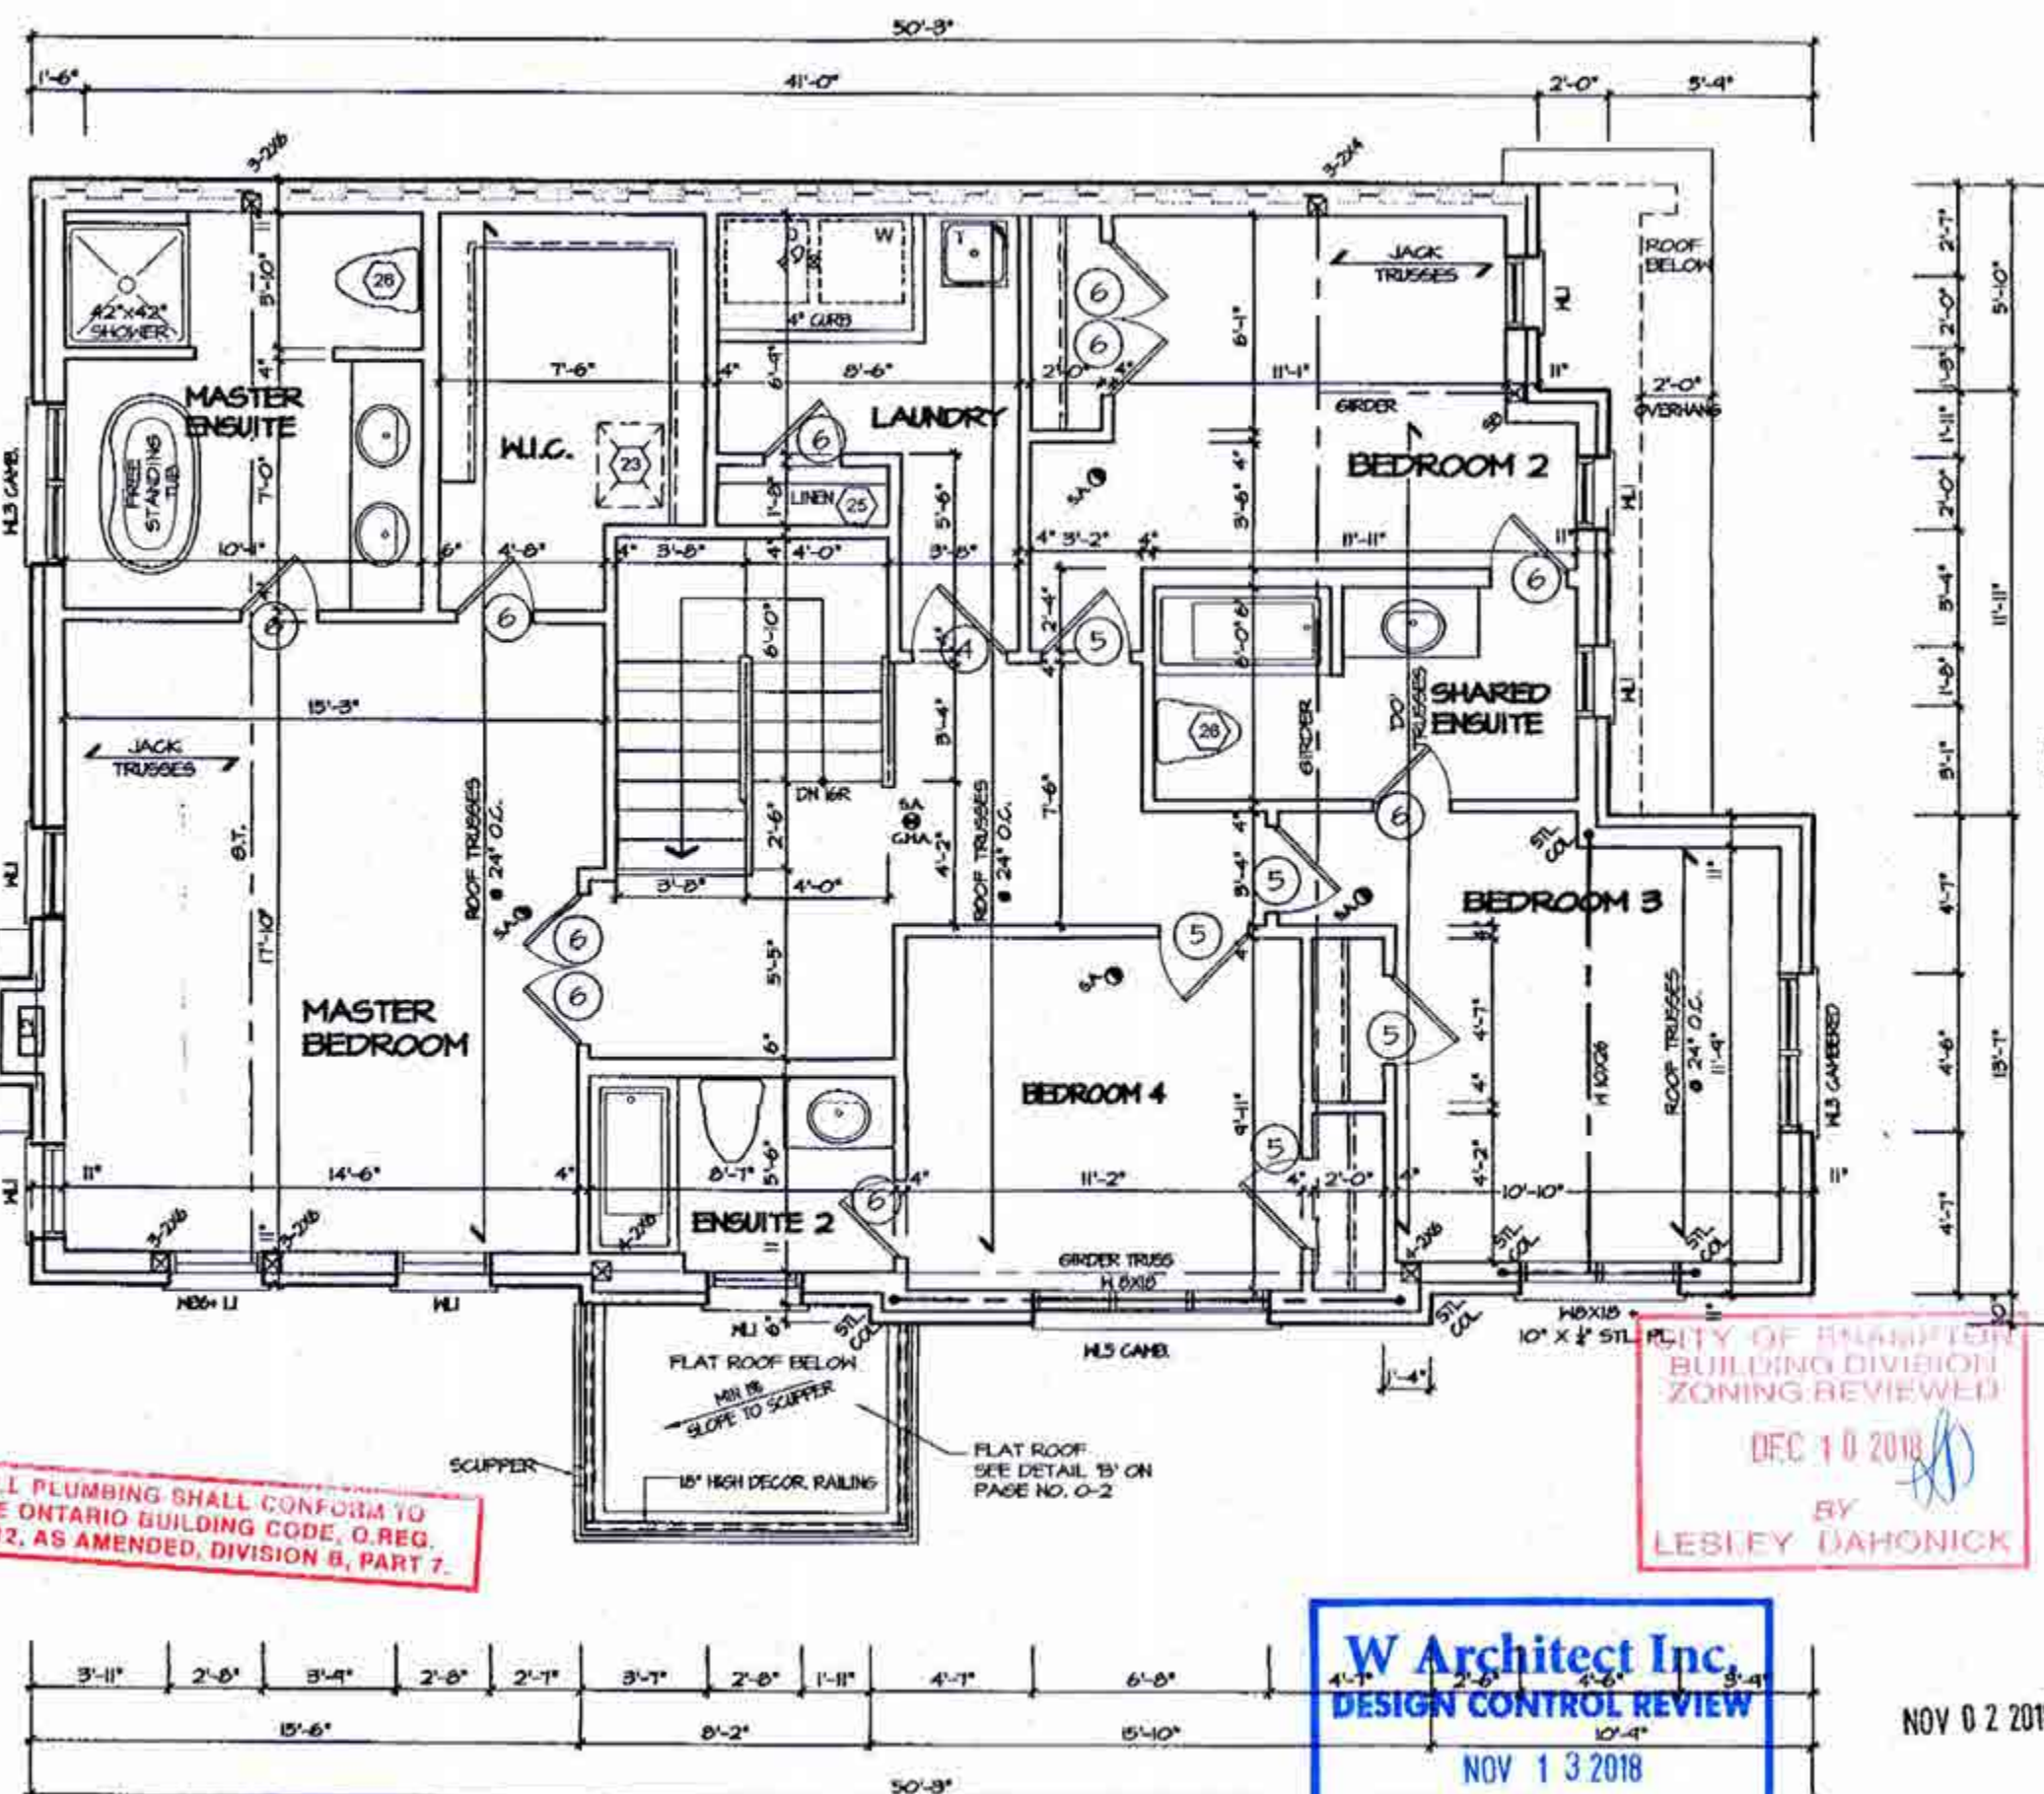

SECOND FLOOR PLAN 2

W Architect Inc.
DESIGN CONTROL REVIEW
NOV 13 2018
FINAL BY: *CCE*
This stamp is only for the purposes of design control and carries no other professional obligations.

REVISIONS	
1. REVISED FOR LOT 21	OCT 2018

The undersigned has reviewed and takes responsibility for this design, and has the qualifications and meets the requirements set out in the Ontario Building Code to be a designer.

QUALIFICATION INFORMATION
Required unless design is exempt under Division C, Subsection 3.2.5 of the building code

VIKAS GAJJAR
NAME
SIGNATURE
28770
BCIN



REGION DESIGN INC.
8700 DUFFERIN ST.
CONCORD, ONTARIO
L4K 4S6
P (416) 736-4096
F (905) 660-0748

**REGION
DESIGN
INC.**

SHEET TITLE
SECOND FLOOR PLAN 2
SCALE
3/16"=1'-0"
DATE
OCT 2018
BY
ZMP
AREA
2617

CONTRACTOR SHALL CHECK ALL DIMENSIONS AND ELEVATIONS BEFORE COMMENCING WITH WORK AND REPORT ANY DISCREPANCIES TO THE DESIGNER. PRINTS ARE NOT TO BE SCALED.

PAGE NO.
3

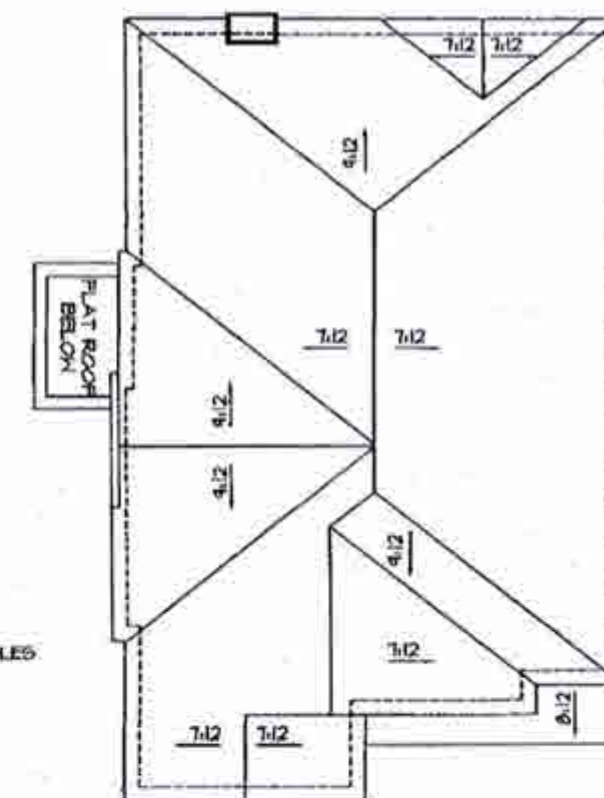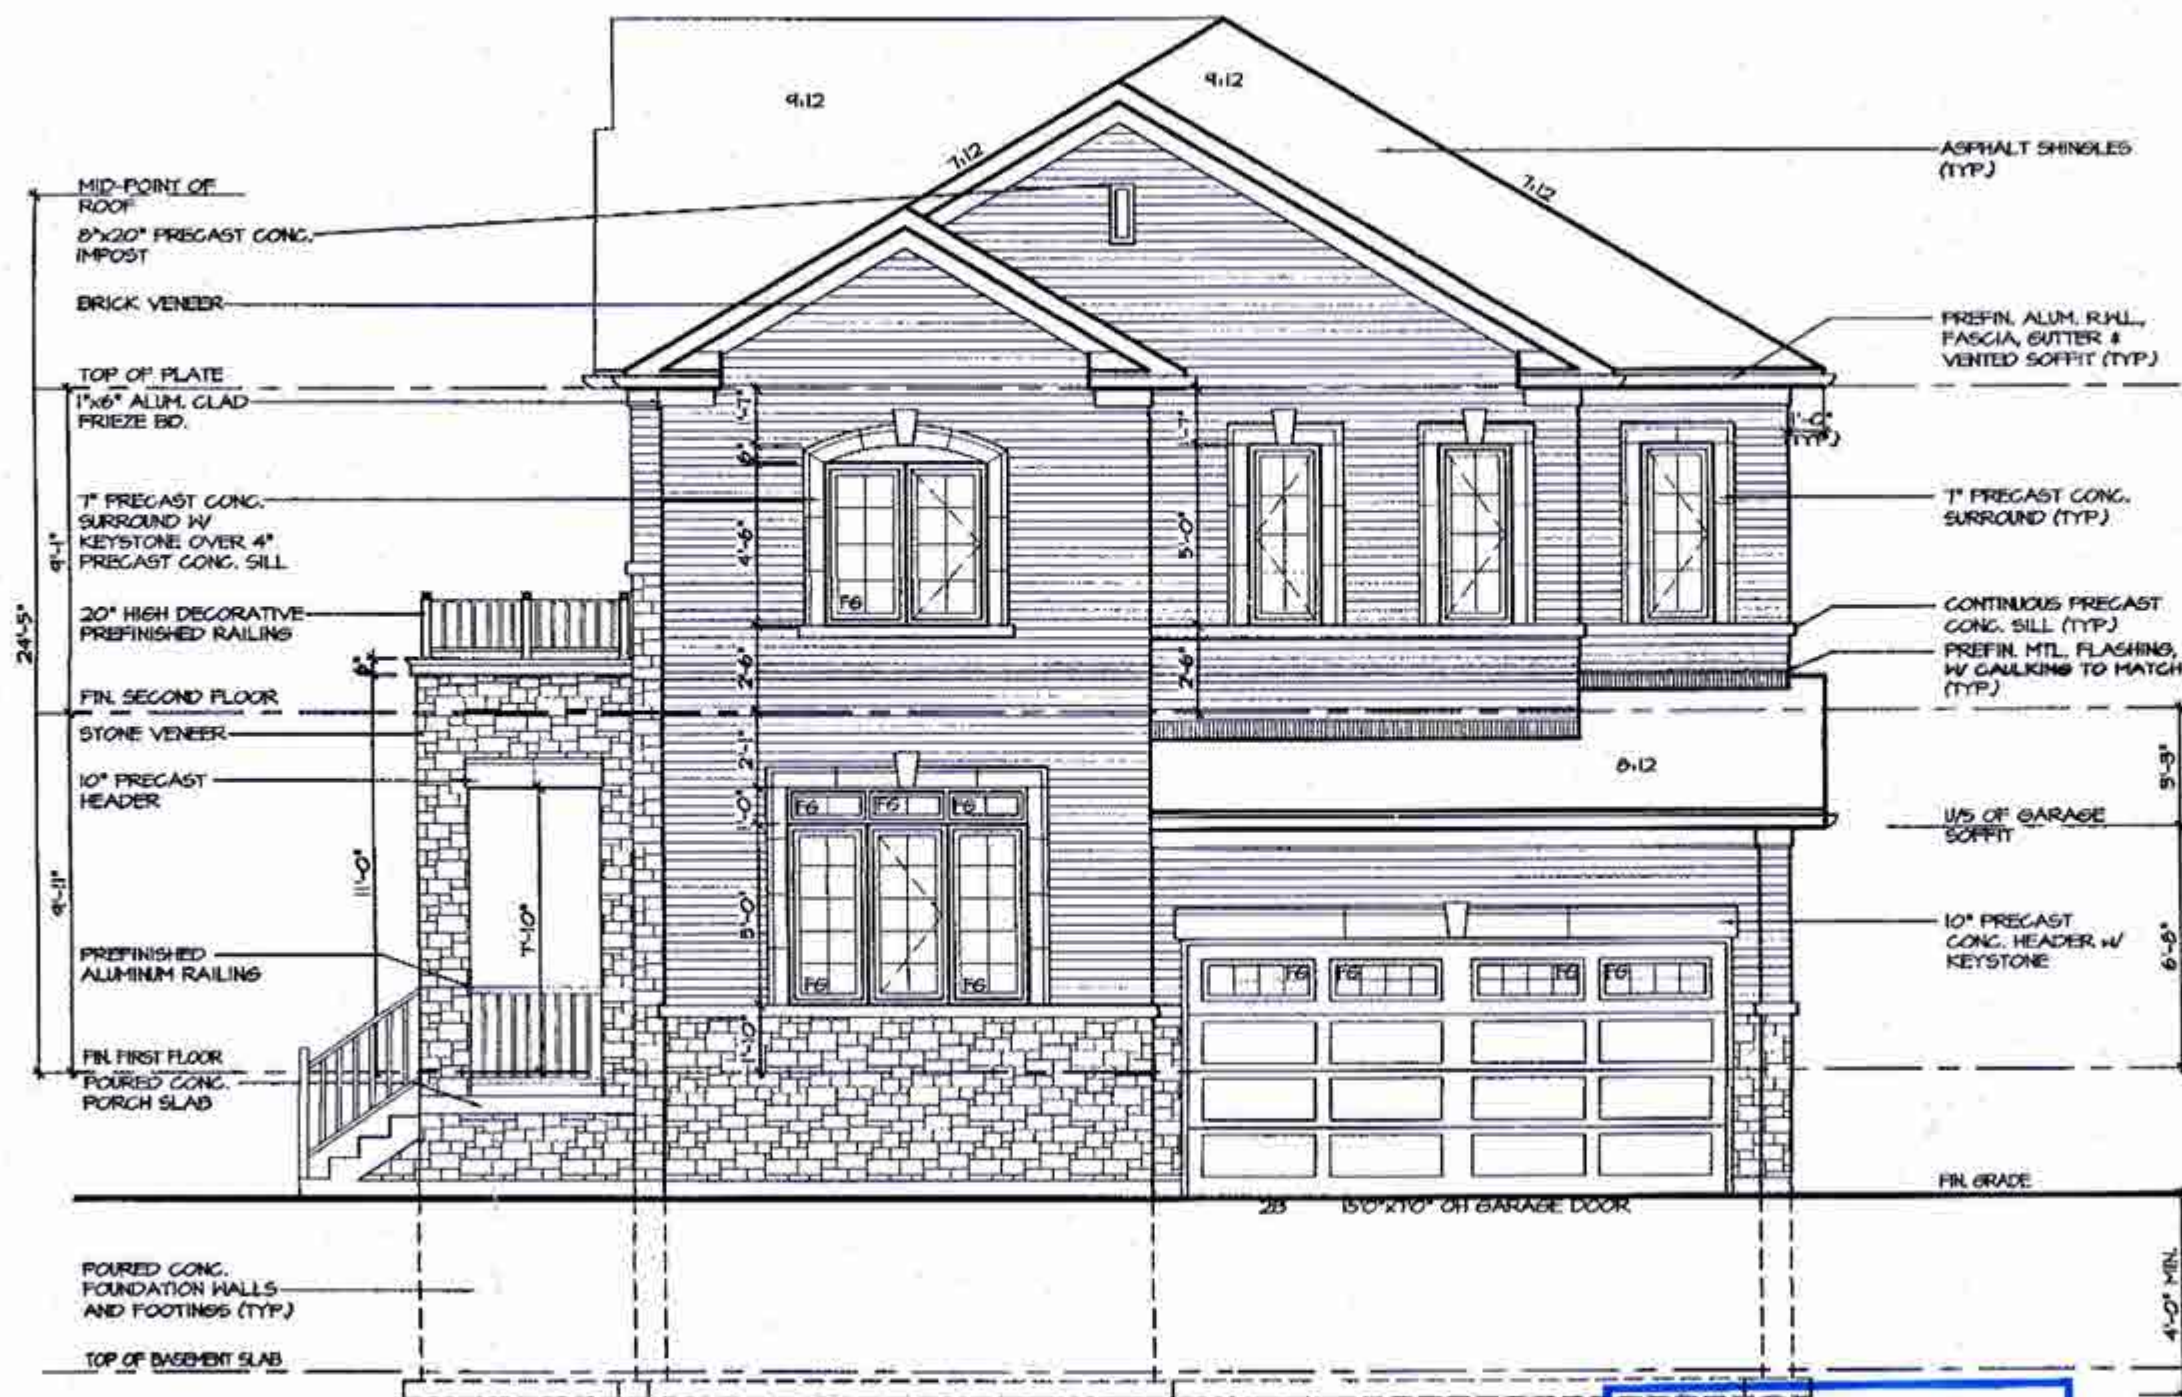

ROOF PLAN 2
SCALE: N.T.S.

CITY OF BRAMPTON
BUILDING DIVISION
REVIEWED
JAN 05 2019
BY
MARK DERKSEN

CITY OF BRAMPTON
BUILDING DIVISION
ZONING REVIEWED
DEC 10 2018
BY
LESLEY DAHONICK

It is the builder's complete responsibility to ensure that all plans submitted for approval fully comply with the Architectural Guidelines and all applicable regulations and requirements including zoning provisions and any provisions in the subdivision agreement. The Control Architect is not responsible in any way for extending or approving site (plotting) plans or working drawings with respect to any zoning or building code or permit matter or that any house can be properly built or located on its lot.

This is to certify that these plans comply with the applicable Architectural Design Guidelines approved by the City of BRAMPTON.

FRONT ELEVATION 2

W Architect Inc.
DESIGN CONTROL REVIEW

NOV 13 2018


FINAL BY: GCE
This stamp is only for the purposes of design control and carries no other professional obligations.

NOV 02 2018

MILLWOOD 12-021

COMPLIANCE PACKAGE "A1"

5.			The undersigned has reviewed and takes responsibility for this design, and has the qualifications and meets the requirements set out in the Ontario Building Code to be a designer. QUALIFICATION INFORMATION Required unless design is exempt under Division C, Subsection 3.2.5 of the building code VIKAS GAJJAR NAME SIGNATURE 28770 BCIN	REGION DESIGN INC. 8700 DUFFERIN ST. CONCORD, ONTARIO L4K 4S6 P (416) 736-4098 F (905) 860-0746	REGION DESIGN INC.	SHEET TITLE FRONT ELEVATION 2		CONTRACTOR SHALL CHECK ALL DIMENSIONS AND ELEVATIONS BEFORE COMMENCING WITH WORK AND REPORT ANY DISCREPANCIES TO THE DESIGNER. PRINTS ARE NOT TO BE SCALED. PAGE No. 4	 PROJECT NAME MINNISALE HOMES CORP.
4.									
3.									
2.									
1.	REVISED FOR LOT 21	OCT 2018							
REVISIONS									

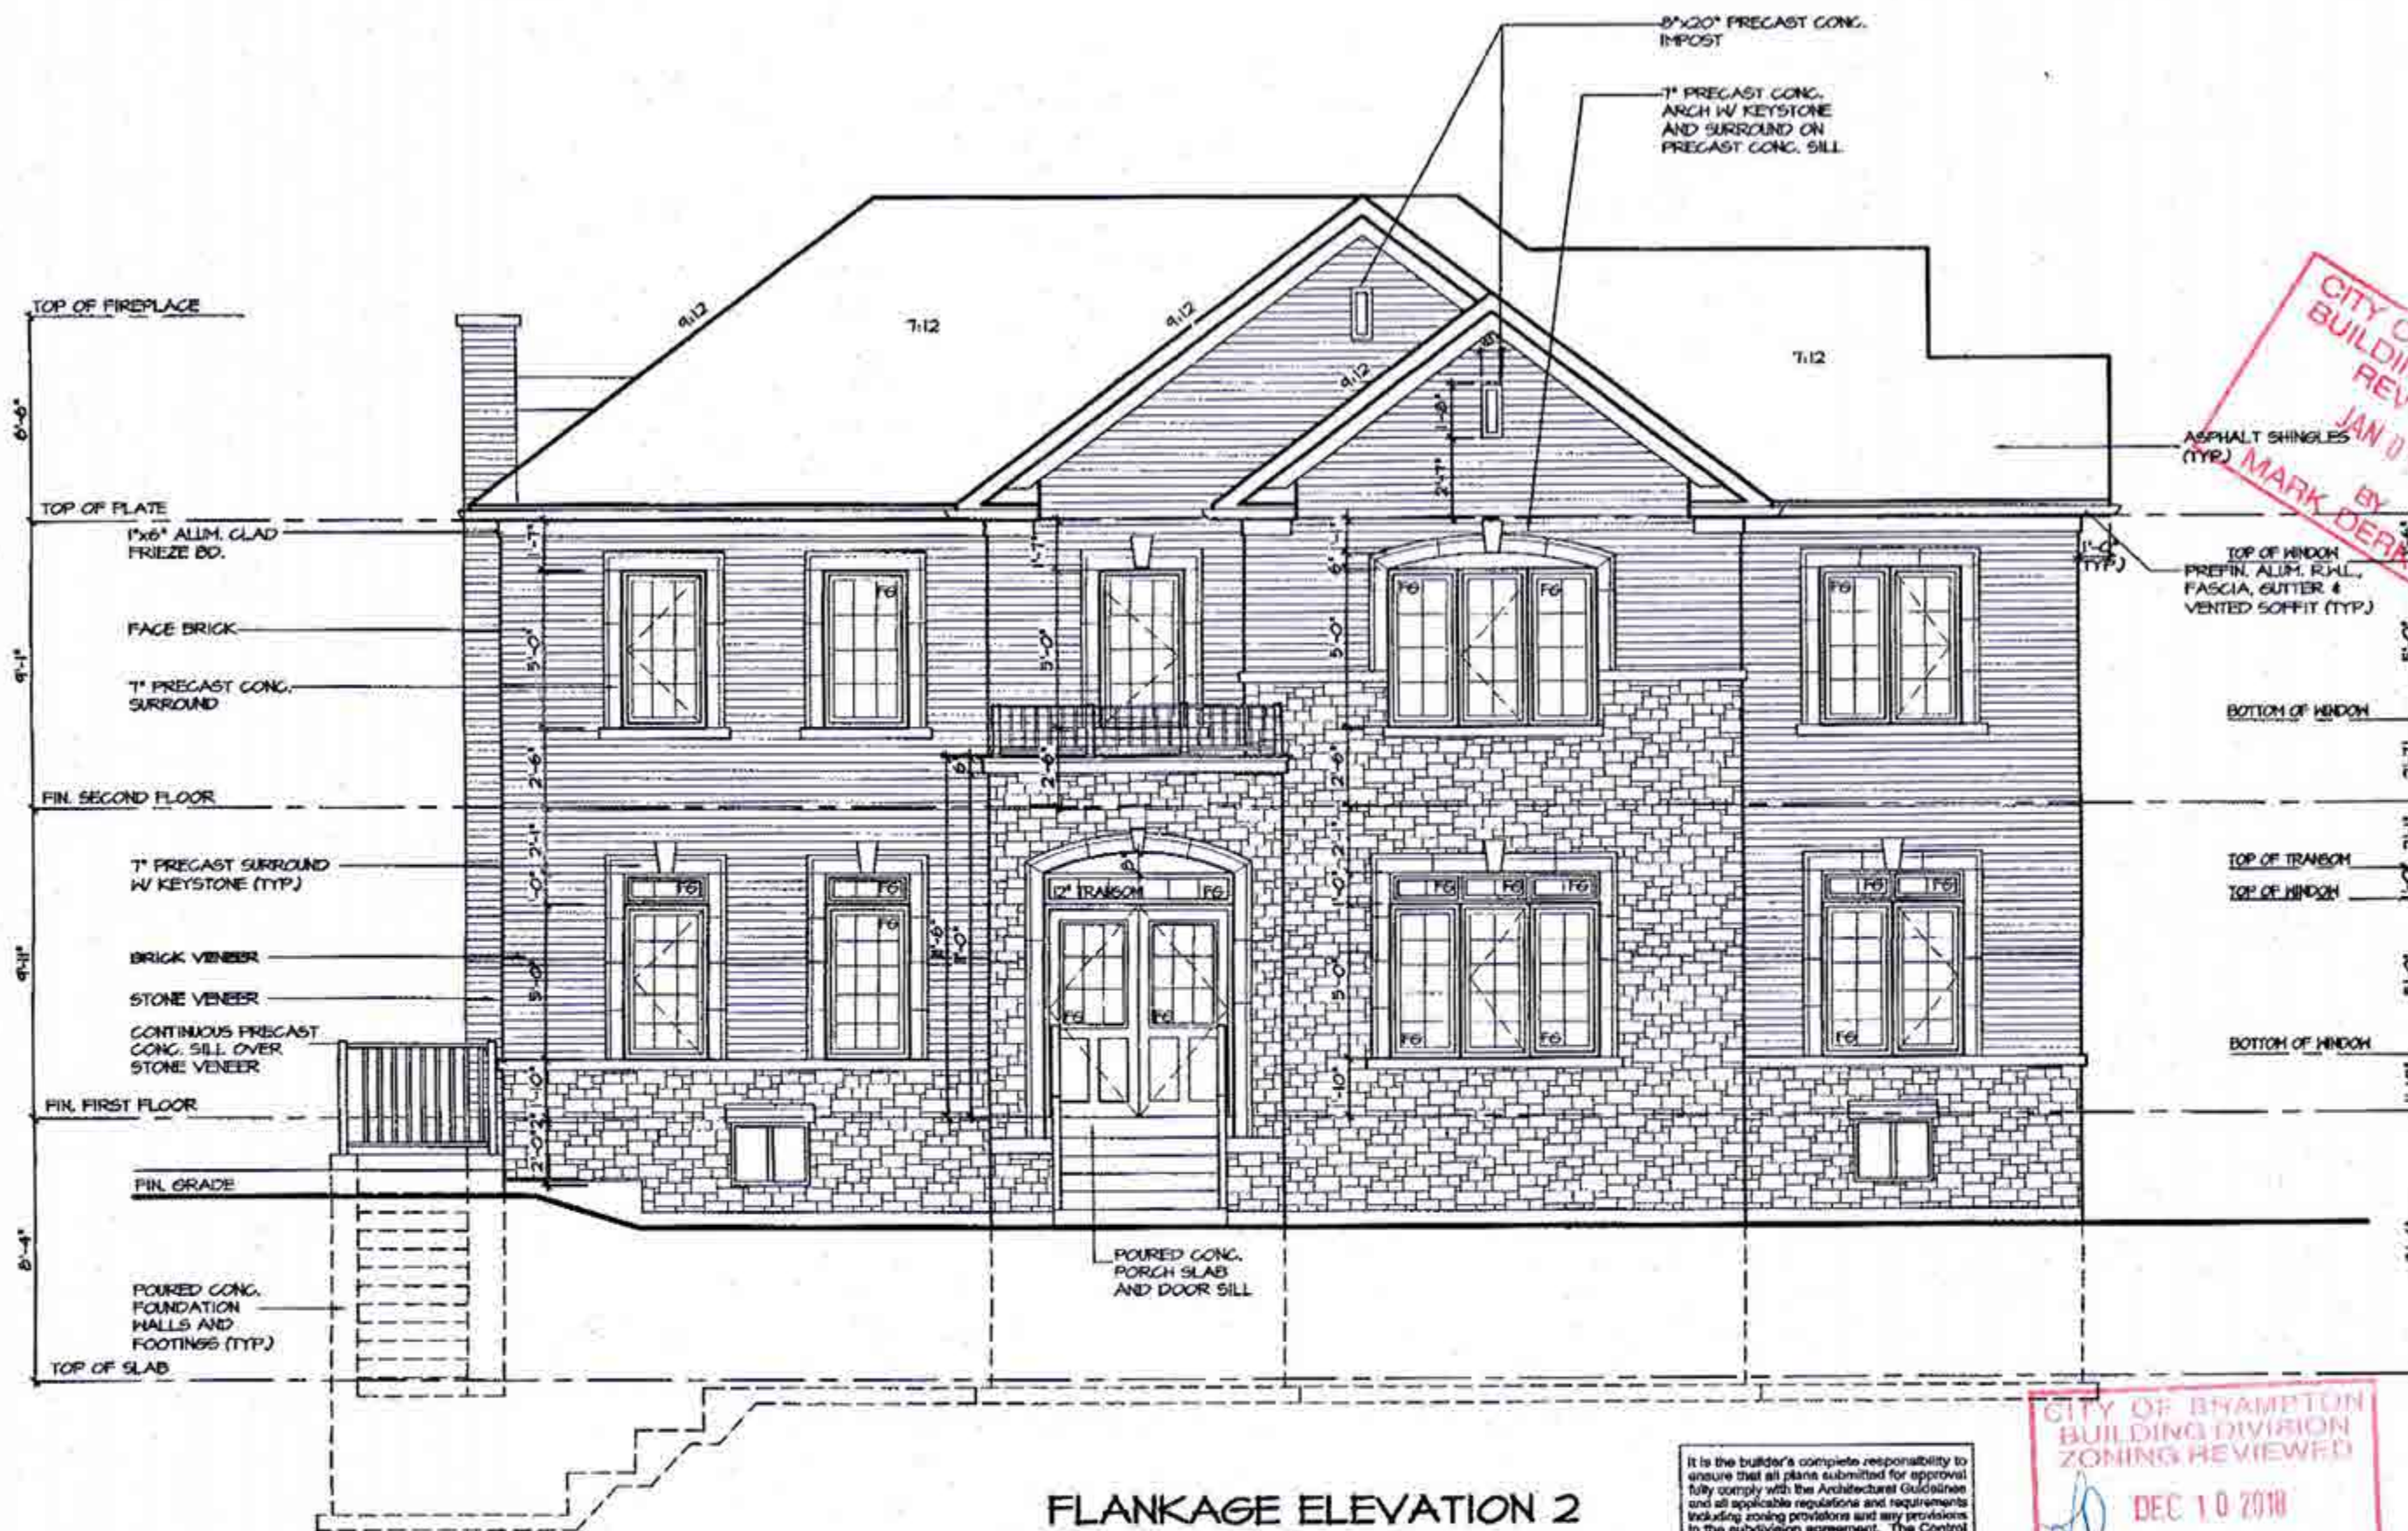

CITY OF BRAMPTON
BUILDING DIVISION
REVIEWED
JAN 05 2018
BY
MARK DERSEN

FLANKAGE ELEVATION 2

W Architect Inc.
DESIGN CONTROL REVIEW
NOV 13 2018
FINAL BY: CTGE
This stamp is only for the purposes of design control and carries no other professional obligations.

It is the builder's complete responsibility to ensure that all plans submitted for approval fully comply with the Architectural Guidelines and all applicable regulations and requirements including zoning provisions and any provisions in the subdivision agreement. The Control Architect is not responsible in any way for examining or approving site (lotting) plans or working drawings with respect to any zoning or building code or permit matter or that any house can be properly built or located on its lot.

This is to certify that these plans comply with the applicable Architectural Design Guidelines approved by the City of BRAMPTON.

CITY OF BRAMPTON
BUILDING DIVISION
ZONING REVIEWED
DEC 10 2018
BY
LESLEY DAHONICK

NOV 02 2018

MILLWOOD 12-021
COMPLIANCE PACKAGE "A1"

5.		
4.		
3.		
2.		
1.	REVISED FOR LOT 21	OCT 2018
REVISIONS		

The undersigned has reviewed and takes responsibility for this design, and has the qualifications and meets the requirements set out in the Ontario Building Code to be a designer.

QUALIFICATION INFORMATION
Required unless design is exempt under Division C, Subsection 3.2.5 of the building code

VIKAS GAJJAR
NAME SIGNATURE
28770
BCIN

REGION DESIGN INC.
8700 DUFFERIN ST.
CONCORD, ONTARIO
L4K 4S0
P (416) 736-4096
F (905) 860-0746

**REGION
DESIGN
INC.**

SHEET TITLE
**FLANKAGE
ELEVATION 2**

SCALE
3/16"=1'-0"

DATE
OCT 2018

BY
ZMP


AREA
2617

CONTRACTOR SHALL CHECK ALL DIMENSIONS AND ELEVATIONS BEFORE COMMENCING WITH WORK AND REPORT ANY DISCREPANCIES TO THE DESIGNER. PRINTS ARE NOT TO BE SCALED.


PAGE No.
5

Greenpark.

PROJECT NAME
MINNISALE HOMES CORP.

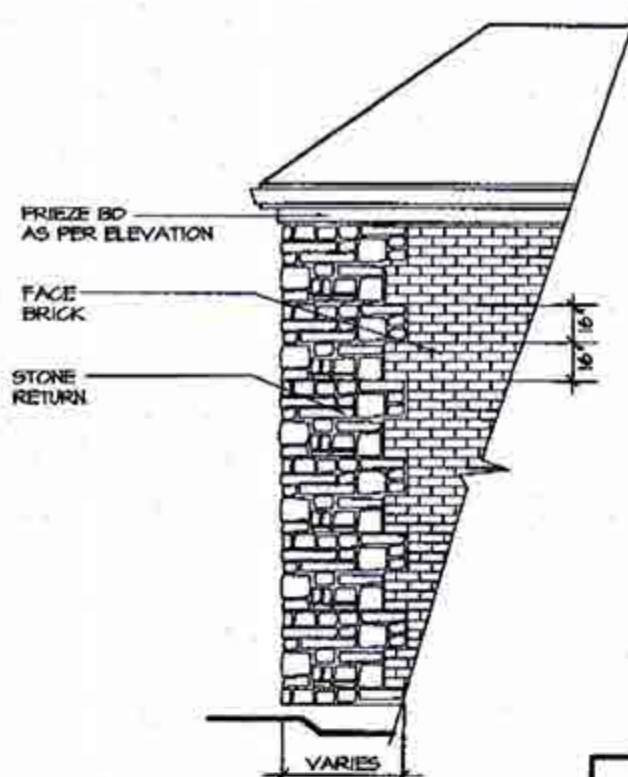

DETAIL OF STONE TO BRICK TRANSITION

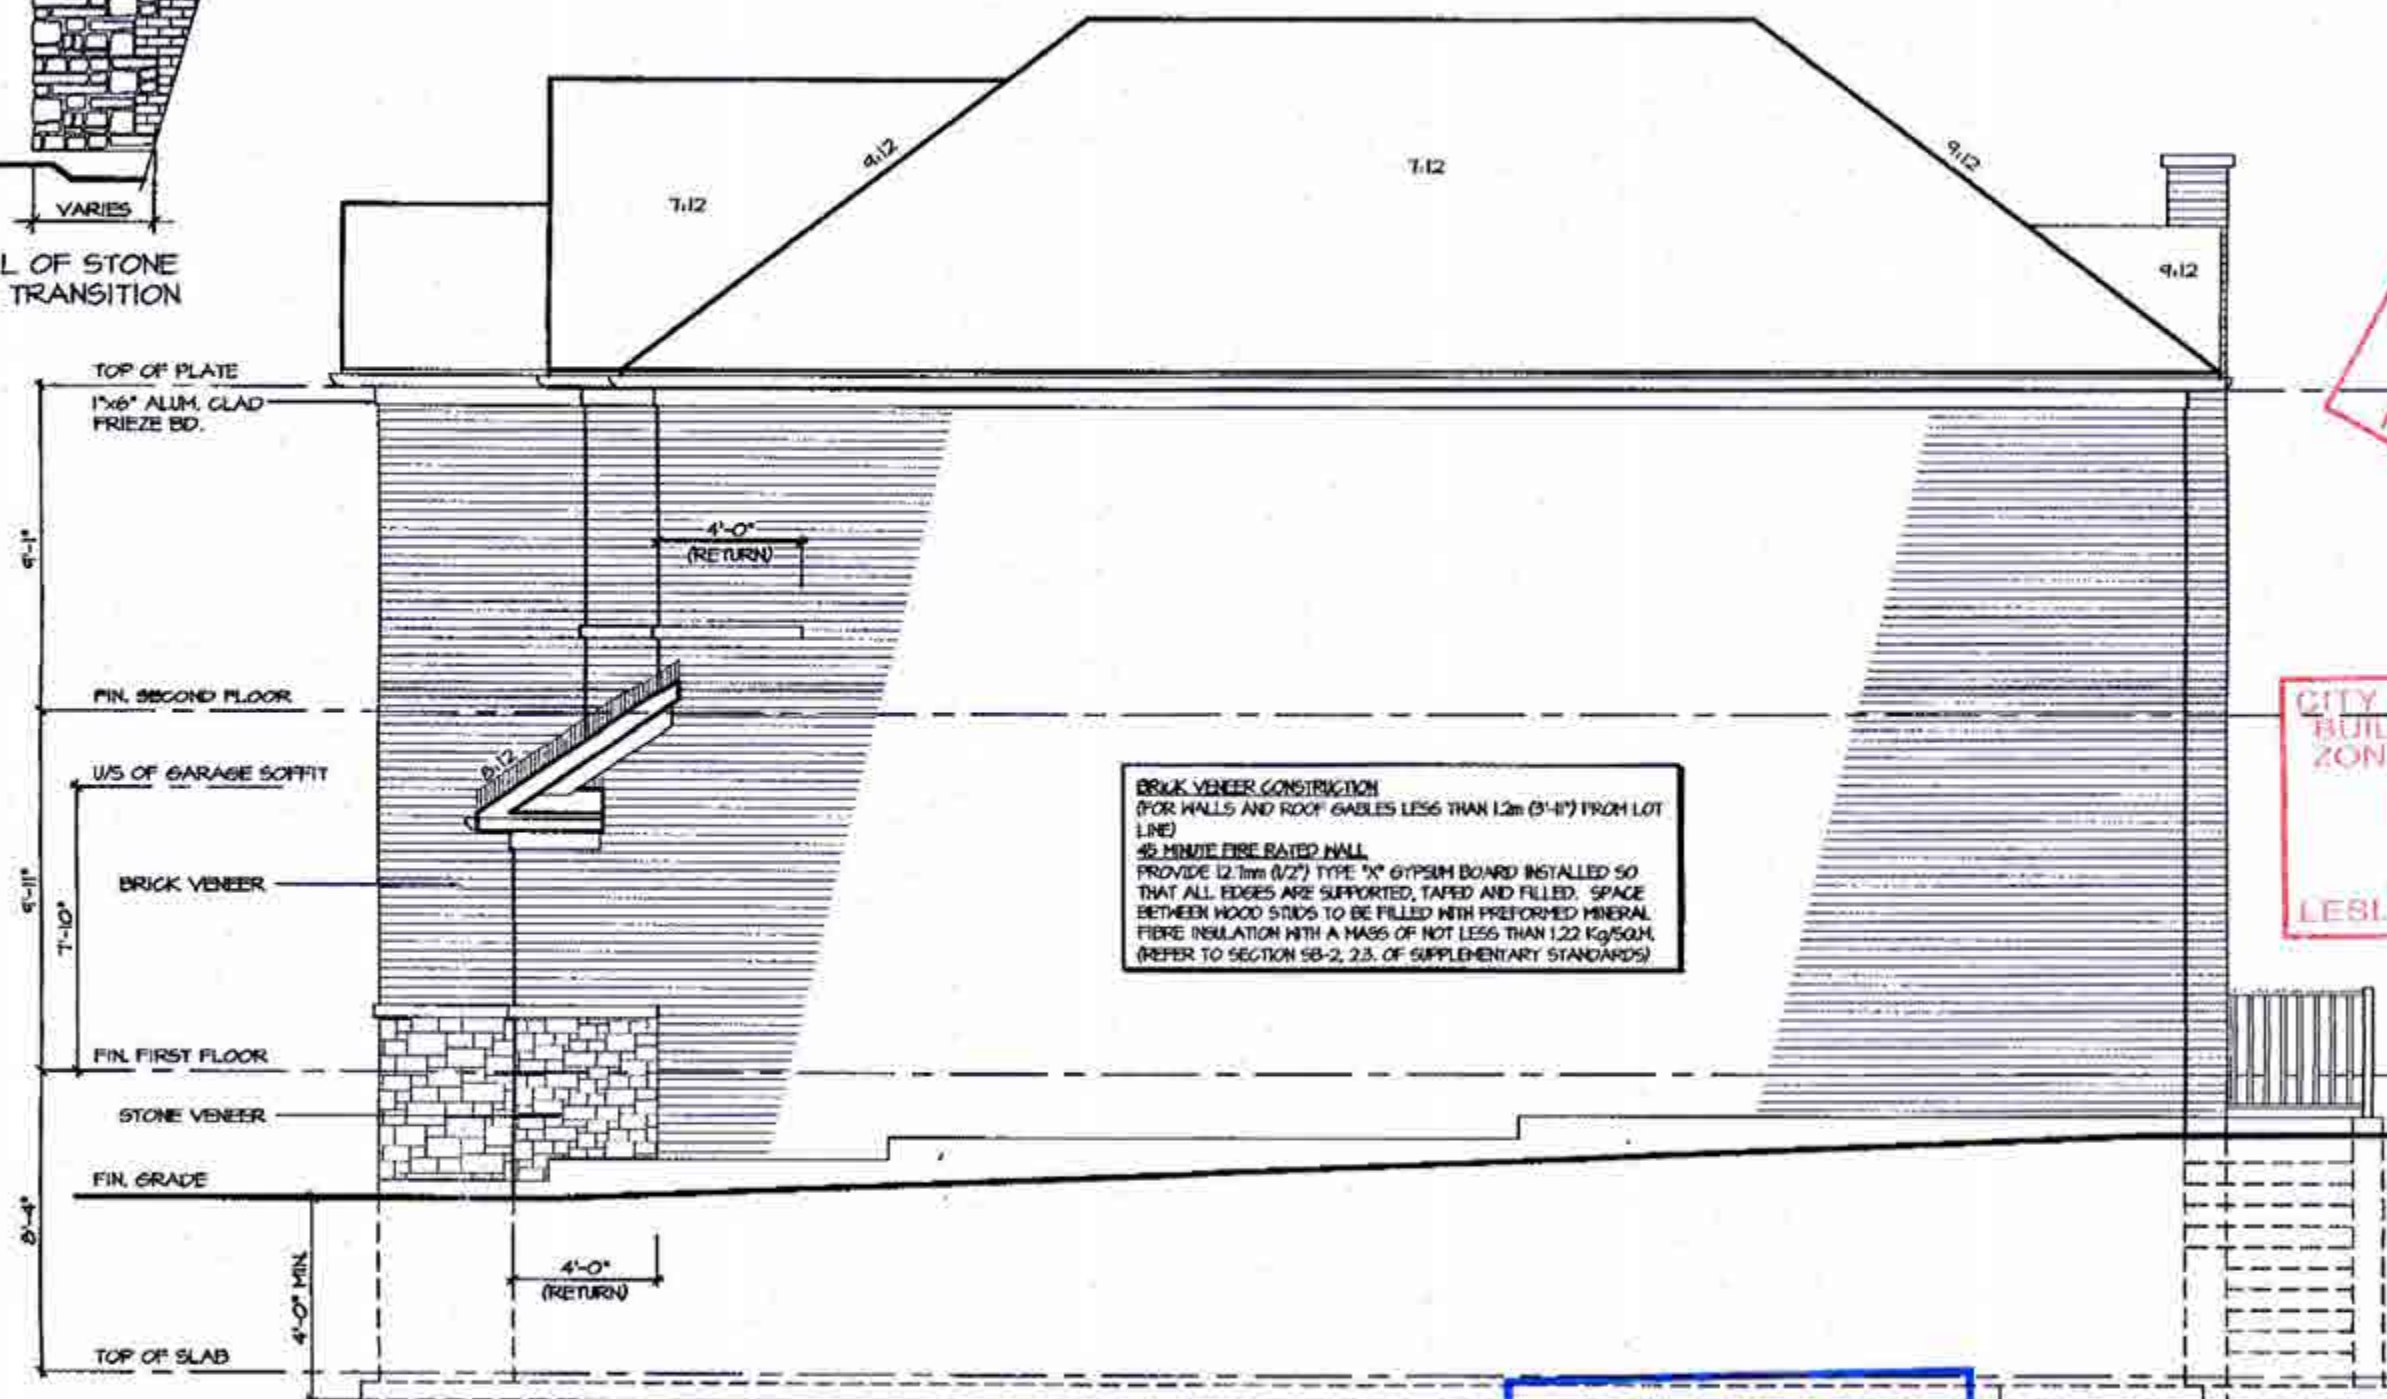

CITY OF BRAMPTON
BUILDING DIVISION
REVIEWED
JAN 11 5 2019
BY
MARK DERKSEN

CITY OF BRAMPTON
BUILDING DIVISION
ZONING REVIEWED
DEC 10 2018
BY
LESLEY DAHONICK

It is the builder's complete responsibility to ensure that all plans submitted for approval fully comply with the Architectural Guidelines and all applicable regulations and requirements including zoning provisions and any provisions in the subdivision agreement. The Control Architect is not responsible in any way for examining or approving site (lotting) plans or working drawings with respect to any zoning or building code or permit matter or that any house can be properly built or located on its lot.

This is to certify that these plans comply with the applicable Architectural Design Guidelines approved by the City of BRAMPTON.

RIGHT ELEVATION 2

ALLOWABLE GLAZING
WALL AREA = 93.0 Sq. Ft.
ALLOWABLE GLAZED AREA @ 7% 1.9 M SIDE YARD = 65.65 Sq. Ft.
ACTUAL GLAZED AREA = 0.0 Sq. Ft.
WITH OPTIONAL 30"x24" BASEMENT KINZONS ACTUAL GLAZED AREA = 0.0 Sq. Ft.

W Architect Inc.
DESIGN CONTROL REVIEW

NOV 13 2018

FINAL BY: CGE

NOV 02 2018

MILLWOOD 12-021

COMPLIANCE PACKAGE "A1"

5.		
4.		
3.		
2.		
1.	REVISED FOR LOT 21	OCT 2018
REVISIONS		

The undersigned has reviewed and takes responsibility for this design, and has the qualifications and meets the requirements set out in the Ontario Building Code to be a designer.

QUALIFICATION INFORMATION
Required unless design is exempt under Division C, Subsection 3.2.6 of the building code

VIKAS GAJJAR
NAME

SIGNATURE

28770
BCIN

REGION DESIGN INC.
8700 DUFFERIN ST.
CONCORD, ONTARIO
L4K 4S6
P (416) 735-4096
F (905) 680-0746

REGION
DESIGN
INC.

SHEET TITLE
RIGHT
SIDE ELEVATION 2

SCALE
3/16"=1'-0"

DATE
OCT 2018


BY
ZMP

AREA
2617

CONTRACTOR SHALL CHECK ALL DIMENSIONS AND ELEVATIONS BEFORE COMMENCING WITH WORK AND REPORT ANY DISCREPANCIES TO THE DESIGNER. PRINTS ARE NOT TO BE SCALED.

PAGE NO.
6

PROJECT NAME
MINNISALE HOMES CORP.

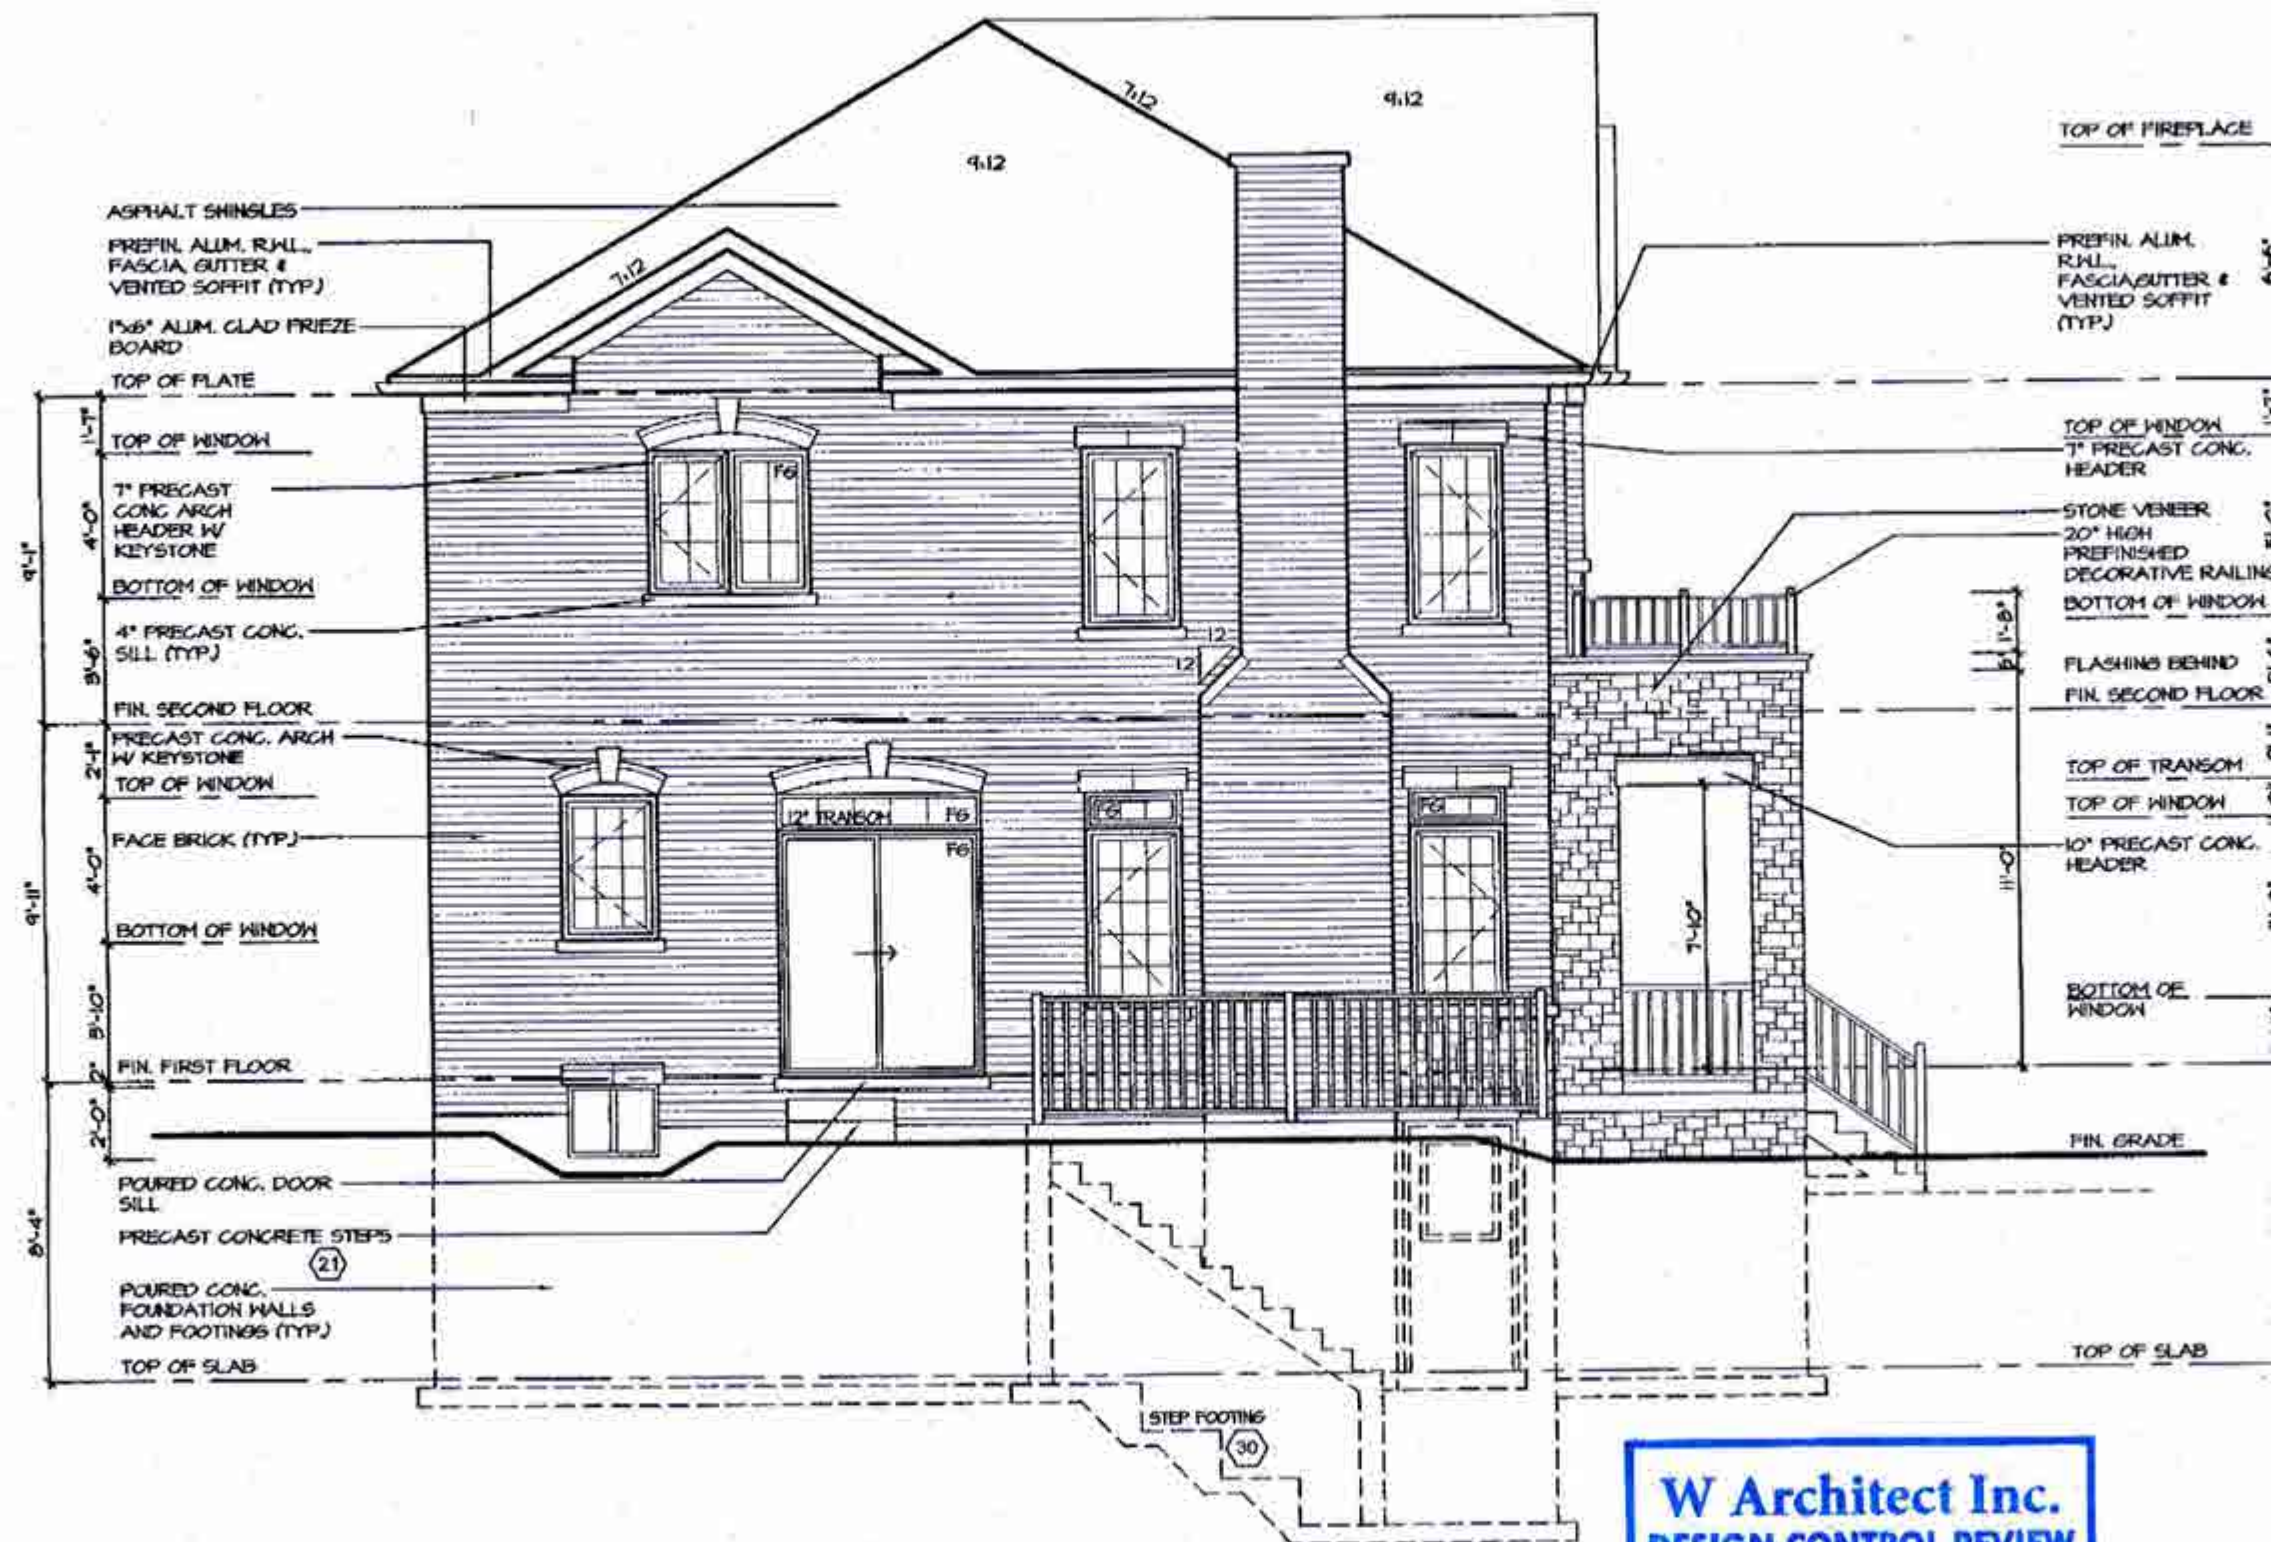

CITY OF BRAMPTON
BUILDING DIVISION
REVIEWED
JAN 05 2019
BY
MARK DERKSEN

CITY OF BRAMPTON
BUILDING DIVISION
ZONING REVIEWED
DEC 10 2018
BY
LESLEY DAHONICK

It is the builder's complete responsibility to ensure that all plans submitted for approval fully comply with the Architectural Guidelines and all applicable regulations and requirements including zoning provisions and any provisions in the subdivision agreement. The Control Architect is not responsible in any way for examining or approving the (noting) plans or working drawings with respect to any zoning or building code or permit matter or that any house can be properly built or located on its lot.

This is to certify that these plans comply with the applicable Architectural Design Guidelines approved by the City of BRAMPTON.

W Architect Inc.
DESIGN CONTROL REVIEW
NOV 13 2018
FINAL BY: ~~CC~~ NOV 02 2018
This stamp is only for the purposes of design control and carries no other professional obligations.

MILLWOOD 12-021

COMPLIANCE PACKAGE "A1"

5.		
4.		
3.		
2.		
1.	REVISED FOR LOT 21	OCT 2018
REVISIONS		

The undersigned has reviewed and takes responsibility for this design, and has the qualifications and meets the requirements set out in the Ontario Building Code to be a designer.

QUALIFICATION INFORMATION
Required unless design is exempt under Division C, Subsection 3.2.5 of the building code
VIKAS GAJJAR
NAME
SIGNATURE
28770
BCIN


REGION DESIGN INC.
5700 DUFFERIN ST.
CONCORD, ONTARIO
L4K 4S6
P (416) 735-4096
F (905) 660-0746

**REGION
DESIGN
INC.**


SHEET TITLE
REAR ELEVATION 2
SCALE
3/16"=1'-0"
DATE
OCT 2018
BY
ZMP
AREA
2617

CONTRACTOR SHALL CHECK ALL DIMENSIONS AND ELEVATIONS BEFORE COMMENCING WITH WORK AND REPORT ANY DISCREPANCIES TO THE DESIGNER. PRINTS ARE NOT TO BE SCALED.
PAGE No.
7

Greenpark.
PROJECT NAME
MINNISALE HOMES CORP.

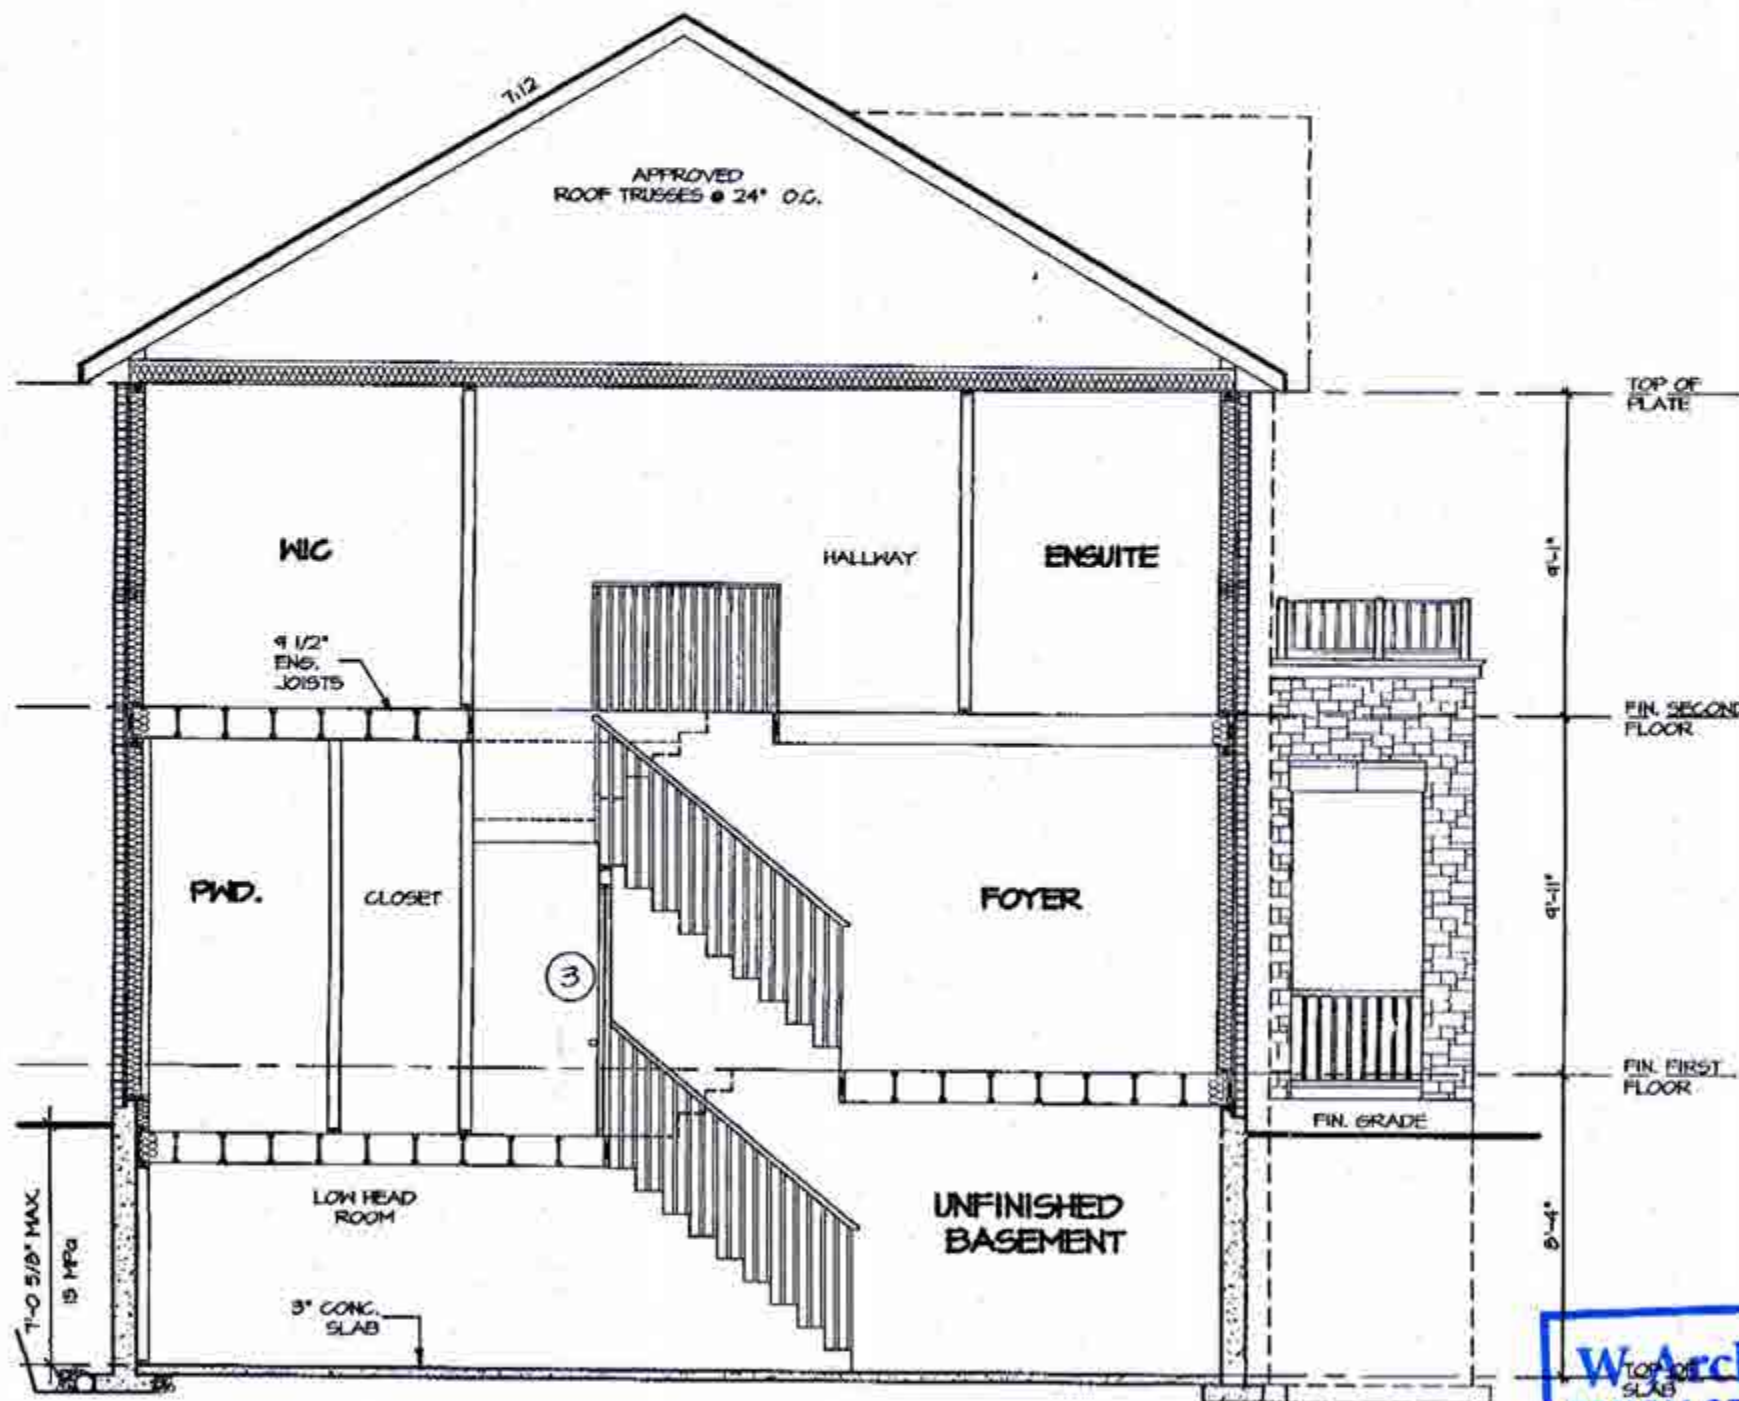

SECTION A-A

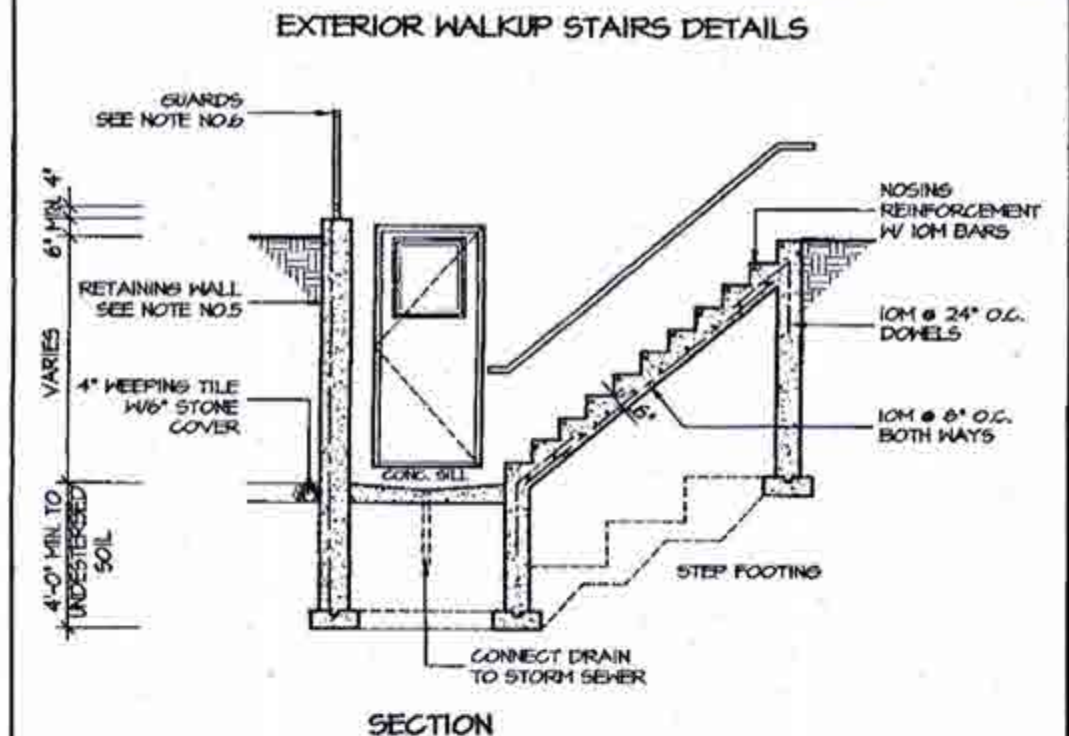

GENERAL NOTES:

1. FOOTING: 24"x24" POURED CONC. FOOTING. ALL FOOTINGS SHALL REST ON NATURAL UNDISTURBED SOIL OR COMPACTED GRANULAR FILL.
2. CONCRETE: MINIMUM COMPRESSIVE STRENGTH OF 32 MPa (4650 psi) @ 28 DAYS W/ 5% TO 8% AIR ENTRAINMENT.
3. EXTERIOR STAIRS: 7 1/8" RISE MAXIMUM, 9 1/4" RUN MINIMUM, 9 1/4" TREAD MINIMUM.
4. INSULATION: FOR INSULATION VALUE & VAPOUR BARRIER LOCATION REFER TO NOTE 13 OF STANDARD NOTES.
5. RETAINING WALL: 10" POURED CONCRETE W/ NO REINFORCING REQUIRED FOR WALL HEIGHTS TO A MAX. OF 4'-7". PROVIDE 15M VERTICAL REINFORCEMENT @ 16" O.C. AND 15M HORIZONTAL REINFORCEMENT @ 24" O.C. FOR WALL HEIGHTS TO 4'-0". RETAINING WALL TO RESIST LATERAL DESIGN LOADS AS PER OBC DIVISION B SECTION 4.1.3.16.
6. GUARDS: 3'-6" HIGH WHERE DISTANCE FROM GRADE TO BOTTOM OF WALKOUT EXCEEDS 5'-11", 2'-11" FOR LESSER HEIGHTS, MAXIMUM 4" BETWEEN VERTICAL PICKETS.



It is the builder's complete responsibility to ensure that all plans submitted for approval fully comply with the Architectural Guidelines and all applicable regulations and requirements including zoning provisions and any provisions in the subdivision agreement. The Control Architect is not responsible in any way for examining or approving site (lotting) plans or working drawings with respect to any zoning or building code or permit matter or that any house can be properly built or located on its lot.

This is to certify that these plans comply with the applicable Architectural Design Guidelines approved by the City of Brampton.

W Architect Inc.
DESIGN CONTROL REVIEW

NOV 13 2018

FINAL BY: *ECC*

(This stamp is only for the purposes of design control and carries no other professional obligations.)



NOV 02 2018

FOR STRUCTURE ONLY

MILLWOOD 12-021

COMPLIANCE PACKAGE "A1"



PROJECT NAME
MINNISALE HOMES CORP.

REVISIONS	
1. REVISED FOR LOT 21	OCT 2018

The undersigned has reviewed and takes responsibility for this design, and has the qualifications and meets the requirements set out in the Ontario Building Code to be a designer.

QUALIFICATION INFORMATION
Required unless design is exempt under Division C, Subsection 3.2.5 of the building code

VIKAS GAJJAR
NAME SIGNATURE

28770
BCIN

REGION DESIGN INC.
5700 DUFFERIN ST.
CONCORD, ONTARIO
L4K 4S8
P (416) 736-4096
F (905) 660-0746

**REGION
DESIGN
INC.**

SHEET TITLE
CROSS SECTION

SCALE
3/16"=1'-0"

DATE
OCT 2018

BY
ZMP

AREA
2617

CONTRACTOR SHALL CHECK ALL DIMENSIONS AND ELEVATIONS BEFORE COMMENCING WITH WORK AND REPORT ANY DISCREPANCIES TO THE DESIGNER. PRINTS ARE NOT TO BE SCALED.

Page No.
8