

LOT 35L

SITE NAME: MINNISALE HOMES CORP

BUILDER: GREENPARK HOMES

TYPE: HEMLOCK 4

GFA: 1960

DATE: Aug-18

LO# 79574

WINTER NATURAL AIR CHANGE RATE 0.367

SUMMER NATURAL AIR CHANGE RATE 0.115

HEAT LOSS AT °F. 74

HEAT GAIN AT °F. 11

CSA-F280-12

SB-12 PACKAGE A1

ROOM USE	EXP. WALL	CLG. HT.	FACTORS	LOSS	GAIN	MBR	ENS	WIC	BED-2	BED-3	BED-4	BATH					
EXP. WALL				29			20	5	29	32	16	8					
CLG. HT.				9			9	9	9	9	9	9					
GRS.WALL AREA				261			180	45	261	288	144	72					
GLAZING				LOSS	GAIN	LOSS	GAIN	LOSS	LOSS	LOSS	LOSS	LOSS	LOSS	GAIN			
NORTH	20.8	15.5	0	0	0	0	0	0	0	0	0	0	0	0	0	0	0
EAST	20.8	41.0	0	0	0	0	0	0	18	374	739	21	436	862	10	208	410
SOUTH	20.8	24.4	0	0	0	0	0	0	0	0	0	0	0	0	0	0	0
WEST	20.8	41.0	18	374	739	14	291	575	0	0	0	0	10	208	244	7	145
SKYLT.	36.4	100.7	0	0	0	0	0	0	0	0	0	0	0	0	0	0	0
DOORS	24.7	3.7	0	0	0	0	0	0	0	0	0	0	0	0	0	0	0
NET EXPOSED WALL	4.4	0.6	243	1069	167	166	723	107	243	1069	157	267	1163	172	124	540	80
NET EXPOSED ROOF WALL ABOVE GR	3.5	0.5	0	0	0	0	0	0	0	0	0	0	0	0	0	0	0
EXPOSED CLG	1.3	0.6	208	261	116	100	125	56	58	63	28	124	155	69	110	138	61
NO ATTIC EXPOSED CLG	2.7	1.2	0	0	0	0	0	0	0	0	0	0	0	0	0	0	0
EXPOSED FLOOR	2.5	0.4	0	0	0	0	0	0	136	339	50	0	0	0	0	0	0
BASEMENT/CRAWL HEAT LOSS																	
SLAB ON GRADE HEAT LOSS																	
SUBTOTAL HT LOSS				1693			1139		2047	1884	1094	559					
SUB TOTAL HT GAIN					1012		738		1069	1161	796	271					
LEVEL FACTOR / MULTIPLIER	0.20	0.29				0.20	0.29		0.20	0.29		0.20	0.29		0.20	0.29	
AIR CHANGE HEAT LOSS				467			328		589	542		161					
AIR CHANGE HEAT GAIN					66		48		70	76		18					
DUCT LOSS				0			0		264	0		0					
DUCT GAIN				0			0		179	0		0					
HEAT GAIN PEOPLE	240		2	480		0	0	0	1	240	1	240	0		0		
HEAT GAIN APPLIANCES/LIGHTS				411		0	0	0	411	411		411			0		
TOTAL HT LOSS BTU/H				2180			1467		2899	2425	1408	720					
TOTAL HT GAIN x 1.3 BTU/H				2560			1022		2560	2455	1949	375					

CITY OF BRAMPTON
BUILDING DIVISION
REVIEWED
JAN 18 2018
HVAC
BY
JOAN LIN

ROOM USE	EXP. WALL	CLG. HT.	FACTORS	LOSS	GAIN	LIV	DIN	KT/PM	LAUN	WIR	FOY	MUD					
EXP. WALL				39			21	47	7	5	11	8					
CLG. HT.				10			10	10	9	10	11	11					
GRS.WALL AREA				371			290	447	63	60	121	88					
GLAZING				LOSS	GAIN	LOSS	GAIN	LOSS	LOSS	LOSS	LOSS	LOSS	LOSS	GAIN			
NORTH	20.8	15.5	0	0	0	0	0	0	0	0	0	0	0	0	0	0	0
EAST	20.8	41.0	34	706	1396	0	0	0	0	0	0	0	0	0	0	0	0
SOUTH	20.8	24.4	0	0	0	23	478	561	9	187	220	0	0	0	0	0	0
WEST	20.8	41.0	0	0	0	0	0	0	0	0	0	0	0	0	0	0	0
SKYLT.	36.4	100.7	0	0	0	0	0	0	0	0	0	0	0	0	0	0	0
DOORS	24.7	3.7	0	0	0	0	0	0	0	0	0	0	0	0	0	0	0
NET EXPOSED WALL	4.4	0.6	337	1466	217	177	789	114	54	235	35	50	218	32	88	383	57
NET EXPOSED ROOF WALL ABOVE GR	3.5	0.5	0	0	0	0	0	0	0	0	0	0	0	0	0	0	0
EXPOSED CLG	1.3	0.6	0	0	0	0	0	0	0	0	0	0	0	0	0	0	0
NO ATTIC EXPOSED CLG	2.7	1.2	0	0	0	0	0	0	0	0	0	0	0	0	0	0	0
EXPOSED FLOOR	2.5	0.4	0	0	0	0	0	0	0	0	0	0	0	0	0	0	0
BASEMENT/CRAWL HEAT LOSS																	
SLAB ON GRADE HEAT LOSS																	
SUBTOTAL HT LOSS				2173			1247		536	243	1147	789					
SUB TOTAL HT GAIN					1613		675		305	43	497	117					
LEVEL FACTOR / MULTIPLIER	0.30	0.43				0.30	0.43		0.20	0.29		0.30	0.43		0.30	0.43	
AIR CHANGE HEAT LOSS				928			533		154	104		337					
AIR CHANGE HEAT GAIN					106		44		20	3		8					
DUCT LOSS				0			0		0	0		0					
DUCT GAIN				0			0		0	0		0					
HEAT GAIN PEOPLE	240		0	0	0	0	0	0	0	0	0	0	0	0	0	0	0
HEAT GAIN APPLIANCES/LIGHTS				411			411		411	411		411			0		
TOTAL HT LOSS BTU/H				3101			1780		690	347	1636	1126					
TOTAL HT GAIN x 1.3 BTU/H				2769			1470		958	60	689	697					

TOTAL HEAT GAIN BTU/H:

24812

TONS: 2.67

LOSS DUE TO VENTILATION LOAD BTU/H: 1993

STRUCTURAL HEAT LOSS: 37747

TOTAL COMBINED HEAT LOSS BTU/H: 39340

Michael O'Rourke

SITE NAME: MINNISSALE HOMES CORP
 BUILDER: GREENPARK HOMES

TYPE: HEMLOCK 4

DATE: Aug-18

GFA: 1960 LO# 79574

 HEATING CFM 1131 COOLING CFM 1131
 TOTAL HEAT LOSS 37,747 TOTAL HEAT GAIN 24,576
 AIR FLOW RATE CFM 29.96 AIR FLOW RATE CFM 46.02

 furnace pressure 0.6
 furnace filter 0.05
 a/c coil pressure 0.2
 available pressure for s/a & r/a 0.35

 #GOODMAN
 GMEC960603BNA 60
 FAN SPEED LOW
 MEDLOW
 MEDIUM
 MEDIUM HIGH
 HIGH 1131

 AFUE = 96 %
 INPUT (BTU/H) = 60,000
 OUTPUT (BTU/H) = 57,800

 DESIGN CFM = 1131
 CFM @ 0.5" E.S.P.

TEMPERATURE RISE 47 °F

RUN COUNT	4th	3rd	2nd	1st	Bas
S/A	0	0	10	9	4
R/A	0	0	4	2	1

 All S/A diffusers 4"x10" unless noted otherwise on layout.
 All S/A runs 5'Ø unless noted otherwise on layout.

RUN #	1	2	3	4	5	6	7	8	10	11	12	13	14	15	16	17	18	19	20	21	22	23	24
ROOM NAME	MBR	ENS	W/C	BED-2	BED-3	BED-4	BATH	BED-2	MBR	MUD	LIV	DIN	LIV	KT/FM	KT/FM	LAUN	W/R	FOY	KT/FM	BAS	BAS	BAS	BAS
RM LOSS MBH	1.09	1.47	0.33	1.45	2.43	1.41	0.72	1.45	1.09	1.13	1.55	1.78	1.55	1.76	1.76	0.69	0.35	1.64	1.76	3.09	3.09	3.09	3.09
CFM PER RUN HEAT	33	44	10	43	73	42	22	43	33	34	46	53	46	53	53	21	10	49	53	93	93	93	93
RM GAIN MBH	1.28	1.02	0.08	1.28	2.46	1.95	0.38	1.28	1.28	0.70	1.38	1.47	1.38	1.86	1.86	0.96	0.06	0.69	1.86	0.34	0.34	0.34	0.34
CFM PER RUN COOLING	59	47	4	59	113	90	17	59	59	32	64	68	64	86	86	44	3	32	86	16	16	16	16
ADJUSTED PRESSURE	0.17	0.17	0.17	0.17	0.15	0.16	0.17	0.17	0.17	0.17	0.17	0.17	0.17	0.16	0.16	0.17	0.17	0.17	0.16	0.16	0.16	0.16	0.16
ACTUAL DUCT LGH	46	57	52	27	35	32	29	5	53	38	29	10	30	34	42	20	38	19	37	25	42	11	24
EQUIVALENT LENGTH	120	130	120	150	160	170	180	160	150	150	180	170	190	140	140	190	120	180	150	150	130	170	170
TOTAL EFFECTIVE LENGTH	166	187	172	177	195	202	209	165	203	188	209	180	220	174	182	210	158	199	187	175	192	141	194
ADJUSTED PRESSURE	0.1	0.09	0.1	0.1	0.08	0.08	0.08	0.1	0.08	0.09	0.08	0.1	0.08	0.09	0.09	0.08	0.11	0.09	0.09	0.09	0.08	0.11	0.08
ROUND DUCT SIZE	5	4	4	5	6	6	4	5	5	4	5	5	5	6	6	4	4	4	6	6	6	6	6
HEATING VELOCITY (F/min)	242	505	115	316	372	214	252	316	242	390	338	389	338	270	270	241	115	562	270	474	474	474	474
COOLING VELOCITY (F/min)	433	539	46	433	576	459	195	433	433	367	470	499	470	438	438	505	34	367	438	82	82	82	82
OUTLET GRILL SIZE	3X10	3X10	3X10	3X10	4X10	4X10	3X10	3X10	3X10	3X10	3X10	3X10	3X10	4X10	4X10	3X10	3X10	3X10	4X10	4X10	4X10	4X10	4X10
TRUNK	A	B	B	E	D	D	E	E	A	B	D	E	D	A	B	E	B	D	B	A	B	E	D

 RUN #
 ROOM NAME
 RM LOSS MBH
 CFM PER RUN HEAT
 RM GAIN MBH
 CFM PER RUN COOLING
 ADJUSTED PRESSURE
 ACTUAL DUCT LGH
 EQUIVALENT LENGTH
 TOTAL EFFECTIVE LENGTH
 ADJUSTED PRESSURE
 ROUND DUCT SIZE
 HEATING VELOCITY (F/min)
 COOLING VELOCITY (F/min)
 OUTLET GRILL SIZE
 TRUNK

 CITY OF BRAMPTON
 BUILDING DIVISION
 REVIEWED

JAN 18 2018

 HVAC
 BY
 JOAN LIN

SUPPLY AIR TRUNK SIZE

TRUNK	STATIC	ROUND	RECT	VELOCITY	TRUNK	STATIC	ROUND	RECT	VELOCITY
CFM	PRESS.	DUCT	DUCT	(F/min)	CFM	PRESS.	DUCT	DUCT	(F/min)
TRUNK A 212	0.08	7.8	8	X 8 477	TRUNK G 0	0.00	0	0	X 8 0
TRUNK B 297	0.08	8.9	10	X 8 535	TRUNK H 0	0.00	0	0	X 8 0
TRUNK C 509	0.08	10.9	14	X 8 654	TRUNK I 0	0.00	0	0	X 8 0
TRUNK D 349	0.08	9.5	12	X 8 524	TRUNK J 0	0.00	0	0	X 8 0
TRUNK E 624	0.08	11.8	16	X 8 702	TRUNK K 0	0.00	0	0	X 8 0
TRUNK F 0	0.00	0	0	X 8 0	TRUNK L 0	0.00	0	0	X 8 0

RETURN AIR TRUNK SIZE

TRUNK	STATIC	ROUND	RECT	VELOCITY
CFM	PRESS.	DUCT	DUCT	(F/min)
TRUNK O 0	0.06	0	0	X 8 0
TRUNK P 0	0.06	0	0	X 8 0
TRUNK Q 0	0.06	0	0	X 8 0
TRUNK R 0	0.06	0	0	X 8 0
TRUNK S 0	0.06	0	0	X 8 0
TRUNK T 0	0.06	0	0	X 8 0
TRUNK U 0	0.06	0	0	X 8 0
TRUNK V 0	0.06	0	0	X 8 0
TRUNK W 0	0.06	0	0	X 8 0
TRUNK X 1131	0.06	15.8	30	X 8 679
TRUNK Y 285	0.06	9.4	10	X 8 513
TRUNK Z 0	0.06	0	0	X 8 0
DROP 1131	0.06	15.8	24	X 10 679

RETURN AIR #	1	2	3	4	5	6																	BR
	0	0	0	0	0	0	0	0	0	0	0	0	0	0	0	0	0	0	0	0	0	0	
AIR VOLUME	135	95	95	155	375	95	0	0	0	0	0	0	0	0	0	0	0	0	0	0	0	0	
PLENUM PRESSURE	0.15	0.15	0.15	0.15	0.15	0.15	0.15	0.15	0.15	0.15	0.15	0.15	0.15	0.15	0.15	0.15	0.15	0.15	0.15	0.15	0.15	0.15	
ACTUAL DUCT LGH	45	37	49	23	21	46	1	1	1	1	1	1	1	1	1	1	1	1	1	1	1	1	
EQUIVALENT LENGTH	140	175	135	235	225	175	0	0	0	0	0	0	0	0	0	0	0	0	0	0	0	0	
TOTAL EFFECTIVE LH	185	212	184	258	246	221	1	1	1	1	1	1	1	1	1	1	1	1	1	1	1	1	
ADJUSTED PRESSURE	0.08	0.07	0.08	0.06	0.06	0.07	14.80	14.80	14.80	14.80	14.80	14.80	14.80	14.80	14.80	14.80	14.80	14.80	14.80	14.80	14.80	14.80	
ROUND DUCT SIZE	6.6	6	5.8	7.5	10.4	6	0	0	0	0	0	0	0	0	0	0	0	0	0	0	0	0	
INLET GRILL SIZE	8	8	8	8	8	8	0	0	0	0	0	0	0	0	0	0	0	0	0	0	0	0	
	X	X	X	X	X	X	X	X	X	X	X	X	X	X	X	X	X	X	X	X	X	X	
INLET GRILL SIZE	14	14	14	14	30	14	0	0	0	0	0	0	0	0	0	0	0	0	0	0	0	0	

TYPE: HEMLOCK 4
SITE NAME: MINNISSALE HOMES CORP

LO # 79574

RESIDENTIAL MECHANICAL VENTILATION DESIGN SUMMARY

COMBUSTION APPLIANCES		9.32.3.1(1)
a) ☐	Direct vent (sealed combustion) only	
b) ☐	Positive venting induced draft (except fireplaces)	
c) ☐	Natural draft, B-vent or induced draft gas fireplace	
d) ☐	Solid Fuel (including fireplaces)	
e) ☐	No Combustion Appliances	

HEATING SYSTEM	
☒	Forced Air
☐	Non Forced Air
☐	Electric Space Heat

HOUSE TYPE		9.32.1(2)
☐	I Type a) or b) appliance only, no solid fuel	
☐	II Type I except with solid fuel (including fireplaces)	
☐	III Any Type c) appliance	
☐	IV Type I, or II with electric space heat	
☐	Other: Type I, II or IV no forced air	

SYSTEM DESIGN OPTIONS		O.N.H.W.P.
☐	1 Exhaust only/Forced Air System	
☐	2 HRV with Ducting/Forced Air System	
☐	3 HRV Simplified/connected to forced air system	
☐	4 HRV with Ducting/non forced air system	
☐	Part 6 Design	

TOTAL VENTILATION CAPACITY		9.32.3.3(1)
Basement + Master Bedroom	3 @ 21.2 cfm	63.6 cfm
Other Bedrooms	3 @ 10.6 cfm	31.8 cfm
Kitchen & Bathrooms	4 @ 10.6 cfm	42.4 cfm
Other Rooms	5 @ 10.6 cfm	53.0 cfm
Table 9.32.3.A. TOTAL		190.8 cfm

PRINCIPAL VENTILATION CAPACITY REQUIRED		9.32.3.4(1)
1 Bedroom	31.8	cfm
2 Bedroom	47.7	cfm
3 Bedroom	63.6	cfm
4 Bedroom	79.5	cfm
5 Bedroom	95.4	cfm
TOTAL		79.5 cfm

SUPPLEMENTAL VENTILATION CAPACITY		9.32.3.6.
Total Ventilation Capacity	190.8	cfm
Less Principal Ventil. Capacity	79.5	cfm
Required Supplemental Capacity	111.3	cfm

PRINCIPAL EXHAUST FAN CAPACITY	
Model: VANEE 65H	Location: BSMT
79.5 cfm	3.0 sones
☒ HVI Approved	

PRINCIPAL EXHAUST HEAT LOSS CALCULATION			
CFM	ΔT °F	Factor	% Loss
79.5 CFM	74 F	1.08	0.25

SUPPLEMENTAL FANS		PANASONIC	
Location	Model	cfm	HVI
ENS	FV-05-11VK1	50	☒
BATH	FV-05-11VK1	50	☒
W/R	FV-05-11VK1	50	☒

HEAT RECOVERY VENTILATOR		9.32.3.11.
Model: VANEE 65H		
155 cfm high	64 cfm low	
75 % Sensible Efficiency	☒ HVI Approved	

LOCATION OF INSTALLATION	
Lot:	Concession
Township:	Plan:
Address:	
Roll #	Building Permit #

BUILDER:	
GREENPARK HOMES	
Name:	
Address:	
City:	
Telephone #:	Fax #:

INSTALLING CONTRACTOR	
Name:	
Address:	
City:	
Telephone #:	Fax #:

DESIGNER CERTIFICATION	
I hereby certify that this ventilation system has been designed in accordance with the Ontario Building Code.	
Name:	HVAC Designs Ltd.
Signature:	<i>Michael O'Rourke</i>
HRAI #	001820
Date:	August-18

CSA F280-12 Residential Heat Loss and Heat Gain Calculations
Formula Sheet (For Air Leakage / Ventilation Calculation)

LO#: 79574

Model: HEMLOCK 4

Builder: GREENPARK HOMES

Date: 8/7/2018

Volume Calculation
House Volume

Level	Floor Area (ft²)	Floor Height (ft)	Volume (ft³)
Bsmt	956	9	8604
First	956	10	9560
Second	1004	9	9036
Third	0	9	0
Fourth	0	9	0
Total:			27,200.0 ft³
Total:			770.2 m³

Air Change & Delta T Data

WINTER NATURAL AIR CHANGE RATE	0.367
SUMMER NATURAL AIR CHANGE RATE	0.115

Design Temperature Difference				
	Tin °C	Tout °C	ΔT °C	ΔT °F
Winter DTDh	22	-19	41	74
Summer DTDc	24	30	6	11

5.2.3.1 Heat Loss due to Air Leakage

$$HL_{airb} = LR_{airh} \times \frac{V_b}{3.6} \times DTD_h \times 1.2$$

0.367 x 213.95 x 41 °C x 1.2 = 3881 W

= 13241 Btu/h

6.2.6 Sensible Gain due to Air Leakage

$$HG_{salb} = LR_{aire} \times \frac{V_b}{3.6} \times DTD_c \times 1.2$$

0.115 x 213.95 x 6 °C x 1.2 = 180 W

= 615 Btu/h

5.2.3.2 Heat Loss due to Mechanical Ventilation

$$HL_{vairb} = PVC \times DTD_h \times 1.08 \times (1 - E)$$

80 CFM x 74 °F x 1.08 x 0.25 = 1593 Btu/h

6.2.7 Sensible heat Gain due to Ventilation

$$HL_{vairb} = PVC \times DTD_h \times 1.08 \times (1 - E)$$

80 CFM x 11 °F x 1.08 x 0.25 = 236 Btu/h

5.2.3.3 Calculation of Air Change Heat Loss for Each Room (Floor Multiplier Section)

$$HL_{airr} = \text{Level Factor} \times HL_{airbv} \times ((HL_{agcr} + HL_{bgcr}) \div (HL_{agclevel} + HL_{bgclevel}))$$

Level	Level Factor (LF)	HLairbv Air Leakage + Ventilation Heat Loss (Btu/h)	Level Conductive Heat Loss: (HL _{level})	Air Leakage Heat Loss Multiplier (LF x HLairbv / HLlevel)
1	0.5	13,241	5,733	1.155
2	0.3		9,299	0.427
3	0.2		9,211	0.288
4	0		0	0.000
5	0		0	0.000

*HLairbv = Air leakage heat loss + ventilation heat loss

*For a balanced or supply only ventilation system HLairve = 0

**CITY OF BRAMPTON
BUILDING DIVISION
REVIEWED
JAN 18 2018
HVAC
BY
JOAN LIN**

HEAT LOSS AND GAIN SUMMARY SHEET**MODEL:** HEMLOCK 4**SFQT:** 1960**LO#** 79574**BUILDER:** GREENPARK HOMES**SITE:** MINNISSALE HOMES CORP**DESIGN ASSUMPTIONS**

HEATING	*F	COOLING	*F
OUTDOOR DESIGN TEMP.	-2	OUTDOOR DESIGN TEMP.	86
INDOOR DESIGN TEMP.	72	INDOOR DESIGN TEMP. (MAX 75°F)	75

BUILDING DATA

ATTACHMENT:	ATTACHED	# OF STORIES (+BASEMENT):	3
FRONT FACES:	EAST	ASSUMED (Y/N):	Y
AIR CHANGES PER HOUR:	3.57	ASSUMED (Y/N):	Y
AIR TIGHTNESS CATEGORY:	AVERAGE	ASSUMED (Y/N):	Y
WIND EXPOSURE:	SHELTERED	ASSUMED (Y/N):	Y
HOUSE VOLUME (ft³):	27200.0	ASSUMED (Y/N):	Y
INTERNAL SHADING:	BLINDS/CURTAINS	ASSUMED OCCUPANTS:	5
INTERIOR LIGHTING LOAD (Btu/h/ft²):	1.27	DC BRUSHLESS MOTOR (Y/N):	Y
FOUNDATION CONFIGURATION	BCIN_1	DEPTH BELOW GRADE:	6.0 ft
LENGTH: 50.0 ft	WIDTH: 26.0 ft	EXPOSED PERIMETER:	102.0 ft

2012 OBC - COMPLIANCE PACKAGE**Component**

Ceiling with Attic Space Minimum RSI (R)-Value
Ceiling Without Attic Space Minimum RSI (R)-Value
Exposed Floor Minimum RSI (R)-Value
Walls Above Grade Minimum RSI (R)-Value
Basement Walls Minimum RSI (R)-Value
Below Grade Slab Entire surface > 600 mm below grade Minimum RSI (R)-Value
Edge of Below Grade Slab ≤ 600 mm Below Grade Minimum RSI (R)-Value
Heated Slab or Slab ≤ 600 mm below grade Minimum RSI (R)-Value
Windows and Sliding Glass Doors Maximum U-Value
Skylights Maximum U-Value
Space Heating Equipment Minimum AFUE
HRV Minimum Efficiency
Domestic Hot Water Heater Minimum EF

**CITY OF BRAMPTON
BUILDING DIVISION
REVIEWED****JAN 18 2018****H V A C
BY
JOAN LIN****Compliance Package
A1**

Nominal	Min. Eff.
60	59.22
31	27.65
31	29.80
22	17.03
20 ci	21.12
-	-
10	10
10	11.13
0.28	-
0.49	-
0.96	-
75%	-
0.8	-


INDIVIDUAL BCIN: 19669

MICHAEL O'ROURKE

Michael O'Rourke

Residential Foundation Thermal Load Calculator

Supplemental tool for CAN/CSA-F280

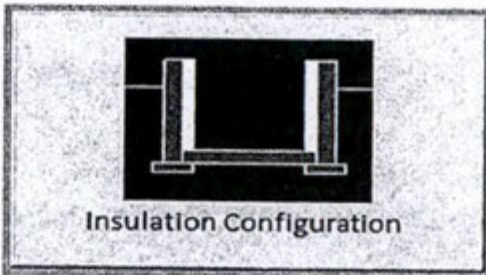Weather Station Description		
Province:	Ontario	
Region:	Brampton	
Site Description		
Soil Conductivity:	Normal conductivity: dry sand, loam, clay	
Water Table:	Normal (7-10 m, 23-33 ft)	
Foundation Dimensions		
Floor Length (m):	15.2	 Insulation Configuration
Floor Width (m):	7.9	
Exposed Perimeter (m):	31.1	
Wall Height (m):	2.7	
Depth Below Grade (m):	1.83	
Window Area (m ²):	1.9	
Door Area (m ²):	3.7	
Radiant Slab		
Heated Fraction of the Slab:	0	CITY OF BRAMPTON BUILDING DIVISION REVIEWED JAN 18 2018 H V A C BY JOAN LIN
Fluid Temperature (°C):	33	
Design Months		
Heating Month	1	
Foundation Loads		
Heating Load (Watts):	988	

TYPE: HEMLOCK 4
LO# 79574

Air Infiltration Residential Load Calculator


Supplemental tool for CAN/CSA-F280


Weather Station Description			
Province:	Ontario		
Region:	Brampton		
Weather Station Location:	Open flat terrain, grass		
Anemometer height (m):	10		
Local Shielding			
Building Site:	Suburban, forest		
Walls:	Heavy		
Flue:	Heavy		
Highest Ceiling Height (m):	7.62		
Building Configuration			
Type:	Semi		
Number of Stories:	Two		
Foundation:	Full		
House Volume (m ³):	770.2		
Air Leakage/Ventilation			
Air Tightness Type:	Present (1961-) (3.57 ACH)		
Custom BDT Data:	ELA @ 10 Pa.	1026.7 cm ²	
	3.57	ACH @ 50 Pa	
Mechanical Ventilation (L/s):	Total Supply	Total Exhaust	
	37.5	37.5	
Flue Size			
Flue #:	#1	#2	#3
Diameter (mm):	0	0	0
Natural Infiltration Rates			
Heating Air Leakage Rate (ACH/H):	0.367		
Cooling Air Leakage Rate (ACH/H):	0.115		

TYPE: HEMLOCK 4
LO# 79574CITY OF BRAMPTON
BUILDING DIVISION
REVIEWED

JAN 18 2018

H V A C
BY
JOAN LIN

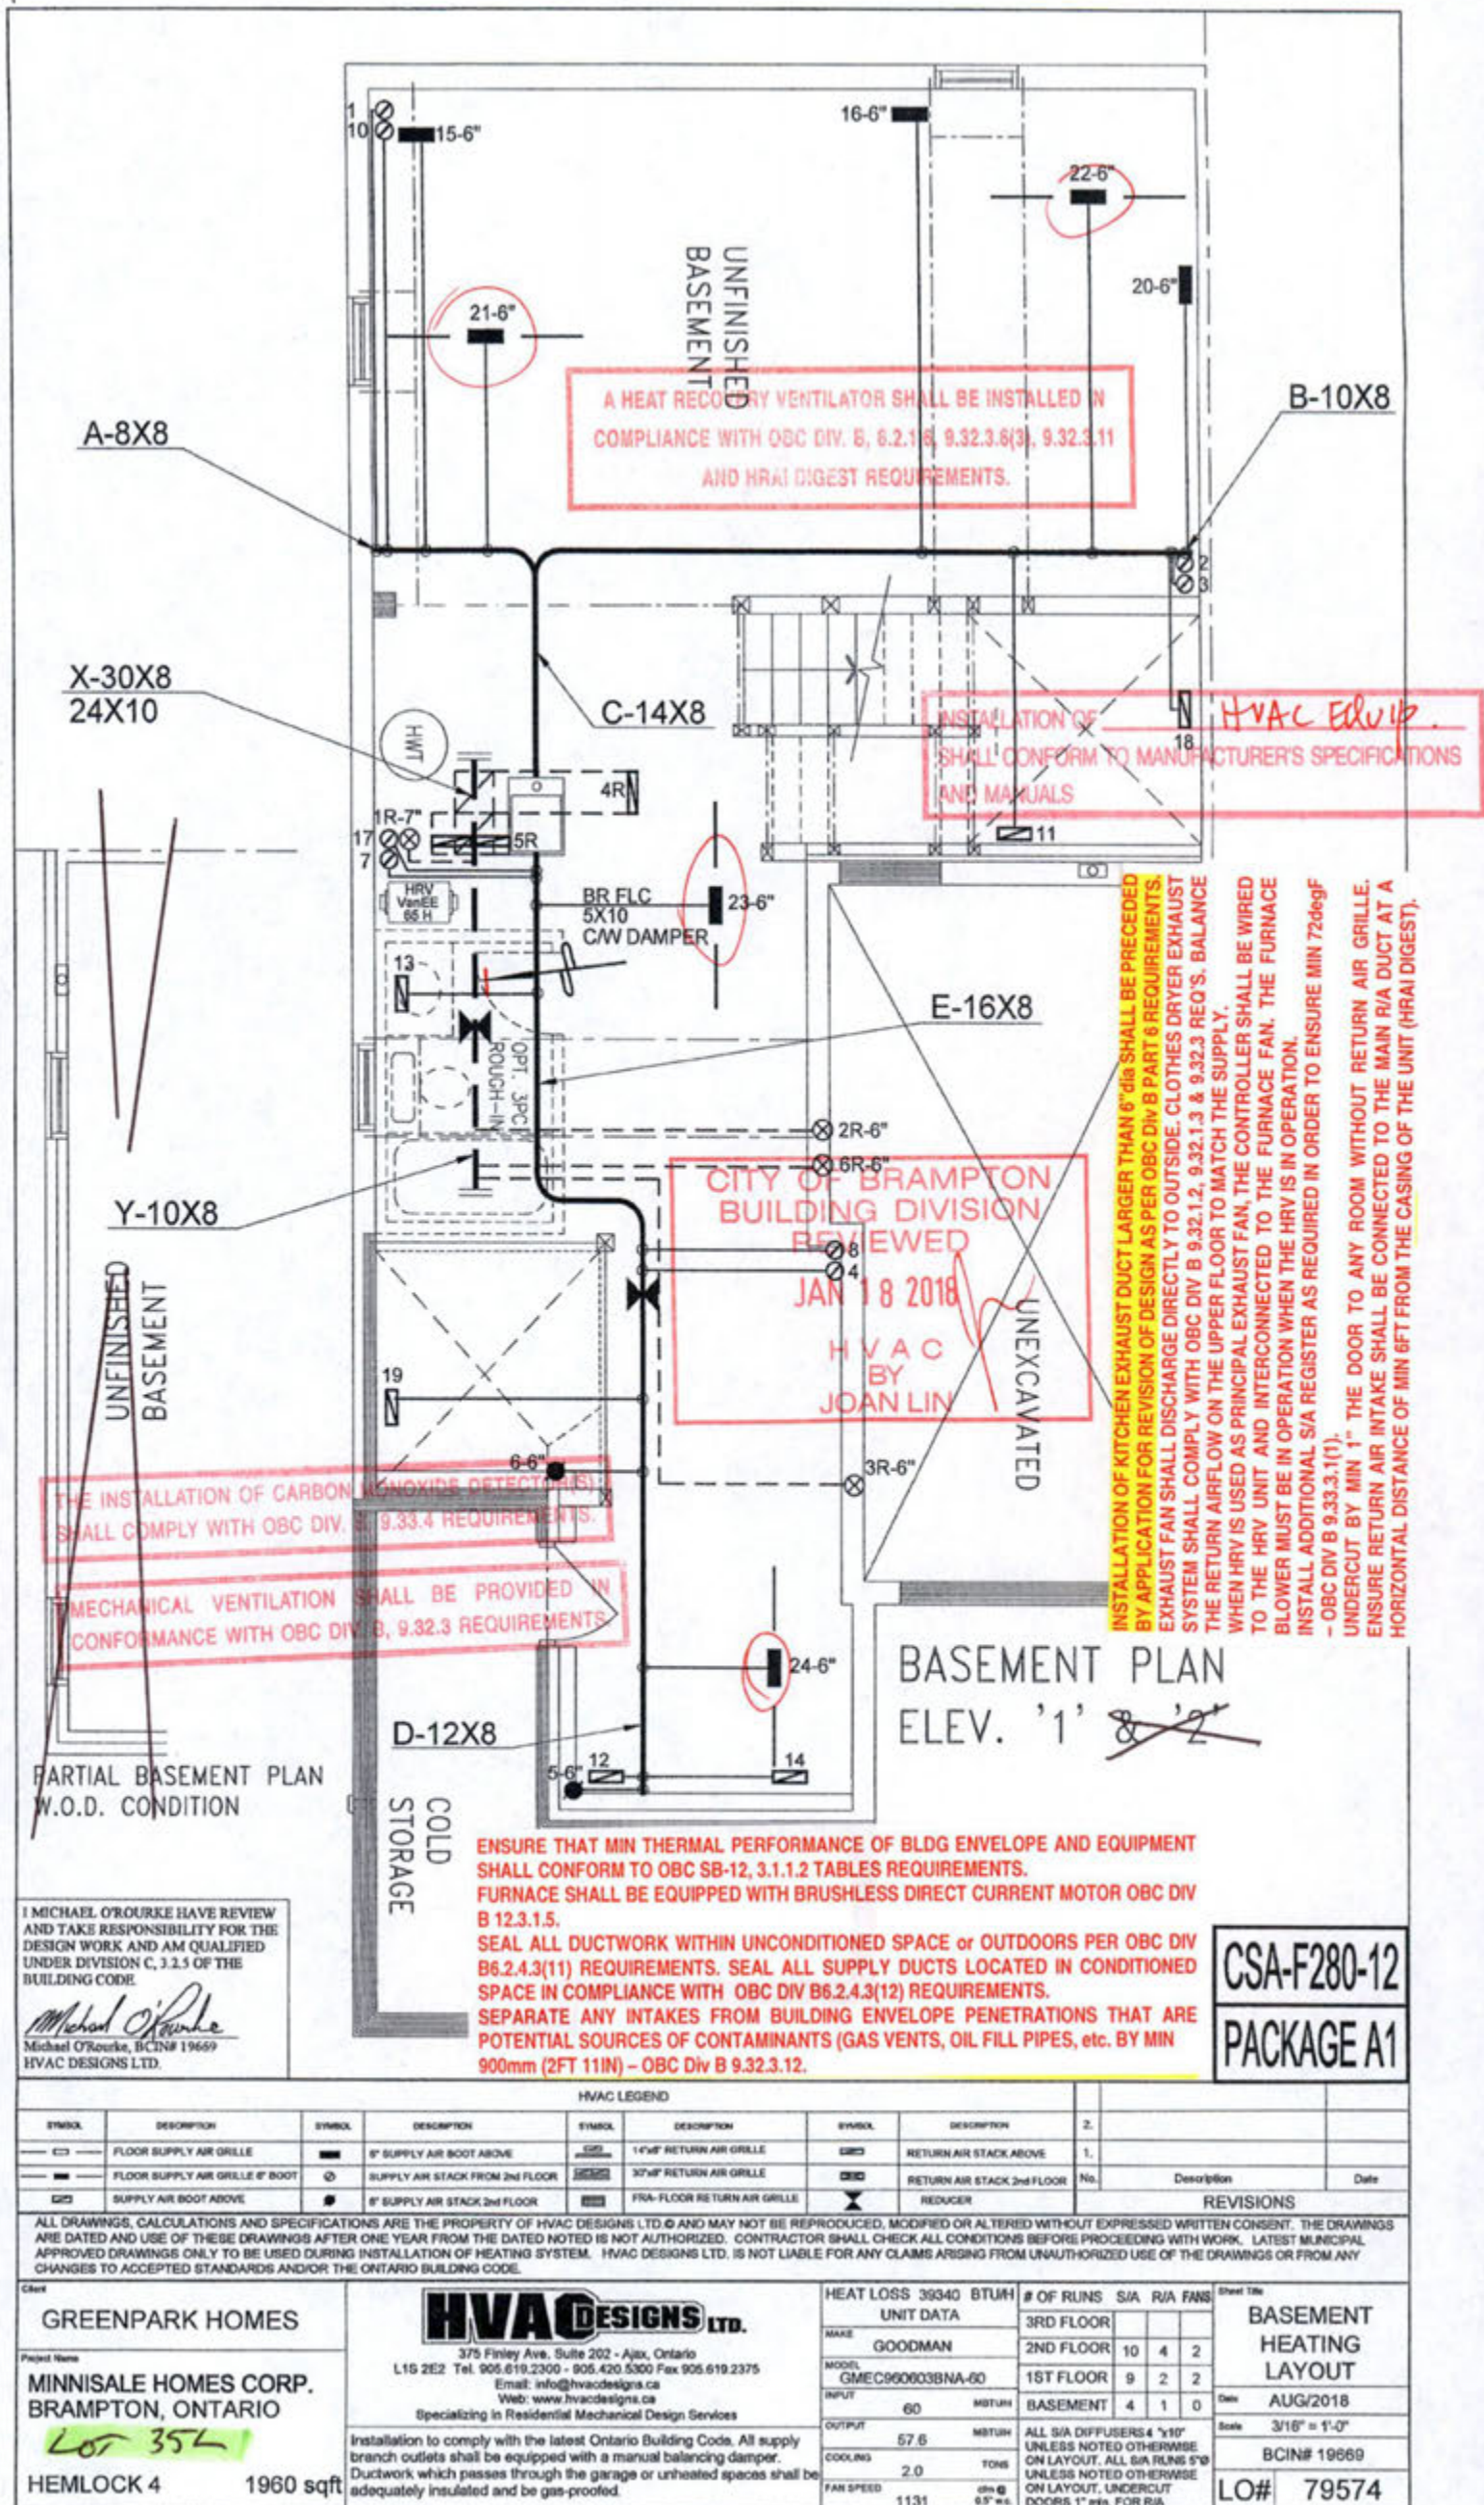

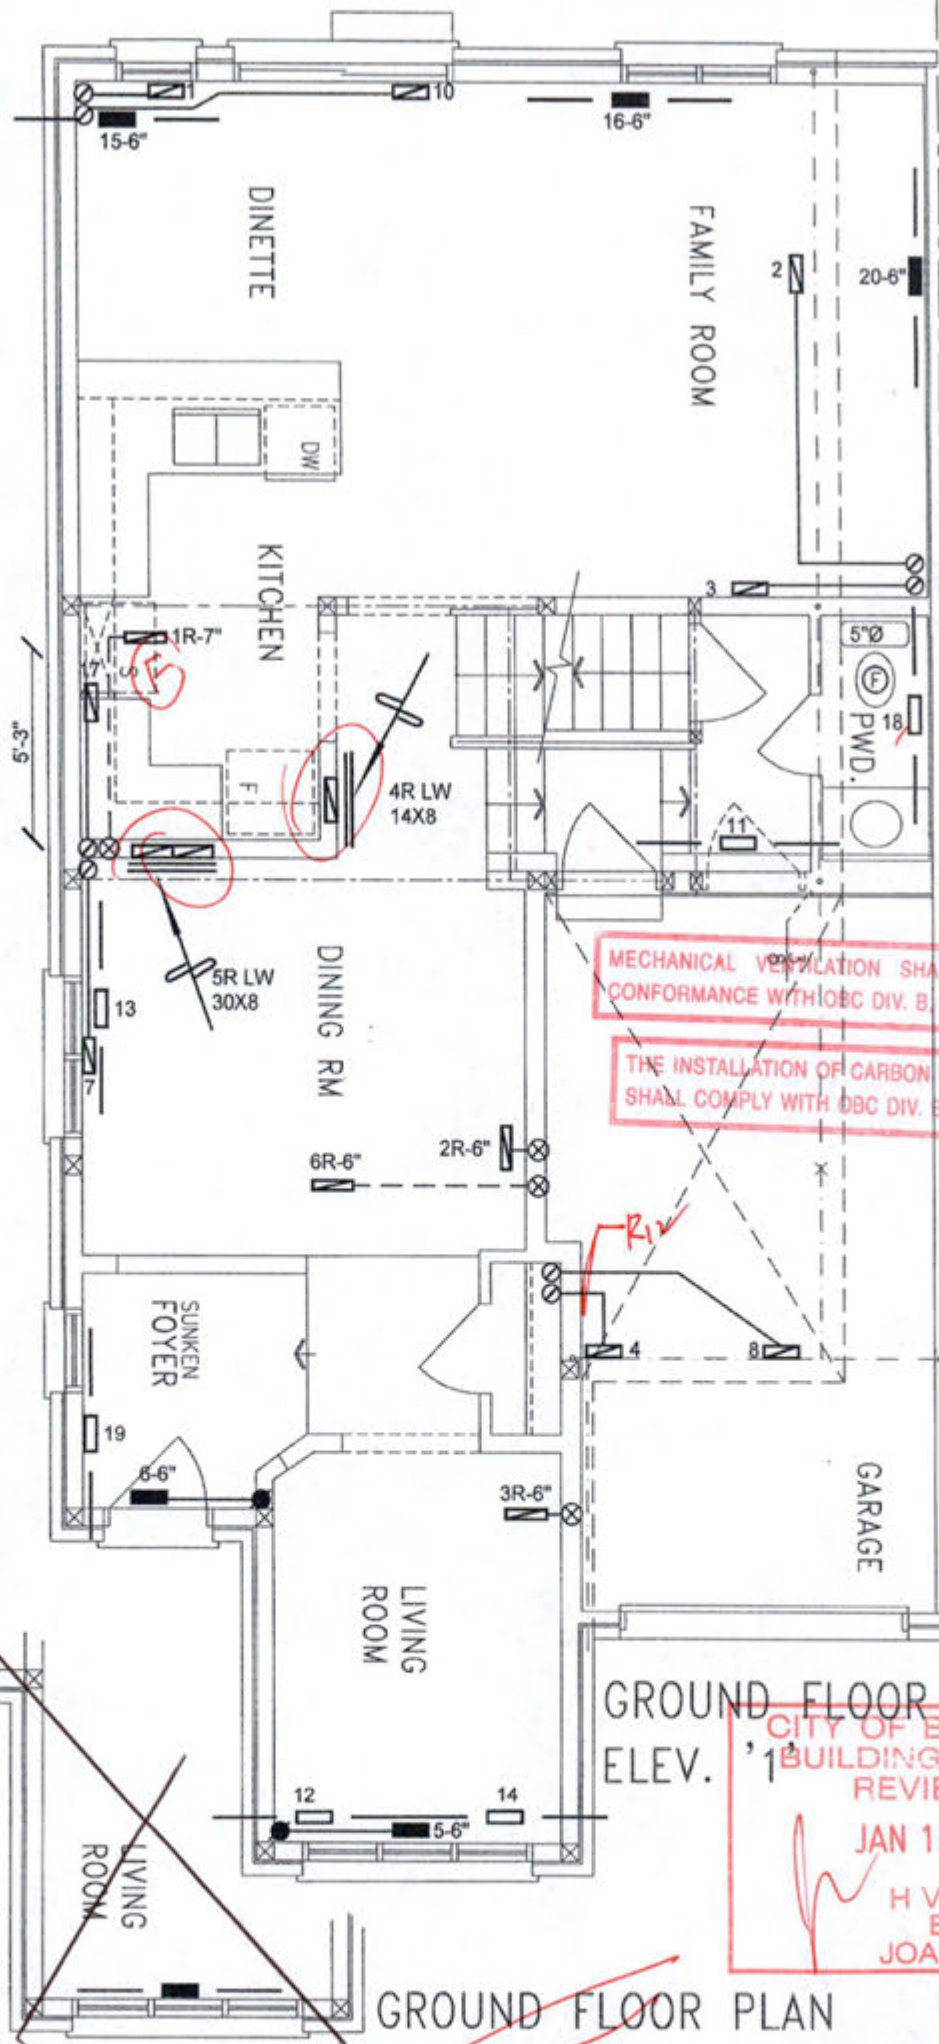

I MICHAEL O'ROURKE HAVE REVIEW AND TAKE RESPONSIBILITY FOR THE DESIGN WORK AND AM QUALIFIED UNDER DIVISION C, 3.2.5 OF THE BUILDING CODE.

Michael O'Rourke
 Michael O'Rourke, BCIN# 19669
 HVAC DESIGNS LTD.


GROUND FLOOR PLAN
ELEV. '2'

CSA-F280-12
PACKAGE A1

HVAC LEGEND					
SYMBOL	DESCRIPTION	SYMBOL	DESCRIPTION	SYMBOL	DESCRIPTION
	FLOOR SUPPLY AIR GRILLE		8" SUPPLY AIR BOOT ABOVE		14" RETURN AIR GRILLE
	FLOOR SUPPLY AIR GRILLE 8" BOOT		SUPPLY AIR STACK FROM 2nd FLOOR		30" RETURN AIR GRILLE
	SUPPLY AIR BOOT ABOVE		8" SUPPLY AIR STACK 3rd FLOOR		RETURN AIR STACK 2nd FLOOR
			FRA-FLOOR RETURN AIR GRILLE		REDUCER

ALL DRAWINGS, CALCULATIONS AND SPECIFICATIONS ARE THE PROPERTY OF HVAC DESIGNS LTD. AND MAY NOT BE REPRODUCED, MODIFIED OR ALTERED WITHOUT EXPRESSED WRITTEN CONSENT. THE DRAWINGS ARE DATED AND USE OF THESE DRAWINGS AFTER ONE YEAR FROM THE DATED NOTED IS NOT AUTHORIZED. CONTRACTOR SHALL CHECK ALL CONDITIONS BEFORE PROCEEDING WITH WORK. LATEST MUNICIPAL APPROVED DRAWINGS ONLY TO BE USED DURING INSTALLATION OF HEATING SYSTEM. HVAC DESIGNS LTD. IS NOT LIABLE FOR ANY CLAIMS ARISING FROM UNAUTHORIZED USE OF THE DRAWINGS OR FROM ANY CHANGES TO ACCEPTED STANDARDS AND/OR THE ONTARIO BUILDING CODE.

Client GREENPARK HOMES		HVACDESIGNS LTD. 375 Finley Ave. Suite 202 - Ajax, Ontario L1S 2E2 Tel. 905.619.2300 - 905.420.5300 Fax 905.619.2375 Email: info@hvacdesigns.ca Web: www.hvacdesigns.ca Specializing in Residential Mechanical Design Services	Sheet Title FIRST FLOOR HEATING LAYOUT	
Project Name MINNISALE HOMES CORP. BRAMPTON, ONTARIO Lot 35L HEMLOCK 4 1960 sqft			Date AUG/2018	
		Installation to comply with the latest Ontario Building Code. All supply branch outlets shall be equipped with a manual balancing damper. Ductwork which passes through the garage or unheated spaces shall be adequately insulated and be gas-proofed.	Scale 3/16" = 1'-0"	
			BCIN# 19669	
			LO# 79574	

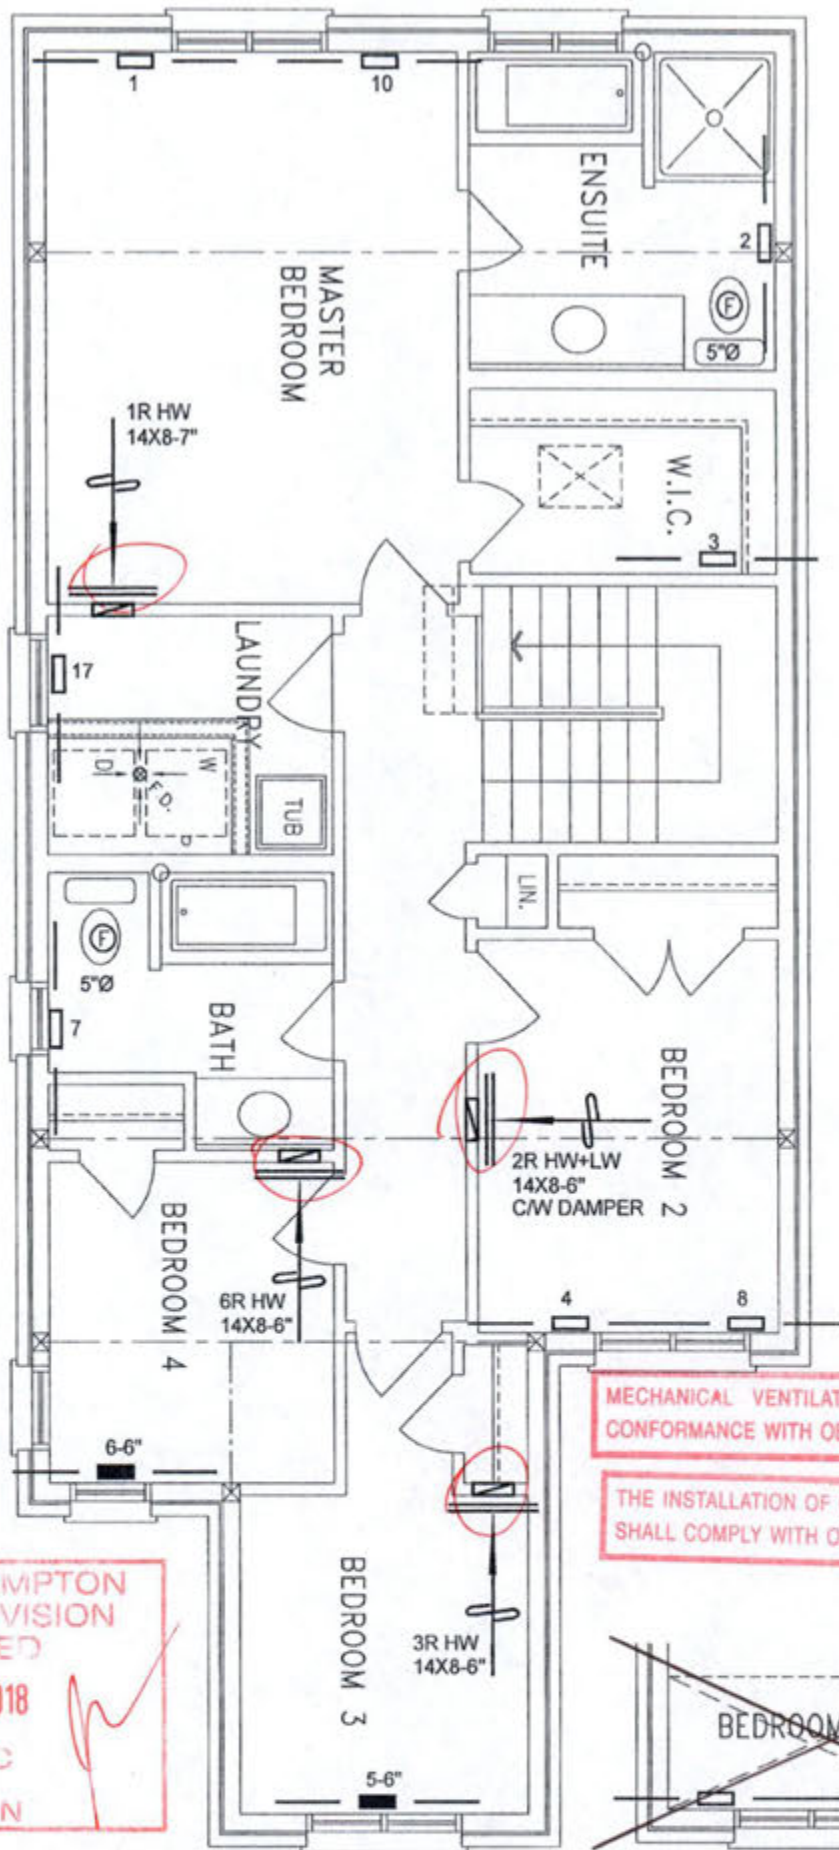

MECHANICAL VENTILATION SHALL BE PROVIDED IN CONFORMANCE WITH OBC DIV. B, 9.32.3 REQUIREMENTS.

THE INSTALLATION OF CARBON MONOXIDE DETECTOR(S) SHALL COMPLY WITH OBC DIV. B, 9.33.4 REQUIREMENTS.

CITY OF BRAMPTON
BUILDING DIVISION
REVIEWED
JAN 18 2018
HVAC
BY
JOAN LIN

SECOND FLOOR PLAN
ELEV. '1'

SECOND FLOOR PLAN
ELEV. '2'

CSA-F280-12
PACKAGE A1

I MICHAEL O'ROURKE HAVE REVIEW AND TAKE RESPONSIBILITY FOR THE DESIGN WORK AND AM QUALIFIED UNDER DIVISION C, 1.2.5 OF THE BUILDING CODE.
Michael O'Rourke
Michael O'Rourke, BCIN# 19669
HVAC DESIGNS LTD.

HVAC LEGEND							
	FLOOR SUPPLY AIR GRILLE		6" SUPPLY AIR BOOT ABOVE		14"x8" RETURN AIR GRILLE		RETURN AIR STACK ABOVE
	FLOOR SUPPLY AIR GRILLE 6" BOOT		SUPPLY AIR STACK FROM 2nd FLOOR		30"x8" RETURN AIR GRILLE		RETURN AIR STACK 2nd FLOOR
	SUPPLY AIR BOOT ABOVE		6" SUPPLY AIR STACK 2nd FLOOR		FRA-FLOOR RETURN AIR GRILLE		REDUCER

ALL DRAWINGS, CALCULATIONS AND SPECIFICATIONS ARE THE PROPERTY OF HVAC DESIGNS LTD. AND MAY NOT BE REPRODUCED, MODIFIED OR ALTERED WITHOUT EXPRESSED WRITTEN CONSENT. THE DRAWINGS ARE DATED AND USE OF THESE DRAWINGS AFTER ONE YEAR FROM THE DATED NOTED IS NOT AUTHORIZED. CONTRACTOR SHALL CHECK ALL CONDITIONS BEFORE PROCEEDING WITH WORK. LATEST MUNICIPAL APPROVED DRAWINGS ONLY TO BE USED DURING INSTALLATION OF HEATING SYSTEM. HVAC DESIGNS LTD. IS NOT LIABLE FOR ANY CLAIMS ARISING FROM UNAUTHORIZED USE OF THE DRAWINGS OR FROM ANY CHANGES TO ACCEPTED STANDARDS AND/OR THE ONTARIO BUILDING CODE.

Client GREENPARK HOMES		HVACDESIGNS LTD. 375 Finley Ave. Suite 202 - Ajax, Ontario L1B 2E2 Tel. 905.619.2300 - 905.420.5300 Fax 905.619.2375 Email: info@hvacedesigns.ca Web: www.hvacedesigns.ca Specializing in Residential Mechanical Design Services Installation to comply with the latest Ontario Building Code. All supply branch outlets shall be equipped with a manual balancing damper. Ductwork which passes through the garage or unheated spaces shall be adequately insulated and be gas-proofed.	Sheet Title SECOND FLOOR HEATING LAYOUT	
Project Name MINNISALE HOMES CORP. BRAMPTON, ONTARIO LOT 354			Date AUG/2018	
HEMLOCK 4 1960 sqft			Scale 3/16" = 1'-0"	
			BCIN# 19669	
			LO# 79574	

Installation to comply with the latest Ontario Building Code. All supply branch outlets shall be equipped with a manual balancing damper. Ductwork which passes through the garage or unheated spaces shall be adequately insulated and be gas-proofed.