



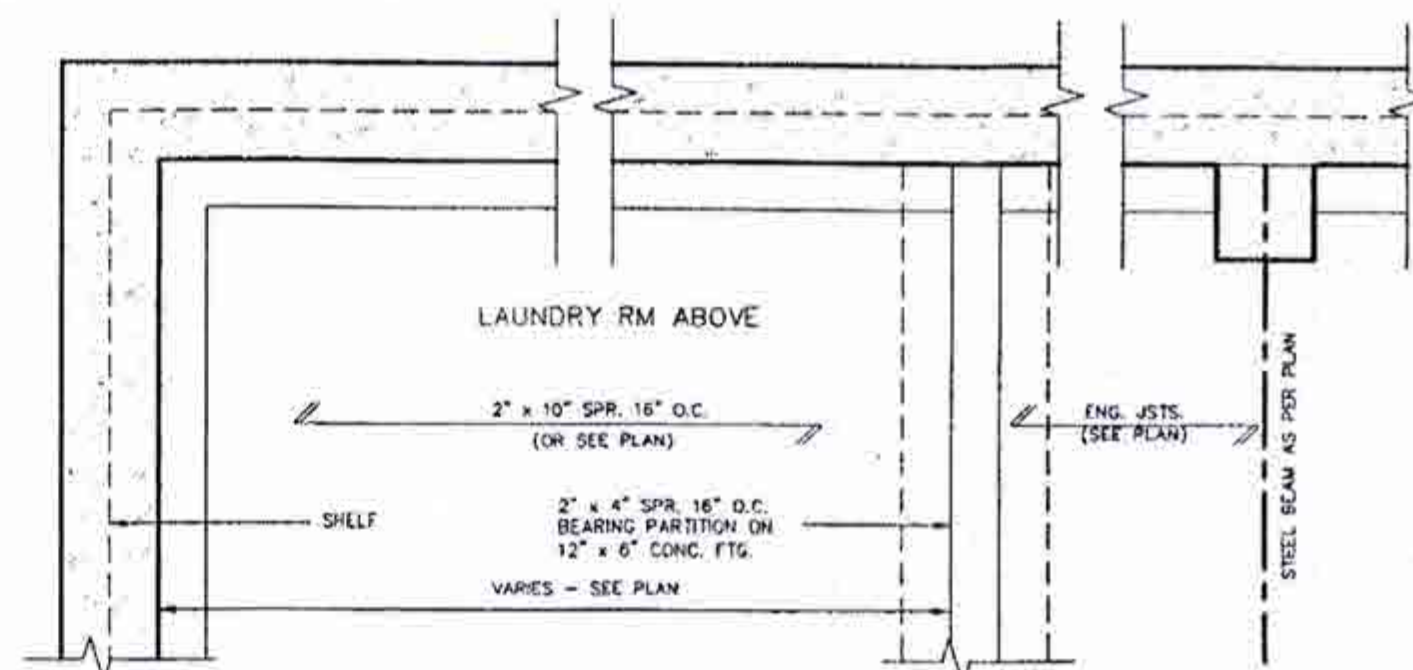

PARTIAL FOUNDATION PLAN

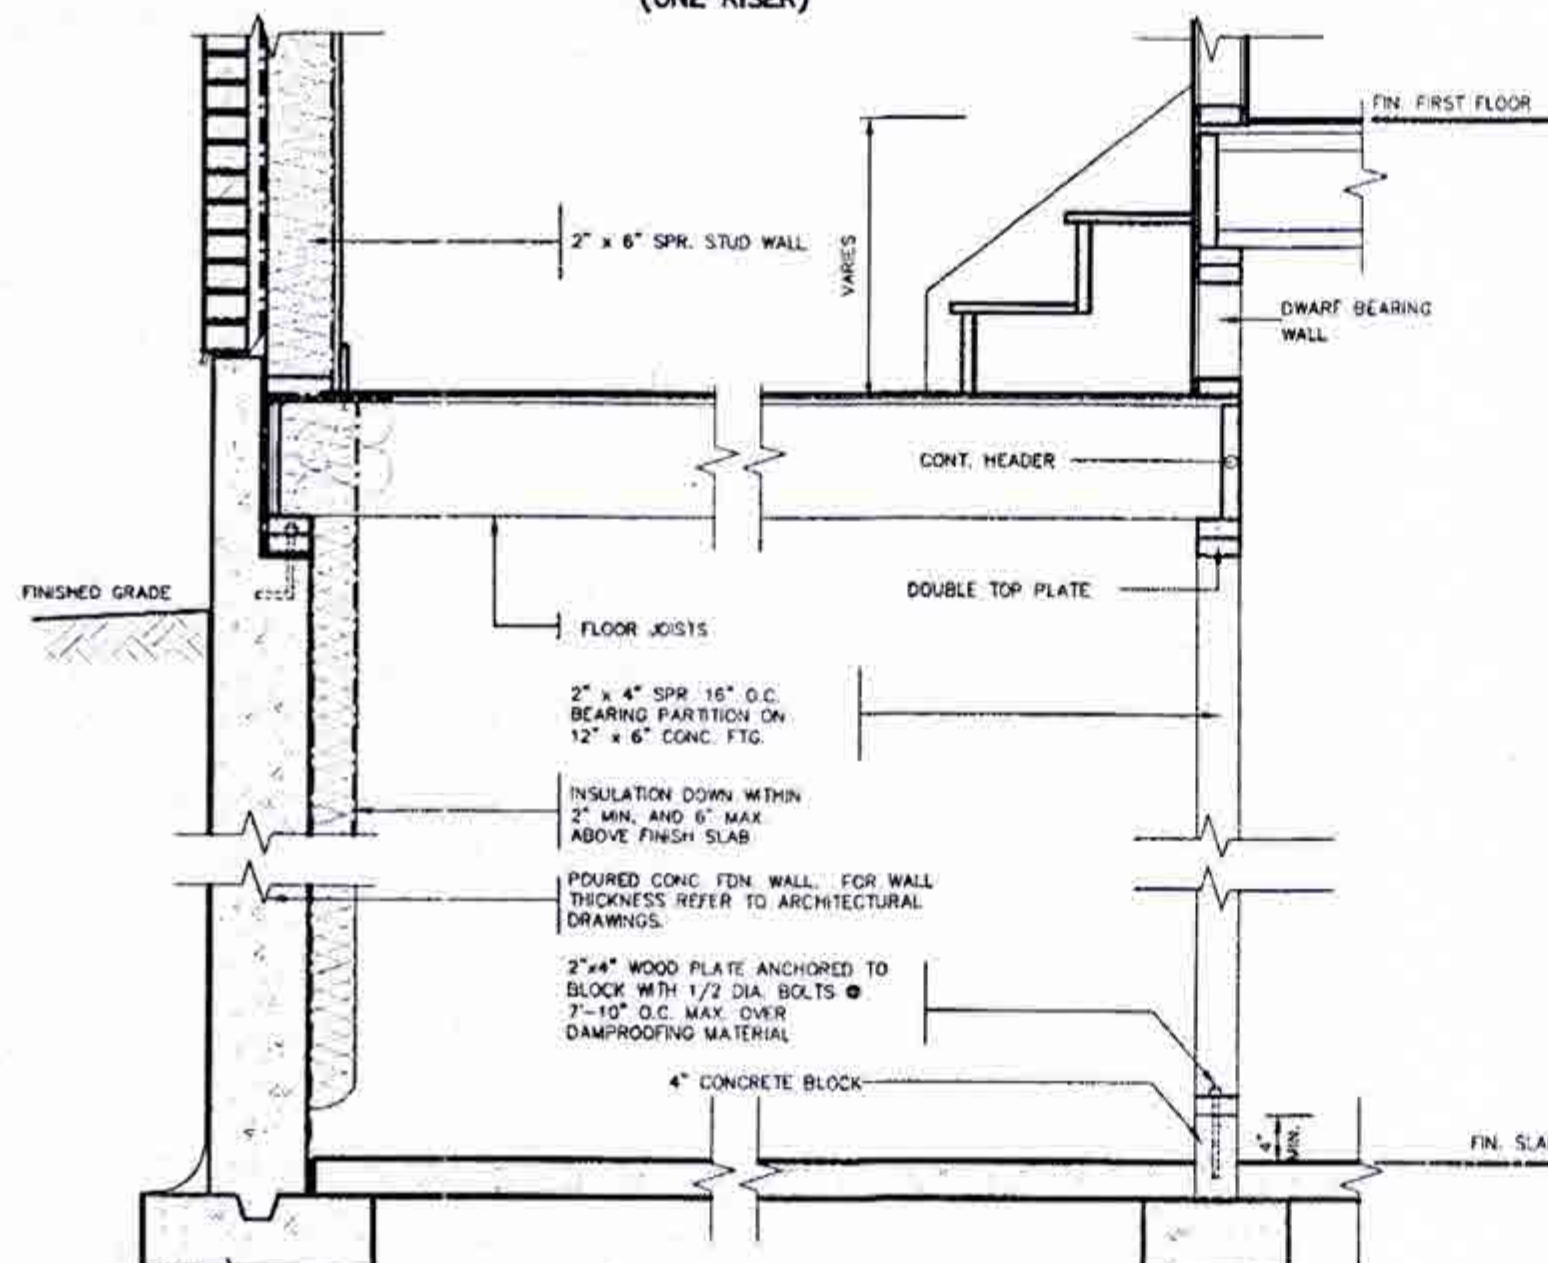




DETAIL OF SUNKEN LAUNDRY/ENTRY
(MORE THAN ONE RISER)



STRUDET INC.
FOR STRUCTURE ONLY

2012 CODE
COMPLIANCE PACKAGE A1

[illegible]

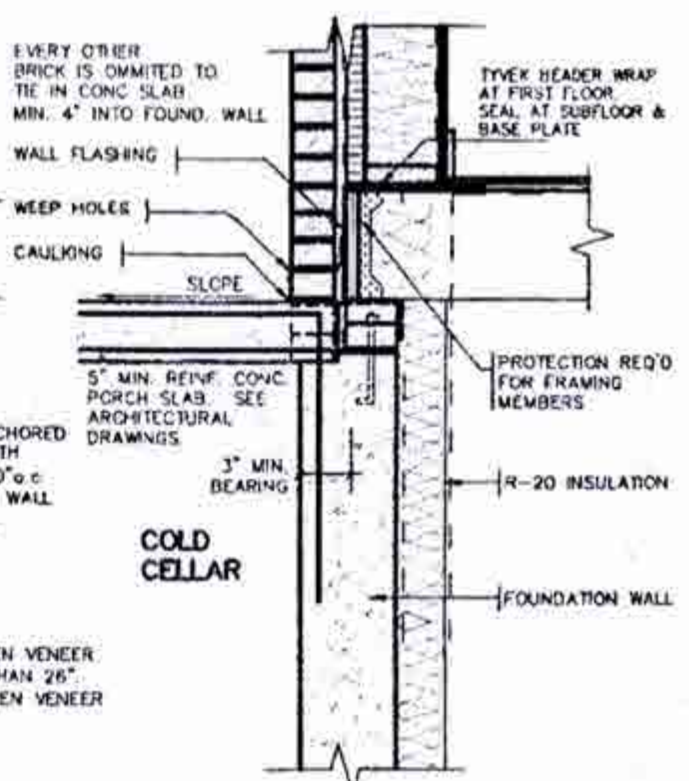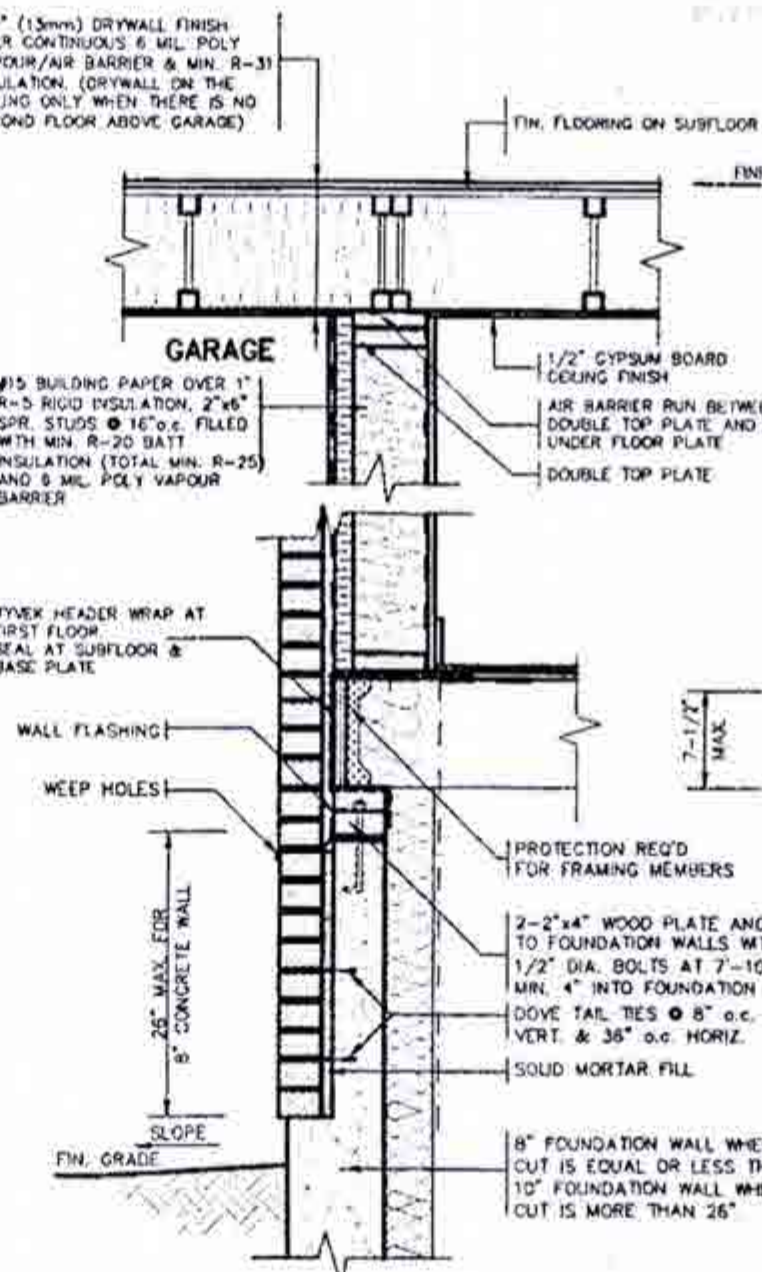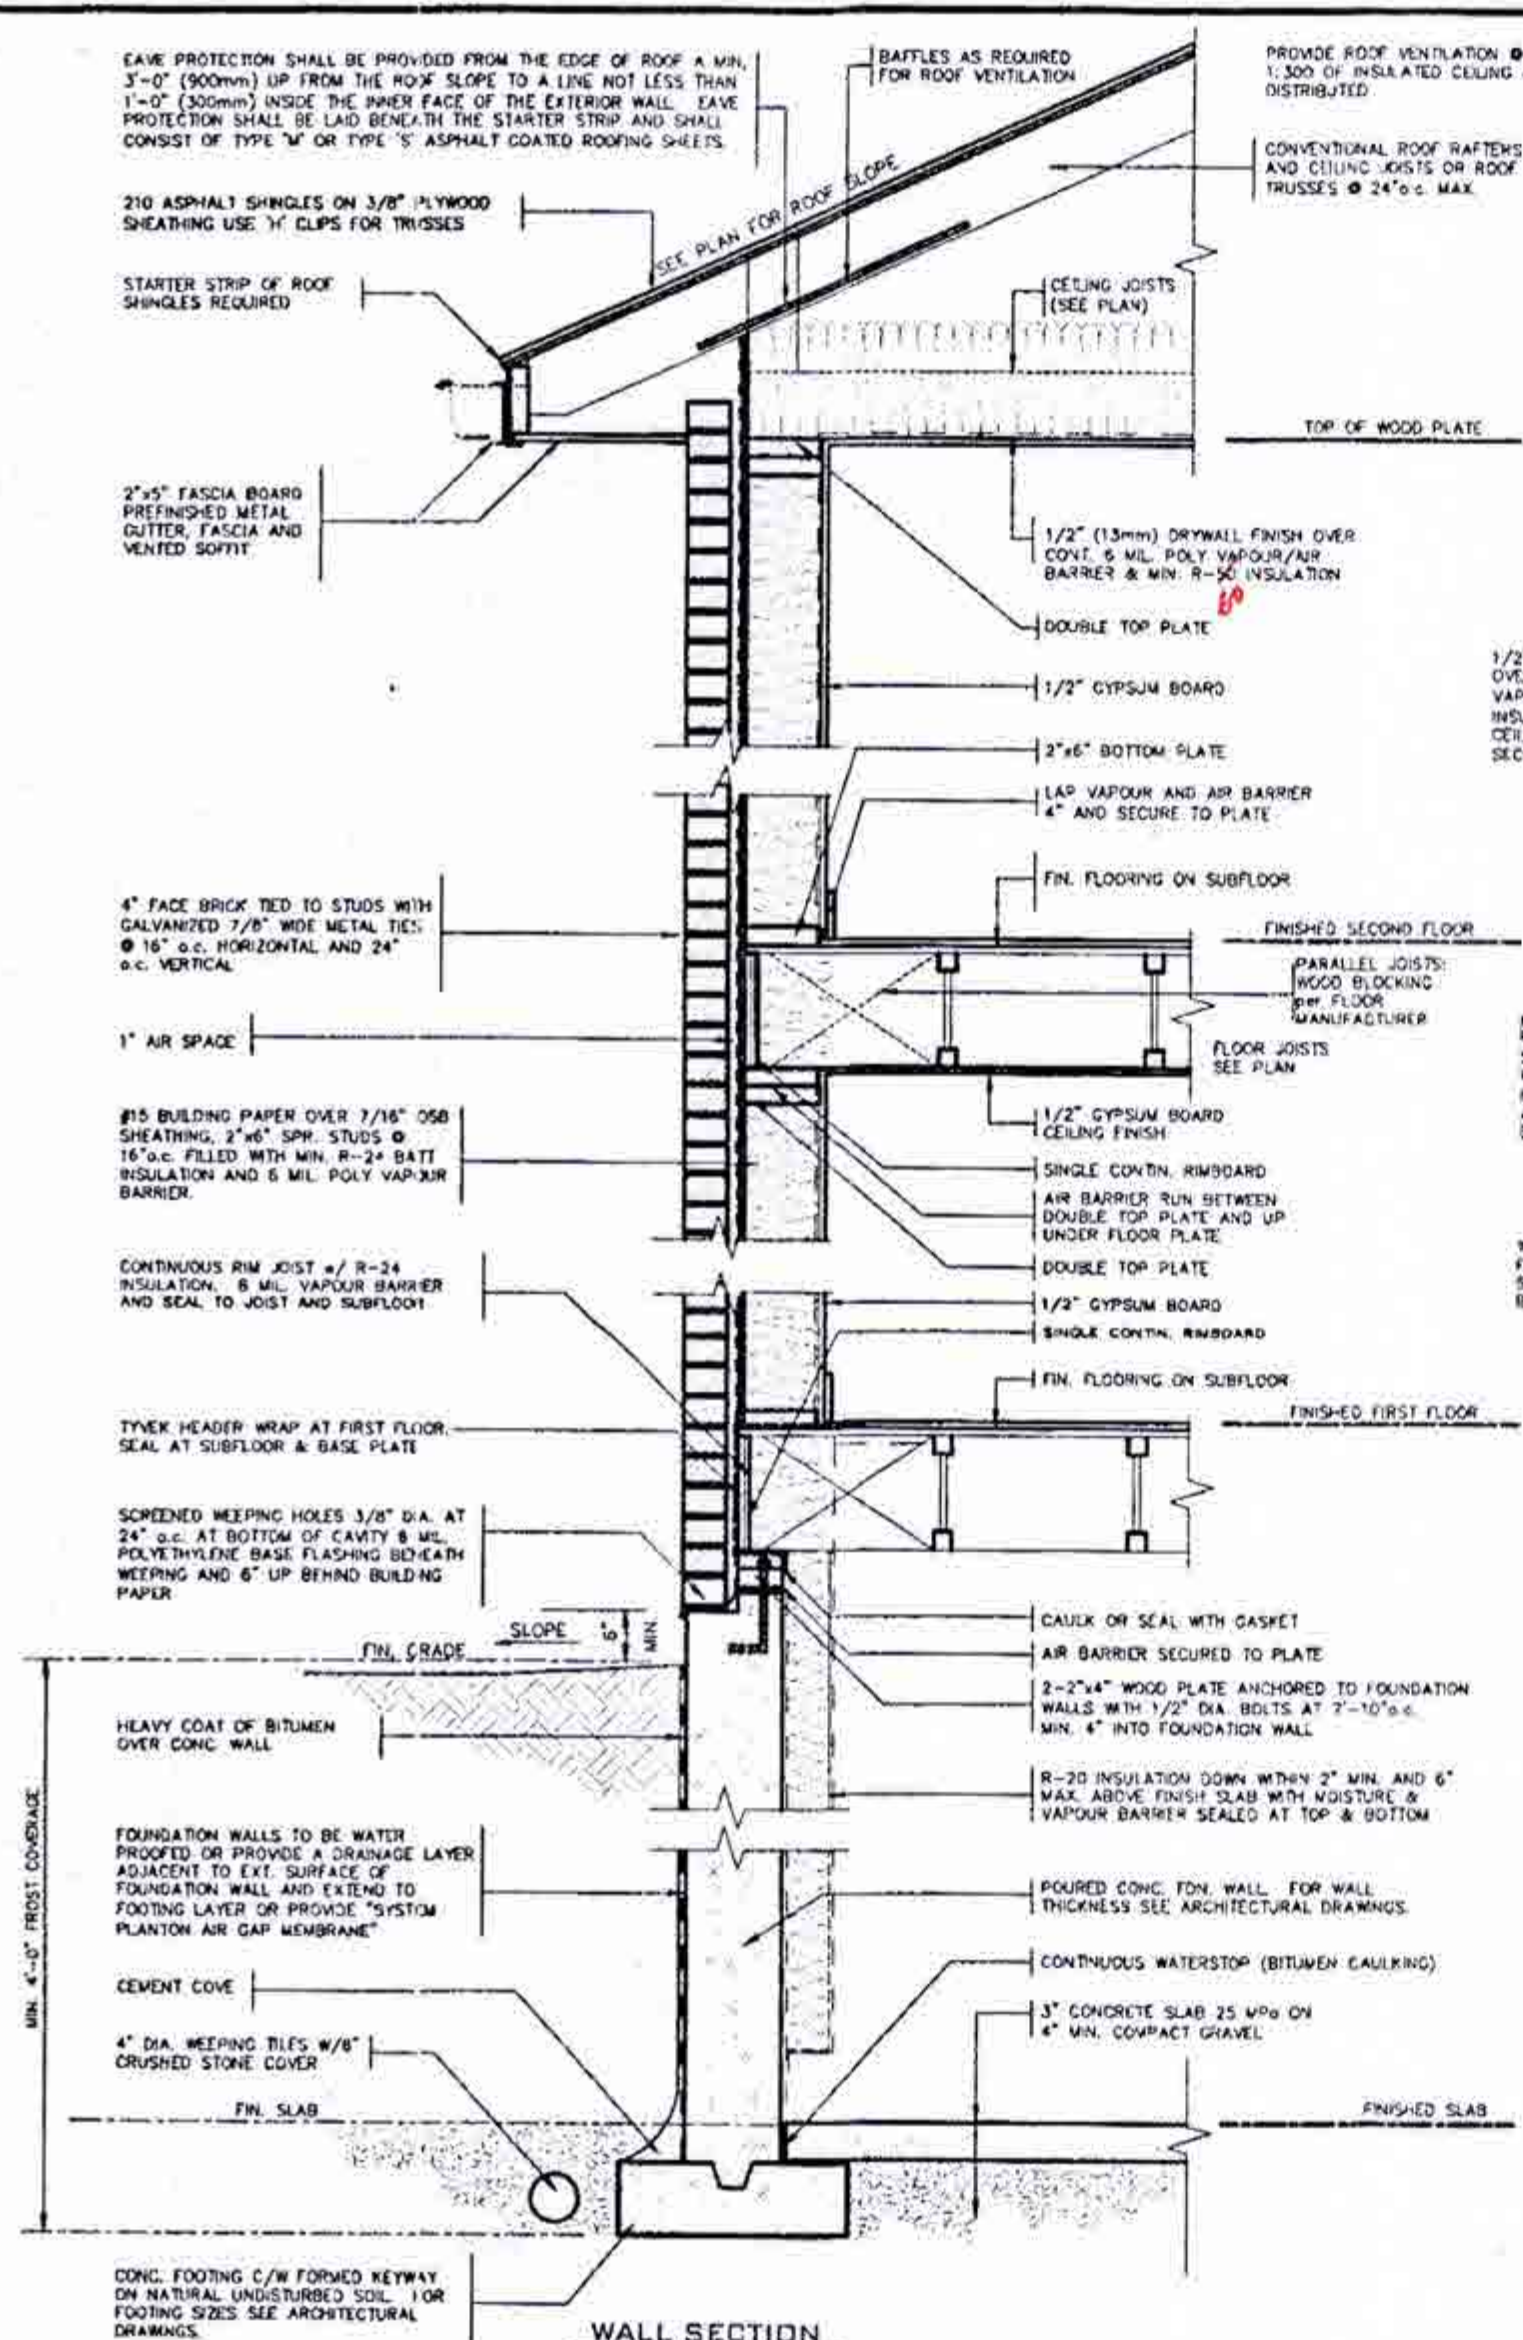

CITY OF BRAMPTON
BUILDING DIVISION
REVIEWED
MAR 05 2019
ATTACHED
OF REVISED PERMITS
ALL WORK MUST COMPLY WITH

REGISTERED PROFESSIONAL ENGINEER
B. MARINKOVIC
PROVINCE OF ONTARIO
STRUDET INC.
FOR STRUCTURE ONLY

2012 CODE COMPLIANCE PACKAGE A1

1	ISSUED FOR PERMIT	JULY 23/18	DATE	BY	Richard Vink	24455	NAME	VA3 DESIGN	255 Consumers Rd. Suite 120 Toronto, ON M2J 1R4 1 416 630 2255 416 630 4782 va3design.com	PROJECT NAME	MINNISALE HOMES CORP.	MUNICIPALITY	BRAMPTON	PRINTED NO.	18012
2	NO DESCRIPTION									DATE	JULY 2018	SCALE	2"x6" BRICK VENEER SECTIONS	3	

All drawings, specifications, related documents and design are the copyright property of VA3 DESIGN. Reproduction of this property in whole or in part is strictly prohibited without VA3 DESIGN's written permission.

ROCKWOOL FITTED TIGHTLY BETWEEN TOP OF WALL AND U/S OF SHEATHING (MAX 1 1/2" (40mm) DEPTH)

PRE-ENGINEERED ROOF TRUSSES BY TRUSS MFG. @ 24" O.C.

PROVIDE MIN HEIGHT 2"x4" (38x89) WOOD BLOCKING FOR WALLS EXCEEDING 9'-10" (3.0m) IN HEIGHT.

POLY WRAP AT PARTY WALL


TOP OF PLATE

ACOUSTICAL SEALANT

2 LAYERS OF 1/2" GYPSUM WALL BOARD FOR CONTINUOUS FIRE-STOPPING

1 HOUR RATED PARTY WALL (ATTIC SPACE)

38x89 (2"x4") STUDS @ 400 O.C. w/ 15.9mm (5/8") FIRECODE GYPSUM BD EACH SIDE, ALL JOINTS TAPED AND SEALED (ULC No. W301)

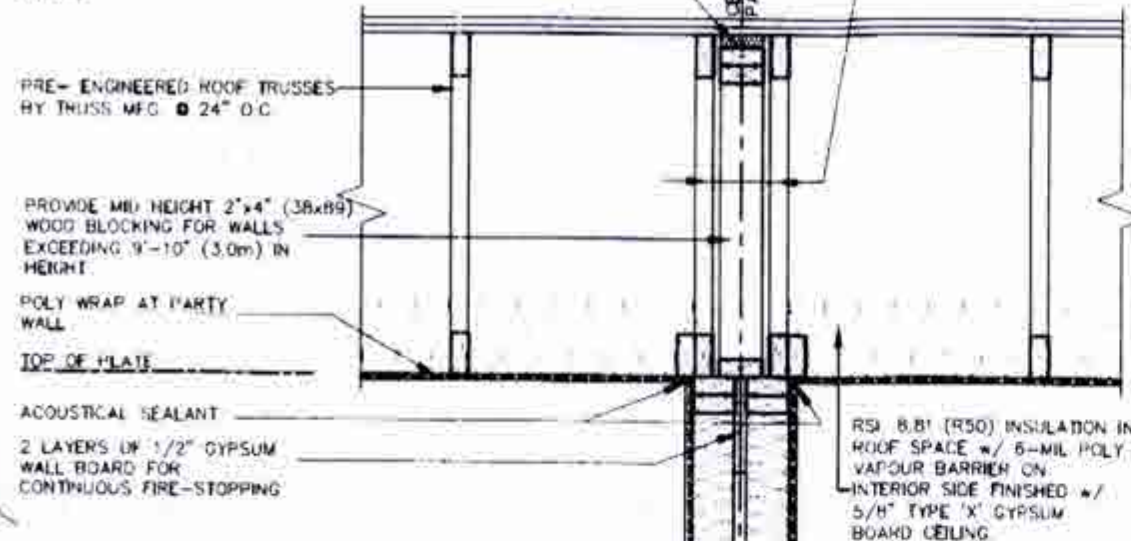




SOUND ABSORPTIVE MATERIAL REQUIREMENTS
SOUND ABSORPTIVE MATERIAL INCLUDES FIBRE PROCESSED FROM ROCK, SLAC, GLASS OR CELLULOSE FIBRE. IT MUST FILL AT LEAST 90% OF THE CAVITY THICKNESS FOR THE WALL TO PROVIDE THE LISTED STC VALUE.

SOUND TRANSMISSION RATING
MINIMUM REQUIRED STC RATING OF 50 (O.B.C. DIV. B 9.11.2.1(1))

ACOUSTICAL SEALANT
ASSEMBLIES WITH SOUND TRANSMISSION CLASS RATINGS OF 50 OR MORE REQUIRE ACOUSTICAL SEALANT APPLIED AROUND ELECTRICAL BOXES AND OTHER OPENINGS, AND AT THE JUNCTION OF INTERSECTING WALLS AND FLOORS, EXCEPT INTERSECTION OF WALLS CONSTRUCTED OF CONCRETE OR SOLID BRICK.

WALL TYPE
SEE SUPPLEMENTARY STANDARDS SBA TABLE 1 W13A HEARING WALL WITH 2 ROWS OF 2"x4" SPR. @ 16" O.C. ON SEPARATE 2"x4" PLATES SET 1" APART WITH 4" ABSORPTIVE MATERIAL AND 1 LAYER 5/8" TYPE 'X' GYPSUM WALL BOARD ON EACH SIDE (SEE NOTES 5 TO TABLE 1).

FIRE RESISTANCE RATING
FIRE RESISTANCE RATING REQUIRED IS 1 HR. MIN. (AS PER SENTENCE DIV. B 9.10.11.2 (1) O.B.C.)

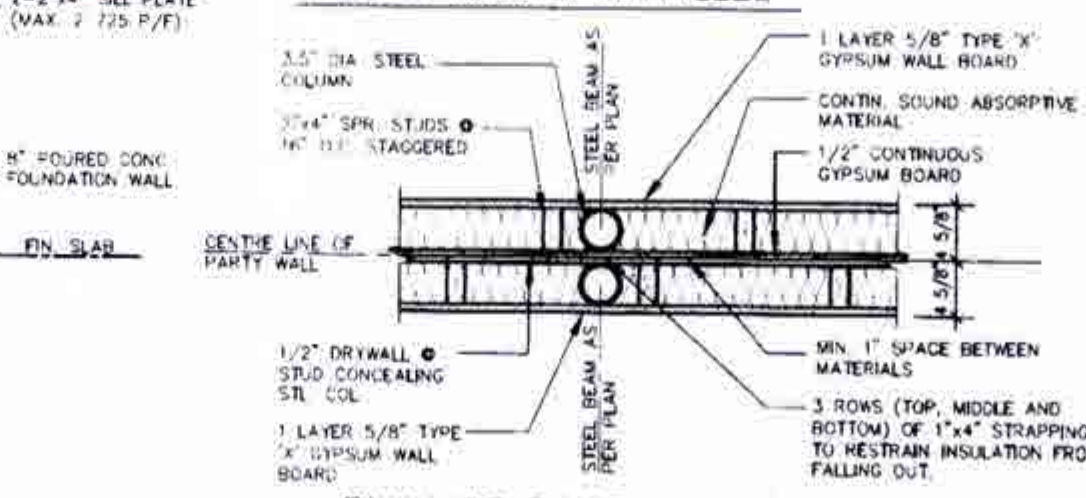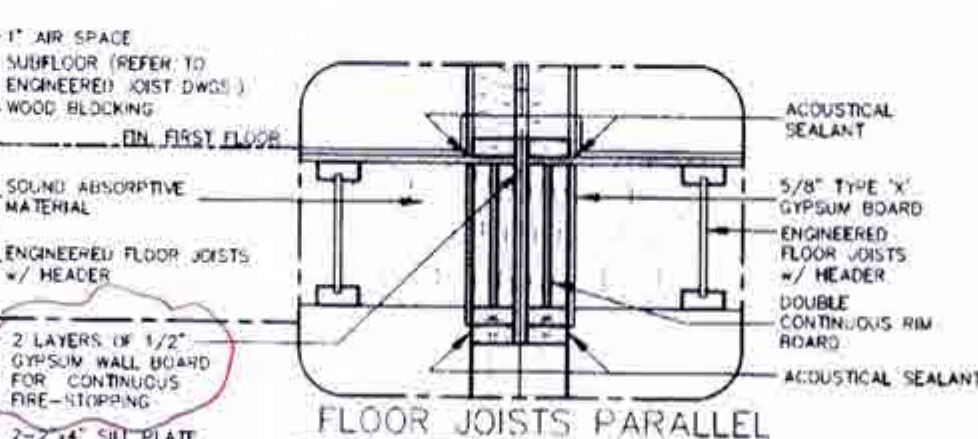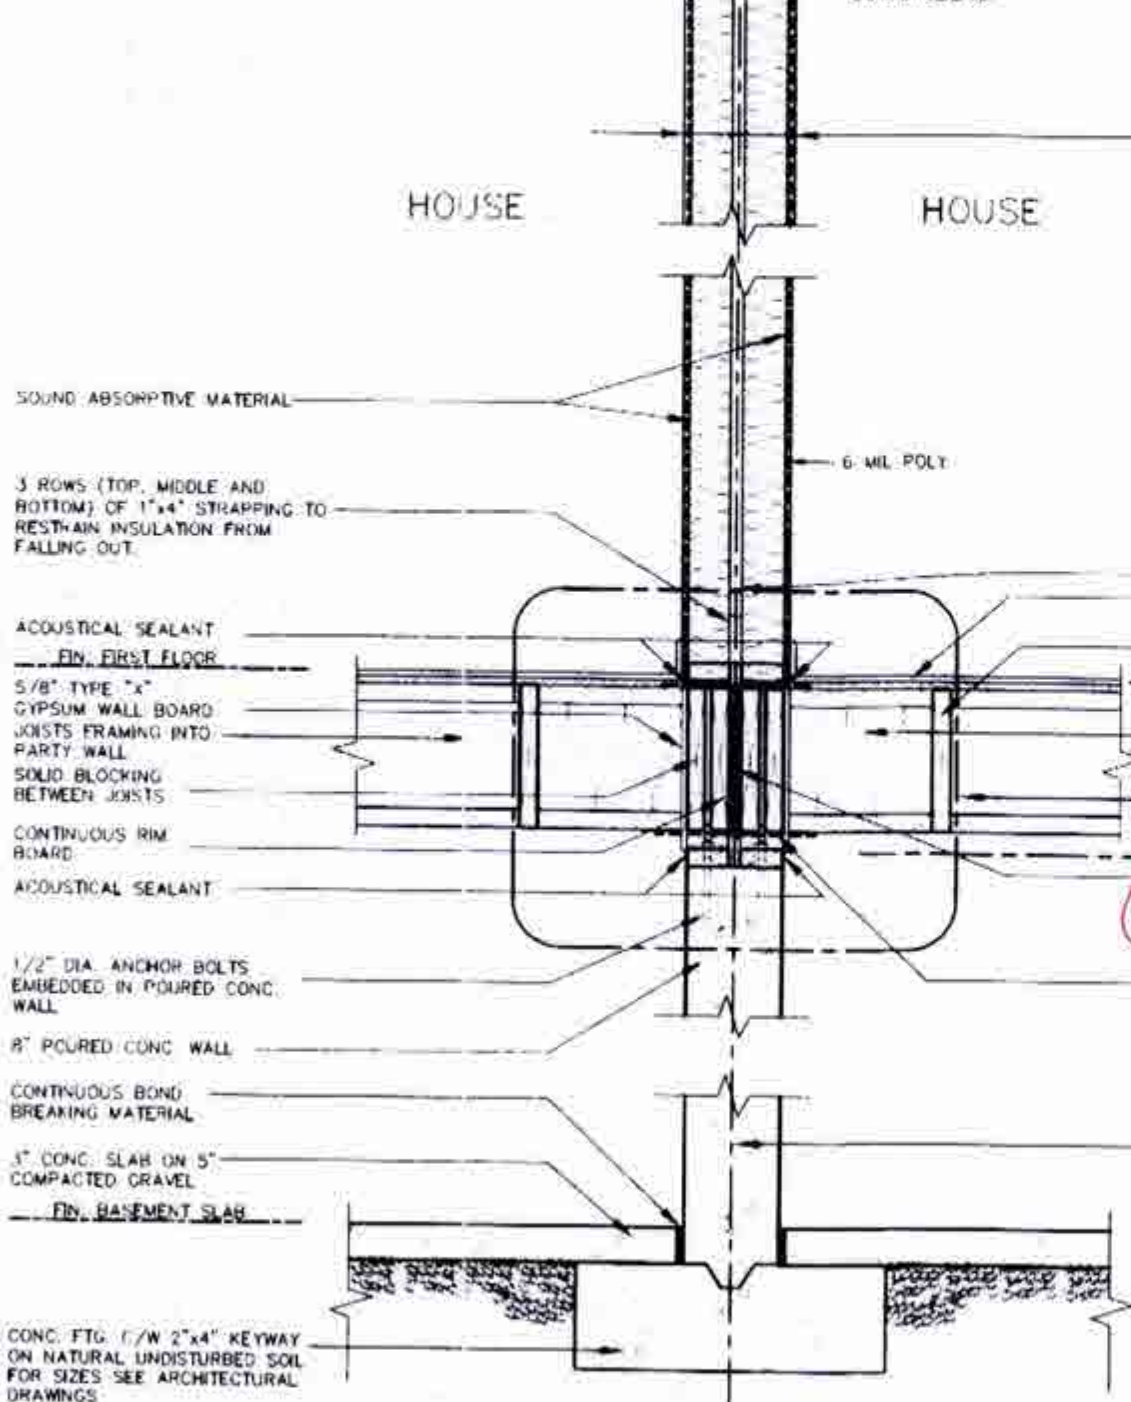

WOOD FRAME PARTY WALL
TRUSSES PARALLEL TO PARTY WALL

PLAN OF PARTY WALL IN GARAGE




CITY OF BRAMPTON
BUILDING DEPARTMENT
REVIEWED
FILE # 7-111
BY
MARY FRENETTE

PARTY WALL DETAIL TO BE READ IN CONJUNCTION WITH DETAILS 1 & 4 ON THE HEMLOCK UNIT DRAWINGS.

JAN 08 2019

2012 CODE
COMPLIANCE PACKAGE A1

3 4 5 The undersigned has reviewed and taken responsibility for the design and has the qualifications and meets the requirements set out in the Ontario Building Code to be a Designer. Signature: Richard Vink Name: Richard Vink Registration Number: 24458 Designation: Designer Firm: VAS Design Inc. Address: 255 Consumers Rd Suite 120, Toronto, ON M2J 1R4 Phone: 416-630-7705, 416-630-4782 Email: vasdesign.com	VA3 DESIGN 255 Consumers Rd Suite 120 Toronto, ON M2J 1R4 416-630-7705, 416-630-4782 vasdesign.com	Greenpark. Project Name: MINNISALE HOMES CORP. Municipality: BRAMPTON Project No: 18012 Date: JANUARY 2019 Party Wall Detail (HEMLOCK MODELS) Drawing No: 4
---	---	---	--

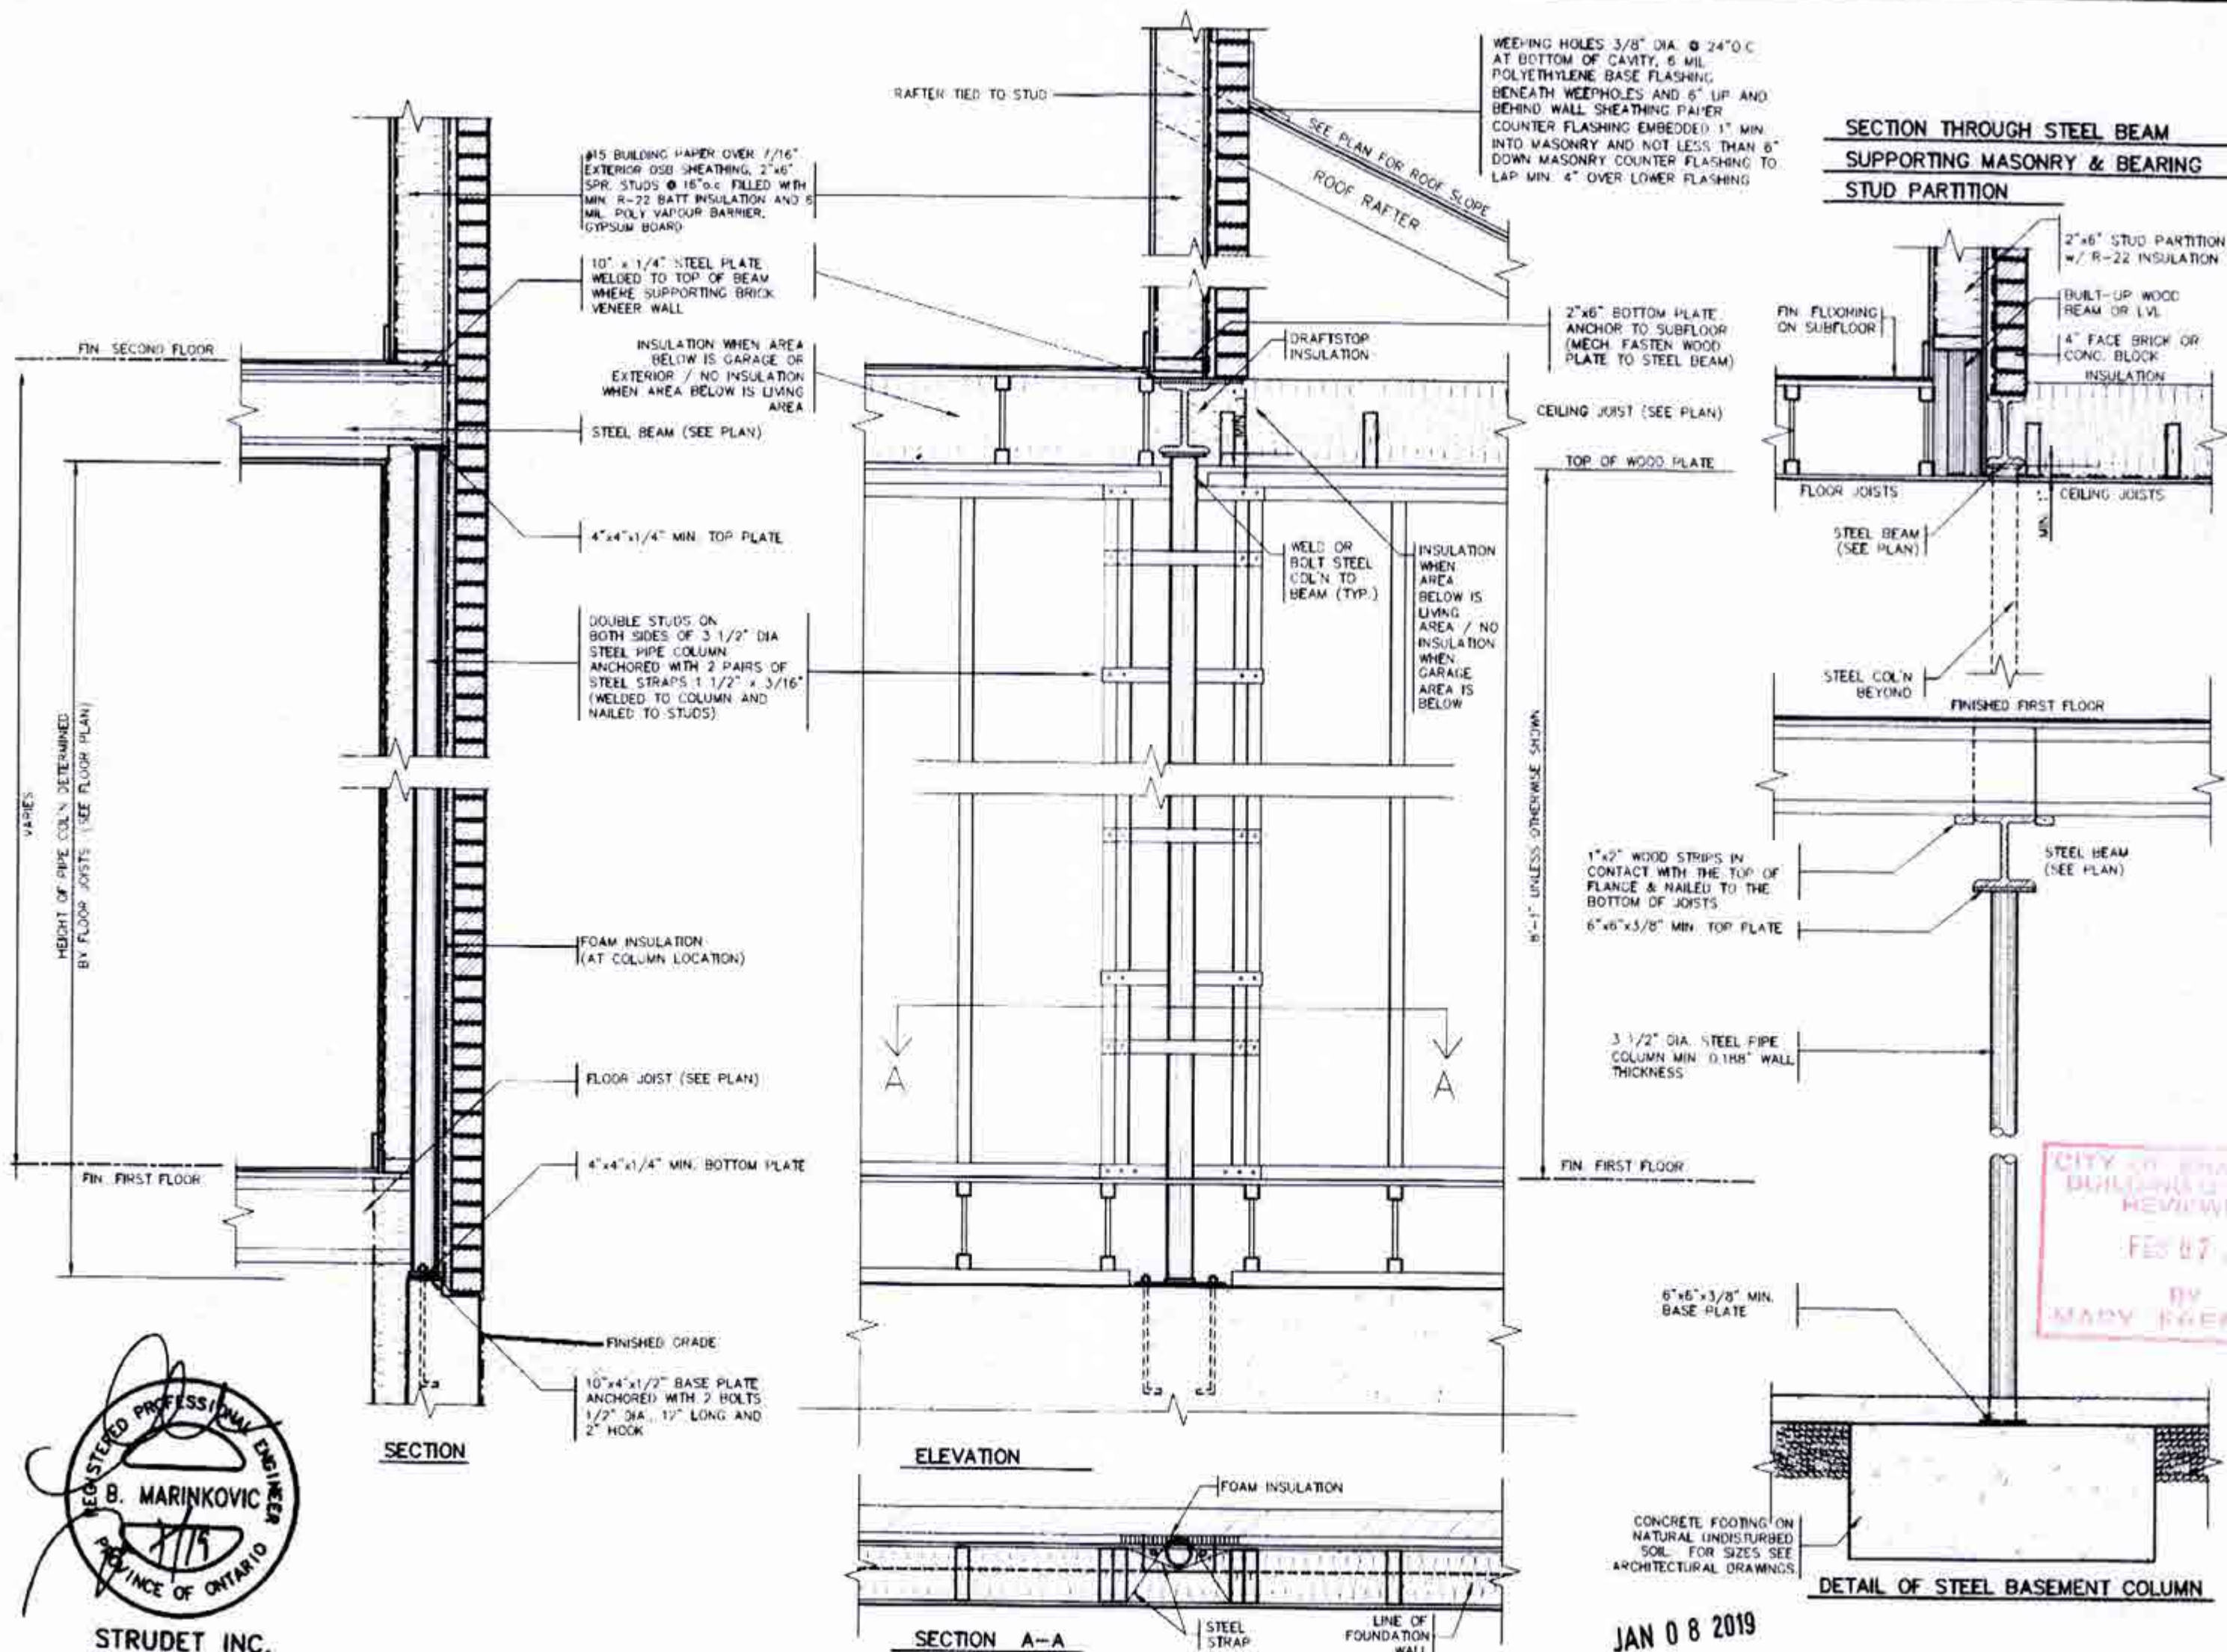

REGISTERED PROFESSIONAL ENGINEER
B. MARINKOVIC
PROVINCE OF ONTARIO
STRUDET INC.
FOR STRUCTURE ONLY

CITY OF BRAMPTON
BUILDING DEPARTMENT
REVIEWED
FEB 07 2019
BY

JAN 08 2019

2012 CODE
COMPLIANCE PACKAGE A1

9 8 7 6 5 4 3 2 1 0	The undersigned has reviewed this design and has the qualifications and meets the requirements set out in the Ontario Building Code to be a Designer. Signature: <i>R. Vink</i> Registration Number: 24488 Designation: RCM Company: VAS Design Inc. Registration Number: 42658	VA3 DESIGN 250 Consumers Rd Suite 120 Toronto, ON M2J 1R4 Tel: 416-530-2255 / 416-530-4782 vasdesign.com	Greenpark. Project Name: MINNISALE HOMES CORP. Location: BRAMPTON Date: JULY 2018 Drawn by: [blank] Checked by: [blank] Scale: [blank]	Project No: 18012 Sheet No: 5 Sheet Title: STEEL COLUMN DETAILS Revision: 18012-CR-STD_DETAILS_A1
---	---	---	--	---

All design specifications, related documents and design are the copyright property of VAS DESIGN. Reproduction of the property in whole or in part is strictly prohibited without VAS DESIGN's written permission.

2" x 2" PICKETS CHAMFERED AT BOTTOM WITH 2" x 6" TOP CAP AND 2" x 4" TOP RAIL (REFER TO DETAIL 1)

3'-6" HIGH WOOD RAILING IF DECK FLOOR IS MORE THAN 5'-11" ABOVE GRADE AND 3'-0" HIGH WOOD RAILING IF DECK IS LESS THAN 5'-11" ABOVE GRADE

MAX 4" OPENING BETWEEN PICKETS

5/4 x 6 PRESSURE TREATED DECKING WITH 1/4" GAP

WB1 RIM JOISTS (PRESSURE TREATED)

GUARDS FOR STAIRS SHALL NOT BE LESS THAN 2'-11" HIGH MEASURED VERTICALLY FROM A LINE DRAWN THROUGH THE OUTSIDE EDGES OF THE STAIR NOSINGS

2" x 4" WOOD BLOCKING @ 4'-0" O.C. MIN. BETWEEN STRINGERS

2" x 12" STRINGER


PRECAST CONCRETE SLAB

(CORROSION RESISTANT) SIMPSON STRONG-TIE COLUMN BASE 1/2" DIA. ANCHOR BOLT


12" CONC. PIER

WOOD DECK SECTION WITH BRICK VENEER

SCALE: 1/2" = 1'-0"

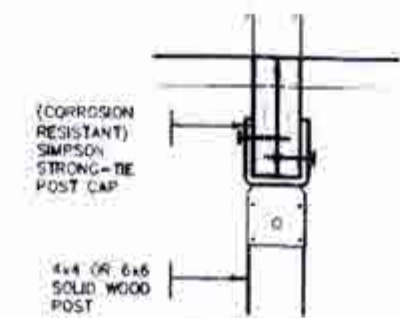

DETAIL 2
BEAM TO POST
SCALE: 1/2" = 1'-0"

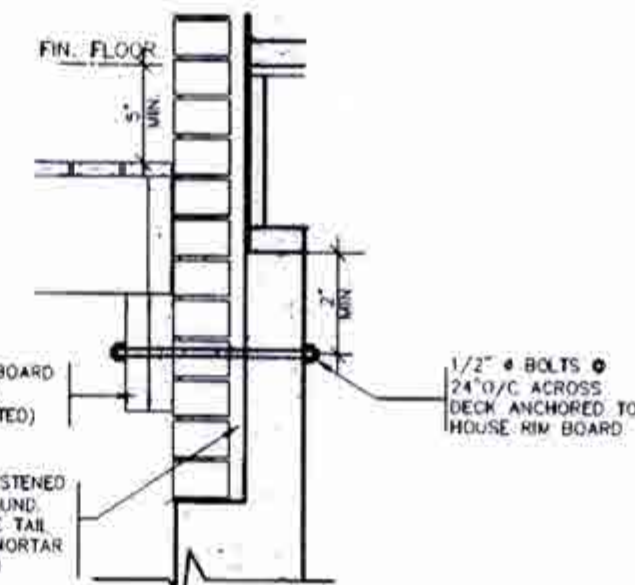


DETAIL 3
STEEL ANGLE
SCALE: 1/2" = 1'-0"

DETAIL 1

CANTILEVERED PICKET SCREWED TO RIM JOIST AND DECK

GUARD PARALLEL TO FLOOR JOISTS


SCALE: 1/2" = 1'-0"

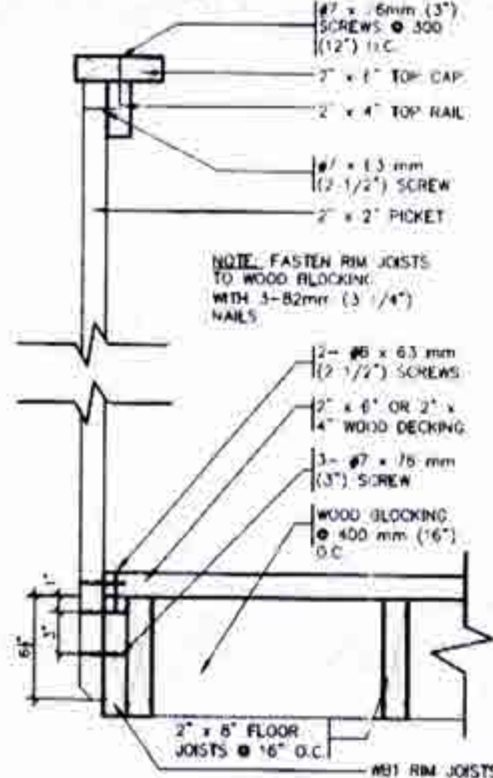



GUARD PERPENDICULAR TO FLOOR JOISTS

SCALE: 1/2" = 1'-0"

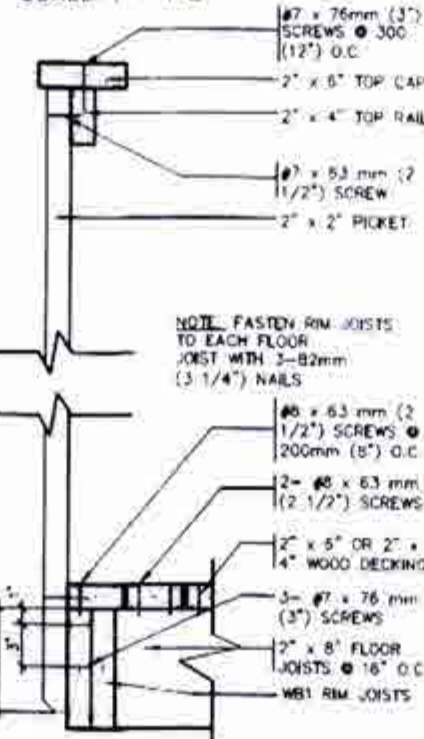

NOTE: FASTEN RIM JOISTS TO EACH FLOOR JOIST WITH 3-82mm (3/4") NAILS

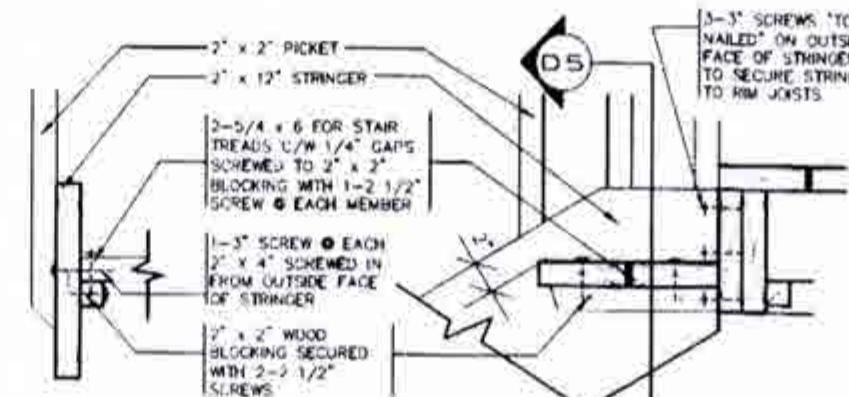

DETAIL 5
SECTION THROUGH STAIR STRINGER
SCALE: 1/2" = 1'-0"

DETAIL 4
SECTION @ TREAD AND STRINGER SECUREMENT
SCALE: 1/2" = 1'-0"

GENERAL NOTES

- BRICK TO BE COMPRESSIVE STRENGTH OF 15 MPa (2200 p.s.i.) MIN. UNITS TO BE LAID WITH FULL HEAD AND BED JOINTS
- MORTAR TO BE TYPE S WITH JOINT THICKNESS OF 10mm (3/8") MIN. AND 20mm (3/4") MAX.
- ALL NAILS AND SCREWS TO BE GALVANIZED.
- WB1 = 2-2 x 8 (PRESSURE TREATED)
WB3 = 2-2 x 10 (PRESSURE TREATED)
- WOOD FOR CANTILEVERED PICKETS SHALL BE DOUGLAS FIR-LARCH, SPRUCE-PINE-FIR, OR HEM-FIR SPECIES.




STRUDET INC.
FOR STRUCTURE ONLY


JAN 08 2019

2012 CODE
COMPLIANCE PACKAGE A1


1 ISSUED FOR PERMIT 2 3 The undersigned has reviewed and takes responsibility for this design and has the qualifications and meets the requirements set out in the Ontario Building Code to be a Designer. Richard Vink 24488 signature 24488 255 Consumers Rd. Suite 120 Toronto, ON M2J 1R4 1-416-630-2255 / 1-416-630-4782 va3design.com	VAS DESIGN	Greenpark project name: MINNISALE HOMES CORP. location: BRAMPTON date: JULY 2018 drawn by: [blank] checked by: [blank] scale: As Shown 18012-GP-STD_DETAILS_A1	project no: 18012 drawing no: 6
---	---	--------------------------	---	---

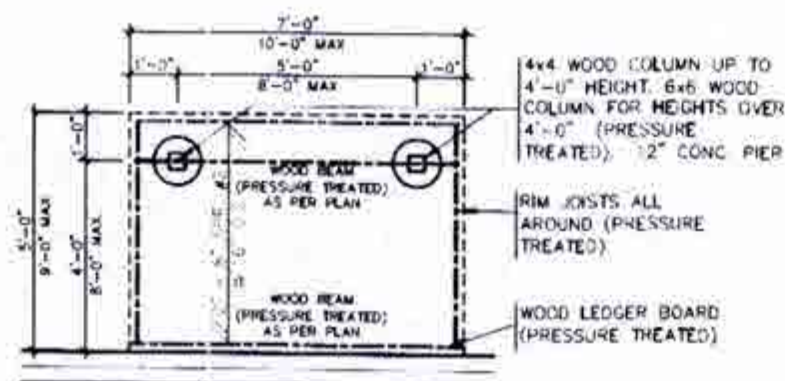


TYPICAL DECK LAYOUT
SCALE: 1/4" = 1'-0"

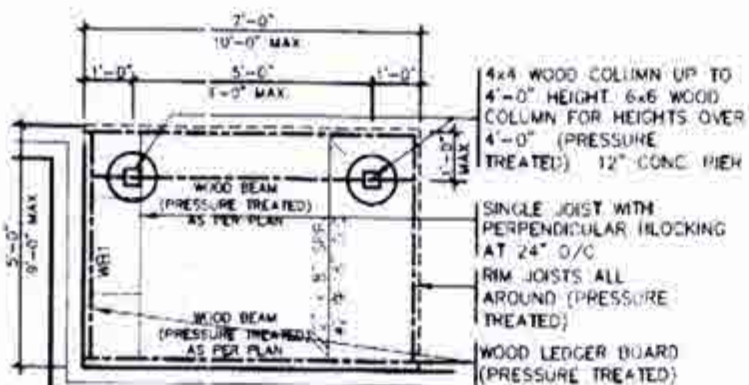

TYPICAL DECK LAYOUT
SCALE: 1/4" = 1'-0"

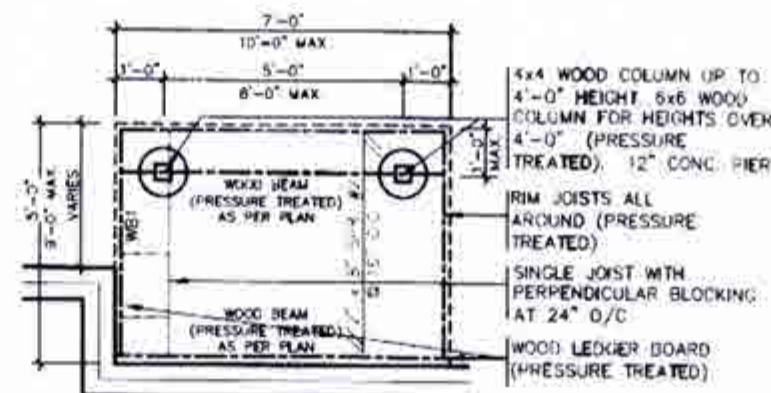

TYPICAL DECK LAYOUT
SCALE: 1/4" = 1'-0"

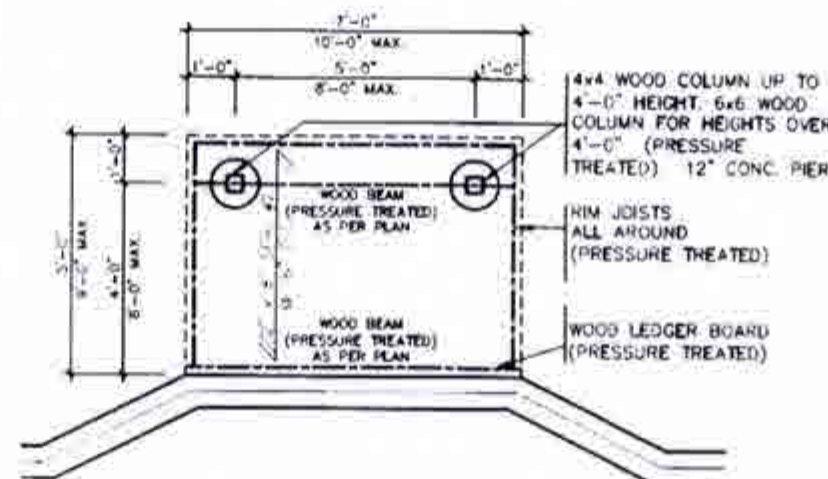

TYPICAL DECK LAYOUT
SCALE: 1/4" = 1'-0"







JAN 08 2019

2012 CODE COMPLIANCE PACKAGE A1

1 ISSUED FOR PERMIT	255 Consumers Rd Suite 120 Toronto, ON M2J 1R4 1 416.632.2235 F 416.630.4782 va3design.com	VAS DESIGN	Greenpark.	project name: MINNISALE HOMES CORP. municipality: BRAMPTON project no.: 18012 date: JULY 2018 drawn by: [signature] checked by: [signature] scale: 1/4" = 1'-0" sheet: 6-2
----------------------------	---	--------------------------	--------------------------	---

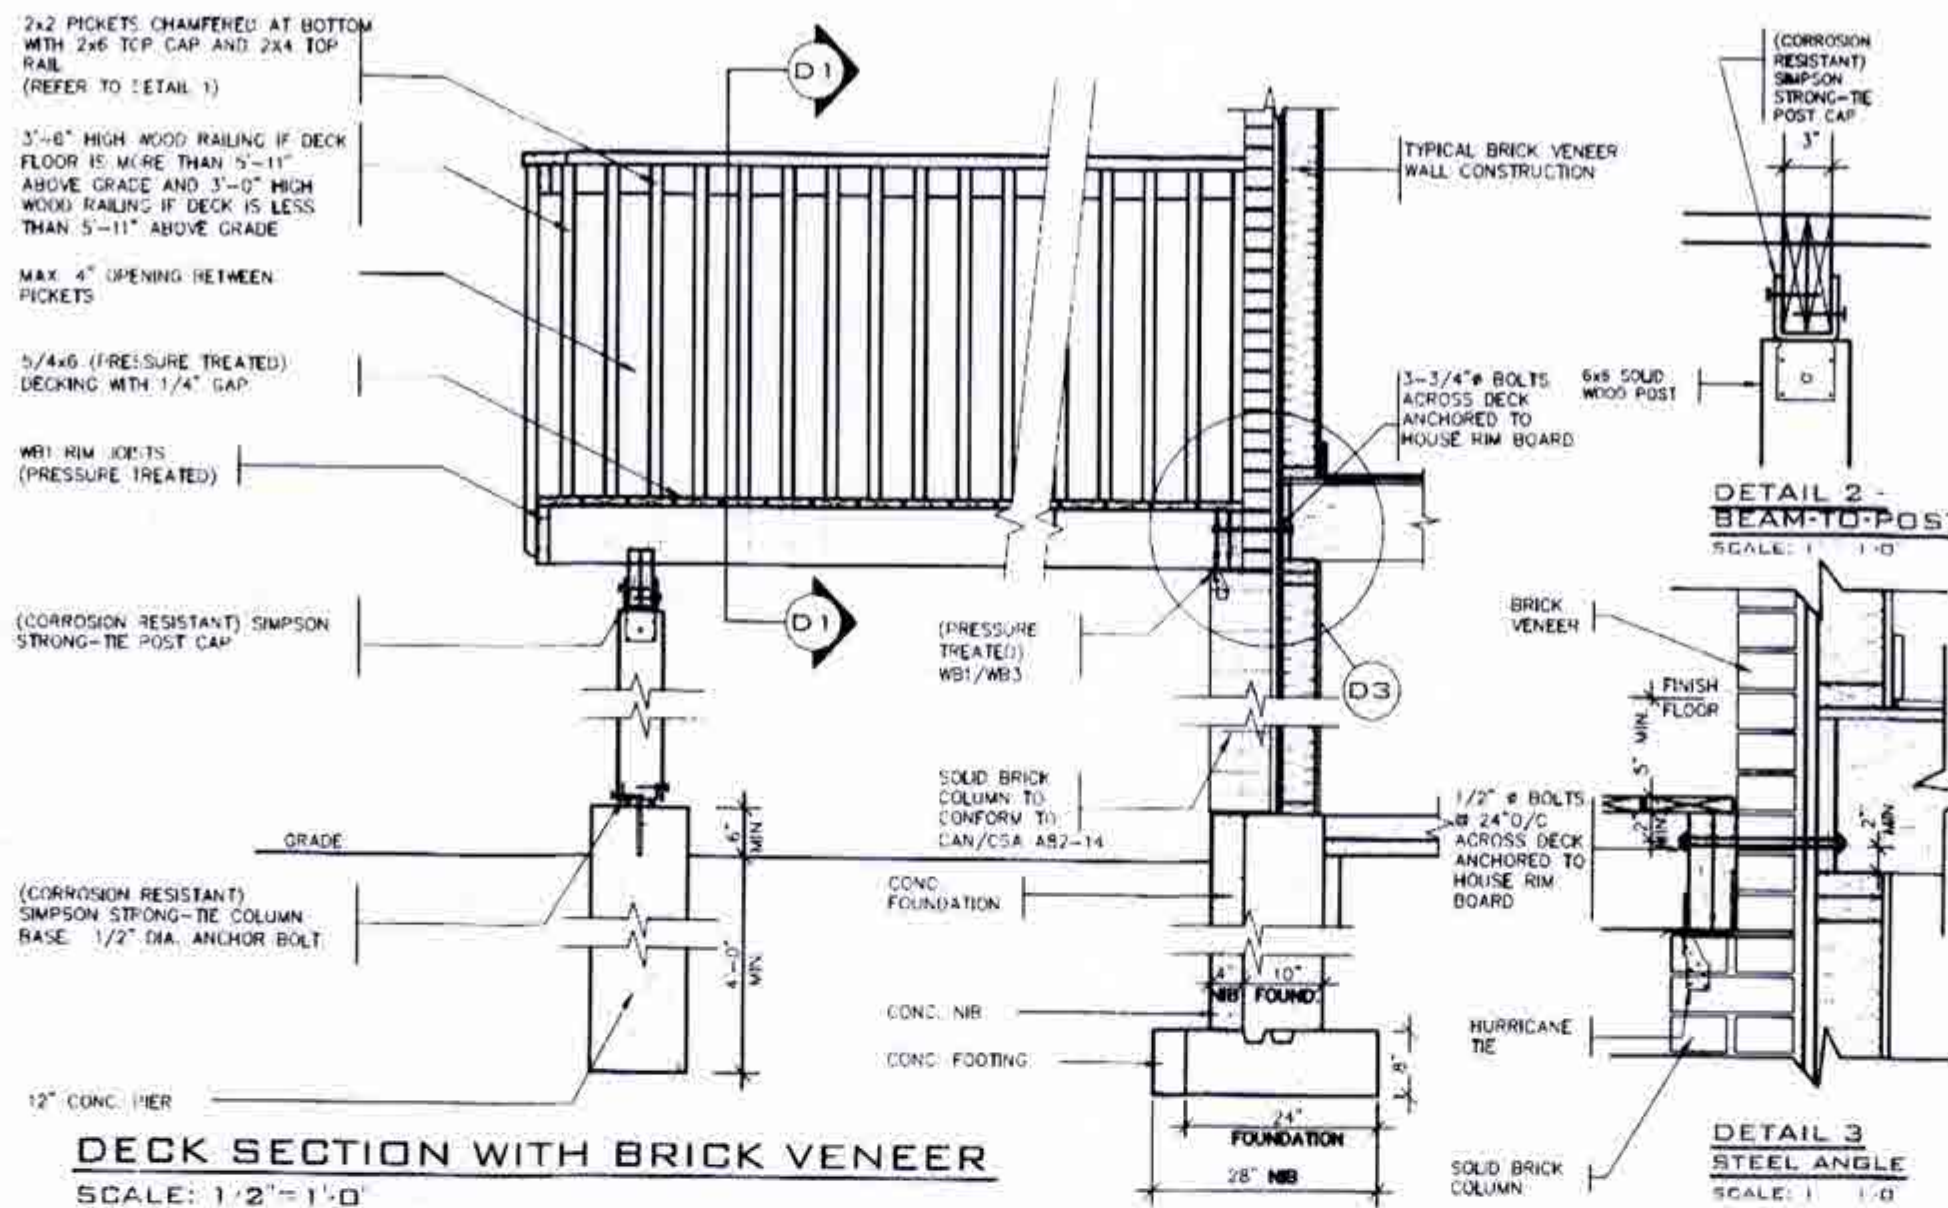

CITY OF BRAMPTON
BUILDING DEPARTMENT
RECEIVED
PER: 07-11
BY: MARY PRINCEP

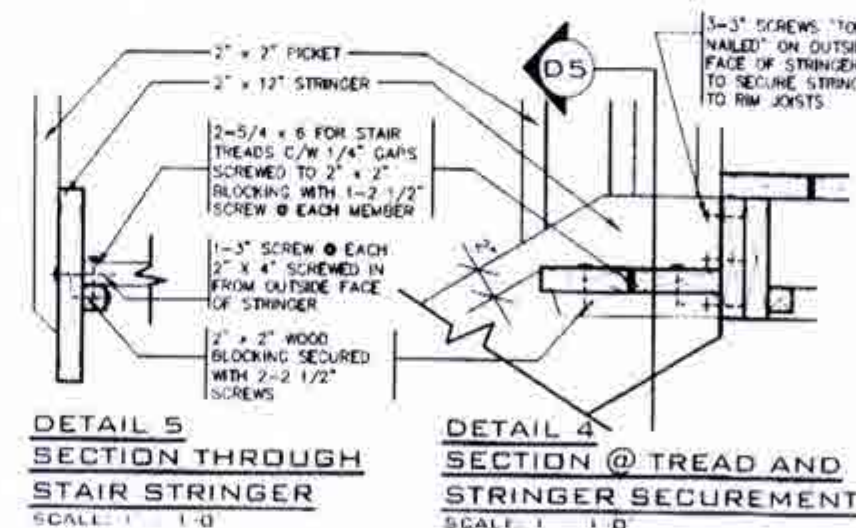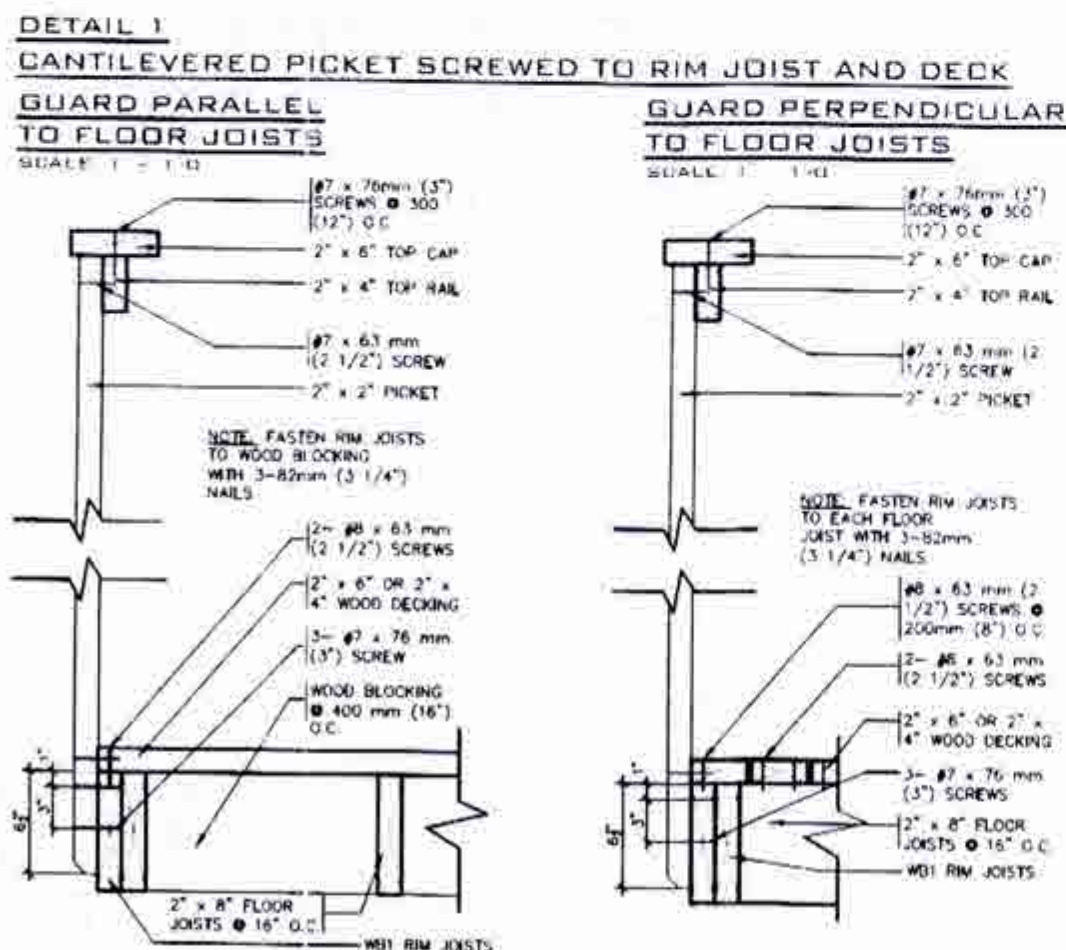

- GENERAL NOTES**
- BRICK TO BE COMPRESSIVE STRENGTH OF 15 MPa (2200 p.s.i.) MIN. UNITS TO BE LAID WITH FULL HEAD AND BED JOINTS.
 - MORTAR TO BE TYPE S WITH JOINT THICKNESS OF 10mm (3/8") MIN. AND 20mm (3/4") MAX.
 - ALL NAILS AND SCREWS TO BE GALVANIZED.
 - WB1 = 2-2 x 8 (PRESSURE TREATED)
WB3 = 2-2 x 10 (PRESSURE TREATED)
 - WOOD FOR CANTILEVERED PICKETS SHALL BE DOUGLAS FIR-LARCH, SPRUCE-PINE-FIR, OR HEM-FIR SPECIES.



JAN 08 2019


2012 CODE
COMPLIANCE PACKAGE A1

9					
8					
7					
6					
5					
4					
3					
2					
1	ISSUED FOR PERMIT				
	no. description	date	by		

VAS DESIGN
255 Consumers Rd. Suite 120
Toronto, ON M2Y 1B4
416.630.2755 / 416.630.4782
vasdesign.com


Greenpark.
project name: MINNISALE HOMES CORP.
municipality: BRAMPTON
date: JULY 2018
drawn by: [signature]
checked by: [signature]
scale: As Shown

project no.: 18012
drawing no.: 18012-GP-STD-DETAILS_A1
sheet no.: 6-3

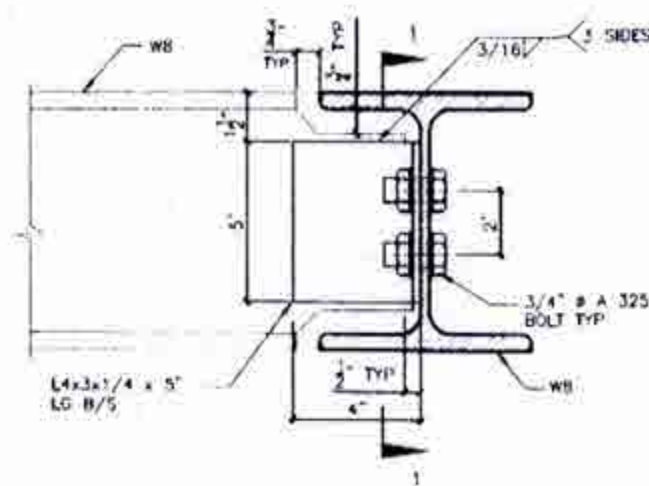


DETAIL 1.

W8
TO
W8
CONNECTION

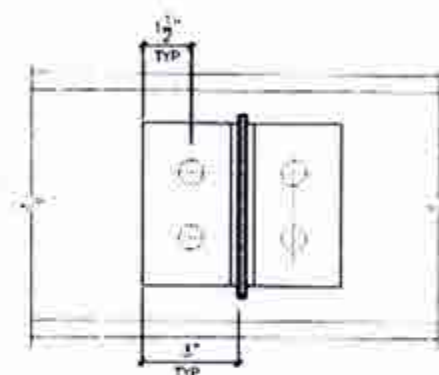


SECTION 1-1

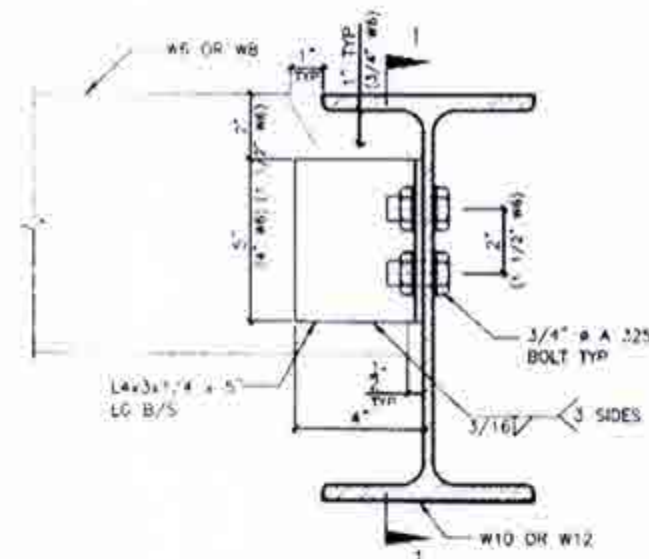



DETAIL 2.

W6(W8)
TO
W10(W12)
CONNECTION

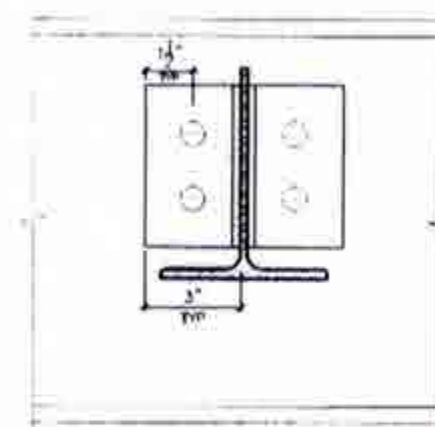


DETAIL 3.

W10
TO
W10
CONNECTION

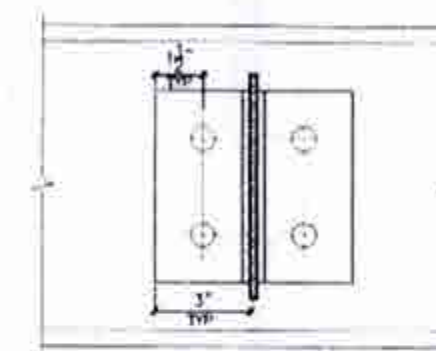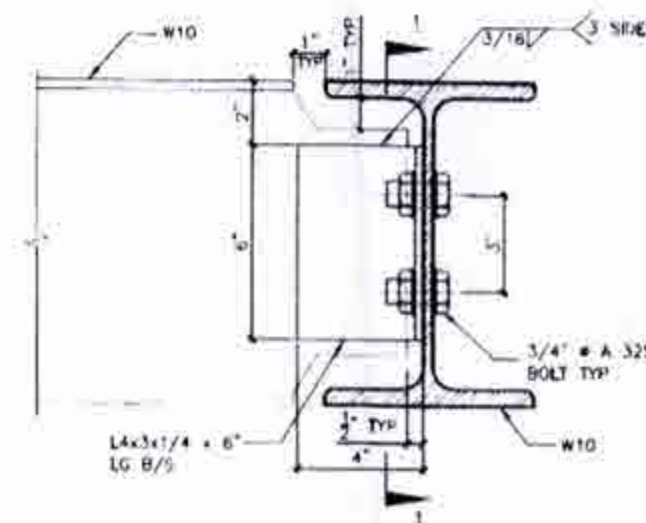


SECTION 1-1

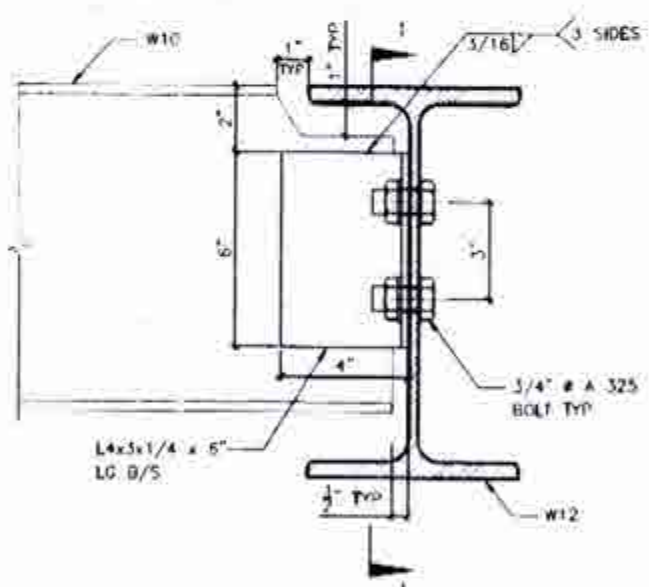


DETAIL 4.

W10
TO
W12
CONNECTION

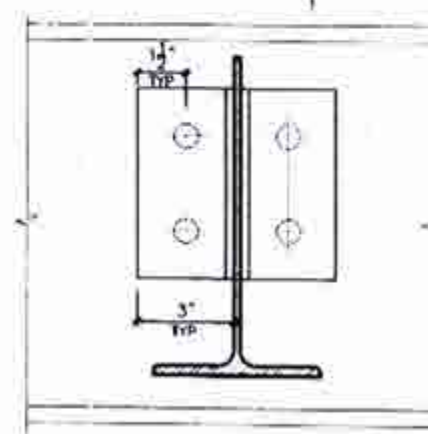


SECTION 1-1

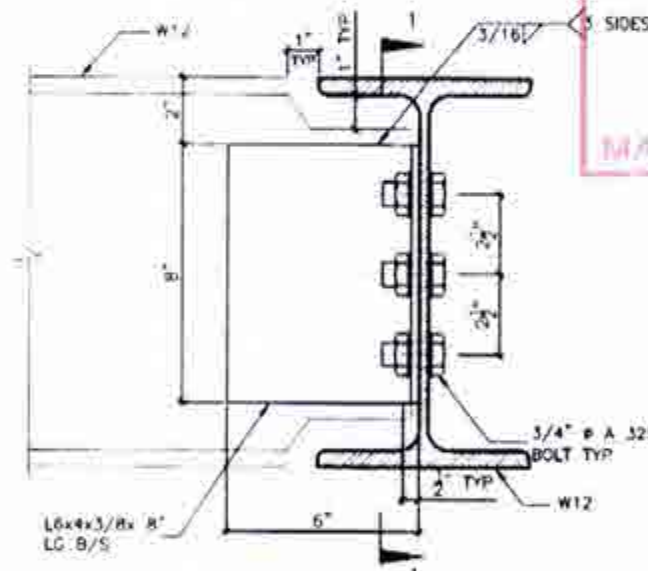

DETAIL 5.

W12
TO
W12
CONNECTION

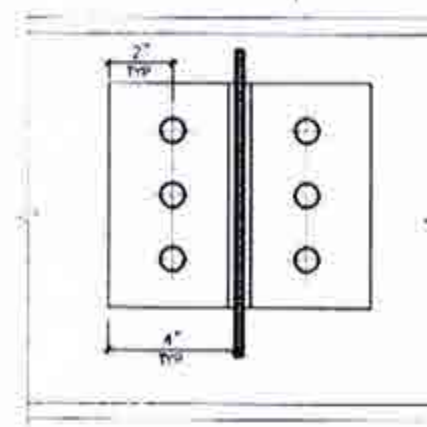


SECTION 1-1




DETAIL 6.

ANGLE
TO
BEAM
CONNECTION

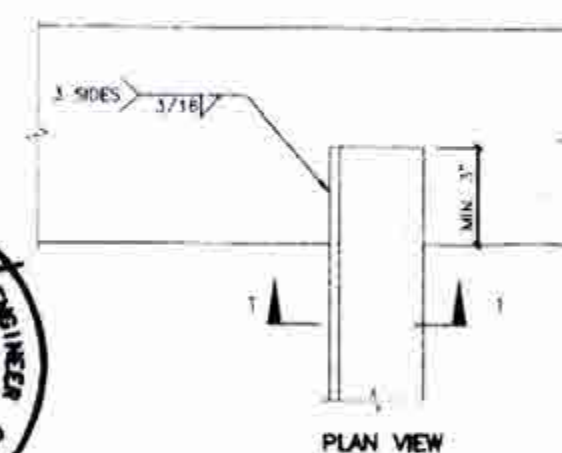

PLAN VIEW

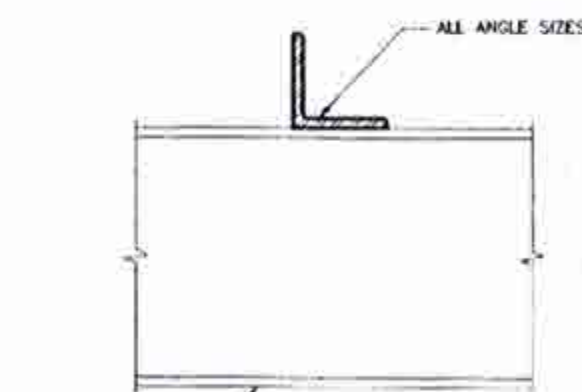

SECTION 1-1

JAN 08 2019
2012 CODE
COMPLIANCE PACKAGE A1

9	1	ISSUED FOR PERMIT	306	BY
8	2	DESCRIPTION		
7	3			
6	4			
5	5			
4	6			
3	7			
2	8			
1	9			

VAS DESIGN
255 Consumers Rd Suite 120
Toronto, ON M2J 1R4
Tel: 416.630.2750 F: 416.630.4782
vasdesign.com


Greenpark.
project name
MINNISALE HOMES CORP.
date
JULY 2018
drawn by
checked by
scale
1/8" = 1'-0"

BRAMPTON


18012

STEEL BEAM CONNECTIONS

7

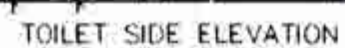

STRUCTURAL REINFORCEMENT FOR GRAH BAR (OBC 9.5.2.3.)
FOR MAIN BATH ONLY

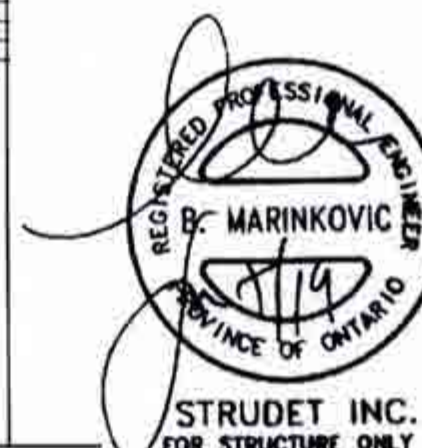



JAN 08 2019

2012 CODE
COMPLIANCE PACKAGE A1

[illegible]

All abstract specifications, related documents and details are the copyright property of V&I NSEA. Reproduction of the contents in whole or in part is strictly prohibited without V&I NSEA's written permission.

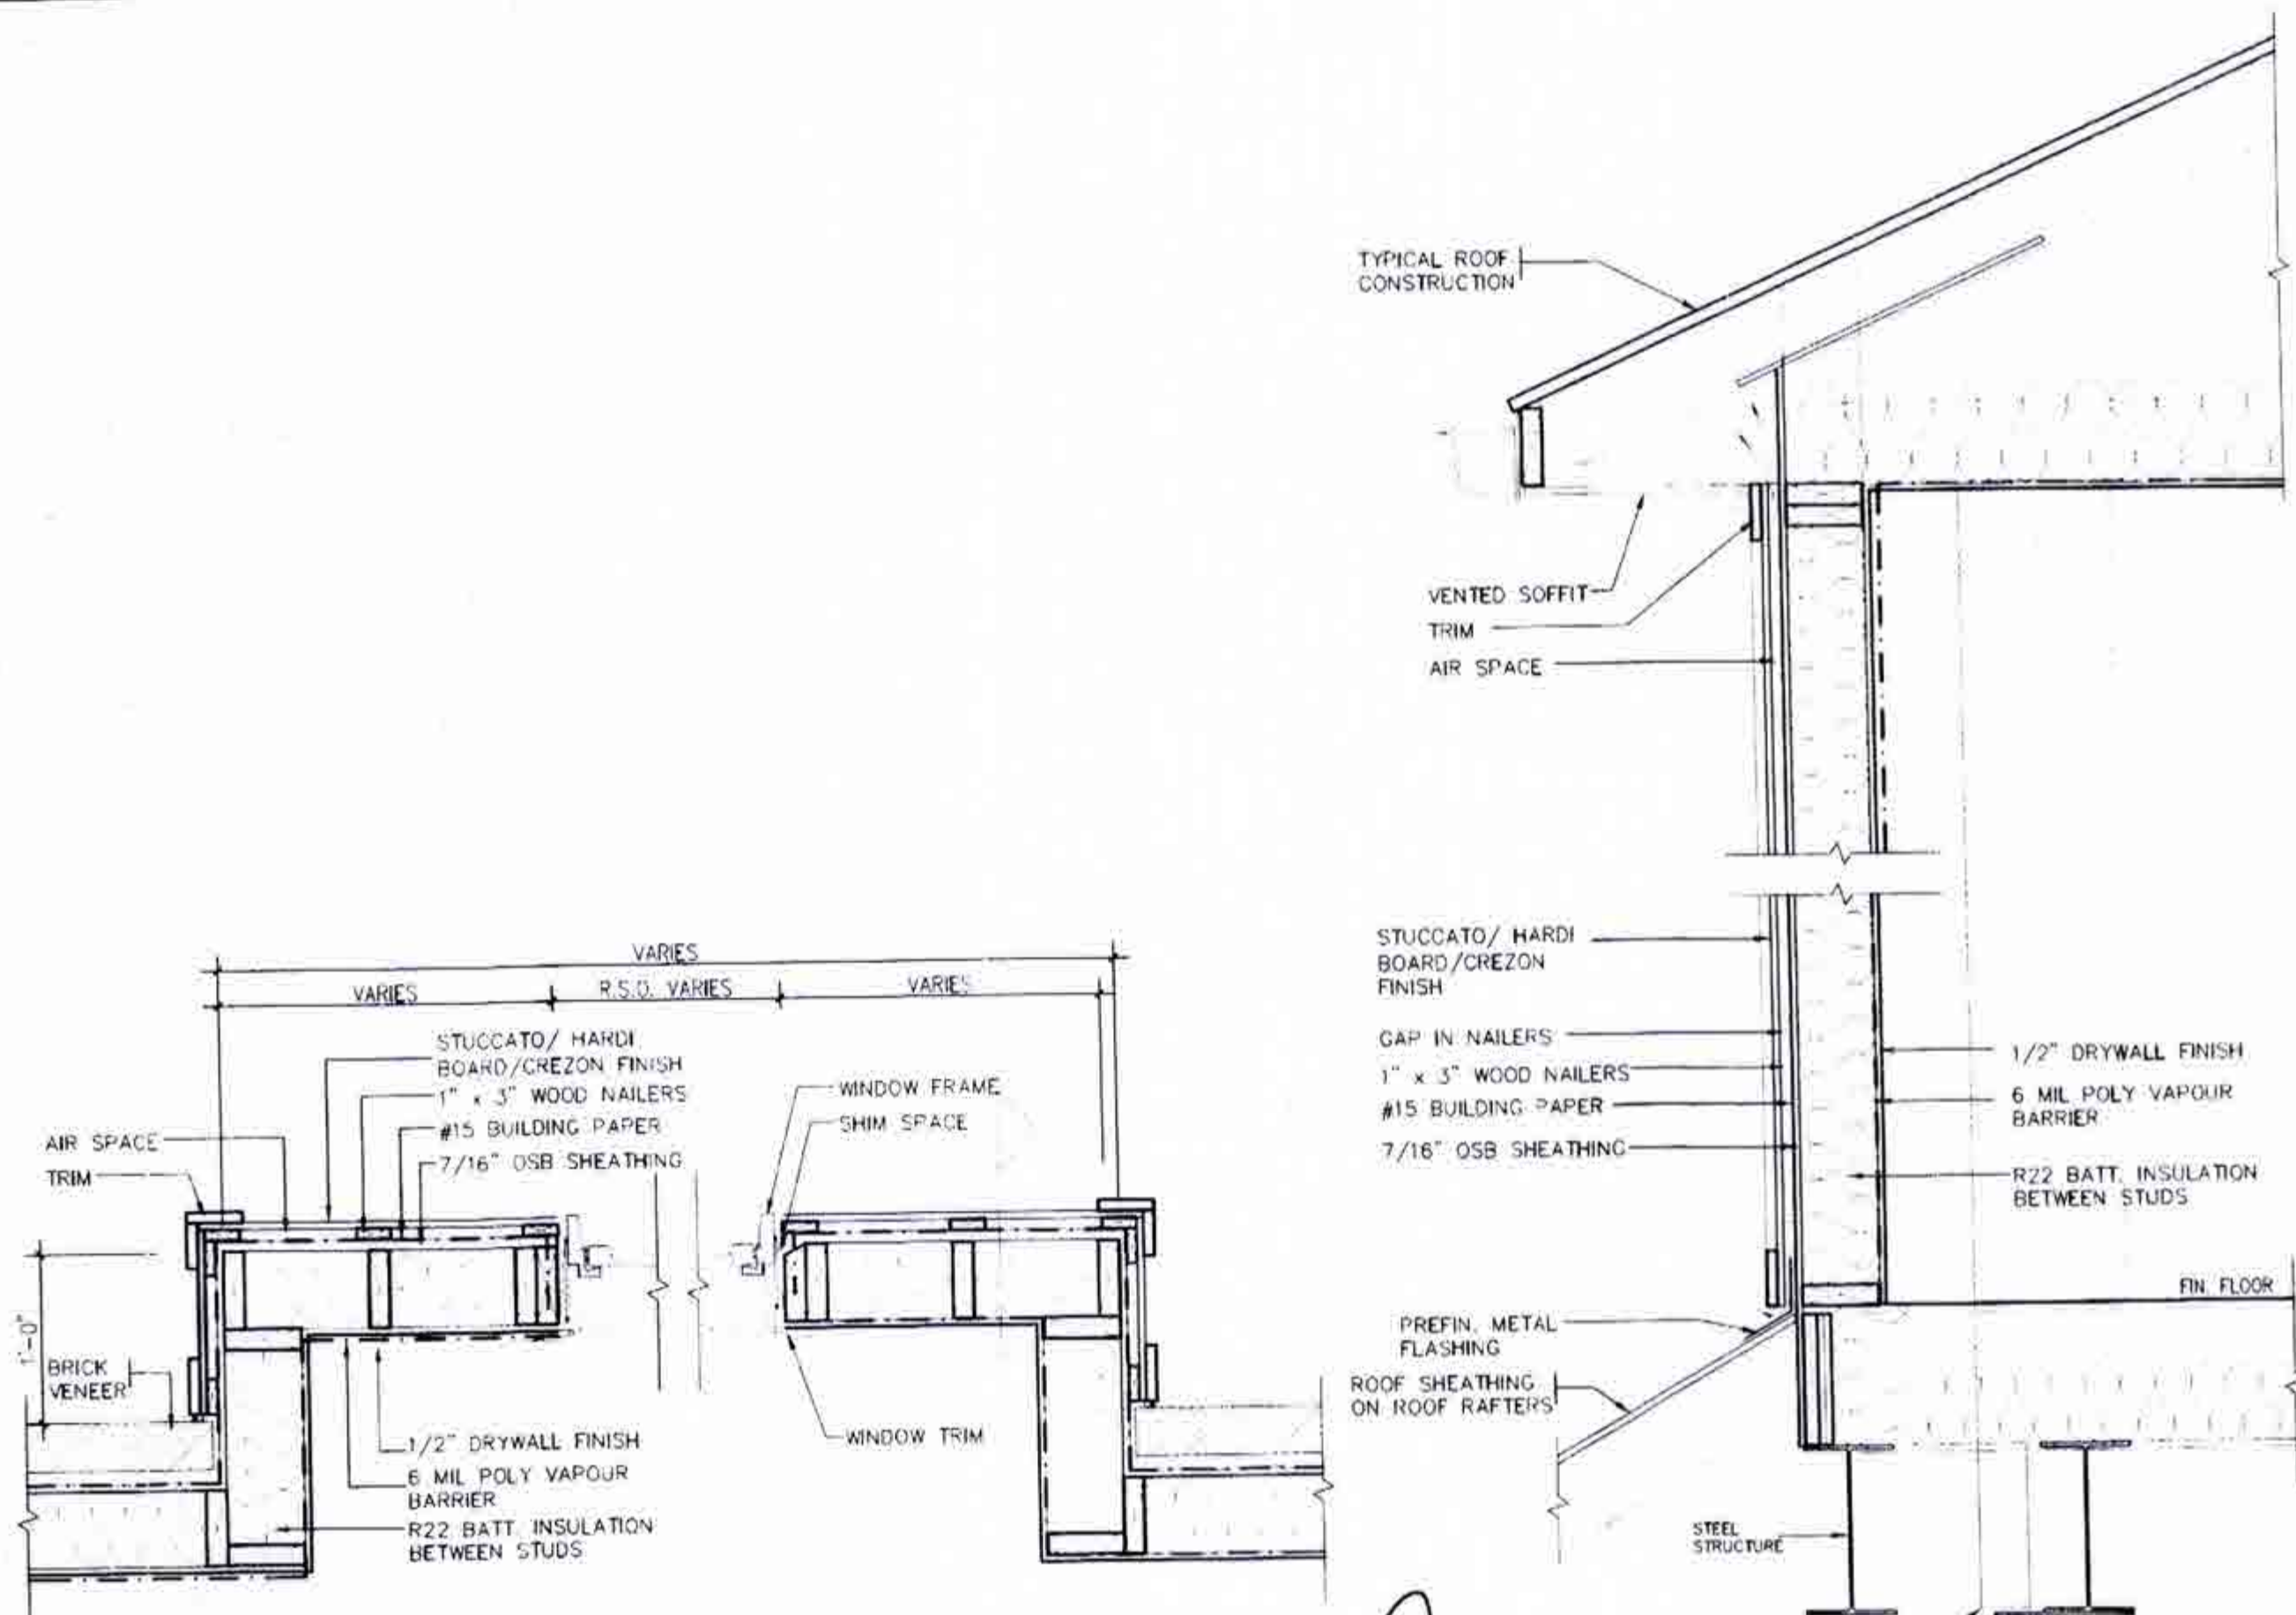

PLAN VIEW

STUCCATO BOARD FINISH CLADDING OR EQUAL (OBC 9.27.)




JAN 08 2019


2012 CODE
COMPLIANCE PACKAGE A1

1 ISSUED FOR PERMIT	255 Consumers Rd Suite 120 Toronto, ON M2J 1R4 1-416-630-2255 F-416-630-4782 vasdesign.com	VA3 DESIGN	Greenpark.	project no 18012 drawing no 9
no description	date by	255 Consumers Rd Suite 120 Toronto, ON M2J 1R4 1-416-630-2255 F-416-630-4782 vasdesign.com	project name MINNISALE HOMES CORP. BRAMPTON date JULY 2018 checked by drawn by ON	18012-GP-STD_DETAILS_A1

All drawings, specifications, related documents and design are the copyright property of VAS DESIGN. Reproduction of the property in whole or in part is strictly prohibited without VAS DESIGN's written permission.

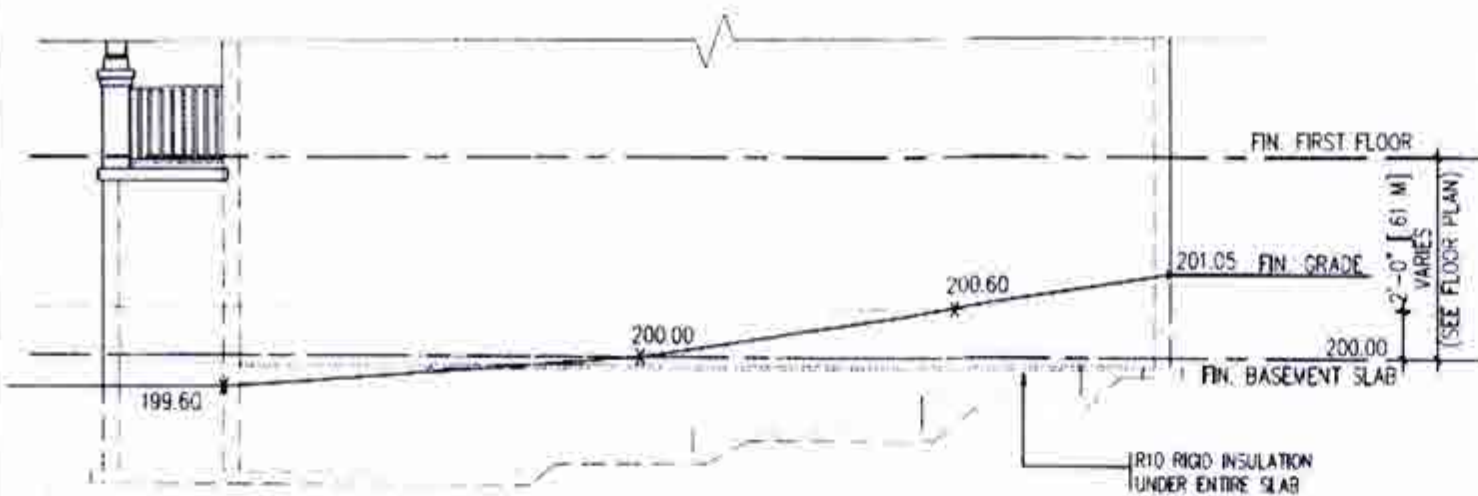


TYPICAL RIGHT SIDE ELEVATION

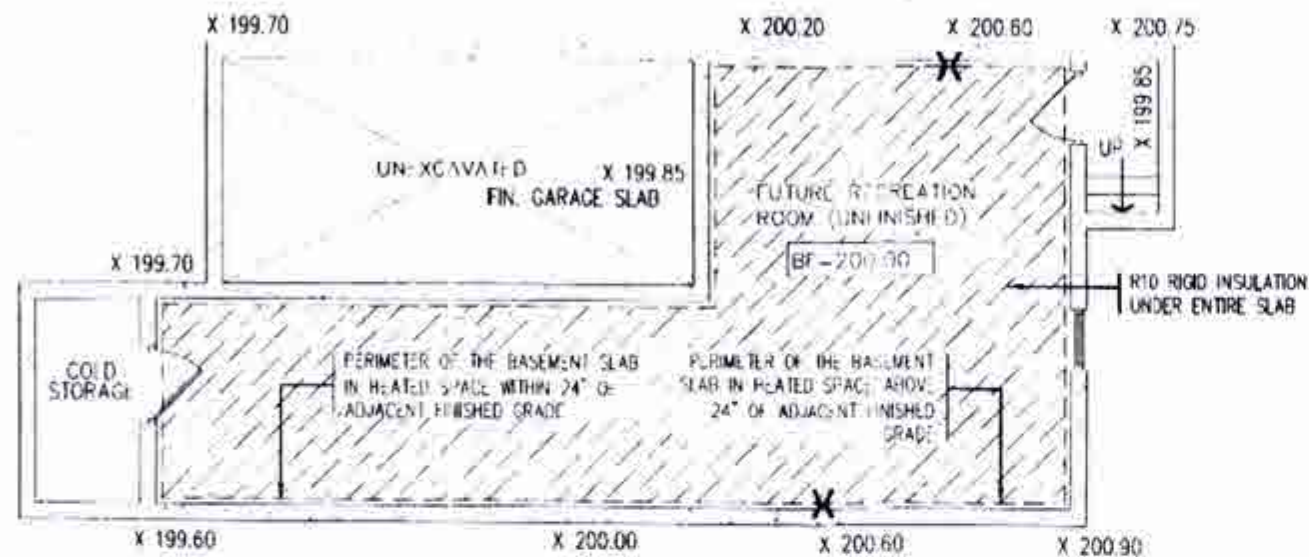


TYPICAL BASEMENT PLAN

SLAB ON GRADE CONDITION

- NOTES:
1. LEVELS SHOWN ON THE PLANS ARE FOR ILLUSTRATION PURPOSE ONLY. SEE FINAL GRADING PLAN FOR ACTUAL LEVELS.
 2. ALL LEVELS ARE SHOWN IN METRIC.

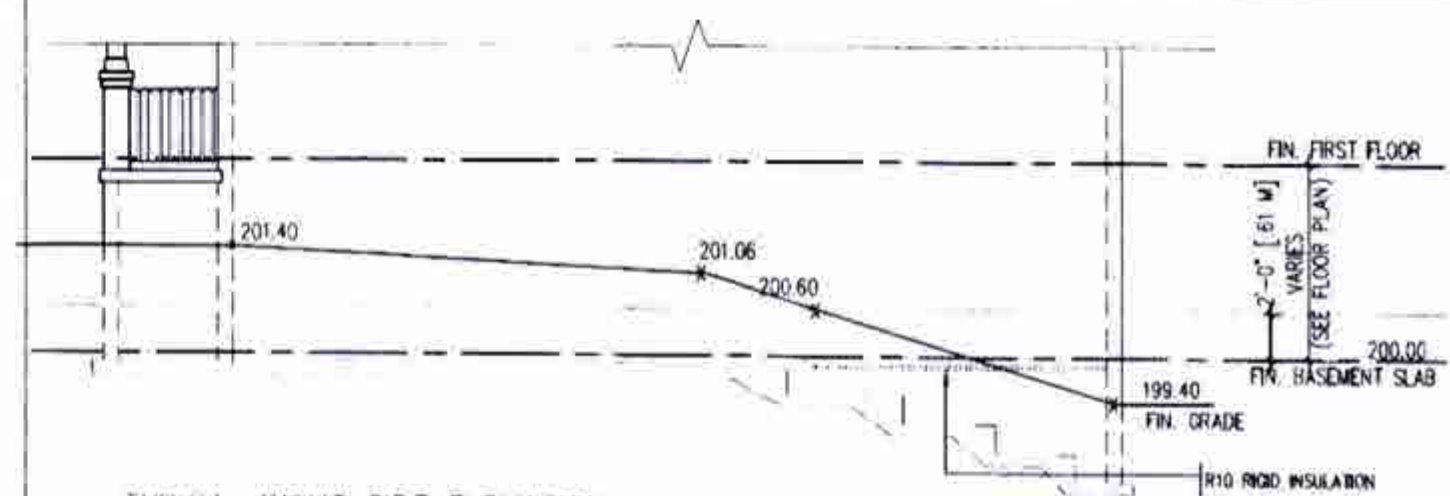


TYPICAL RIGHT SIDE ELEVATION

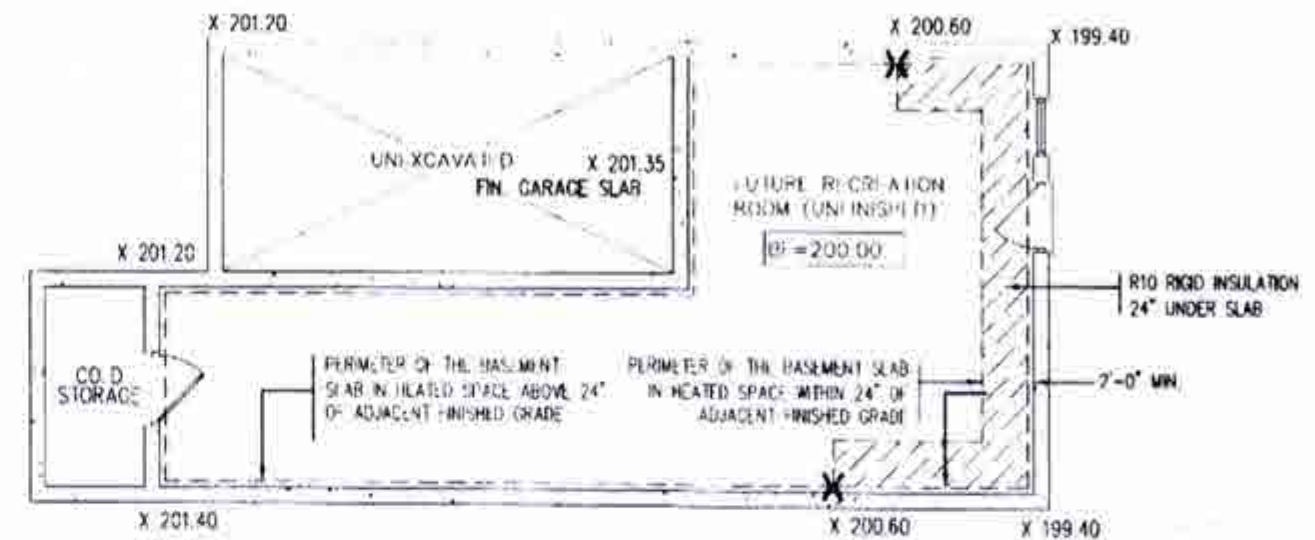


TYPICAL BASEMENT PLAN

WALK OUT BASEMENT CONDITION

- NOTES:
1. LEVELS SHOWN ON THE PLANS ARE FOR ILLUSTRATION PURPOSE ONLY. SEE FINAL GRADING PLAN FOR ACTUAL LEVELS.
 2. ALL LEVELS ARE SHOWN IN METRIC.

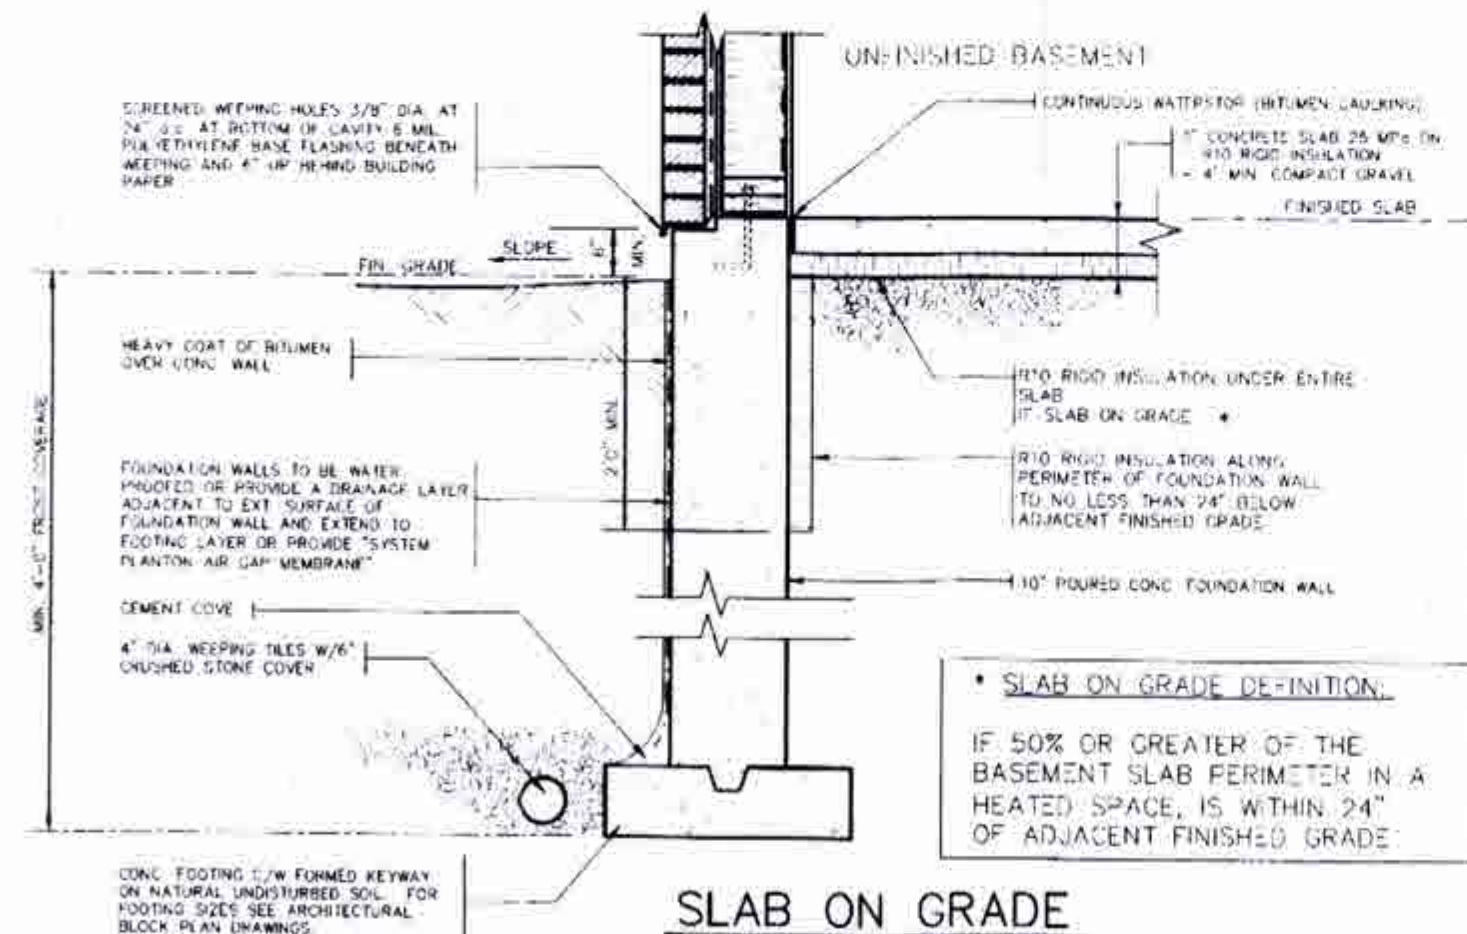

SLAB ON GRADE

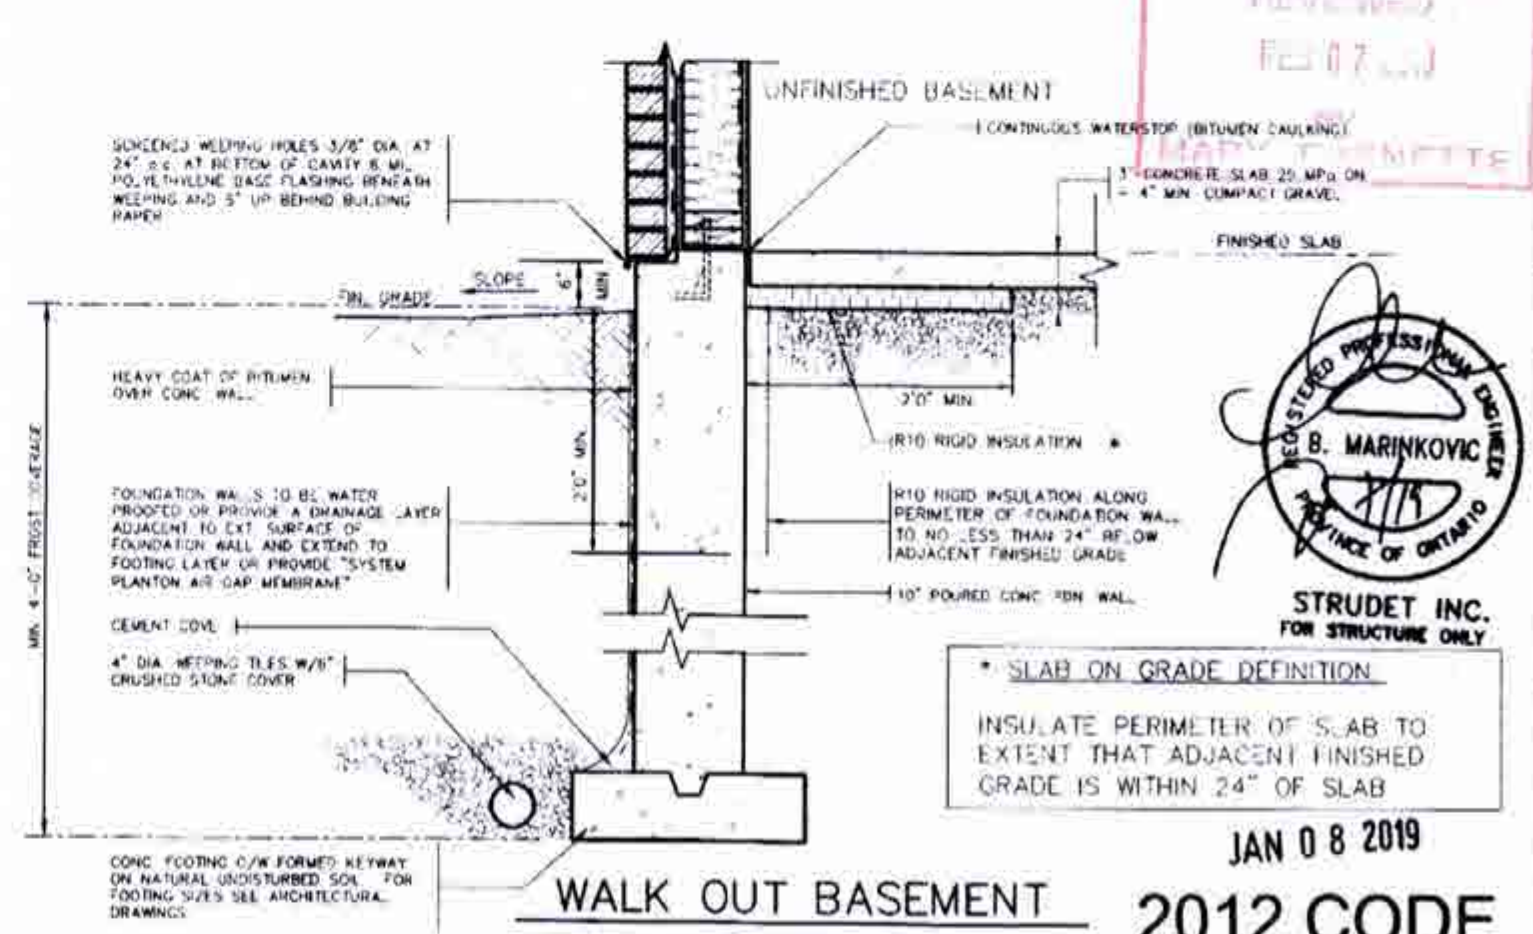

WALK OUT BASEMENT 2012 CODE COMPLIANCE PACKAGE A1

JAN 08 2019

1	ISSUED FOR PERMIT	DATE	BY	DESCRIPTION
2				
3				
4				
5				
6				
7				
8				
9				
10				

The undersigned has reviewed and takes responsibility for the design and has the qualifications and meets the requirements set out in the Ontario Building Code to be a Design Professional.

Richard Vink 24458
 VAS Design Inc. 42658

VA3 DESIGN

255 Consumers Rd Suite 120
 Markham, ON M2J 1R4
 416-430-5155 / 416-430-4782
 vasdesign.com

Greenpark.

Project Name: MINNISALE HOMES CORP. Municipality: BRAMPTON Project No: 18012
 Date: JULY 2018
 Drawing Title: SLAB ON GRADE/ WALKOUT BASEMENT
 Drawing No: 18012-GP-STD-DETAL_A1
 Scale: 1/8" = 1'-0"

10