

CONSTRUCTION SUMMARY		RECEIVED MAY 28 2019	
Mayfield Village 2 (G) - Minnisale Homes Corp.			
PURCHASERS: RAMYA NONAVINAKERE SRINIVA and PRAMOD MUTTANNA SITARAM		TEL: RES.: 647-671-3675	
LOT / PHASE	REG. PLAN #	HOUSE TYPE	
8 / 2	43M-2060	Millwood 1 Elev 3 (4 Bedroom Plan)	

ELECTRICAL

8 - POT LIGHT - LED - FIRST FLOOR INSTALLATION 28May19 Note:	
1 - LIGHT AND SWITCH - NO FIXTURE INCLUDED - LIVING ROOM 28May19 Note:	
1 - PLUG - ELECTRICAL PLUG 7FT FROM FLOOR- FAMILY ROOM- SEE SKETCH 28May19 Note:	
1 - PLUG - ELECTRICAL PLUG - TO BE INSTALLED OVER FIREPLACE 28May19 Note:	
1 - PLUG - ELECTRICAL PLUG WITH GFI AND SWITCH - FOR FESTIVE LIGHTING 28May19 Note:	
1 - 200 AMP ELECTRICAL SERVICE 28May19 Note:	

PLUMBING

2 - TOE TESTER - ADD TOE TESTER TO SHOWER- MASTER SHOWER AND MAIN SHOWER 28May19 Note:	
1 - 5 FOOT SHOWER WITH SLIDING GLASS CHROME DOORS IN LIEU OF TUB- MAIN BATHROOM 28May19 Note:	





PROMOTIONAL

1 - PARTIAL REDEMPTION OF PROMOTIONAL PACKAGE \$5,585 BALANCE FORWARD \$14,415 TO BE USED AT A LATER DATE. ORIGINAL PROMOTIONAL PACKAGE OF \$20,000 AS PER SCHEDULE PE 28May19 Note:	
1 - PARTIAL REDEMPTION OF PROMOTIONAL PACKAGE \$\$\$\$\$\$ BALANCE FORWARD TO BE USED AT A LATER DATE. ORIGINAL PROMOTIONAL PACKAGE OF \$\$\$\$\$\$ AS PER SCHEDULE PE DATED MMMDDYYYY. 28May19 Note:	

EXTRAS AS PER OFFER

(20) The Vendor agrees that notwithstanding any other term or provision in this Agreement included in the Purchase Price and in addition to those items detailed in Schedule GP to the Agreement of Purchase and Sale, the Purchaser is entitled to a credit o Worksheet Note:	
The Purchaser acknowledges that the Purchase Price is inclusive of all credits and promotional packages available at the time of purchase. Worksheet Note:	

This Document is Extremely Time Sensitive - Printed 28 May 19 at 11:59

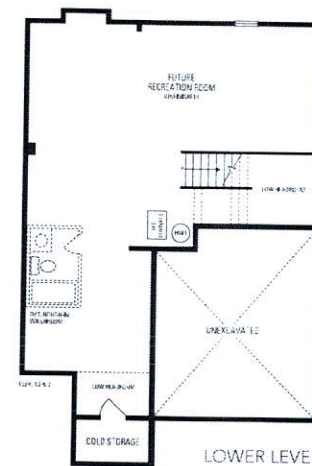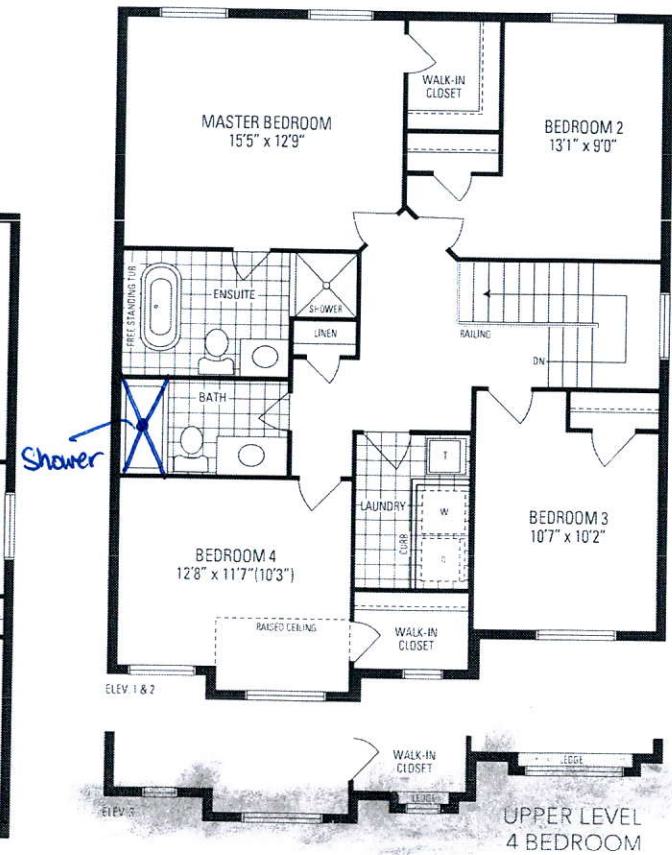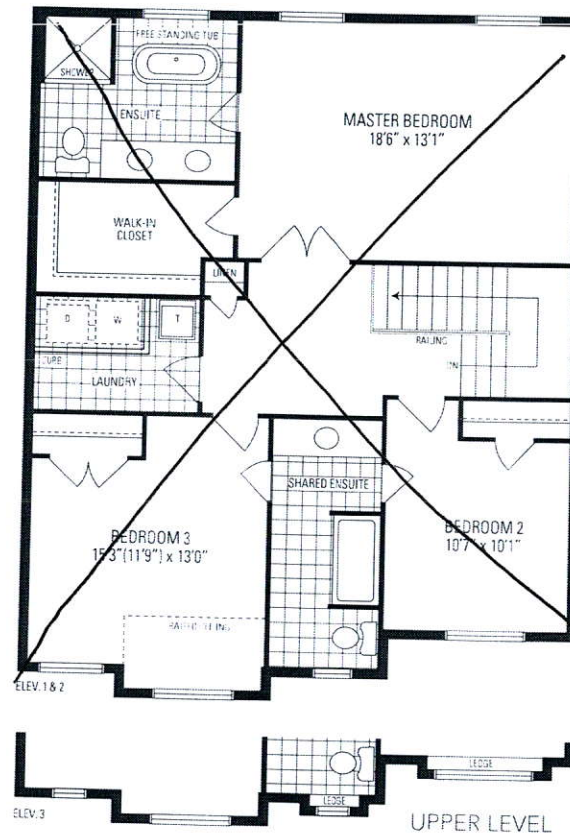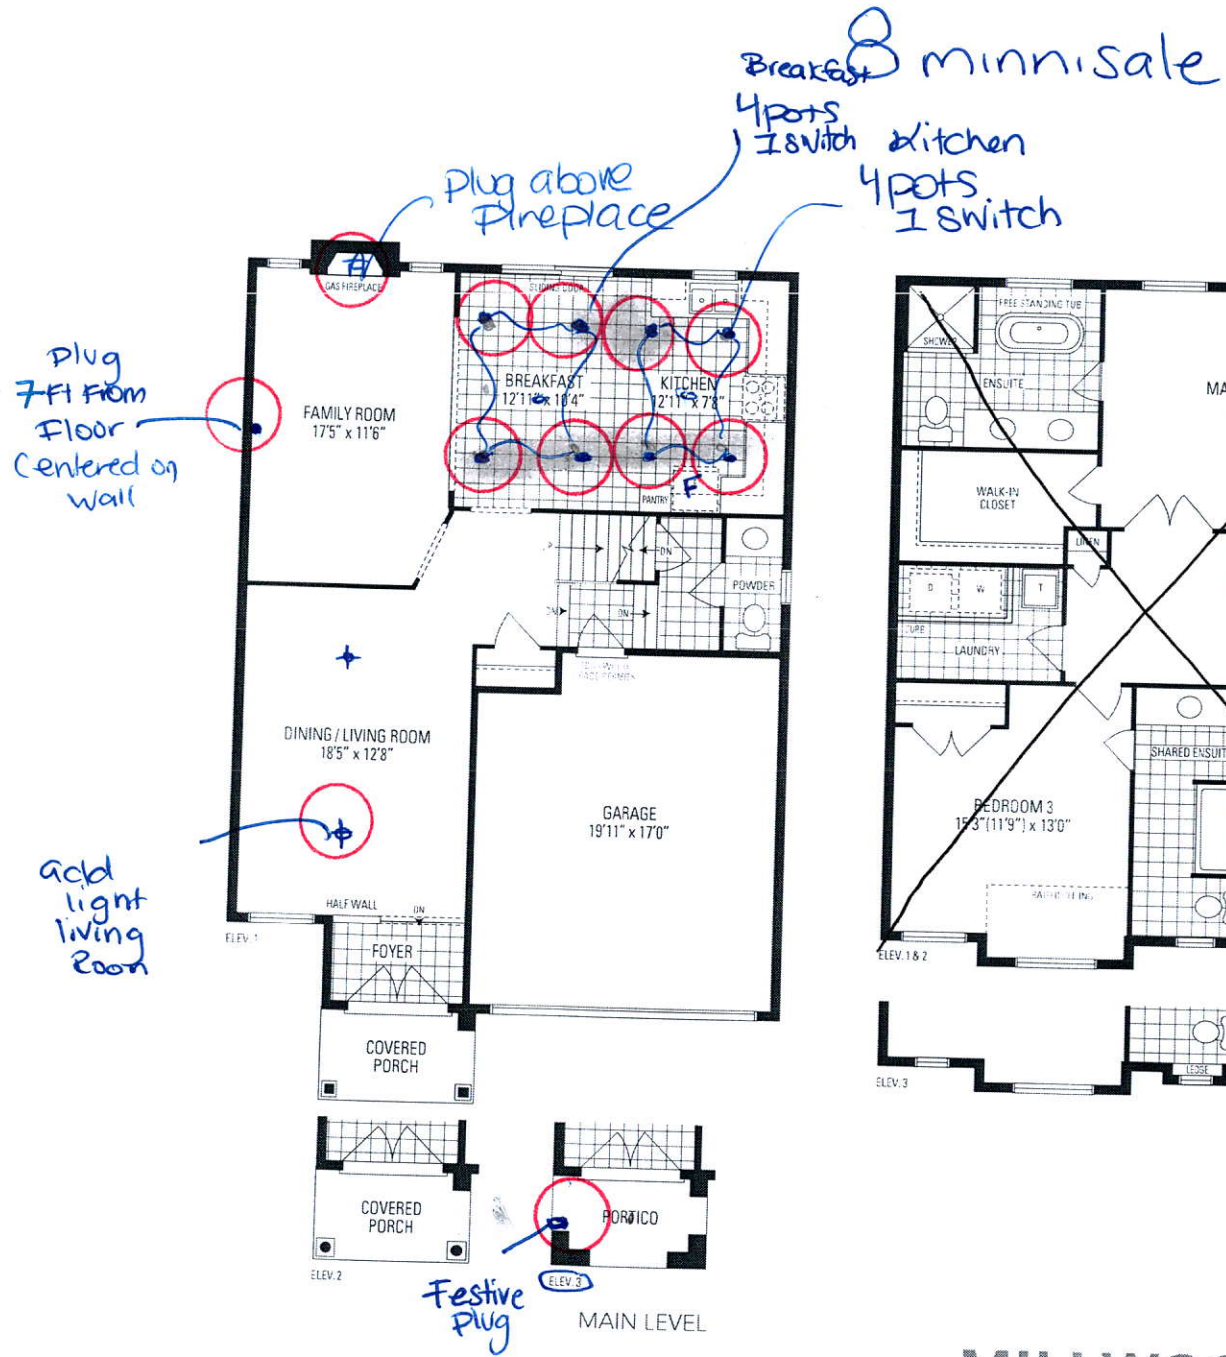

MILLWOOD 1

38' LOT • 2,194 SQ.FT.

Orientation of home may be reversed and purchaser agrees to accept the same. Steps and porches may vary at any exterior entrance ways due to grading variance. Actual usable floor space may vary from the stated floor areas. All renderings are artist's concept. Dimensions, specifications and architectural detailing subject to modifications. Roofline and adjoining model types may vary due to siting. E. & O. E. June 2018