


OPENINGS WITHIN GUARDS AND SPACES
BETWEEN GUARDS AND ALL FINISHED
SURFACES SHALL NOT EXCEED 100 MM.
GUARDS SHALL BE DESIGNED TO
NOT FACILITATE CLIMBING

THIS STRUCTURE MUST BE
CONSTRUCTED TO MEET OR
EXCEED THE PROVISIONS OF
THE ONTARIO BUILDING CODE

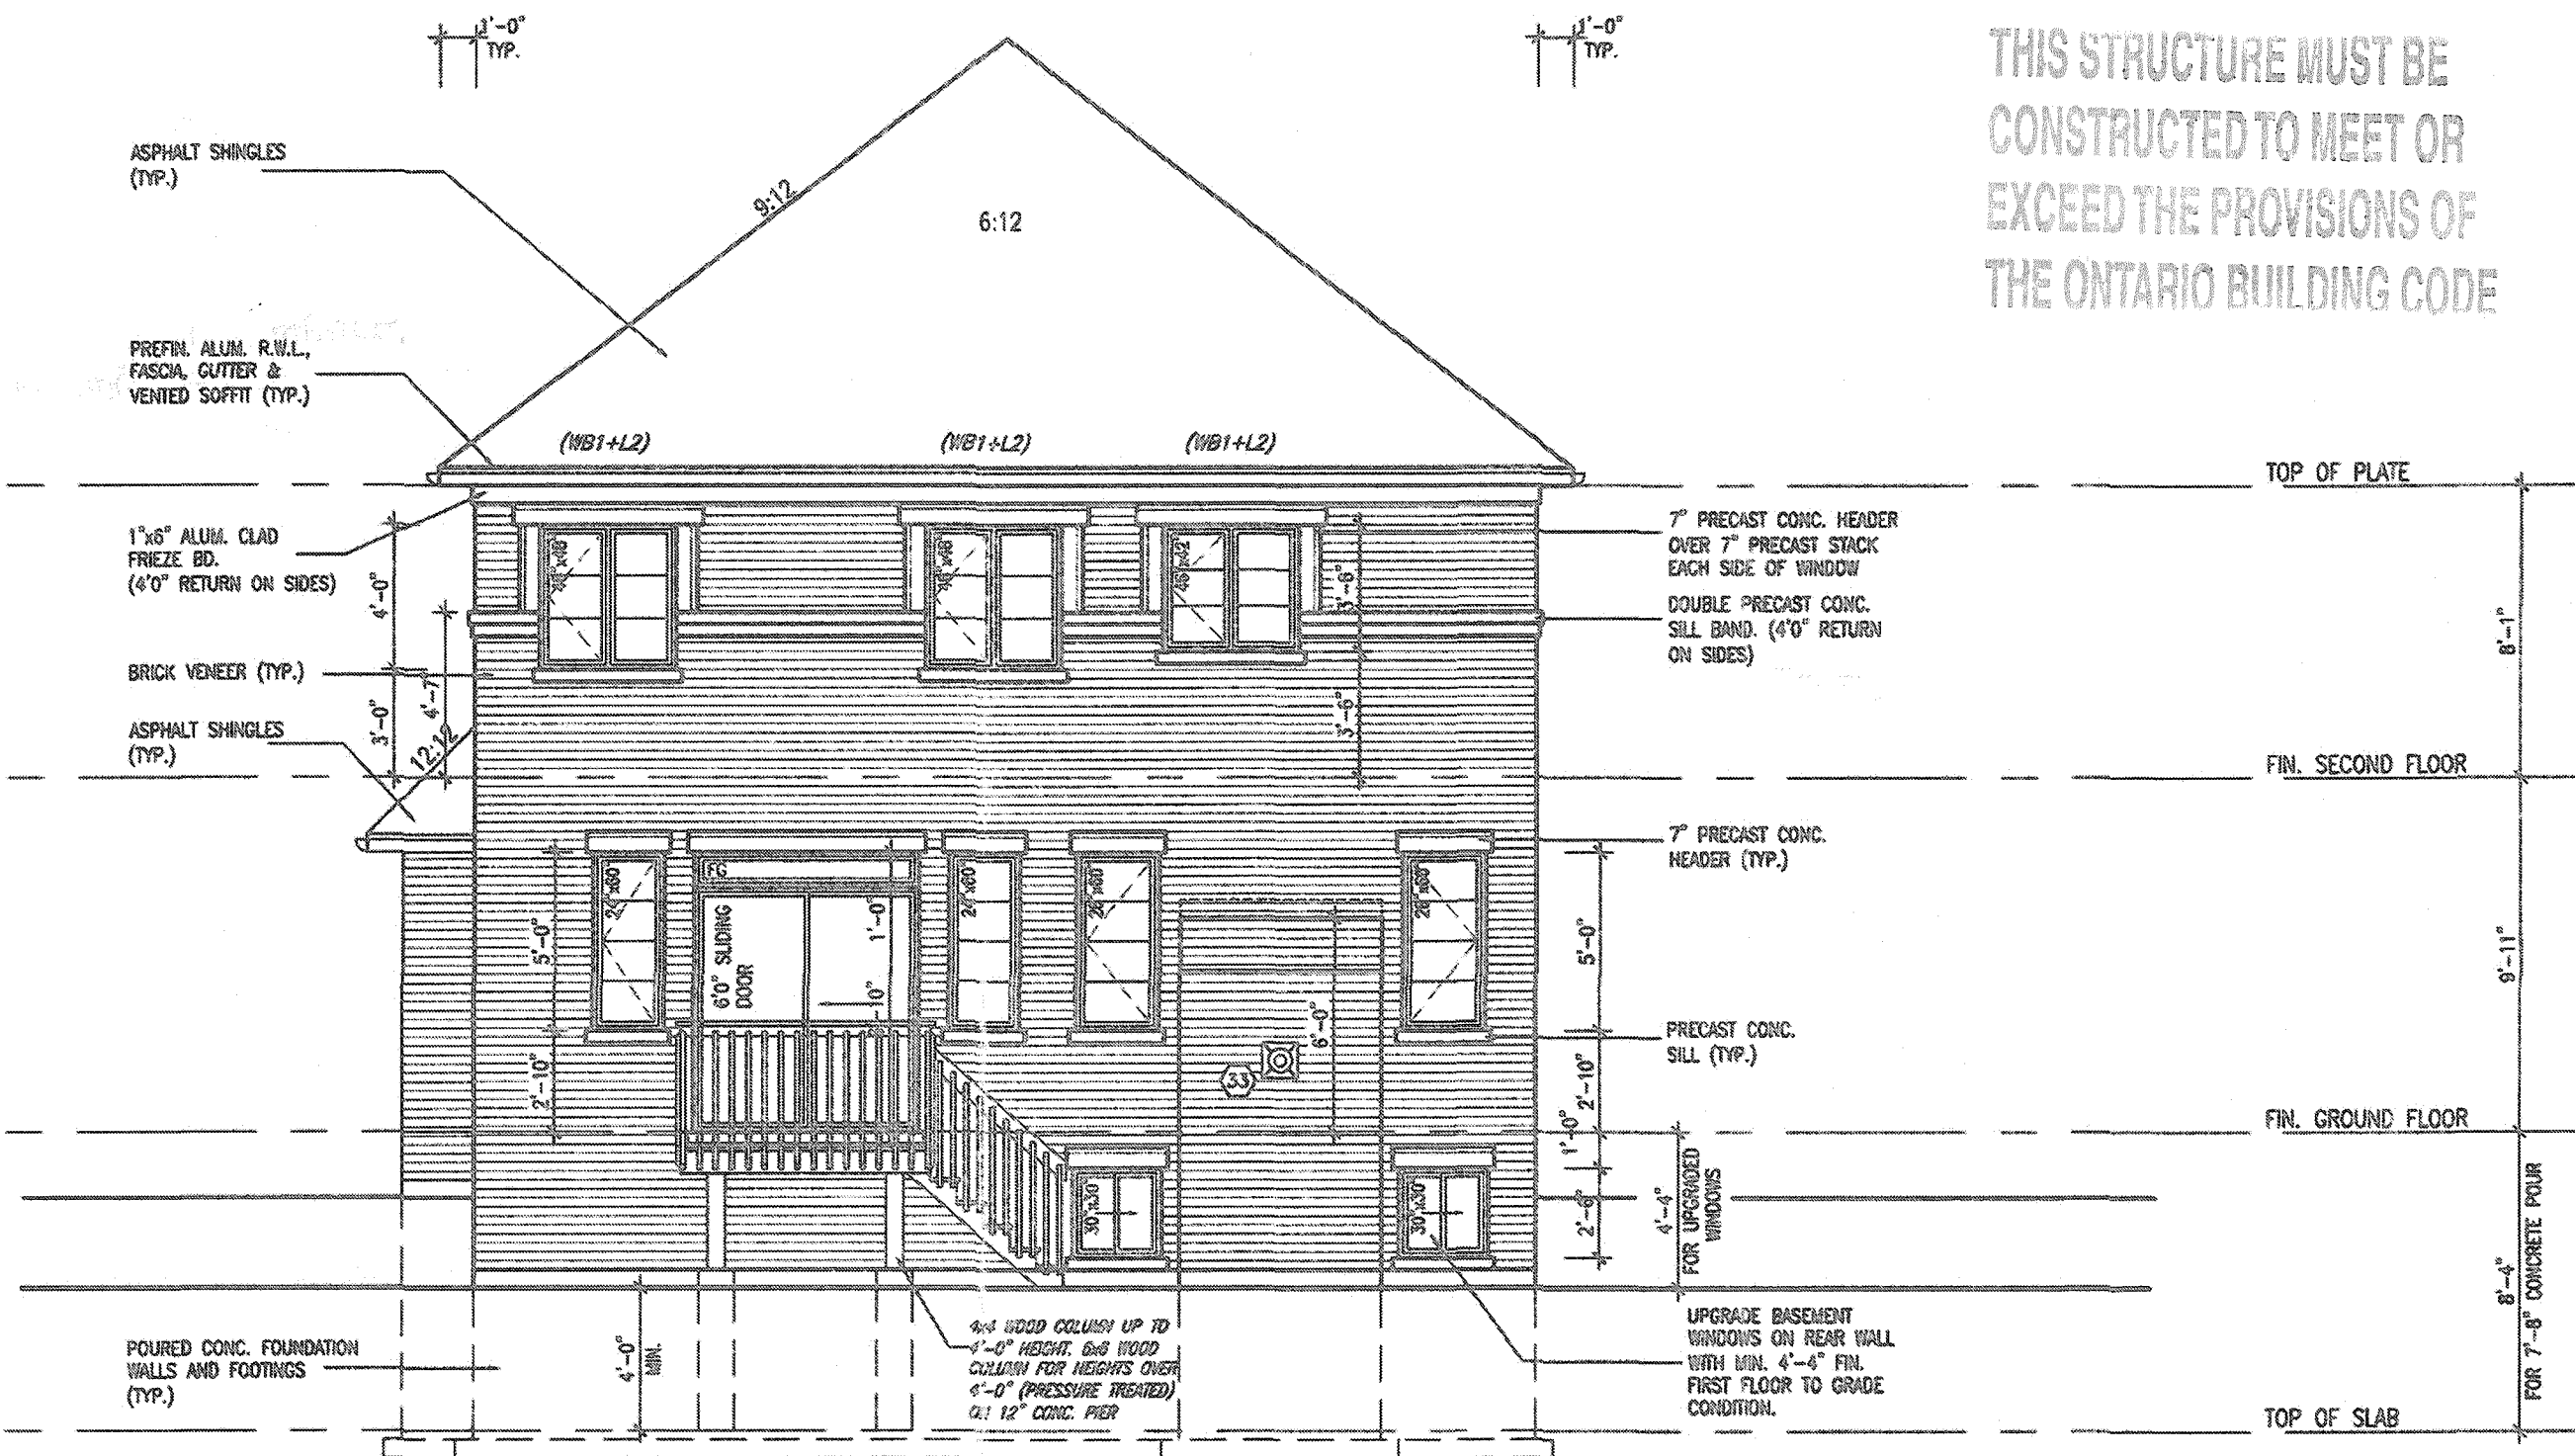

RECEIVED
AUG 28 2019
TOWN OF CALEDON
BUILDING SECTION
FILE NO _____

JUL 30 2019

PRESTON 3
ENERGY STAR

[illegible]

