

<div>CONSTRUCTION SUMMARY</div> <div>Mountainview Heights 3 (G) - Russell Gardens Building Ltd.</div>					<div>JUL 27 2020</div>
PURCHASER: Gurbax SINGH				TEL:	
LOT / PHASE	REG. PLAN #	HOUSE TYPE			
13 / 3	62M-1266	Mountainash Five (5 Bedroom) Elev 2			

CONSTRUCTION

1 - SHARED ENSUITE BEDROOM 4/5 -- 5 FOOT SHOWER WITH SLIDING GLASS CHROME DOORS IN LIEU OF TUB	
15Jul20 Note:	

PLUMBING

3 - TOE TESTER - ADD TOE TESTER TO SHOWER - ALL SHOWERS	
15Jul20 Note:	

PROMOTIONAL





1 - PARTIAL REDEMPTION OF PROMOTIONAL PACKAGE \$2,450.00 BALANCE (\$12,550.00) FORWARD TO BE USED AT A LATER DATE. ORIGINAL PROMOTIONAL PACKAGE OF \$15,000 AS PER SCHEDULE PE DATED 06/27/2020.	
15Jul20 Note:	

EXTRAS AS PER OFFER

The Vendor agrees that notwithstanding any other term or provision in this Agreement included in the Purchase Price and in addition to those items detailed in Schedule GP to the Agreement of Purchase and Sale, the Purchaser is entitled to a credit of Fif	
Worksheet Note:	
200 AMPS	
Worksheet Note:	
3 Larger Basement Windows - subject to Engineering Approval	
Worksheet Note:	
WALKOUT DECK	
Worksheet Note:	

This Document is Extremely Time Sensitive - Printed 15 Jul 20 at 10:14

Walk-Out
Larger Basement Windows

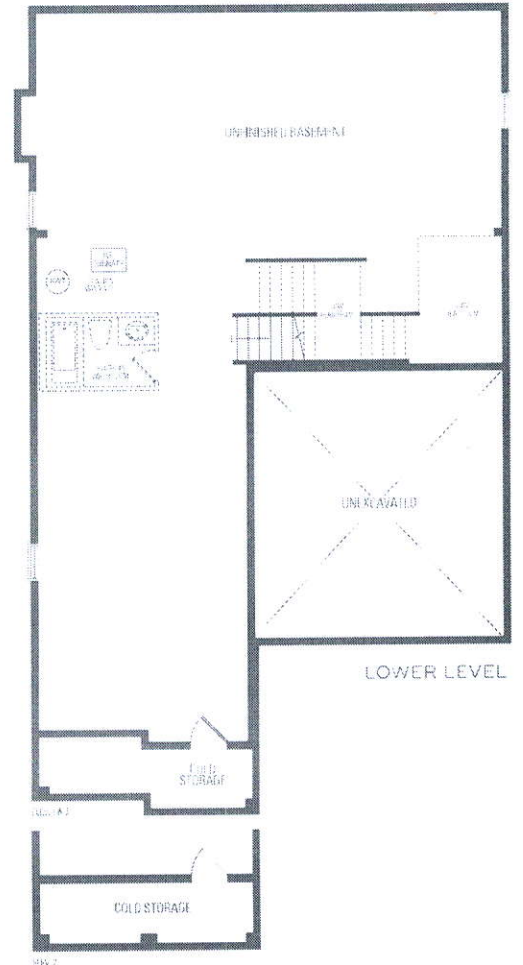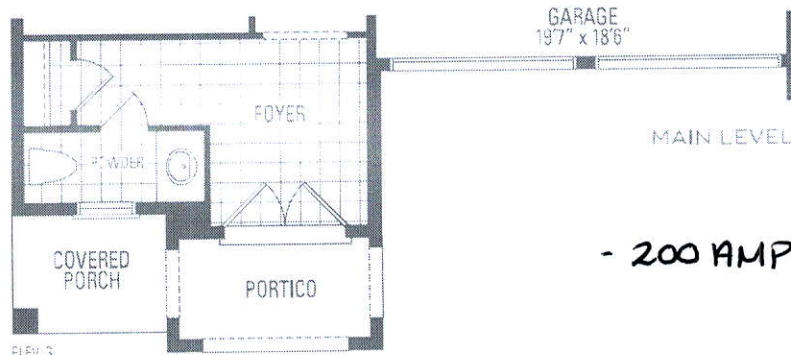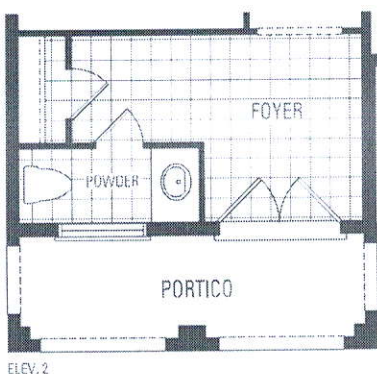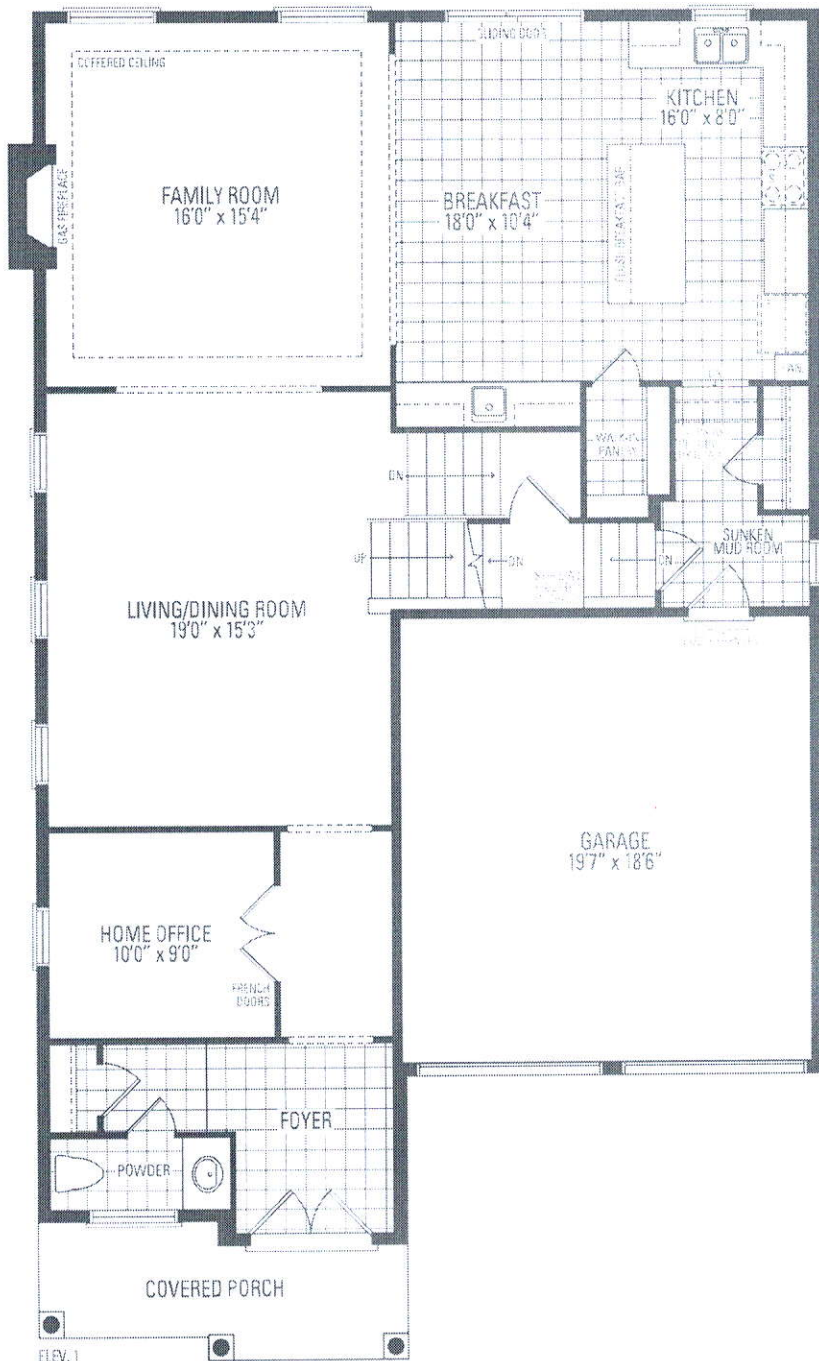

- 200 AMP


MOUNTAINASH FIVE ELEV. 1 • 3,288 sq.ft. | ELEV. 2 • 3,291 sq.ft.

Orientation of home may be reversed and purchaser agrees to accept the same. Steps and porches may vary at any exterior entrance ways and the stated floor areas. All renderings are artist's concept. Dimensions, specifications and architectural detailing subject to modifications. Roofline

5 BEDROOM LAYOUT

MOUNTAINASH FIVE

ELEV. 1 • 3,288 sq.ft. | ELEV. 2 • 3,291 sq.ft. | ELEV. 3 • 3,298 sq.ft.

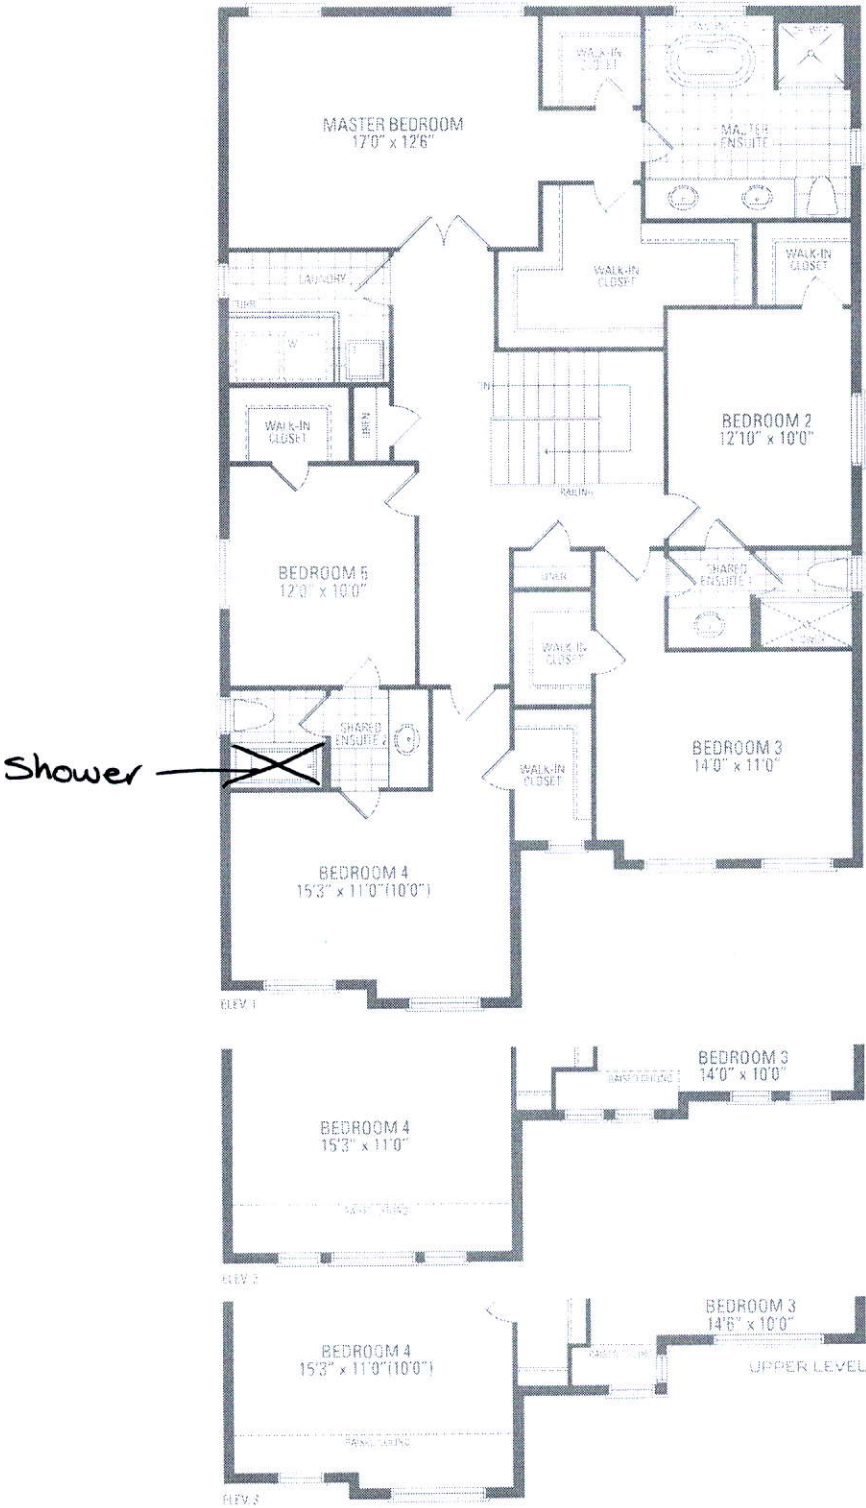

Construction of home may be altered and amended without notice. Steps and porches may vary in size and/or location. Actual usable floor space may vary from the stated floor plan. All dimensions are in feet and inches. Dimensions are approximate and do not include wall thickness. Building and floor plan details may vary due to site. E.N.D. May 2020