

CONSTRUCTION SUMMARY

Mountainview Heights 3 (G) - Russell Gardens Building Ltd.

PURCHASERS: PARAG ROHITKUMAR PARIKH and CHAITALI P PARIKH

TEL: RES.: 416-605-5661

LOT / PHASE 217 / 3	REG. PLAN # 62M-1266	HOUSE TYPE Mountainash Four (5 Bedroom) Elev 3		
------------------------	-------------------------	---	--	--

CONSTRUCTION

1 - SMOOTH CEILINGS ON FIRST FLOOR ONLY - DET 03May21 Note:	
1 - FIRST FLOOR - ROUNDED BEADED CORNERS 03May21 Note:	
1 - DELETE BULK HEADS IN KITCHEN IF CONSTRUCTION PERMITS 03May21 Note:	
1 - KITCHEN - RELOCATE STANDARD SINK & DISHWASHER FROM ISLAND TO PERIMETER AS PER SKETCH - IF CONSTRUCTION PERMITS 03May21 Note:	

PLUMBING

1 - KITCHEN - RELOCATE STANDARD SINK & DISHWASHER FROM ISLAND TO PERIMETER AS PER SKETCH - IF CONSTRUCTION PERMITS 03May21 Note:	
1 - 5 FOOT SHOWER WITH SLIDING GLASS CHROME DOORS IN LIEU OF TUB - IF CONSTRUCTION PERMITS - ENSUITE 2/3 BATHROOM 03May21 Note:	

PROMOTIONAL



1 - PARTIAL REDEMPTION OF PROMOTIONAL PACKAGE \$10,400.00 BALANCE FORWARD (\$14,600.00) TO BE USED AT A LATER DATE. ORIGINAL PROMOTIONAL PACKAGE OF \$25,000.00 AS PER SCHEDULE PE 03May21 Note:	
---	--

EXTRAS AS PER OFFER




(1) The Vendor agrees that notwithstanding any other term or provision in this Agreement included in the Purchase Price and in addition to those items detailed in Schedule GP to the Agreement of Purchase and Sale, the Purchaser is entitled to a credit of Worksheet Note:	
200 AMP SERVICE LABELLED WITH CIRCUIT BREAKER PANEL TO UTILITY AUTHORITY STANDARDS. Worksheet Note:	
Purchase Price includes 4 enlarged basement windows, and the obligation to construct the house with the enlarged basement windows is subject to the Vendor?s approval, in its sole and unfettered discretion The Purchaser acknowledges and agrees that the lo Worksheet Note:	
10 foot ceiling height on Main Floor. The Purchaser acknowledges that as a result of the increased ceiling height from the Vendor?s standard ceiling height, various modifications to the interior and exterior of the dwelling unit may be made, including bu Worksheet Note:	
PURCHASER(S) ACKNOWLEDGES THAT THE PURCHASE PRICE IS INCLUSIVE OF ALL CREDITS AND PROMOTIONAL PACKAGES AVAILABLE AT TIME OF PURCHASE. Worksheet Note:	

This Document is Extremely Time Sensitive - Printed 3 May 21 at 9:37

RECEIVED
MAY 03 2021

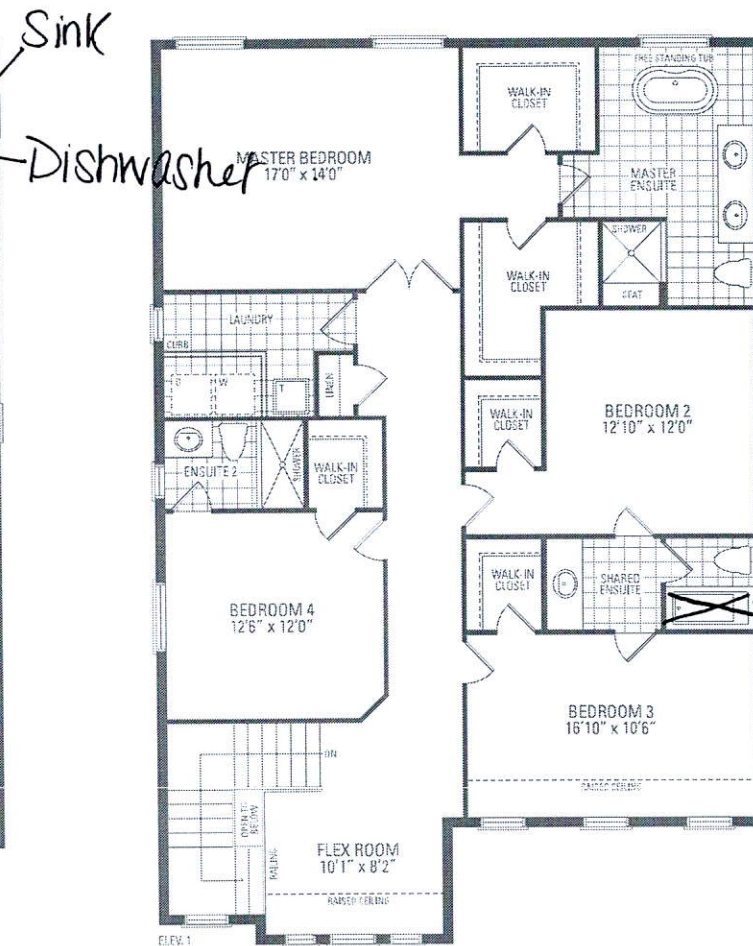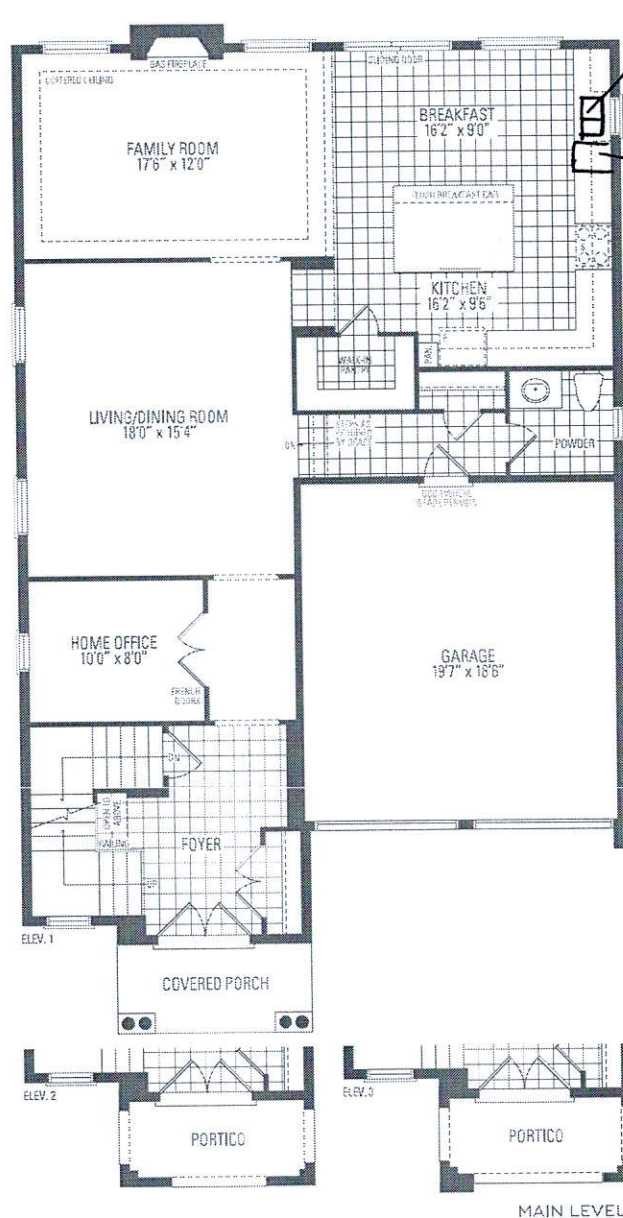

5' Shower

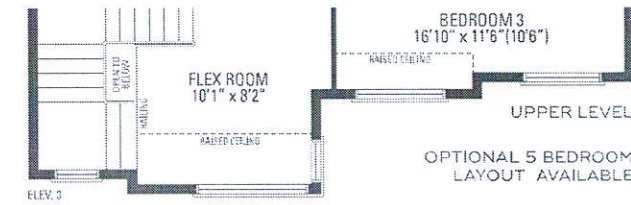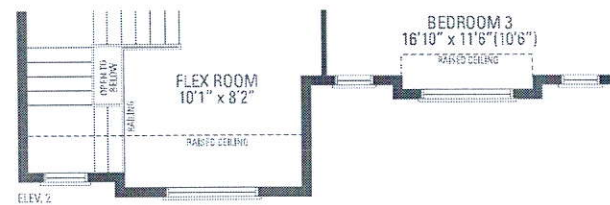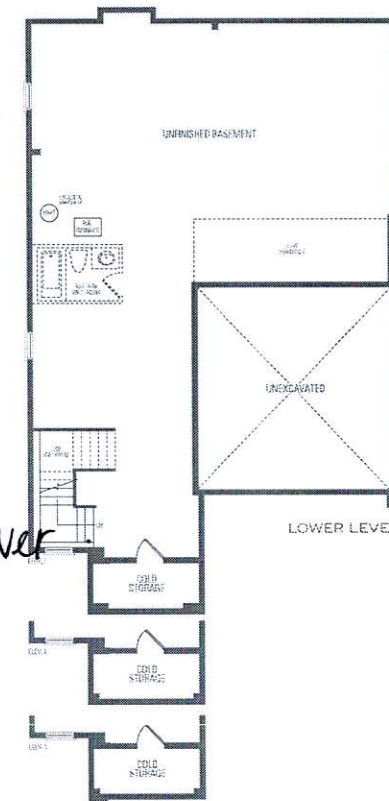

OPTIONAL 5 BEDROOM LAYOUT AVAILABLE

MOUNTAINASH FOUR ELEV. 1 • 3,189 sq.ft. | ELEV. 2 • 3,191 sq.ft. | ELEV. 3 • 3,196 sq.ft.

Orientation of home may be reversed and purchaser agrees to accept the same. Steps and porches may vary at any exterior entrance ways due to grading variance. Actual usable floor space may vary from the stated floor areas. All renderings are artist's concept. Dimensions, specifications and architectural detailing subject to modifications. Roofline and adjoining model types may vary due to siting. E. & D. E. May 2020

