

CONSTRUCTION SUMMARY

Mountainview Heights 3 (G) - Russell Gardens Building Ltd.

PURCHASERS: Ninoslav TAMBUR and Anita TAMBUR TEL:

LOT / PHASE 360 / 4	REG. PLAN # 62M-1266	HOUSE TYPE Springfield One (4 Bedroom) Elev 3		
------------------------	-------------------------	--	--	--

ELECTRICAL

1 - 200 AMP ELECTRICAL SERVICE 31May21 Note:	
---	--

PLUMBING

2 - TOE TESTER - ADD TOE TESTER TO SHOWERS 31May21 Note:	
---	--

PROMOTIONAL

1 - LESS CREDIT FROM PURCHASER EXTRA SHEET IN OFFER 31May21 Note: NEW PROMO BALANCE \$8575.00	
--	--

EXTRAS AS PER OFFER

(1) The Vendor agrees that notwithstanding any other term or provision in this Agreement included in the Purchase Price and in addition to those items detailed in Schedule GP to the Agreement of Purchase and Sale, the Purchaser is entitled to a credit of Worksheet Note:	
Granite kitchen counter top, from Vendor?s standard samples Worksheet Note:	
PURCHASER(S) ACKNOWLEDGES THAT THE PURCHASE PRICE IS INCLUSIVE OF ALL CREDITS AND PROMOTIONAL PACKAGES AVAILABLE AT TIME OF PURCHASE. Worksheet Note:	

This Document is Extremely Time Sensitive - Printed 31 May 21 at 14:36


CONSTRUCTION SUMMARY

PRELIMINARY: DATE JUN 23 2021

FINAL: DATE

## A large, two-story brick house with a dark, gabled roof. The exterior is made of light-colored bricks. The house features a covered front porch supported by white columns, a central entrance with a dark door, and a two-car garage with dark doors. There are several windows, including arched ones on the second floor. The house is surrounded by a green lawn and some landscaping, including a small garden bed in the foreground.

A two-story house with a stone and brick exterior, a gabled roof, and a two-car garage. The house features a central entrance with a small porch and a large window. The garage is located on the right side of the house. The house is surrounded by a green lawn and trees.

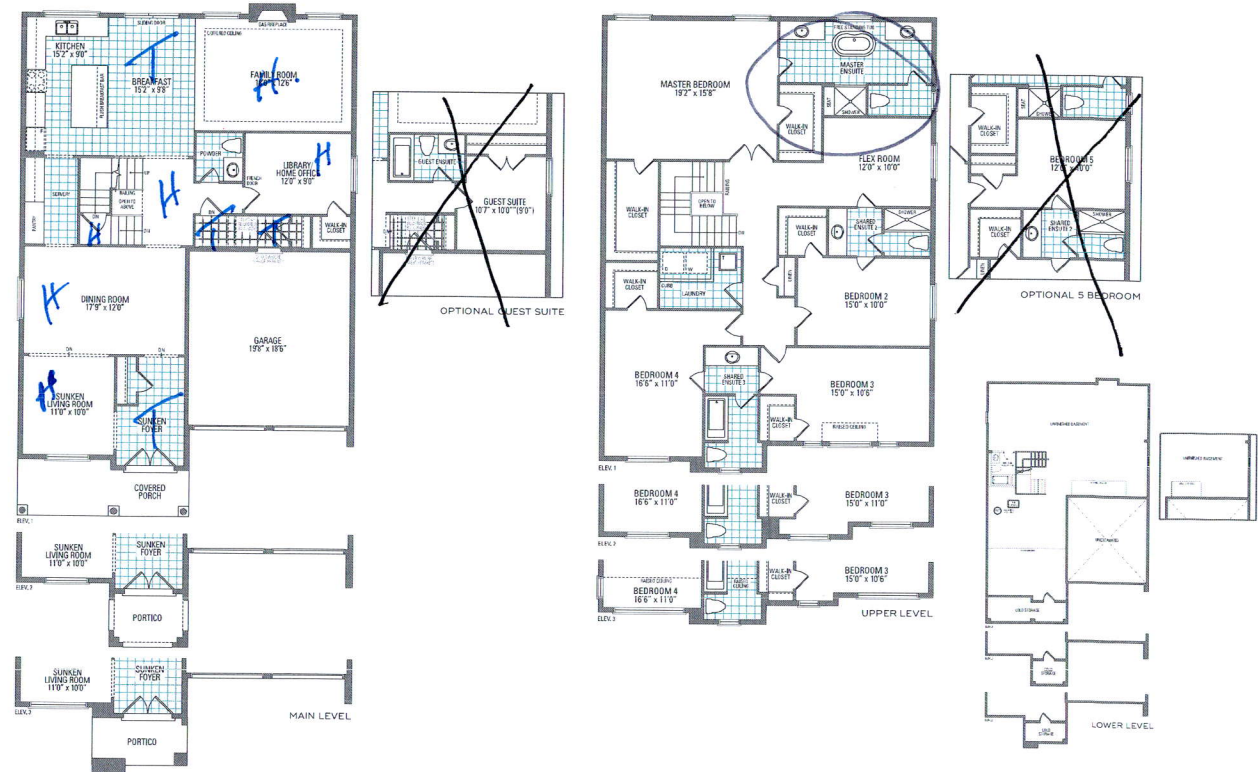

Orientation of home may be reversed and purchaser agrees to accept same. Steps and porches may vary at any exterior entrance ways due to grading variance. Actual usable floor space may vary from the stated floor areas. All renderings are artist's concept. Dimensions, specifications and architectural detailing subject to modifications. Roofline and adjoining model types may vary due to siting. E. & O. E. May 2021