Greenpark.

ai ceilpe			
		ONSTRUCTION SUMMARY	
PURCHASERS: Caroline	Mountainvi	ew Heights 3 (G) - Russell Gardens Building Lt	d.
		regory Osadebamwen OSAGIE	TE
LOT / PHASE 562 / 4	REG. PLAN # 62M-1266	HOUSE TYPE Springfield Two (4 Bed with Guest Suite) Elev 1	
CONSTRUCTION			
1 - OAK STAIRS TO BASE 23Jul21 Note:	MENT FROM MAIN FL	OOR-NATURAL FINISH	
2304121			
MIDDODS AND CLASS			
MIRRORS AND GLASS			
23Jul21 Note:	RAMELESS GLASS SHO	OWER ENCLOSURE – INCLUDES CHROME KNOB AN	D HINGES
PLUMBING			tal last procession to the second process of the second se
1 - WATER LINE FOR FRII	OGE - ROUGH-IN ONLY	7	
	FOOT SHOWER WITH	I SLIDING GLASS CHROME DOORS IN LIEU OF TUB	
23Jul21 Note:			
PROMOTIONAL			
1 - LESS CREDIT FROM PU 23Jul21 Note: NEW PR	JRCHASER EXTRA SHI ROMO BALANCE \$93		
200 at 21 Hote. NEW 11	COMO BALANCE \$93	33.00	
	T	EVTDACAC BED OFFED	
	r	EXTRAS AS PER OFFER	
(1) The Vendor agrees that	notwithstanding any ot	her term or provision in this Agreement included in the	e Purchase Price and in
addition to those items deta Worksheet Note:	iled in Schedule GP to	the Agreement of Purchase and Sale, the Purchaser is	entitled to a credit of
Worksheet Note.			
PURCHASER(S) ACKNO PROMOTIONAL PACKA		E PURCHASE PRICE IS INCLUSIVE OF ALL CRE	DITS AND
Worksheet Note:	GES AVAILABLE AT	TIME OF FURCHASE.	
Cit-1-it-1	C . X 1 0 / 1		
Granite kitchen counter top Worksheet Note:	, from vendor?s standa	iru sampies	
Purchase Price includes 3 e	nlarged basement wind	ows, and the obligation to construct the house with the	enlarged basement

This Document is Extremely Time Sensitive - Printed 23 Jul 21 at 12:00

windows is subject to the Vendors approval, in its sole and unfettered discretion The Purchaser acknowledges and agrees that the

CONSTRUCTION SUMMARY

PRELIMINARY: DATE JUL 2 8 2021

FINAL: DATE

loc

Worksheet Note:

47' LOT SPRINGFIELD TWO

*Greenpark








ELEVATION 1 · 3,551 sq.ft.

ELEVATION 3 · 3,547 sq.ft


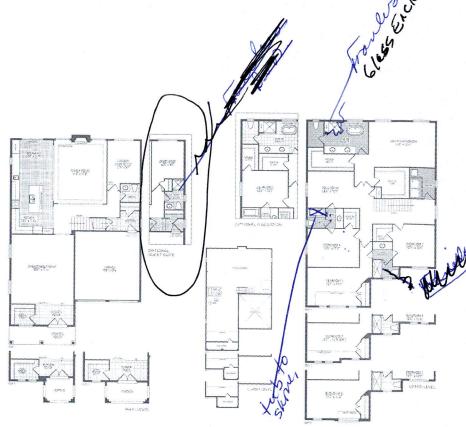

