Greenpark

Revised

RECEIVED
MAY 27 2022

CONSTRUCTION SUMMARY

Mountainview Heights 3 (G) - Russell Gardens Building Ltd.

PURCHASERS: Wajid Abdul SYED and Erum WAJID SYED **TEL:** RES.: 437-349-9009

LOT / PHASE	REG. PLAN #	HOUSE TYPE		
599 / 4	62M-1266	Grandville Three Elev 3		

CABINETRY

1 - VANITY - POWDER ROOM - UPGRADE 5 *11May22* Note: New ☆	
1 - LAUNDRY ROOM - UPGRADE STANDARD UPPER & BASE CABINETRY TO UPGRADE 5 - 30" UPPERS WITH EXTENSION ABOVE WASHER AND DRYER - ADD ONE FOOT OF BASE CABINETRY *11May22* Note:	☆
1 - ~~***DELETE - LAUNDRY ROOM - UPGRADE STANDARD UPPER & BASE CABINETRY TO UPGRADE 2 - 30" UPPERS WITH EXTENSION ABOVE WASHER AND DRYER - ADD ONE FOOT OF BASE CABINETRY~~ *11May22* Note:	
1 - MUD ROOM - UPGRADE 1 HARDWARE ON CUSTOM BENCH *14Apr22* Note:	
1 - LAUNDRY ROOM - UPGRADE 1 HARDWARE - INCLUDES EXTENSION *14Apr22* Note:	
1 - ~~LAUNDRY ROOM - UPGRADE STANDARD UPPER AND BASE CABINETRY TO UPGRADE 2 - 30" UPPERS WITH EXTENTION~~ ABOVE WASHER AND DRYER - ADD ONE FOOT OF BASE CABINETRY *14Apr22* Note:	
1 - KITCHEN CABINETRY - TWO COLOUR KITCHEN - FLAT FEE *14Apr22* Note:	
1 - KITCHEN - LIGHT VALANCE - NO ELECTRICAL *14Apr22* Note:	
1 - KITCHEN - CROWN MOULDING WITH HEADER - CM3 *14Apr22* Note:	
1 - CABINETRY - KITCHEN - UPGRADE 5 *14Apr22* Note:	
1 - VANITY - GUEST ENSUITE BATHROOM - HARDWARE UPGRADE 1 *14Apr22* Note:	
1 - VANITY - GUEST ENSUITE BATHROOM - UPGRADE 1 *14Apr22* Note:	
1 - VANITY - ENSUITE 5 BATHROOM - HARDWARE UPGRADE 1 *14Apr22* Note:	
1 - VANITY - ENSUITE 5 BATHROOM - UPGRADE 5 CABINETRY *14Apr22* Note:	
1 - VANITY - SHARED ENSUITE 3/4 BATHROOM - HARDWARE UPGRADE 1 *14Apr22* Note:	
1 - VANITY - ENSUITE 3/4 BATHROOM - UPGRADE 5 CABINETRY *14Apr22* Note:	
1 - VANITY - ENSUITE 2 BATHROOM - HARDWARE UPGRADE 1 *14Apr22* Note:	

599- Russell Gardens Ph-4.

FILE NAME:
RUSSELL GARDENS 599 PH4-APR 19 22

REV APR 19 22
PAULINE

REV APRIL 22 22
LEIGH
REV MAY 4 22 PB
REV MAY 16 22 PB

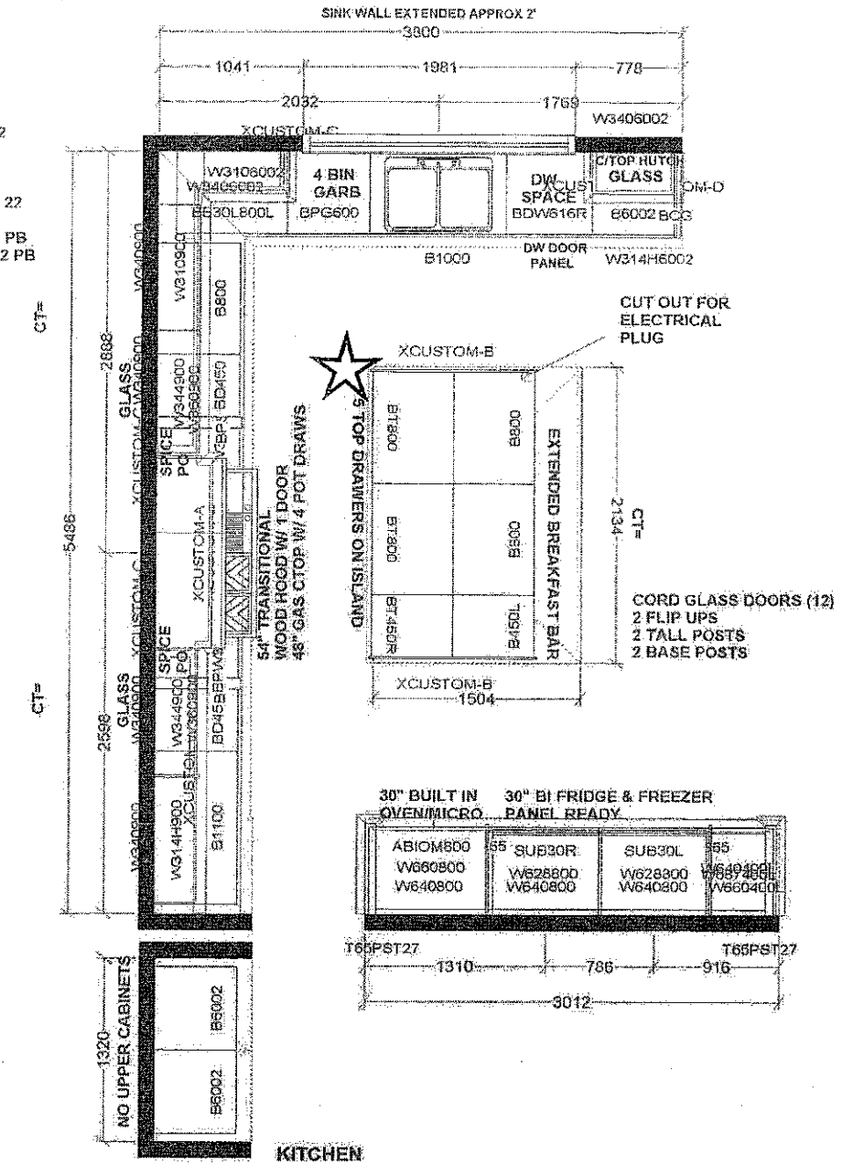

PROTOTYPE FOR EXTRAS

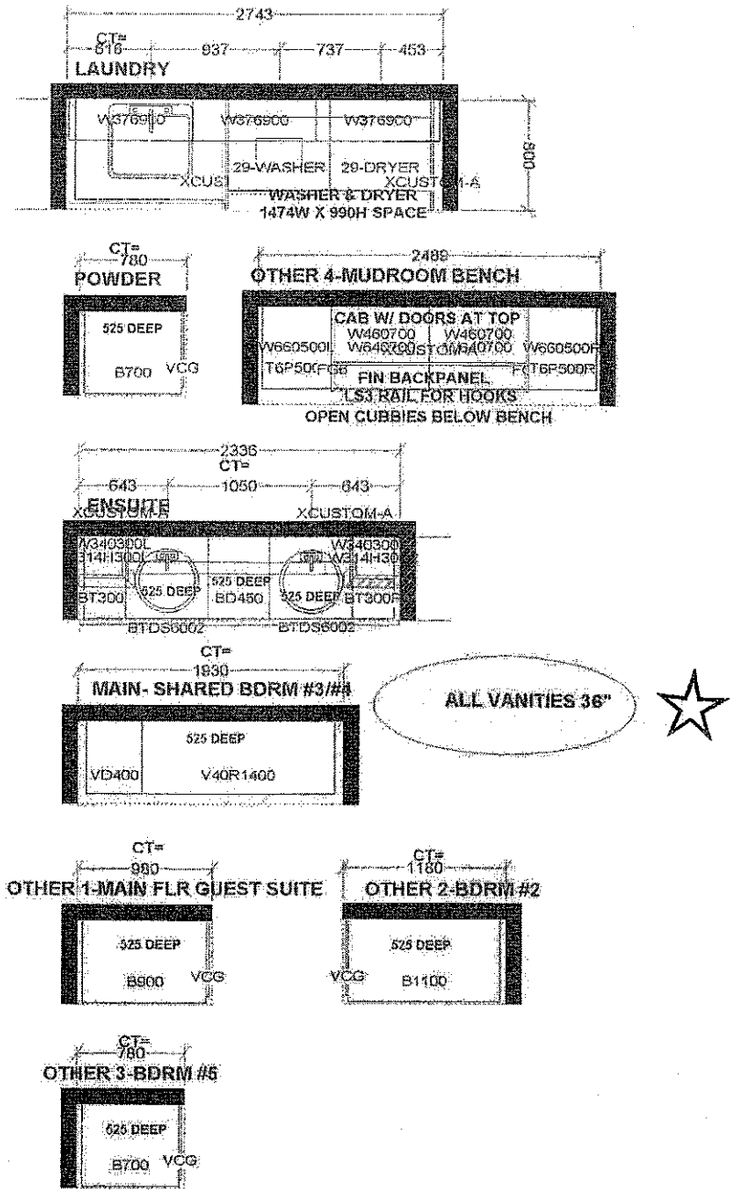

Selba Industries		J#
W WDTH_____ W HGHT_____ W CNT_____	This drawing is the intellectual property of SELBA INDUSTRIES INC. and is an original design which must not be released or copied unless applicable fee has been paid or job order placed.	JOB NUMBER:
FLOOR HGHT_____ DOOR HGHT_____	DESIGNER: LR	BUILDER: GREENPARK
BT CENT_____ 2X4_____ VENT BOX COVER	DATE: APR 28 21/rev'd sept 17 21	SITE: RUSSELL GARDENS PH.4 MODEL: GRANDVILLE 3X EL 1,2,3 LOT #:

599-Russell Gardens
Ph. 4.

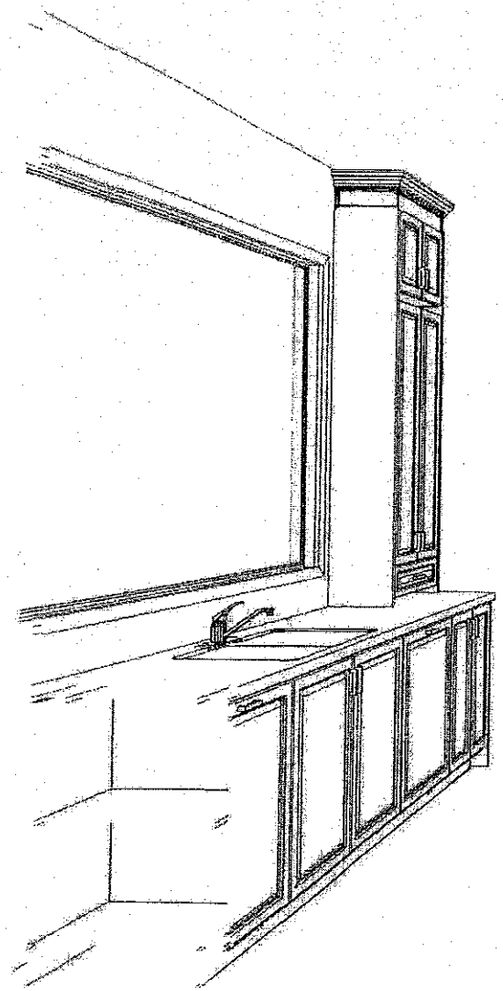

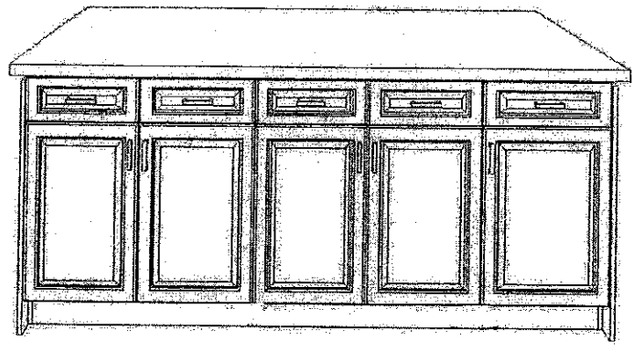

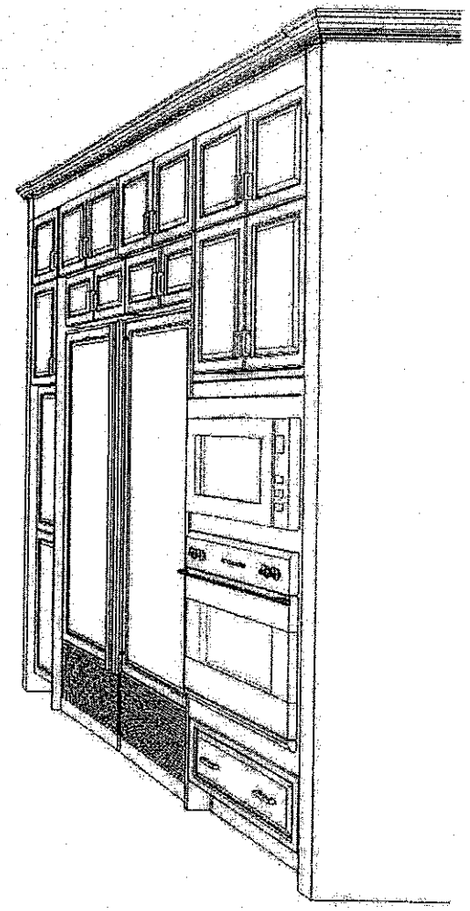

This drawing is the intellectual property of SELBA INDUSTRIES INC. and is an artistic interpretation of the general appearance of the design. It is not meant to be an exact rendition.

2020 TECHNOLOGIES

Designed: 5/4/2022
Printed: 5/16/2022

INSIDE ISLAND VIEW - Rev. MAY 16/22

RUSSELL GARDENS 599-APR 22 2022 | LAYOUT | Drawing #: 1

599-Russell Gardens Ph-4

Master Ensuite Bath Hutch.

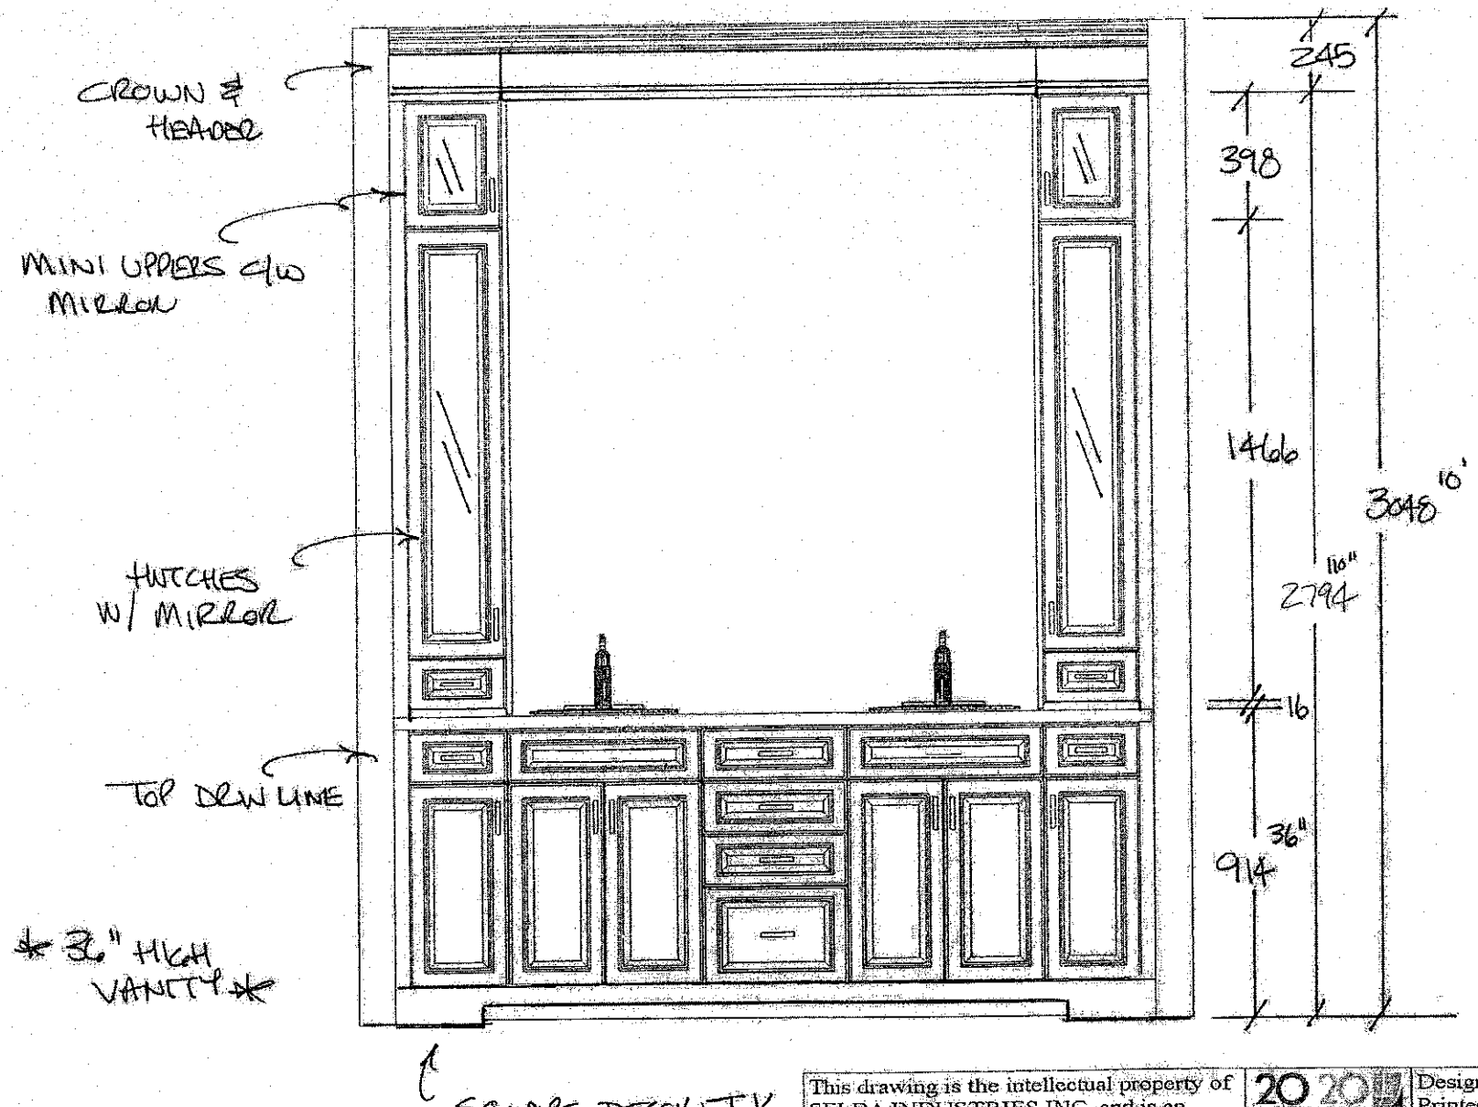

This drawing is the intellectual property of SELBA INDUSTRIES INC. and is an artistic interpretation of the general appearance of the design. It is not meant to be an exact rendition.

2020 TECHNOLOGIES

Designed: 5/4/2022
Printed: 5/16/2022

Rev MAY16/22

RUSSELL GARDENS 599-APR 22 2022 | LAYOUT | Drawing #: 1