

SITE NAME: ROUNDEL HOMES INC
BUILDER: GREENPARK HOMES

TYPE: TERRACOTA 1

DATE: May-21

GFA: 3287 LO# 90737

HEATING CFM 1122 COOLING CFM 1122
TOTAL HEAT LOSS 60,097 TOTAL HEAT GAIN 36,840
AIR FLOW RATE CFM 18.67 AIR FLOW RATE CFM 30.46

furnace pressure 0.6
furnace filter 0.05
a/c coil pressure 0.2
available pressure for s/a & r/a 0.35

#GOODMAN
GMEC960803BNA 80
FAN SPEED LOW
MEDLOW
MEDIUM 885
MEDIUM HIGH 1005
HIGH 1122
AFUE = 96 %
INPUT (BTU/H) = 80,000
OUTPUT (BTU/H) = 76,800
DESIGN CFM = 1122
CFM @ .6" E.S.P.
TEMPERATURE RISE 63 °F

RUN COUNT	4th	3rd	2nd	1st	Bas
S/A	0	0	13	7	4
R/A	0	0	5	2	1

All S/A diffusers 4"x10" unless noted otherwise on layout.

All S/A runs 5"Ø unless noted otherwise on layout.

RUN #	1	2	3	4	5	6	7	8	9	10	11	12	13	14	15	16	17	18	19	21	22	23	24
ROOM NAME	MBR	ENS	FLEX	BED-2	BED-3	BED-4	ENS-3	FLEX	BED-3	MBR	S-ENS	FAM	LV/DN	KIT	KIT	LIB	LAUN	W/R	FOY	BAS	BAS	BAS	BAS
RM LOSS MBH.	1.75	2.39	2.44	1.91	2.16	1.39	0.63	2.44	2.16	1.75	0.57	3.61	2.47	2.21	2.21	1.53	0.78	2.75	4.34	5.02	5.02	5.02	5.02
CFM PER RUN HEAT	33	45	45	36	40	26	12	45	40	33	11	67	46	41	41	29	15	51	81	94	94	94	94
RM GAIN MBH.	1.88	1.45	2.86	1.90	2.57	1.83	0.36	2.86	2.57	1.88	0.20	3.37	2.01	2.18	2.18	1.28	1.11	0.54	0.96	0.67	0.67	0.67	0.67
CFM PER RUN COOLING	57	44	87	58	78	56	11	87	78	57	6	103	61	66	66	39	34	16	29	20	20	20	20
ADJUSTED PRESSURE	0.17	0.17	0.16	0.17	0.17	0.17	0.17	0.16	0.17	0.17	0.17	0.16	0.17	0.17	0.17	0.17	0.17	0.17	0.16	0.16	0.16	0.16	0.16
ACTUAL DUCT LGH.	32	63	51	56	61	46	49	58	49	38	46	26	25	38	44	40	23	47	48	34	20	24	41
EQUIVALENT LENGTH	130	150	160	140	100	210	200	130	190	100	130	130	140	120	120	140	160	130	110	120	100	130	130
TOTAL EFFECTIVE LENGTH	162	213	211	196	161	256	249	188	239	138	176	156	165	158	164	180	183	177	158	154	120	154	171
ADJUSTED PRESSURE	0.11	0.08	0.08	0.09	0.11	0.07	0.07	0.09	0.07	0.12	0.1	0.1	0.1	0.11	0.1	0.1	0.09	0.1	0.1	0.11	0.14	0.11	0.09
ROUND DUCT SIZE	5	5	6	6	6	5	4	6	6	5	4	6	5	5	5	4	4	5	5	6	6	6	6
HEATING VELOCITY (ft/min)	242	330	229	184	204	191	138	229	204	242	126	342	338	301	301	333	172	374	595	479	479	479	479
COOLING VELOCITY (ft/min)	419	323	444	296	398	411	126	444	398	419	69	525	448	485	485	447	390	117	213	102	102	102	102
OUTLET GRILL SIZE	3X10	3X10	4X10	4X10	4X10	3X10	3X10	4X10	4X10	3X10	3X10	4X10	3X10	3X10	3X10	3X10	3X10	3X10	3X10	4X10	4X10	4X10	4X10
TRUNK	C	A	D	A	E	D	D	D	D	C	E	C	E	B	B	D	C	A	D	B	C	E	D

RUN #	25
ROOM NAME	S-ENS
RM LOSS MBH.	0.57
CFM PER RUN HEAT	11
RM GAIN MBH.	0.20
CFM PER RUN COOLING	6
ADJUSTED PRESSURE	0.17
ACTUAL DUCT LGH.	46
EQUIVALENT LENGTH	140
TOTAL EFFECTIVE LENGTH	186
ADJUSTED PRESSURE	0.09
ROUND DUCT SIZE	4
HEATING VELOCITY (ft/min)	126
COOLING VELOCITY (ft/min)	69
OUTLET GRILL SIZE	3X10
TRUNK	E

Richmond Hill City of Richmond Hill
Building Division
HVAC REVIEWED
Initials: **PXV**

SUPPLY AIR TRUNK SIZE

	TRUNK	STATIC	ROUND	RECT			VELOCITY		TRUNK	STATIC	ROUND	RECT		VELOCITY	
	CFM	PRESS.	DUCT	DUCT			(ft/min)		CFM	PRESS.	DUCT	DUCT		(ft/min)	
TRUNK A	132	0.08	6.6	8	x	8	297	TRUNK G	0	0.00	0	0	x	8	0
TRUNK B	176	0.10	6.9	8	x	8	396	TRUNK H	0	0.00	0	0	x	8	0
TRUNK C	550	0.08	11.2	14	x	8	707	TRUNK I	0	0.00	0	0	x	8	0
TRUNK D	372	0.07	10	12	x	8	558	TRUNK J	0	0.00	0	0	x	8	0
TRUNK E	574	0.07	11.8	16	x	8	646	TRUNK K	0	0.00	0	0	x	8	0
TRUNK F	0	0.00	0	0	x	8	0	TRUNK L	0	0.00	0	0	x	8	0

RETURN AIR TRUNK SIZE

	TRUNK CFM	STATIC PRESS.	ROUND DUCT	RECT DUCT		VELOCITY (ft/min)	
TRUNK O	0	0.05	0	0	x	8	0
TRUNK P	0	0.05	0	0	x	8	0
TRUNK Q	0	0.05	0	0	x	8	0
TRUNK R	0	0.05	0	0	x	8	0
TRUNK S	0	0.05	0	0	x	8	0
TRUNK T	0	0.05	0	0	x	8	0
TRUNK U	0	0.05	0	0	x	8	0
TRUNK V	0	0.05	0	0	x	8	0
TRUNK W	0	0.05	0	0	x	8	0
TRUNK X	867	0.05	15	26	x	8	600
TRUNK Y	535	0.05	12.5	18	x	8	535
TRUNK Z	0	0.05	0	0	x	8	0
DROP	1122	0.05	16.5	24	x	10	673

RETURN AIR #	1	2	3	4	5	6	7	8	9	10	11	12	13	14	15	16	17	18	19	20	21	22	23	24	25
AIR VOLUME	85	95	95	85	75	360	175	0	0	0	0	0	0	0	0	0	0	0	0	0	0	0	0	0	152
PLENUM PRESSURE	0.15	0.15	0.15	0.15	0.15	0.15	0.15	0.15	0.15	0.15	0.15	0.15	0.15	0.15	0.15	0.15	0.15	0.15	0.15	0.15	0.15	0.15	0.15	0.15	0.15
ACTUAL DUCT LGH.	51	42	51	53	63	26	26	1	1	1	1	1	1	1	1	1	1	1	1	1	1	1	1	1	15
EQUIVALENT LENGTH	205	165	155	205	210	185	190	0	0	0	0	0	0	0	0	0	0	0	0	0	0	0	0	0	185
TOTAL EFFECTIVE LN	256	207	206	258	273	211	216	1	1	1	1	1	1	1	1	1	1	1	1	1	1	1	1	1	200
ADJUSTED PRESSURE	0.06	0.07	0.07	0.06	0.05	0.07	0.07	14.80	14.80	14.80	14.80	14.80	14.80	14.80	14.80	14.80	14.80	14.80	14.80	14.80	14.80	14.80	14.80	14.80	0.07
ROUND DUCT SIZE	6	6	6	6	6	9.9	7.5	0	0	0	0	0	0	0	0	0	0	0	0	0	0	0	0	0	7.2
INLET GRILL SIZE	8	8	8	8	8	8	8	0	0	0	0	0	0	0	0	0	0	0	0	0	0	0	0	0	8
INLET GRILL SIZE	X	X	X	X	X	X	X	X	X	X	X	X	X	X	X	X	X	X	X	X	X	X	X	X	X
INLET GRILL SIZE	14	14	14	14	14	30	14	0	0	0	0	0	0	0	0	0	0	0	0	0	0	0	0	0	14

TYPE: TERRACOTA 1
SITE NAME: ROUNDEL HOMES INC

LO # 90737

RESIDENTIAL MECHANICAL VENTILATION DESIGN SUMMARY

COMBUSTION APPLIANCES		9.32.3.1(1)
a)	<input checked="" type="checkbox"/> Direct vent (sealed combustion) only	
b)	<input type="checkbox"/> Positive venting induced draft (except fireplaces)	
c)	<input type="checkbox"/> Natural draft, B-vent or induced draft gas fireplace	
d)	<input type="checkbox"/> Solid Fuel (including fireplaces)	
e)	<input type="checkbox"/> No Combustion Appliances	

HEATING SYSTEM	
<input checked="" type="checkbox"/> Forced Air	<input type="checkbox"/> Non Forced Air
<input type="checkbox"/> Electric Space Heat	

HOUSE TYPE		9.32.1(2)
<input checked="" type="checkbox"/> I	Type a) or b) appliance only, no solid fuel	
<input type="checkbox"/> II	Type I except with solid fuel (including fireplaces)	
<input type="checkbox"/> III	Any Type c) appliance	
<input type="checkbox"/> IV	Type I, or II with electric space heat	
<input type="checkbox"/>	Other: Type I, II or IV no forced air	

SYSTEM DESIGN OPTIONS		O.N.H.W.P.
<input type="checkbox"/> 1	Exhaust only/Forced Air System	
<input type="checkbox"/> 2	HRV with Ducting/Forced Air System	
<input checked="" type="checkbox"/> 3	HRV Simplified/connected to forced air system	
<input type="checkbox"/> 4	HRV with Ducting/non forced air system	
<input type="checkbox"/>	Part 6 Design	

TOTAL VENTILATION CAPACITY		9.32.3.3(1)
Basement + Master Bedroom	2 @ 21.2 cfm	42.4 cfm
Other Bedrooms	3 @ 10.6 cfm	31.8 cfm
Kitchen & Bathrooms	5 @ 10.6 cfm	53 cfm
Other Rooms	8 @ 10.6 cfm	84.8 cfm
Table 9.32.3.A. TOTAL		212.0 cfm

PRINCIPAL VENTILATION CAPACITY REQUIRED		9.32.3.4.(1)
1 Bedroom	31.8	cfm
2 Bedroom	47.7	cfm
3 Bedroom	63.6	cfm
4 Bedroom	79.5	cfm
5 Bedroom	95.4	cfm
TOTAL		79.5 cfm

SUPPLEMENTAL VENTILATION CAPACITY		9.32.3.5.
Total Ventilation Capacity	212	cfm
Less Principal Ventil. Capacity	79.5	cfm
Required Supplemental Capacity	132.5	cfm

PRINCIPAL EXHAUST FAN CAPACITY	
Model:	VANEE V150H
Location:	BSMT
79.5 cfm	3.0 sones
<input checked="" type="checkbox"/> HVI Approved	

PRINCIPAL EXHAUST HEAT LOSS CALCULATION	
CFM	$\Delta T \cdot F$
79.5 CFM	X 78 F
FACTOR	% LOSS
1.08	X 0.25

SUPPLEMENTAL FANS		PANASONIC
Location	Model	cfm HVI Sones
ENS	FV-05-11VK1	50 ✓ 0.3
ENS-3	FV-05-11VK1	50 ✓ 0.3
S-ENS	FV-05-11VK1	50 ✓ 0.3
W/R	FV-05-11VK1	50 ✓ 0.3

HEAT RECOVERY VENTILATOR		9.32.3.11.
Model:	VANEE V150H	
150 cfm high	35 cfm low	
75 % Sensible Efficiency	<input checked="" type="checkbox"/> HVI Approved	
@ 32 deg F (0 deg C)		

LOCATION OF INSTALLATION	
Lot:	Concession
Township	Plan:
Address	
Roll #	Building Permit #

BUILDER:	
GREENPARK HOMES	
Name:	City of Richmond Hill
Address:	Building Division
City:	
Telephone #:	
Initials:	PXV

INSTALLING CONTRACTOR	
Name:	
Address:	
City:	
Telephone #:	Fax #:


DESIGNER CERTIFICATION	
I hereby certify that this ventilation system has been designed in accordance with the Ontario Building Code.	
Name:	HVAC Designs Ltd.
Signature:	<i>Michael O'Rourke</i>
HRAI #	001820
Date:	May-21

I REVIEW AND TAKE RESPONSIBILITY FOR THE DESIGN WORK AND AM QUALIFIED IN THE APPROPRIATE CATEGORY AS AN "OTHER DESIGNER" UNDER DIVISION C.3.2.5 OF THE BUILDING CODE.
INDIVIDUAL BCIN: 19669 *Michael O'Rourke* MICHAEL O'ROURKE

RECEIVED
Per: joshua.nabua

09/22/2022

CSA F280-12 Residential Heat Loss and Heat Gain Calculations	
Formula Sheet (For Air Leakage / Ventilation Calculation)	
LO#: 90737		Model: TERRACOTA 1		Builder: GREENPARK HOMES	
Date: 2021-05-10	
Volume Calculation			Air Change & Delta T Data	
House Volume <table border="1" style="width:100%; border-collapse: collapse;"> <thead> <tr> <th>Level</th> <th>Floor Area (ft²)</th> <th>Floor Height (ft)</th> <th>Volume (ft³)</th> </tr> </thead> <tbody> <tr><td>Bsmt</td><td>1447</td><td>8</td><td>11576</td></tr> <tr><td>First</td><td>1447</td><td>10</td><td>14470</td></tr> <tr><td>Second</td><td>1840</td><td>9</td><td>16560</td></tr> <tr><td>Third</td><td>0</td><td>9</td><td>0</td></tr> <tr><td>Fourth</td><td>0</td><td>9</td><td>0</td></tr> <tr><td colspan="3" style="text-align: right;">Total:</td><td>42,606.0 ft³</td></tr> <tr><td colspan="3" style="text-align: right;">Total:</td><td>1206.5 m³</td></tr> </tbody> </table>			Level	Floor Area (ft²)	Floor Height (ft)	Volume (ft³)	Bsmt	1447	8	11576	First	1447	10	14470	Second	1840	9	16560	Third	0	9	0	Fourth	0	9	0	Total:			42,606.0 ft³	Total:			1206.5 m³	<table border="1" style="width:100%; border-collapse: collapse;"> <tr> <td style="width: 80%;">WINTER NATURAL AIR CHANGE RATE</td> <td style="width: 20%;">0.352</td> </tr> <tr> <td>SUMMER NATURAL AIR CHANGE RATE</td> <td>0.110</td> </tr> </table> <table border="1" style="width:100%; border-collapse: collapse;"> <tr> <th colspan="5" style="text-align: center;">Design Temperature Difference</th> </tr> <tr> <th></th> <th>Tin °C</th> <th>Tout °C</th> <th>ΔT °C</th> <th>ΔT °F</th> </tr> <tr> <td>Winter DTDh</td> <td>22</td> <td>-21</td> <td>43</td> <td>78</td> </tr> <tr> <td>Summer DTDc</td> <td>24</td> <td>31</td> <td>7</td> <td>13</td> </tr> </table>		WINTER NATURAL AIR CHANGE RATE	0.352	SUMMER NATURAL AIR CHANGE RATE	0.110	Design Temperature Difference						Tin °C	Tout °C	ΔT °C	ΔT °F	Winter DTDh	22	-21	43	78	Summer DTDc	24	31	7	13
Level	Floor Area (ft²)	Floor Height (ft)	Volume (ft³)	
Bsmt	1447	8	11576	
First	1447	10	14470	
Second	1840	9	16560	
Third	0	9	0	
Fourth	0	9	0	
Total:			42,606.0 ft³	
Total:			1206.5 m³	
WINTER NATURAL AIR CHANGE RATE	0.352	
SUMMER NATURAL AIR CHANGE RATE	0.110	
Design Temperature Difference	
	Tin °C	Tout °C	ΔT °C	ΔT °F	
Winter DTDh	22	-21	43	78	
Summer DTDc	24	31	7	13	
5.2.3.1 Heat Loss due to Air Leakage			6.2.6 Sensible Gain due to Air Leakage	
$HL_{airb} = LR_{airh} \times \frac{V_b}{3.6} \times DTD_h \times 1.2$ <p>0.352 x 335.13 x 43 °C x 1.2 = 6116 W</p> <p>= 20868 Btu/h</p>			$HG_{satb} = LR_{airc} \times \frac{V_b}{3.6} \times DTD_c \times 1.2$ <p>= 0.110 x 335.13 x 7 °C x 1.2 = 314 W</p> <p>= 1071 Btu/h</p>	
5.2.3.2 Heat Loss due to Mechanical Ventilation			6.2.7 Sensible heat Gain due to Ventilation	
$HL_{vairb} = PVC \times DTD_h \times 1.08 \times (1 - E)$ <p>80 CFM x 78 °F x 1.08 x 0.25 = 1670 Btu/h</p>			$HL_{vairb} = PVC \times DTD_h \times 1.08 \times (1 - E)$ <p>80 CFM x 13 °F x 1.08 x 0.25 = 275 Btu/h</p>	
5.2.3.3 Calculation of Air Change Heat Loss for Each Room (Floor Multiplier Section)	
$HL_{airr} = Level\ Factor \times HL_{airbv} \times \{(HL_{agcr} + HL_{bgcr}) \div (HL_{agclevel} + HL_{bgclevel})\}$ <table border="1" style="width:100%; border-collapse: collapse;"> <thead> <tr> <th>Level</th> <th>Level Factor (LF)</th> <th>HLairve Air Leakage + Ventilation Heat Loss (Btu/h)</th> <th>Level Conductive Heat Loss: (HL_{clevel})</th> <th>Air Leakage Heat Loss Multiplier (LF x HLairbv / HLlevel)</th> </tr> </thead> <tbody> <tr><td>1</td><td>0.5</td><td rowspan="5" style="text-align: center; vertical-align: middle;">20,868</td><td>9,627</td><td>1.084</td></tr> <tr><td>2</td><td>0.3</td><td>12,869</td><td>0.486</td></tr> <tr><td>3</td><td>0.2</td><td>15,623</td><td>0.267</td></tr> <tr><td>4</td><td>0</td><td>0</td><td>0.000</td></tr> <tr><td>5</td><td>0</td><td>0</td><td>0.000</td></tr> </tbody> </table> <p>*HLairbv = Air leakage heat loss + ventilation heat loss *For a balanced or supply only ventilation system HLairve = 0</p>					Level	Level Factor (LF)	HLairve Air Leakage + Ventilation Heat Loss (Btu/h)	Level Conductive Heat Loss: (HL _{clevel})	Air Leakage Heat Loss Multiplier (LF x HLairbv / HLlevel)	1	0.5	20,868	9,627	1.084	2	0.3	12,869	0.486	3	0.2	15,623	0.267	4	0	0	0.000	5	0	0	0.000																														
Level	Level Factor (LF)	HLairve Air Leakage + Ventilation Heat Loss (Btu/h)	Level Conductive Heat Loss: (HL _{clevel})	Air Leakage Heat Loss Multiplier (LF x HLairbv / HLlevel)	
1	0.5	20,868	9,627	1.084	
2	0.3		12,869	0.486	
3	0.2		15,623	0.267	
4	0		0	0.000	
5	0		0	0.000	

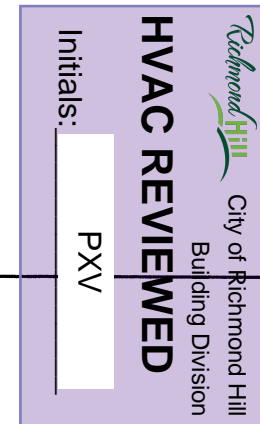

RECEIVED
09/22/2022
CITY OF RICHMOND HILL
BUILDING DIVISION

Per: joshua.nabua

HEAT LOSS AND GAIN SUMMARY SHEET

MODEL: TERRACOTA 1

BUILDER: GREENPARK HOMES

SFQT: 3287

LO# 90737

SITE: ROUNDEL HOMES INC

DESIGN ASSUMPTIONS

HEATING	°F	COOLING	°F
OUTDOOR DESIGN TEMP.	-6	OUTDOOR DESIGN TEMP.	88
INDOOR DESIGN TEMP.	72	INDOOR DESIGN TEMP. (MAX 75°F)	75

BUILDING DATA

ATTACHMENT:	DETACHED	# OF STORIES (+BASEMENT):	3
FRONT FACES:	EAST	ASSUMED (Y/N):	Y
AIR CHANGES PER HOUR:	3.57	ASSUMED (Y/N):	Y
AIR TIGHTNESS CATEGORY:	AVERAGE	ASSUMED (Y/N):	Y
WIND EXPOSURE:	SHELTERED	ASSUMED (Y/N):	Y
HOUSE VOLUME (ft³):	42606.0	ASSUMED (Y/N):	Y
INTERNAL SHADING:	BLINDS/CURTAINS	ASSUMED OCCUPANTS:	5
INTERIOR LIGHTING LOAD (Btu/h/ft²):	1.27	DC BRUSHLESS MOTOR (Y/N):	Y
FOUNDATION CONFIGURATION	BCIN_1	DEPTH BELOW GRADE:	5.0 ft
LENGTH: 52.0 ft	WIDTH: 37.0 ft	EXPOSED PERIMETER:	178.0 ft

2012 OBC - COMPLIANCE PACKAGE

Component

Compliance Package A1

Nominal Min. Eff.

Ceiling with Attic Space Minimum RSI (R)-Value	60	59.22
Ceiling Without Attic Space Minimum RSI (R)-Value	31	27.65
Exposed Floor Minimum RSI (R)-Value	31	29.80
Walls Above Grade Minimum RSI (R)-Value	22	17.03
Basement Walls Minimum RSI (R)-Value	20 ci	21.12
Below Grade Slab Entire surface > 600 mm below grade Minimum RSI (R)-Value	-	-
Edge of Below Grade Slab ≤ 600 mm Below Grade Minimum RSI (R)-Value	10	10
Heated Slab or Slab ≤ 600 mm below grade Minimum RSI (R)-Value	10	11.13
Windows and Sliding Glass Doors Maximum U-Value	0.28	-
Skylights Maximum U-Value	0.49	-
Space Heating Equipment Minimum AFUE	0.96	-
HRV Minimum Efficiency	75%	-
Domestic Hot Water Heater Minimum EF	0.8	-

INDIVIDUAL BCIN: 19669

MICHAEL O'ROURKE

 09/22/2022


CITY OF RICHMOND HILL
BUILDING DIVISION

RECEIVED

Per: joshua.nabua

Residential Foundation Thermal Load Calculator

Supplemental tool for CAN/CSA-F280

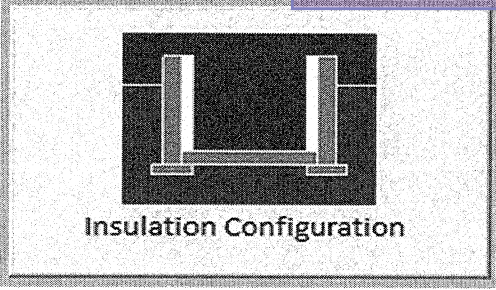Weather Station Description		
Province:	Ontario	
Region:	Richmond Hill	
Site Description		
Soil Conductivity:	Normal conductivity: dry sand, loam, clay	
Water Table:	Normal (7-10 m, 23-33 ft)	
Foundation Dimensions		
Floor Length (m):	15.8	 Insulation Configuration
Floor Width (m):	11.3	
Exposed Perimeter (m):	0.0	
Wall Height (m):	2.4	
Depth Below Grade (m):	1.52	
Window Area (m ²):	2.6	
Door Area (m ²):	1.9	
Radiant Slab		
Heated Fraction of the Slab:	0	6068 btu/hr
Fluid Temperature (°C):	33	
Design Months		
Heating Month	1	
Foundation Loads		
Heating Load (Watts):	1778	

TYPE: TERRACOTA 1
LO# 90737CITY OF RICHMOND HILL
BUILDING DIVISION

09/22/2022


RECEIVED

Per: joshua.nabua

Air Infiltration Residential Load Calculator

Supplemental tool for CAN/CSA-F280

Weather Station Description				
Province:	Ontario			
Region:	Richmond Hill			
Weather Station Location:	Open flat terrain, grass			
Anemometer height (m):	10			
Local Shielding				
Building Site:	Suburban, forest			
Walls:	Heavy			
Flue:	Heavy			
Highest Ceiling Height (m):	7.62			
Building Configuration				
Type:	Detached			
Number of Stories:	Two			
Foundation:	Full			
House Volume (m ³):	1206.5			
Air Leakage/Ventilation				
Air Tightness Type:	Present (1961-) (3.57 ACH)			
Custom BDT Data:	ELA @ 10 Pa.		1608.3 cm ²	
	3.57		ACH @ 50 Pa	
Mechanical Ventilation (L/s):	Total Supply	Total Exhaust		
	37.5	37.5		
Flue Size				
Flue #:	#1	#2	#3	#4
Diameter (mm):	0	0	0	0
Natural Infiltration Rates				
Heating Air Leakage Rate (ACH/H):	0.352			
Cooling Air Leakage Rate (ACH/H):	0.110			

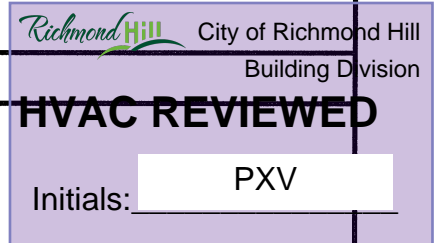
TYPE: TERRACOTA 1
LO# 90737CITY OF RICHMOND HILL
BUILDING DIVISION

09/22/2022

RECEIVED

Per: joshua.nabua

- 1.Laundry dryer exhaust duct shall be provided as per OBC 2012 Div.B 6.2.3.8(7).
- 2.Kitchen hood exhaust duct shall be provided as per OBC 2012, Div.B 9.32.3.10, 9.32.3.5(2).
- 3.Minimum R-12 Insulation Value required for ducts installed at unheated or exposed condition (OBC 2012 Div.B 6.2.4.3(10) and seal the ducts as per 6.2.4.3(11) & HRAI Digest 2005, Clause 4.5.
- 4.Penetration of Air Barrier System by ducts, wires, conduits or building materials shall be sealed as per OBC 2012, Div.B 9.25.3.3.(9) & (10).
- 5.Volume control dampers to all branches to be installed per OBC 2012, Div.B, 6.2.4.5.
- 6.Space between studs and joists used as return ducts shall be separated from unused portion as per OBC 2012 Div.B 6.2.4.7(6)

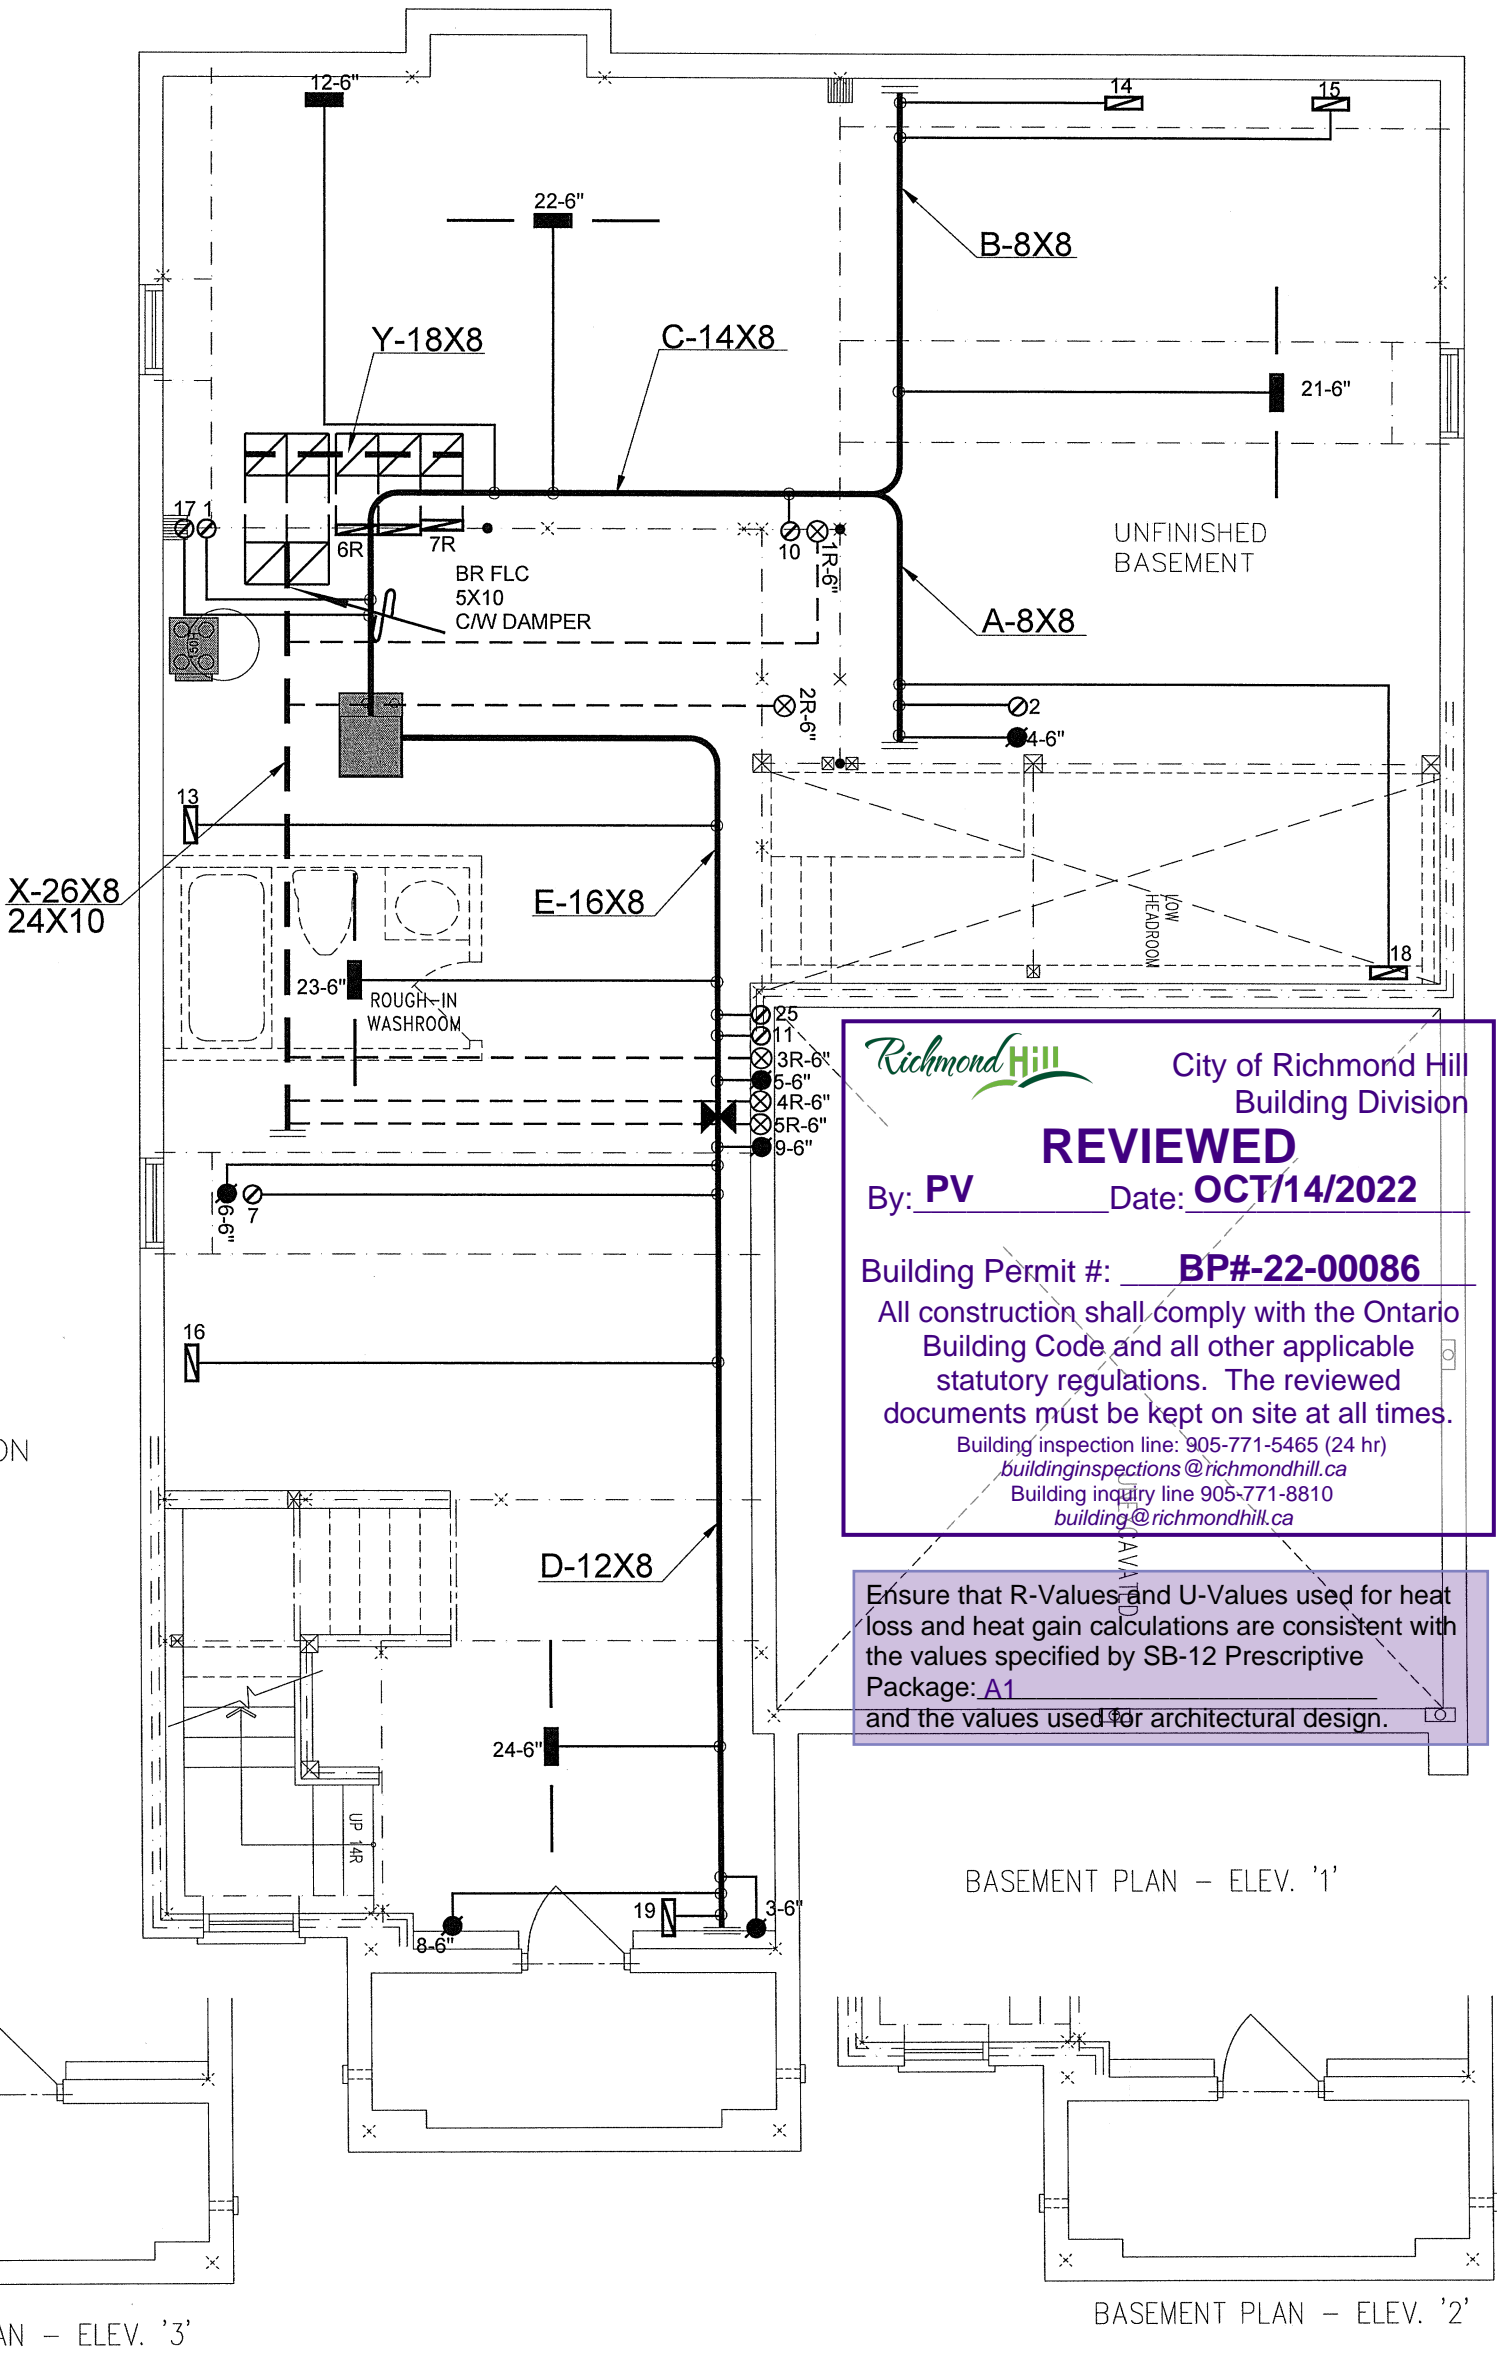

City of Richmond Hill
Building Division

REVIEWED

By: **PV** Date: **OCT/14/2022**

Building Permit #: **BP#-22-00086**

All construction shall comply with the Ontario Building Code and all other applicable statutory regulations. The reviewed documents must be kept on site at all times.

Building inspection line: 905-771-5465 (24 hr)
buildinginspections@richmondhill.ca
Building inquiry line 905-771-8810
building@richmondhill.ca

Ensure that R-Values and U-Values used for heat loss and heat gain calculations are consistent with the values specified by SB-12 Prescriptive Package: **A1** and the values used for architectural design.

I MICHAEL O'ROURKE HAVE REVIEW AND TAKE RESPONSIBILITY FOR THE DESIGN WORK AND AM QUALIFIED UNDER DIVISION C.3.2.5 OF THE BUILDING CODE.

Michael O'Rourke, BCIN# 19669
HVAC DESIGNS LTD.

HVAC LEGEND							3.		
SYMBOL	DESCRIPTION	SYMBOL	DESCRIPTION	SYMBOL	DESCRIPTION	SYMBOL	DESCRIPTION	2.	
	SUPPLY AIR GRILLE		6" SUPPLY AIR BOOT ABOVE		14"x8" RETURN AIR GRILLE		RETURN AIR STACK ABOVE	1.	
	SUPPLY AIR GRILLE 6" BOOT		SUPPLY AIR STACK FROM 2nd FLOOR		30"x8" RETURN AIR GRILLE		RETURN AIR STACK 2nd FLOOR	No.	Description Date
	SUPPLY AIR BOOT ABOVE		6" SUPPLY AIR STACK 2nd FLOOR		FRA- FLOOR RETURN AIR GRILLE		REDUCER	REVISIONS	

ALL DRAWINGS, CALCULATIONS AND SPECIFICATIONS ARE THE PROPERTY OF HVAC DESIGNS LTD.© AND MAY NOT BE REPRODUCED, MODIFIED OR ALTERED WITHOUT EXPRESSED WRITTEN CONSENT. THE DRAWINGS ARE DATED AND USE OF THESE DRAWINGS AFTER ONE YEAR FROM THE DATED NOTED IS NOT AUTHORIZED. CONTRACTOR SHALL CHECK ALL CONDITIONS BEFORE PROCEEDING WITH WORK. LATEST MUNICIPAL APPROVED DRAWINGS ONLY TO BE USED DURING INSTALLATION OF HEATING SYSTEM. HVAC DESIGNS LTD. IS NOT LIABLE FOR ANY CLAIMS ARISING FROM UNAUTHORIZED USE OF THE DRAWINGS OR FROM ANY CHANGES TO ACCEPTED STANDARDS AND/OR THE ONTARIO BUILDING CODE.

Client

GREENPARK HOMES

Project Name

ROUNDEL HOMES INC
RICHMOND HILL, ONTARIO

TERRACOTA 1

3287 sqft

375 Finley Ave. Suite 202 - Ajax, Ontario
L1S 2E2 Tel. 905.619.2300 - 905.420.5300 Fax 905.619.2375
Email: info@hvacdesigns.ca
Web: www.hvacdesigns.ca
Specializing in Residential Mechanical Design Services

Installation to comply with the latest Ontario Building Code. All supply branch outlets shall be equipped with a manual balancing damper. Ductwork which passes through the garage or unheated spaces shall be adequately insulated and be gas-proofed.

HEAT LOSS 61767 BTU/H
UNIT DATA

MAKE GOODMAN

MODEL GMEC960803BNA

INPUT 80 MBTU/H

OUTPUT 76.8 MBTU/H

COOLING 3.0 TONS

FAN SPEED 1122 cfm @ 0.6" w.c.

OF RUNS S/A R/A FANS

3RD FLOOR

2ND FLOOR 13 5 3

1ST FLOOR 7 2 2

BASEMENT 4 1 0

ALL S/A DIFFUSERS 4"x10" UNLESS NOTED OTHERWISE ON LAYOUT. ALL S/A RUNS 5" UNLESS NOTED OTHERWISE ON LAYOUT. UNDERCUT DOORS 1" min. FOR R/A

Sheet Title

BASEMENT HEATING LAYOUT

CITY OF RICHMOND HILL BUILDING DIVISION


Date MAY/2021

Scale 3/16" = 1'-0"

BCIN# 19669

LO# 90737

Per: joshua.nabua

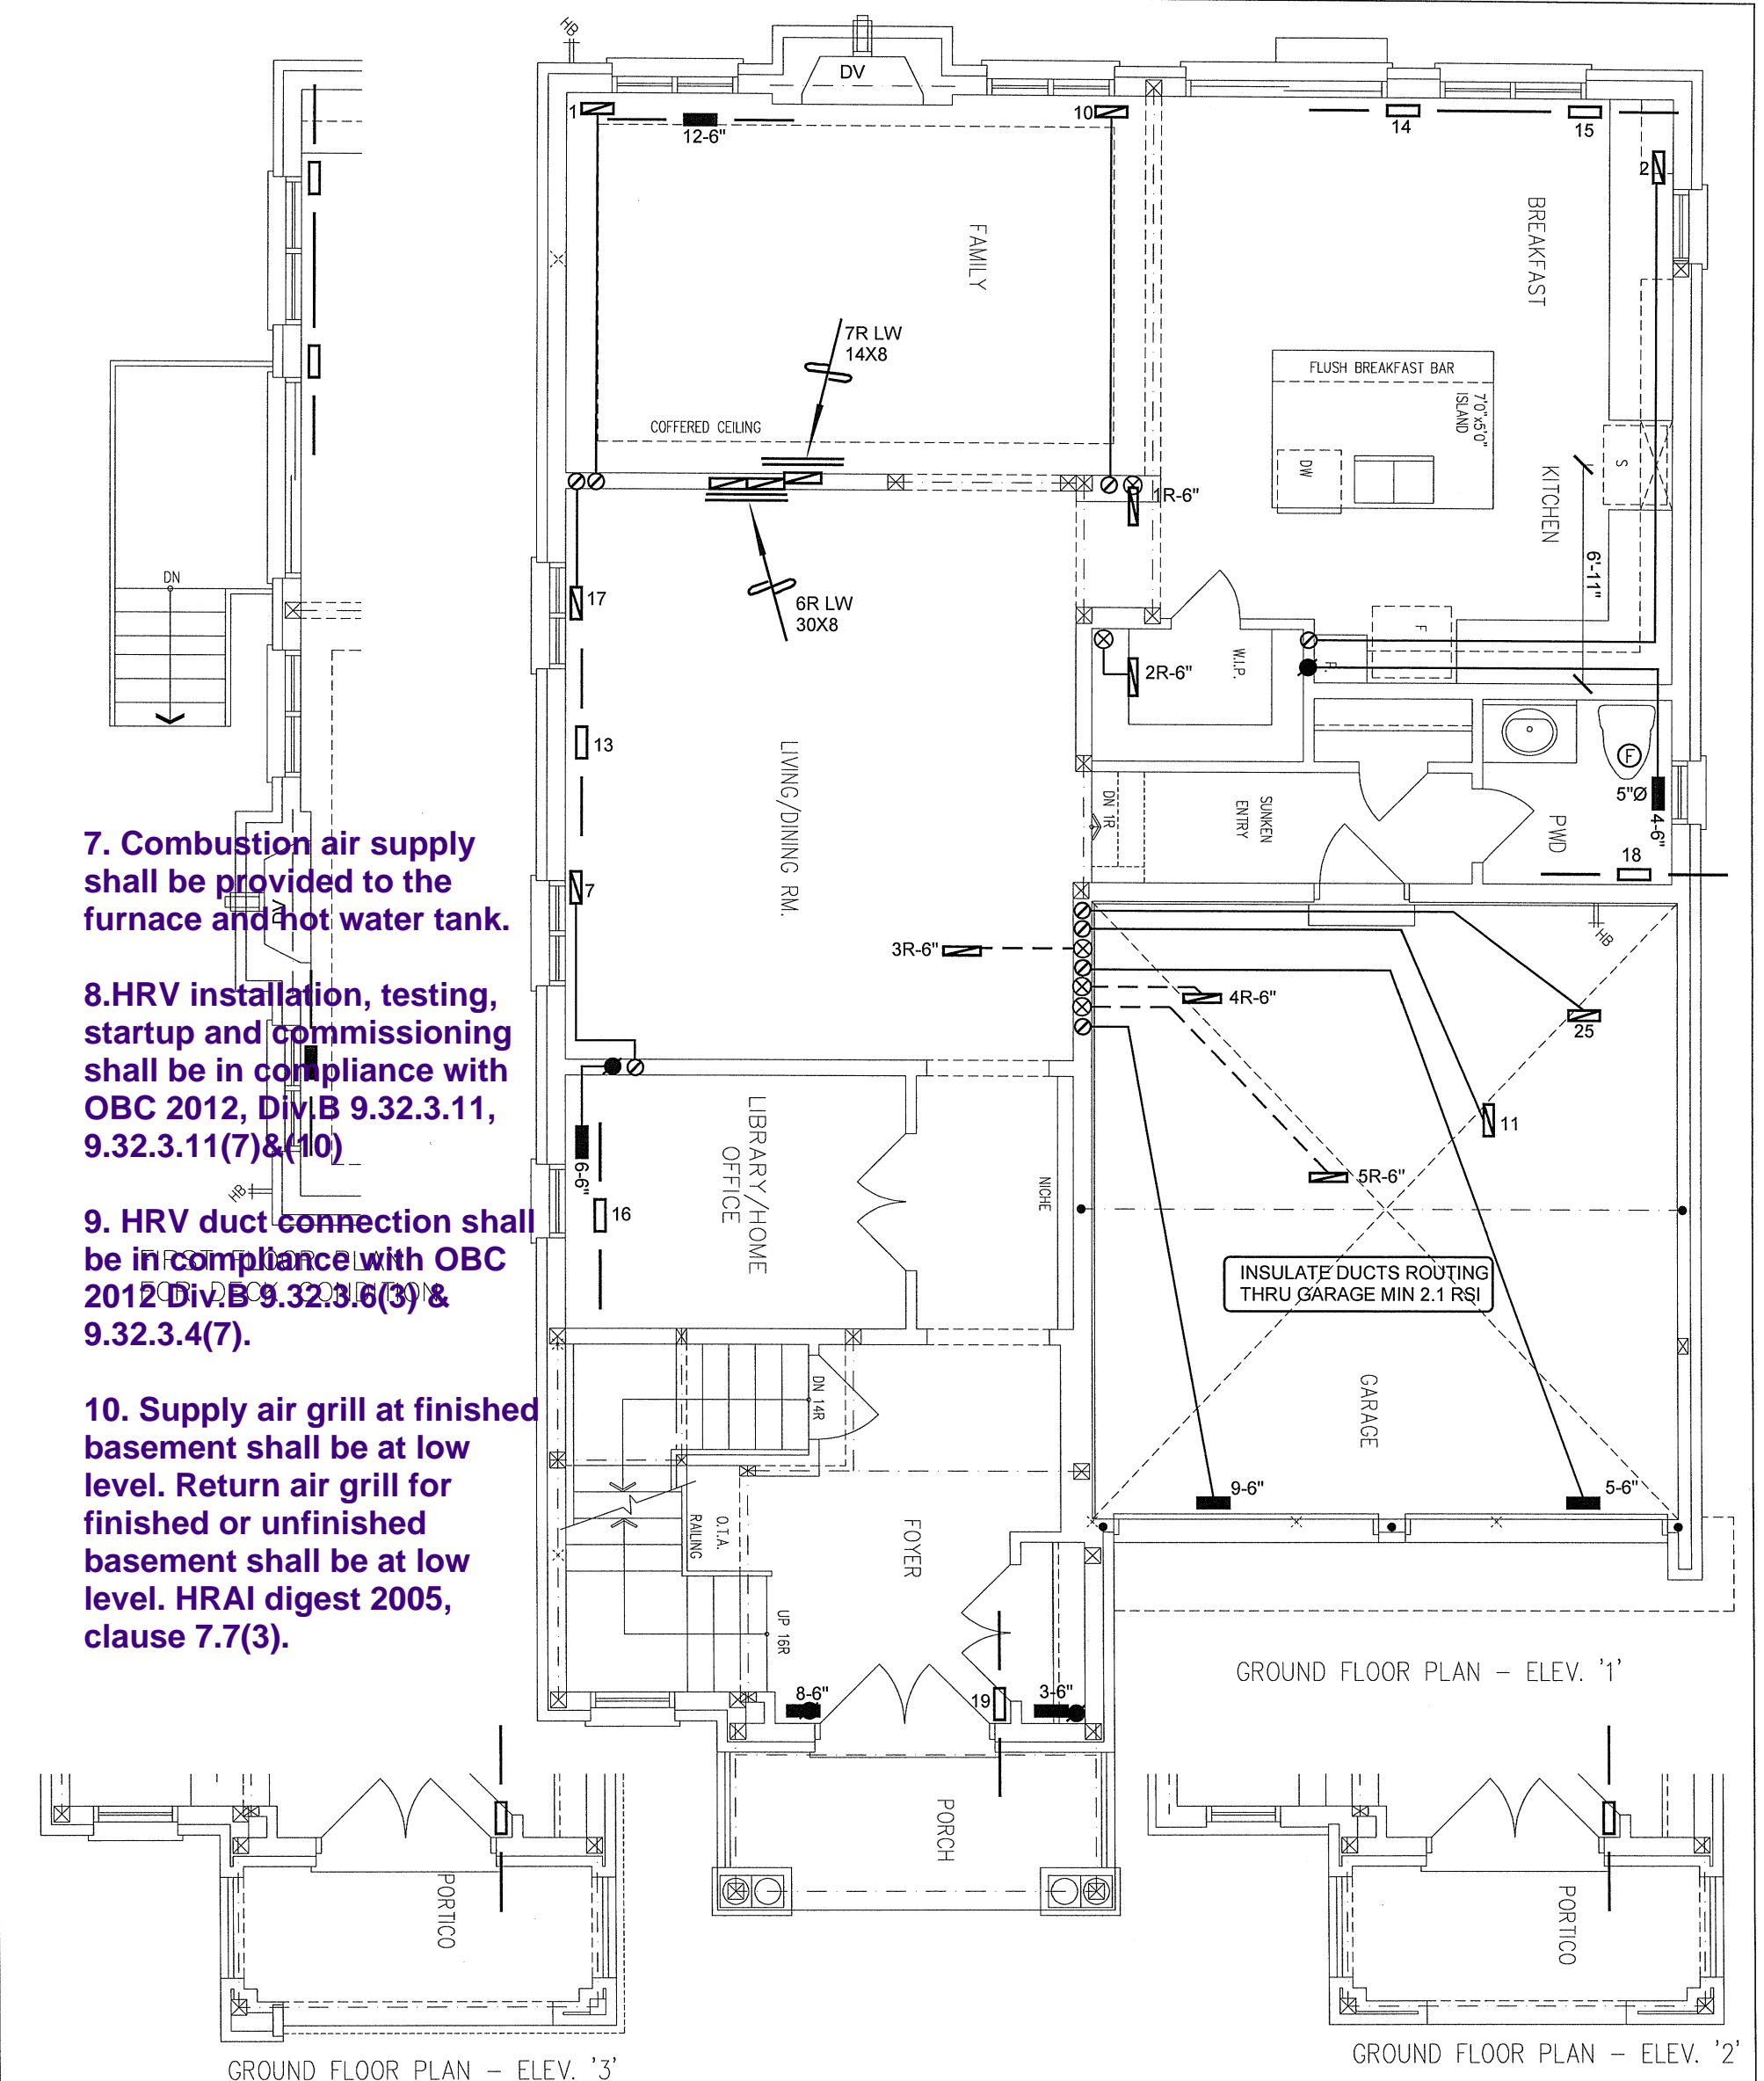

7. Combustion air supply shall be provided to the furnace and hot water tank.

8.HRV installation, testing, startup and commissioning shall be in compliance with OBC 2012, Div.B 9.32.3.11, 9.32.3.11(7)&(10)

9. HRV duct connection shall be in compliance with OBC 2012 Div.B 9.32.3.6(3) & 9.32.3.4(7).

10. Supply air grill at finished basement shall be at low level. Return air grill for finished or unfinished basement shall be at low level. HRAI digest 2005, clause 7.7(3).

I MICHAEL O'ROURKE HAVE REVIEW AND TAKE RESPONSIBILITY FOR THE DESIGN WORK AND AM QUALIFIED UNDER DIVISION C, 3.2.3 OF THE BUILDING CODE.
Michael O'Rourke
Michael O'Rourke, BCIN# 19669
HVAC DESIGNS LTD.

CSA-F280-12
PACKAGE A1

HVAC LEGEND							3.		
SYMBOL	DESCRIPTION	SYMBOL	DESCRIPTION	SYMBOL	DESCRIPTION	SYMBOL	DESCRIPTION	2.	
	SUPPLY AIR GRILLE		6" SUPPLY AIR BOOT ABOVE		14"x8" RETURN AIR GRILLE		RETURN AIR STACK ABOVE	1.	
	SUPPLY AIR GRILLE 6" BOOT		SUPPLY AIR STACK FROM 2nd FLOOR		30"x8" RETURN AIR GRILLE		RETURN AIR STACK 2nd FLOOR	No.	Description Date
	SUPPLY AIR BOOT ABOVE		6" SUPPLY AIR STACK 2nd FLOOR		FRA- FLOOR RETURN AIR GRILLE		REDUCER	REVISIONS	


ALL DRAWINGS, CALCULATIONS AND SPECIFICATIONS ARE THE PROPERTY OF HVAC DESIGNS LTD.© AND MAY NOT BE REPRODUCED, MODIFIED OR ALTERED WITHOUT EXPRESSED WRITTEN CONSENT. THE DRAWINGS ARE DATED AND USE OF THESE DRAWINGS AFTER ONE YEAR FROM THE DATED NOTED IS NOT AUTHORIZED. CONTRACTOR SHALL CHECK ALL CONDITIONS BEFORE PROCEEDING WITH WORK. LATEST MUNICIPAL APPROVED DRAWINGS ONLY TO BE USED DURING INSTALLATION OF HEATING SYSTEM. HVAC DESIGNS LTD. IS NOT LIABLE FOR ANY CLAIMS ARISING FROM UNAUTHORIZED USE OF THE DRAWINGS OR FROM ANY CHANGES TO ACCEPTED STANDARDS AND/OR THE ONTARIO BUILDING CODE.

Client GREENPARK HOMES	 375 Finley Ave. Suite 202 - Ajax, Ontario L1S 2E2 Tel. 905.619.2300 - 905.420.5300 Fax 905.619.2375 Email: info@hvacdesigns.ca Web: www.hvacdesigns.ca Specializing in Residential Mechanical Design Services Installation to comply with the latest Ontario Building Code. All supply branch outlets shall be equipped with a manual balancing damper. Ductwork which passes through the garage or unheated spaces shall be adequately insulated and be gas-proofed.	Sheet Title FIRST FLOOR HEATING LAYOUT
Project Name ROUNDEL HOMES INC RICHMOND HILL, ONTARIO		City of Richmond Hill Building Division Date MAY/2021 Scale 3/16" = 1'-0" 09/22/2022 BCIN# 19669 LO# 90737 Per: joshua.nabua
TERRACOTA 1	3287 sqft	

13.Exterior insulation effective R-Value for wall, roof or exposed floor shall be maintained at the respective location where duct or sanitary pipes are routed inside exterior envelope.

14. Return air intake shall be provided as recommended in HRAI Digest 2005 Section 4.7 Return air inlet should be positioned so that short circuiting of supply air is avoided. A high and low wall return air combination shall be provided when a combined cooling & heating system is installed.

15. For simplified HRV/ERV installation, with stale air and fresh air connected to return air plenum, stale air intake and fresh air supply shall be separated minimum 3' or as recommended by HRV/ERV Manufacturer.

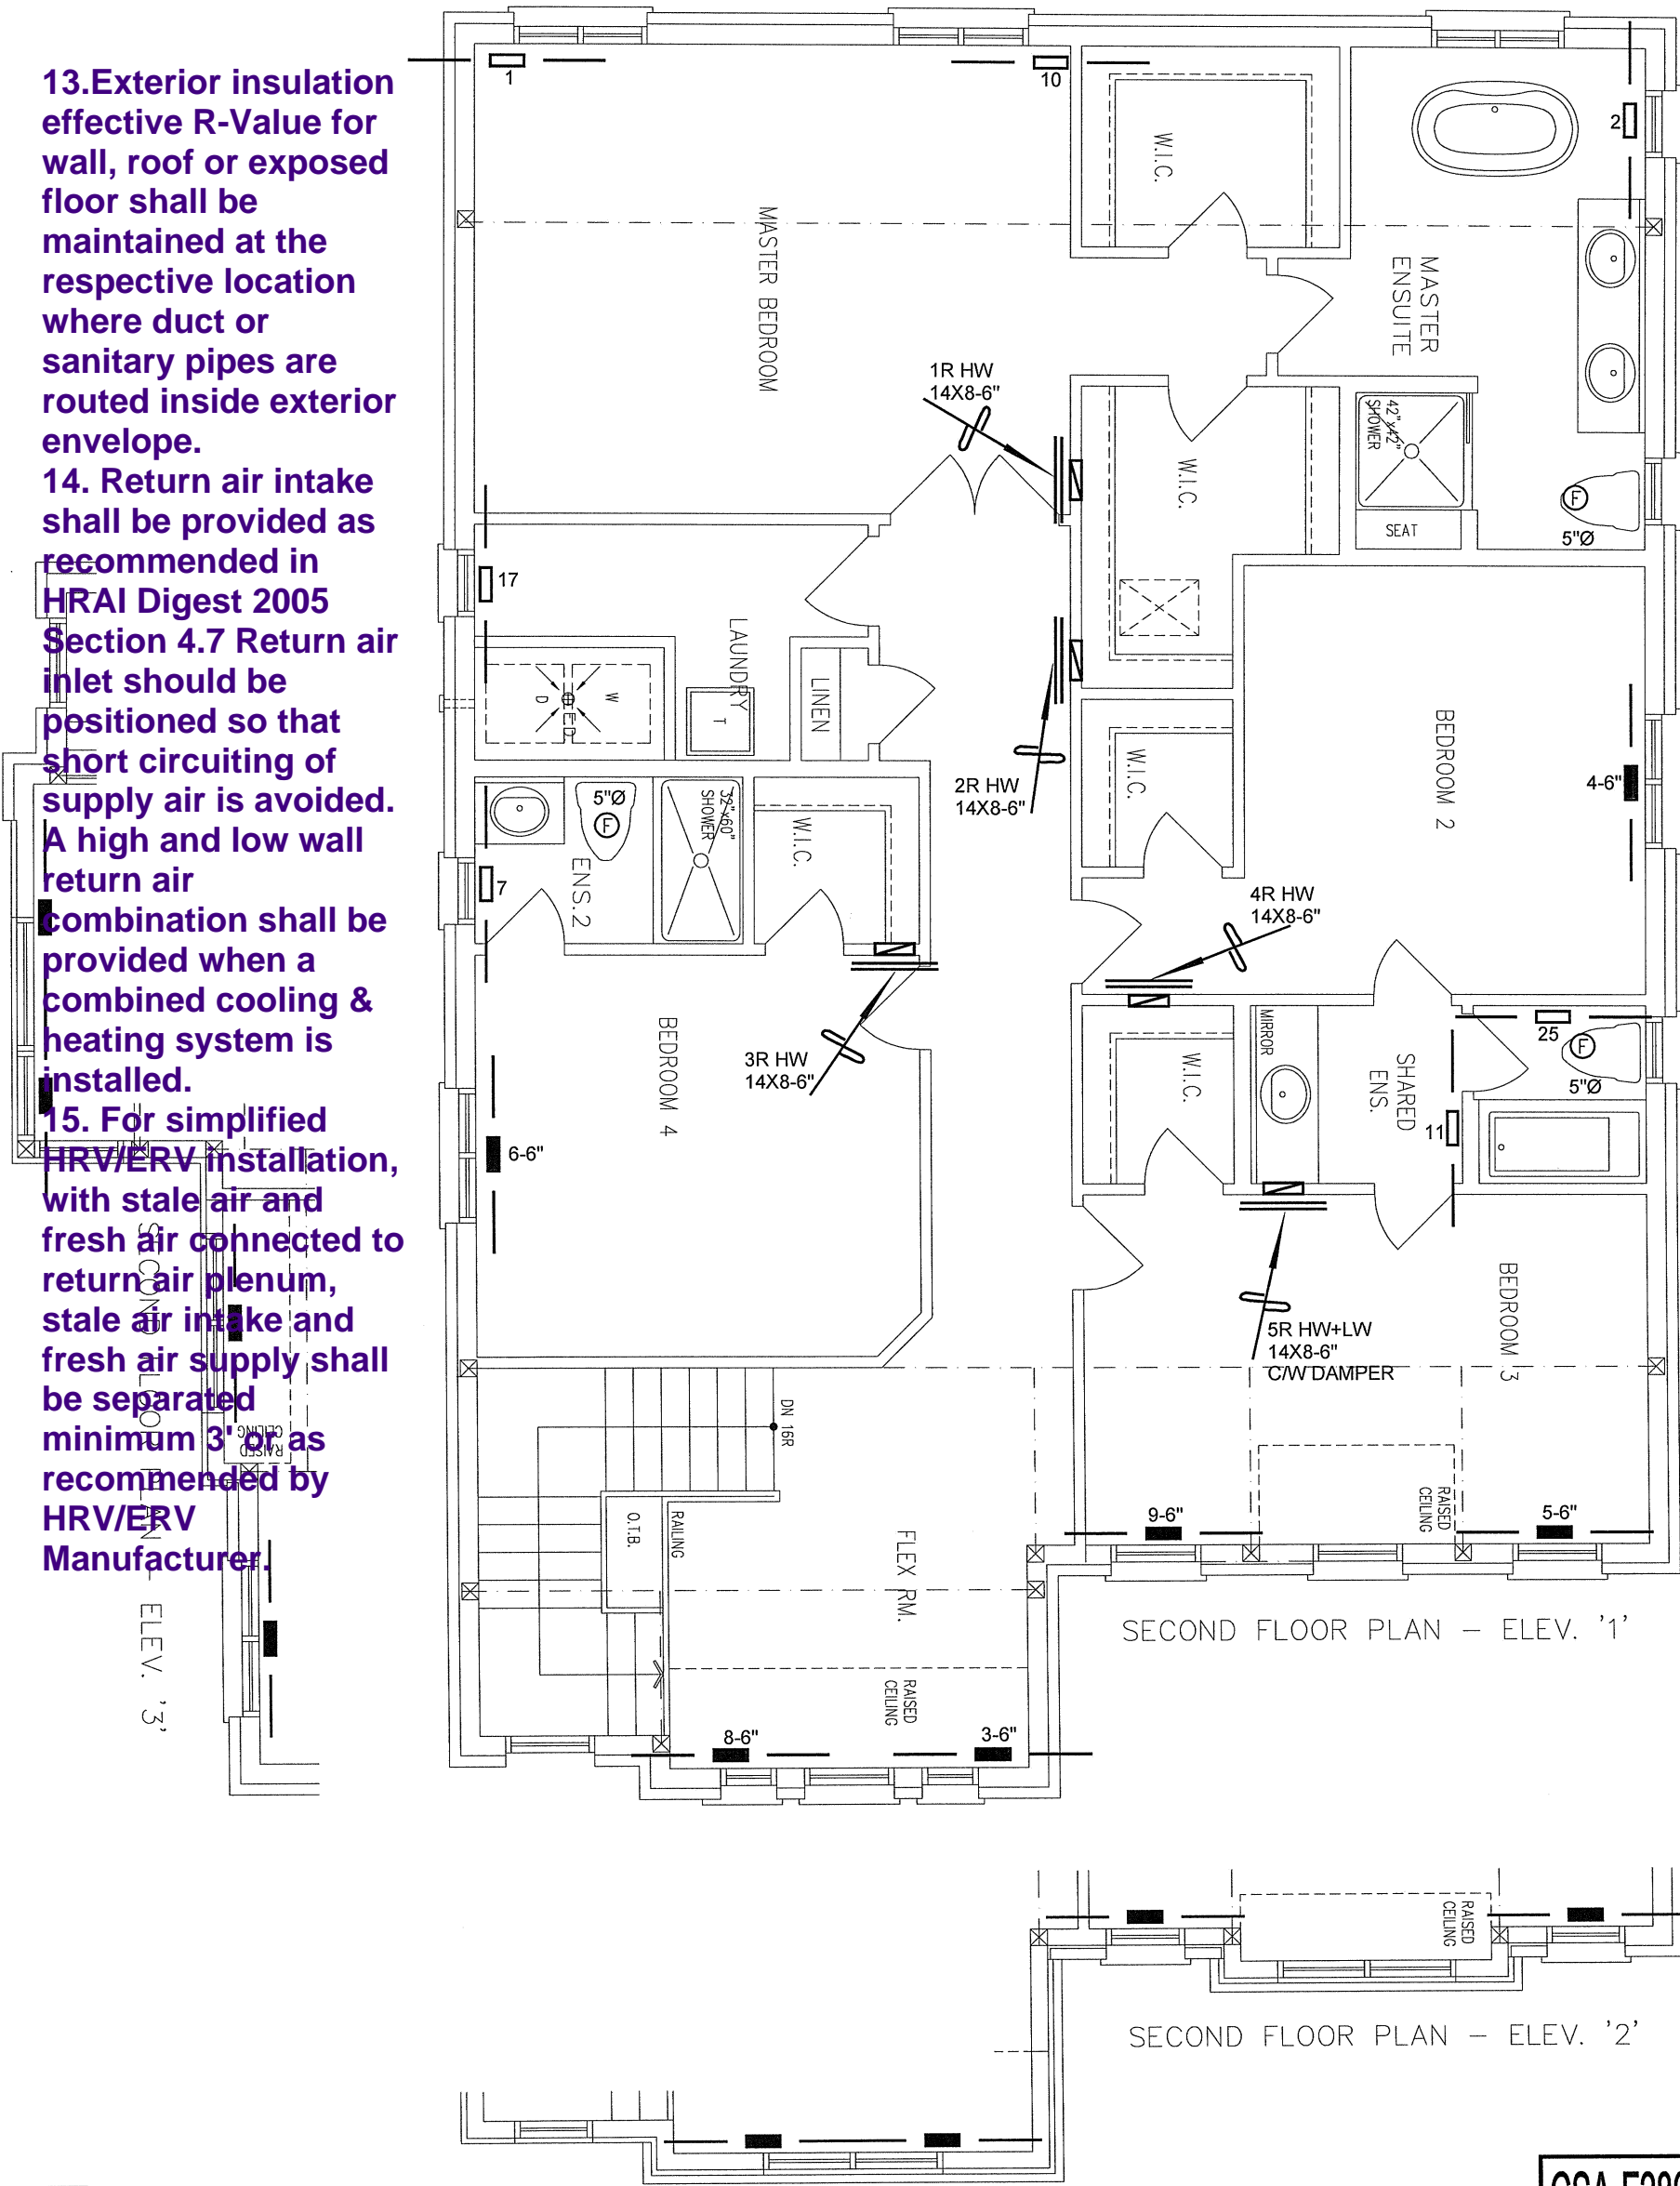

I MICHAEL O'ROURKE HAVE REVIEWED AND TAKE RESPONSIBILITY FOR THE DESIGN WORK AND AM QUALIFIED UNDER DIVISION C, 3.2.5 OF THE BUILDING CODE.

Michael O'Rourke
Michael O'Rourke, BCIN# 19669
HVAC DESIGNS LTD.

HVAC LEGEND						3.	
SYMBOL	DESCRIPTION	SYMBOL	DESCRIPTION	SYMBOL	DESCRIPTION	SYMBOL	DESCRIPTION
	SUPPLY AIR GRILLE		6" SUPPLY AIR BOOT ABOVE		14"x8" RETURN AIR GRILLE		RETURN AIR STACK ABOVE
	SUPPLY AIR GRILLE 6" BOOT		SUPPLY AIR STACK FROM 2nd FLOOR		30"x8" RETURN AIR GRILLE		RETURN AIR STACK 2nd FLOOR
	SUPPLY AIR BOOT ABOVE		6" SUPPLY AIR STACK 2nd FLOOR		FRA- FLOOR RETURN AIR GRILLE		REDUCER
						REVISIONS	
						No.	Date

ALL DRAWINGS, CALCULATIONS AND SPECIFICATIONS ARE THE PROPERTY OF HVAC DESIGNS LTD.© AND MAY NOT BE REPRODUCED, MODIFIED OR ALTERED WITHOUT EXPRESSED WRITTEN CONSENT. THE DRAWINGS ARE DATED AND USE OF THESE DRAWINGS AFTER ONE YEAR FROM THE DATED NOTED IS NOT AUTHORIZED. CONTRACTOR SHALL CHECK ALL CONDITIONS BEFORE PROCEEDING WITH WORK. LATEST MUNICIPAL APPROVED DRAWINGS ONLY TO BE USED DURING INSTALLATION OF HEATING SYSTEM. HVAC DESIGNS LTD. IS NOT LIABLE FOR ANY CLAIMS ARISING FROM UNAUTHORIZED USE OF THE DRAWINGS OR FROM ANY CHANGES TO ACCEPTED STANDARDS AND/OR THE ONTARIO BUILDING CODE.

Client GREENPARK HOMES		<div><p>375 Finley Ave. Suite 202 - Ajax, Ontario L1S 2E2 Tel. 905.619.2300 - 905.420.5300 Fax 905.619.2375 Email: info@hvacdesigns.ca Web: www.hvacdesigns.ca Specializing in Residential Mechanical Design Services</p></div>	Sheet Title SECOND FLOOR HEATING LAYOUT	
Project Name ROUNDEL HOMES INC RICHMOND HILL, ONTARIO			CITY OF RICHMOND HILL BUILDING DIVISION Date MAY/2021 Scale 3/16" = 1'-0" 09/22/2022 BCIN# 19669 <div>LO# 90737</div>	
TERRACOTA 1 3287 sqft		Installation to comply with the latest Ontario Building Code. All supply branch outlets shall be equipped with a manual balancing damper. Ductwork which passes through the garage or unheated spaces shall be adequately insulated and be gas-proofed.		