

CONSTRUCTION SUMMARY - PARTIAL ONLY
Mountainview Heights 3 (G) - Russell Gardens Building Ltd.

PURCHASERS: NJEUGA NJIHA NYA and Jolly Destin JUOMPAN YAKAM YATCHOU TEL: RES.: 514-388-9742 BUS.: 905-805-6945

LOT NUMBER	PHASE	HOUSE TYPE	REG. PLAN #		
585	4	Grandville Three Elev 2	62M-1266		

INV#	QTY	EXTRA / CHANGE	
------	-----	----------------	--

CABINETRY

26,503 19Jan22	1 - CABINETRY - KITCHEN - UPGRADE 5 Note:
26,315 05Nov21	1 - CABINETRY PROVISION - PROVISION FOR PLUG ON ISLAND (PLUG EXTRA ORDERED SEPARATELY) Note:
26,503 19Jan22	1 - ***DELETE - CABINETRY - KITCHEN - UPGRADE 3 Note:
26,315 05Nov21	1 - KITCHEN CABINETRY - CROWN MOULDING CM 3 Note:
26,315 05Nov21	1 - KITCHEN CABINETRY - LIGHT VALANCE - NO ELECTRICAL Note:
26,315 05Nov21	1 - KITCHEN CABINETRY - TWO COLOUR KITCHEN - FLAT FEE Note:
26,315 05Nov21	1 - CABINETRY - KITCHEN - UPGRADE 3 Note:

CABINETRY ACCESSORIES

26,503 19Jan22	1 - KITCHEN CABINETRY - BUILT-IN FRIDGE CABINET - PRICE IS EACH Note: See attached new micro specs
26,503 19Jan22	1 - CABINETRY FEE FOR FLUSH CUTOUT ON WALL OVEN/MICROWAVE COMBO CABINET ONLY Note: ★
26,503 19Jan22	1 - KITCHEN - CREATE OPENING FOR WINE FRIDGE Note:
26,503 19Jan22	1 - KITCHEN CABINETRY BASE - BANK OF DRAWERS - UPGRADE 5 Note: Selling \$
26,503 19Jan22	1 - KITCHEN CABINETRY BASE - POT/DRAWERS (CABINET) - UPGRADE 5 Note:
26,503 19Jan22	1 - KITCHEN CABINETRY - BUILT-IN MICROWAVE/OVEN COMBO - UPGRADE 5 Note: Cons
26,503 19Jan22	1 - KITCHEN CABINETRY BASE - COOKTOP CABINET WITH POT DRAWERS (2 DRAWERS) - UPGRADE 5 Note:
26,503 19Jan22	1 - KITCHEN CABINETRY - MINI STACKED UPPER CABINETS - PRICE IS PER FOOT - UPGRADE 5 CABINETRY Note:

30" Built-In Microwave Oven

500 Series – Stainless Steel HMB50152UC



HMB50152UC
Stainless Steel

Built-in microwave design matched for use in combination with Bosch wall oven.

- Features & Benefits**

Large cooking interior gives you more flexibility in what types of dishes you can cook.

Built for speed and convenience with 950 watts of microwave cooking power.

Convenient automatic sensor programs simplify cooking for great results every time.

General Properties	
Cavity color	Stainless Steel
Max. microwave power	950 W
Capacity	
Cavity capacity	1.6 cu. ft.
Turntable diameter	14 1/8"
Technical Details	
Watts	1,650 W
Circuit breaker	15 A
Volts	120 V
Frequency	60 Hz
Power cord length	43"
Plug type	NEMA 5-15 – 3 prong plug



Dimensions & Weight	
Overall appliance dimensions (HxWxD)	19 5/8" x 29 3/4" x 19 5/8"
Required cutout size – Standard (HxWxD)	19 1/4" x 28 1/2" x 19 1/4"
Required cutout size – Flush (HxWxD)	20 1/4" x 30" x 20 3/4"
Oven overall interior dimensions (HxWxD)	9 7/8" x 16 1/2" x 16 1/2"
Net weight	75 lbs
Accessories–Included	
Included	Glass turntable

Lot 585
Russell

Accessories: To purchase Bosch accessories, cleaners & parts please visit www.bosch-home.com/us/store or call 1-800-944-2904 (Mon to Fri 5 am to 6 pm PST, Sat 6 am to 3 pm PST).

Notes: All height, width and depth dimensions are shown in inches. BSH reserves the absolute and unrestricted right to change product materials and specifications, at any time, without notice. Consult the product's installation instructions for final dimensional data and other details prior to making cutout.

Warranties: Please see Use & Care manual or Bosch website for statement of limited warranty.

For more information on our entire line of products, go to www.bosch-home.com/us or call 1-800-944-2904




© BSH Home Appliances Corporation. All rights reserved. Bosch is a registered trademark of Robert Bosch GmbH.

30" Built-In Microwave Oven

500 Series – Stainless Steel HMB50152UC



Installation Details

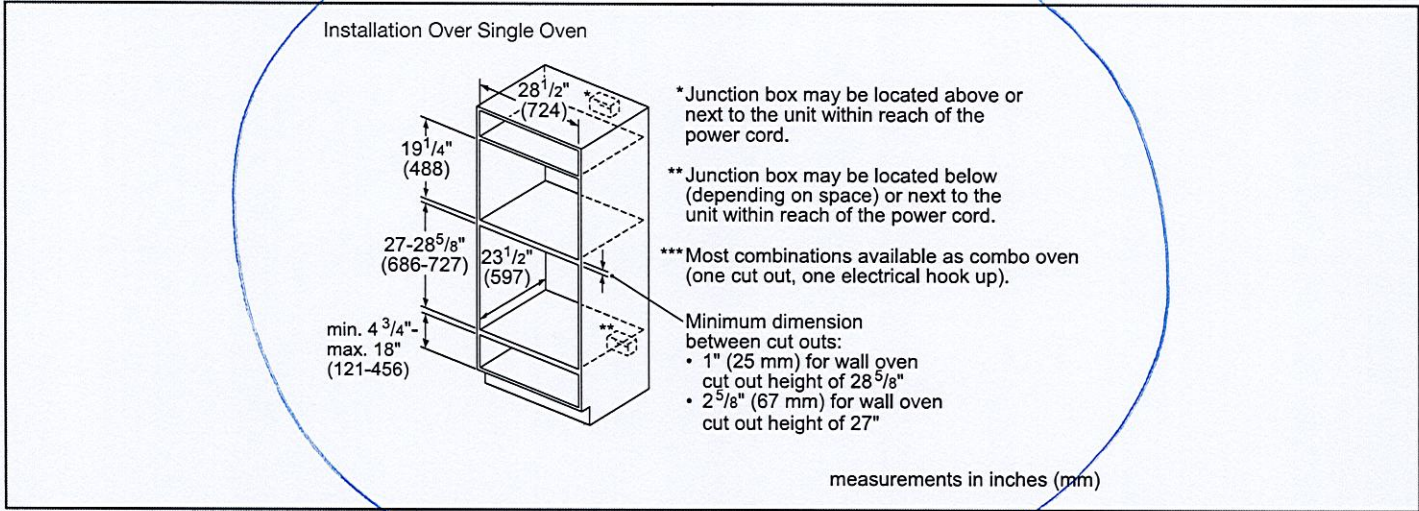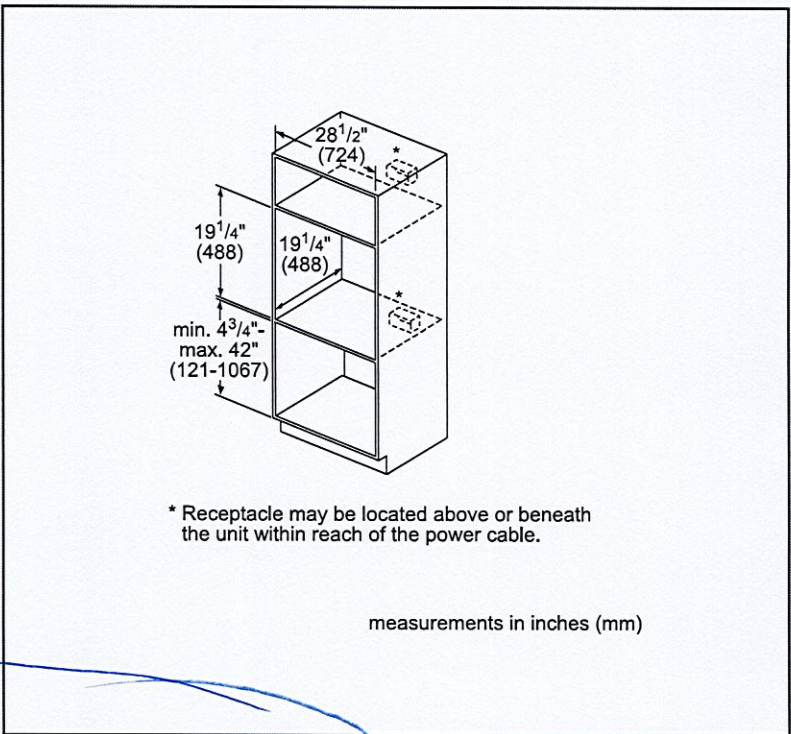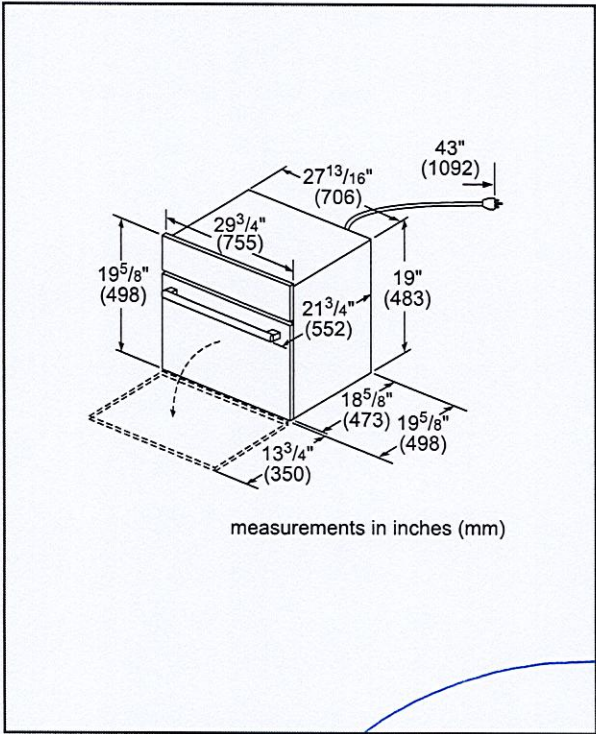

Accessories: To purchase Bosch accessories, cleaners & parts please visit www.bosch-home.com/us/store or call 1-800-944-2904 (Mon to Fri 5 am to 6 pm PST, Sat 6 am to 3 pm PST).

Notes: All height, width and depth dimensions are shown in inches. BSH reserves the absolute and unrestricted right to change product materials and specifications, at any time, without notice. Consult the product's installation instructions for final dimensional data and other details prior to making cutout.

Warranties: Please see Use & Care manual or Bosch website for statement of limited warranty.

For more information on our entire line of products, go to www.bosch-home.com/us or call 1-800-944-2904

© BSH Home Appliances Corporation. All rights reserved. Bosch is a registered trademark of Robert Bosch GmbH.



Lot 585
Russell

30" Built-In Microwave Oven

500 Series – Stainless Steel HMB50152UC



Installation Details

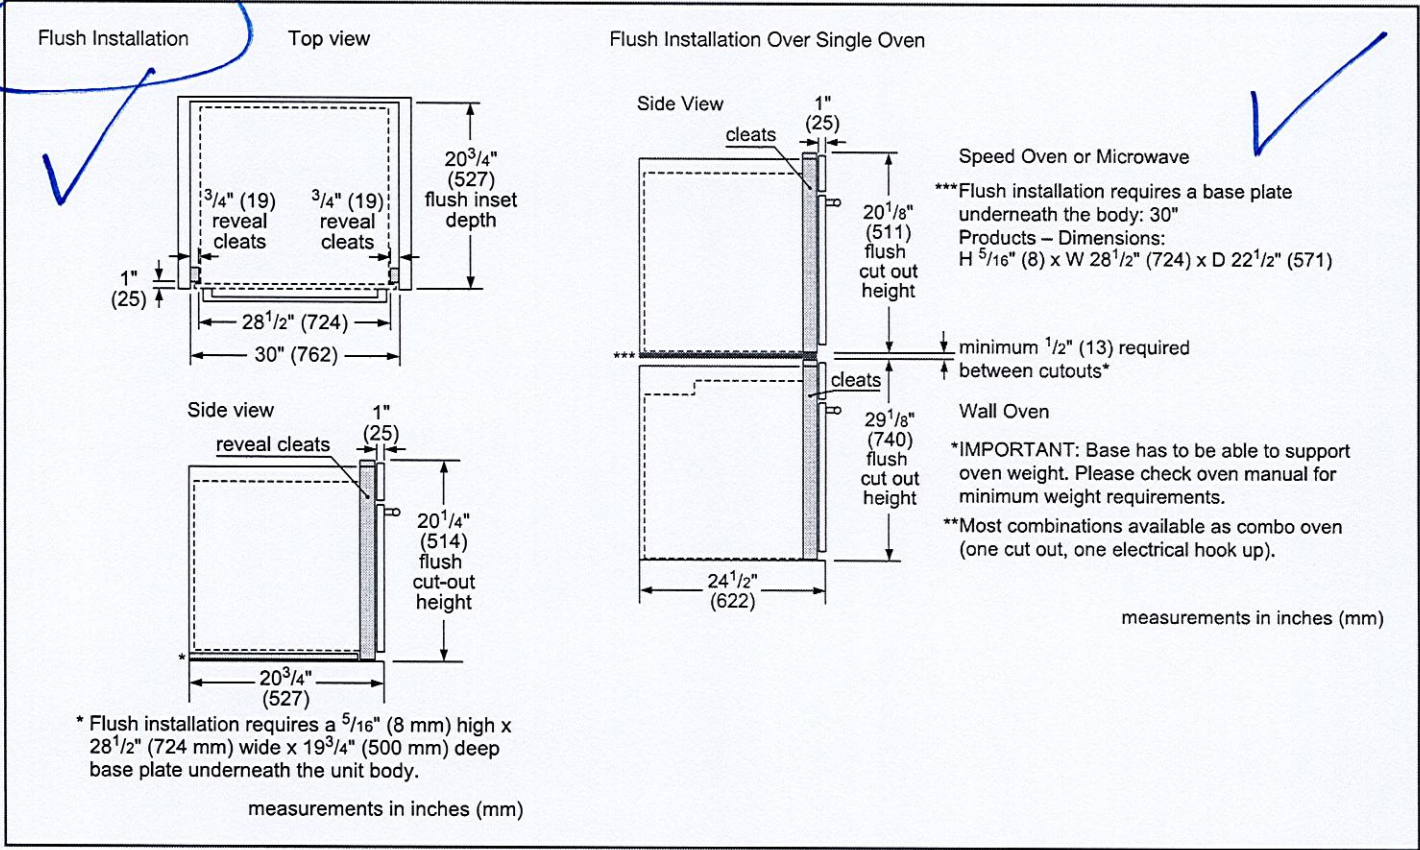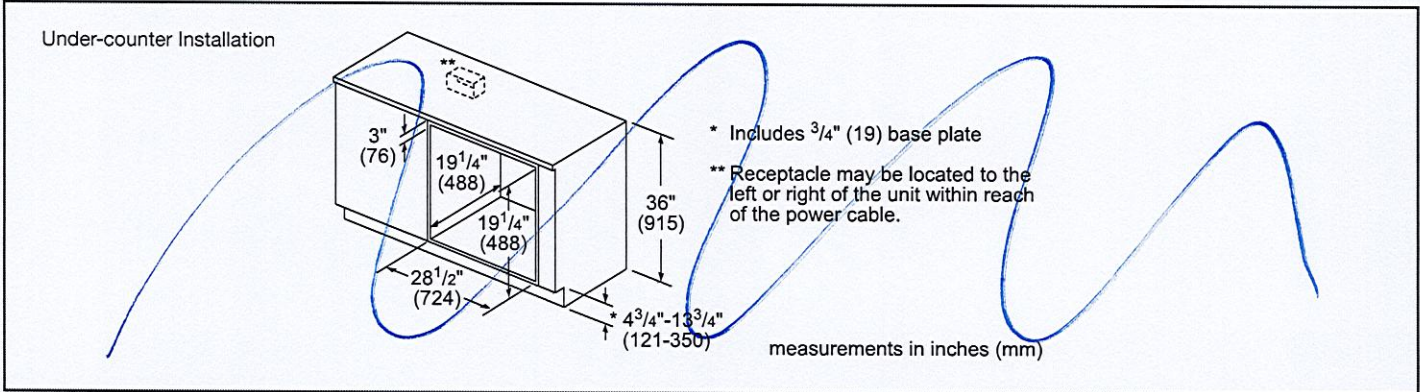

Accessories: To purchase Bosch accessories, cleaners & parts please visit www.bosch-home.com/us/store or call 1-800-944-2904 (Mon to Fri 5 am to 6 pm PST, Sat 6 am to 3 pm PST).

Notes: All height, width and depth dimensions are shown in inches. BSH reserves the absolute and unrestricted right to change product materials and specifications, at any time, without notice. Consult the product's installation instructions for final dimensional data and other details prior to making cutout.

Warranties: Please see Use & Care manual or Bosch website for statement of limited warranty.

For more information on our entire line of products, go to www.bosch-home.com/us or call 1-800-944-2904

© BSH Home Appliances Corporation. All rights reserved. Bosch is a registered trademark of Robert Bosch GmbH.


Lot 585
Russell

30" Built-In Microwave Oven

500 Series – Stainless Steel HMB50152UC



Installation Details

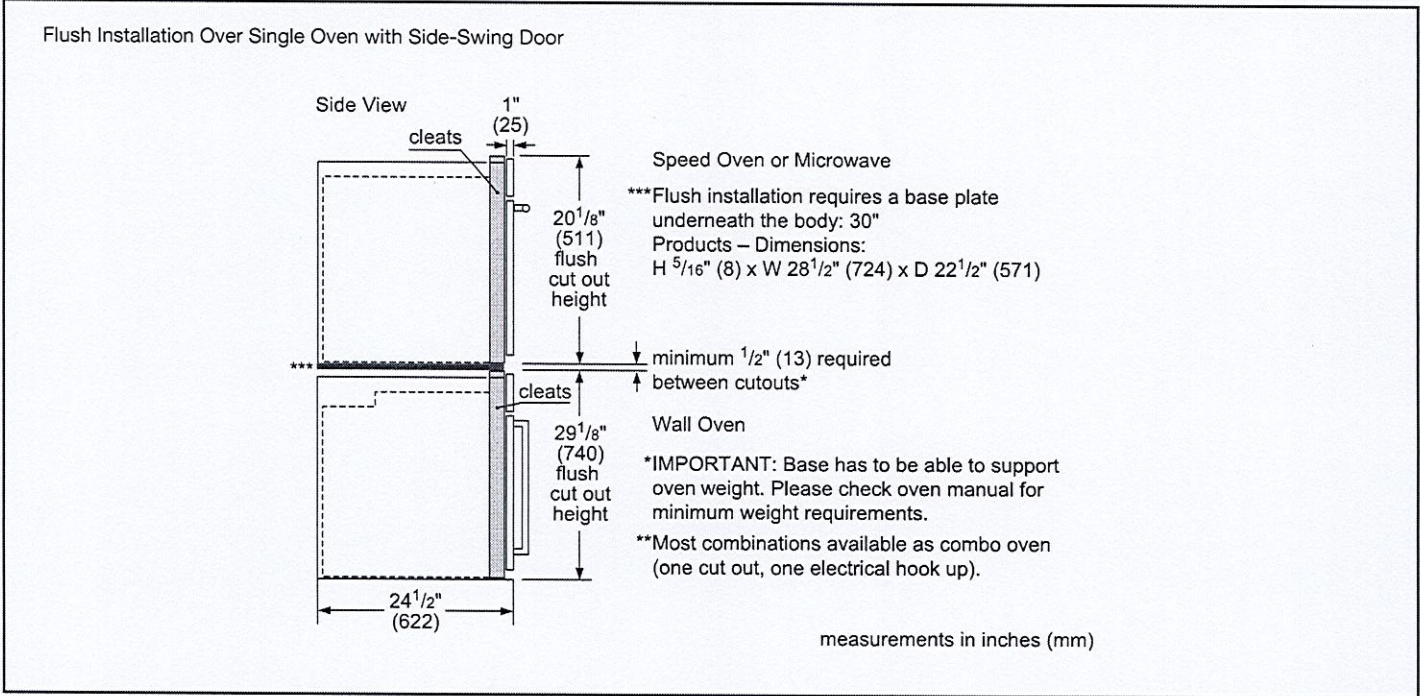

Accessories: To purchase Bosch accessories, cleaners & parts please visit www.bosch-home.com/us/store or call 1-800-944-2904 (Mon to Fri 5 am to 6 pm PST, Sat 6 am to 3 pm PST).

Notes: All height, width and depth dimensions are shown in inches. BSH reserves the absolute and unrestricted right to change product materials and specifications, at any time, without notice. Consult the product's installation instructions for final dimensional data and other details prior to making cutout.

Warranties: Please see Use & Care manual or Bosch website for statement of limited warranty.

For more information on our entire line of products, go to www.bosch-home.com/us or call 1-800-944-2904

© BSH Home Appliances Corporation. All rights reserved. Bosch is a registered trademark of Robert Bosch GmbH.

Lot 585
Russell