

CONSTRUCTION SUMMARY

Palmetto - Zadorra Estates Corp.

PURCHASER: Kengatharan PARARAJASINGAM

TEL: RES.: 416-356-5961

LOT / PHASE 31 / 1	REG. PLAN #	HOUSE TYPE Villa 3 Elev 1		
-----------------------	-------------	------------------------------	--	--

CONSTRUCTION

1 - SMOOTH CEILINGS ON FIRST FLOOR 25Sep23 Note:	
---	--

FIREPLACE AND ACCESSORIES

1 - GAS LINE ROUGH-IN FOR STOVE (INCLUDES ELECTRICAL OUTLET) - FIRST FLOOR 25Sep23 Note:	
---	--

PROMOTIONAL

1 - PARTIAL REDEMPTION OF PROMOTIONAL PACKAGE \$7,790.00. BALANCE FORWARD \$7,210.00 TO BE USED AT A LATER DATE. ORIGINAL PROMOTIONAL PACKAGE OF \$15,000.00 AS PER SCHEDULE PE. 25Sep23 Note:	
---	--

EXTRAS AS PER OFFER



The Vendor agrees that notwithstanding any other term or provision in this Agreement included in the Purchase Price and in addition to those items detailed in Schedule GP to the Agreement of Purchase and Sale, the Purchaser is entitled to a credit of Fif Worksheet Note:	
---	--

This Document is Extremely Time Sensitive - Printed 25 Sep 23 at 16:21

LOT #31

Villa 3 36' LOT

ELEVATION 1 2,662 sq.ft. • ELEVATION 2 2,662 sq.ft. • ELEVATION 3 2,647 sq.ft.
INCLUDES 15 SQ.FT. OF OPEN AREA

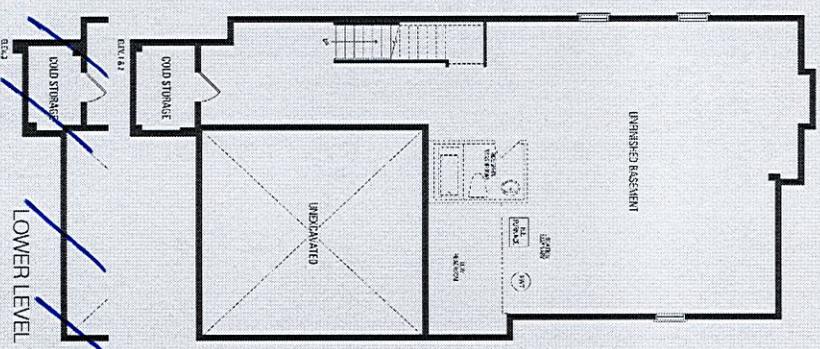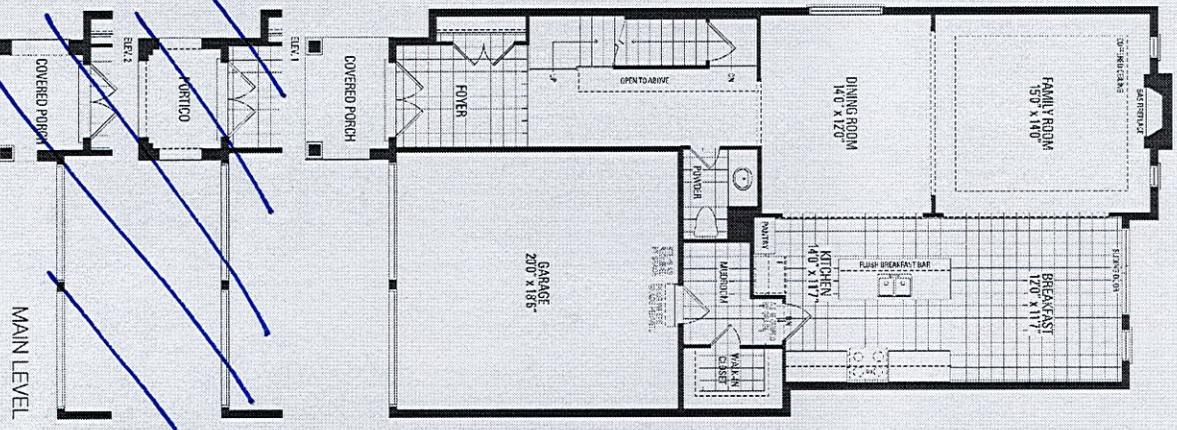

*Gas line r/i for stove
*Smooth ceiling- 1st floor

