Greenpark.

## **CONSTRUCTION SUMMARY**

Palmetto - Zadorra Estates Corp.

PURCHASERS: Idowu Emmanuel ADEFALA and Munirah ABDUL RAHIM

OCT 18 2023

TEL: RES.: 647-514-8007

LOT / PHASE	REG. PLAN #	HOUSE TYPE	
35 / 1		Villa 5 Elev 1	

ELECTRICAL	
1 - PLUG - ELECTRICAL PLUG - TO BE INSTALLED OVER FIREPLACE	
13Oct23 Note:	
1 - ABOVE KITCHEN ISLAND - ADD LIGHT AND SWITCH - NO FIXTURE INCLUDED	
13Oct23 Note:	
1 - LIGHT AND SWITCH - NO FIXTURE INCLUDED - LIVING ROOM	
13Oct23 Note:	
1300125 1.000.	
FIREPLACE AND ACCESSORIES	
1 - GAS LINE ROUGH-IN FOR STOVE (INCLUDES ELECTRICAL OUTLET) - FIRST FLOOR	
13Oct23 Note:	
15 00125 1.000	
PLUMBING	
1 - WATER LINE FOR FRIDGE - ROUGH-IN ONLY	
13Oct23 Note:	
1500125 11010.	
PROMOTIONAL	
1 - PARTIAL REDEMTION OF PROMOTIONAL PACKAGE \$2,310.00 BALANCE FORWARD \$12,690.00 TO BE USED AT A LATER	TOWNERS


## **EXTRAS AS PER OFFER**


DATE. ORIGINAL PROMOTIONAL PACKAGE OF \$15,000.00 AS PER SCHEDULE PE.

The Vendor agrees that notwithstanding any other term or provision in this Agreement included in the Purchase Price and in addition to those items detailed in Schedule GP to the Agreement of Purchase and Sale, the Purchaser is entitled to a credit of Fif Worksheet Note:

This Document is Extremely Time Sensitive - Printed 13 Oct 23 at 16:28

13Oct23 Note:

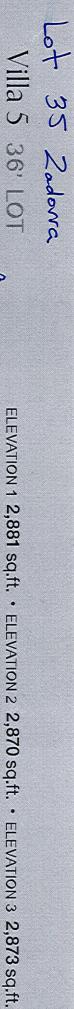

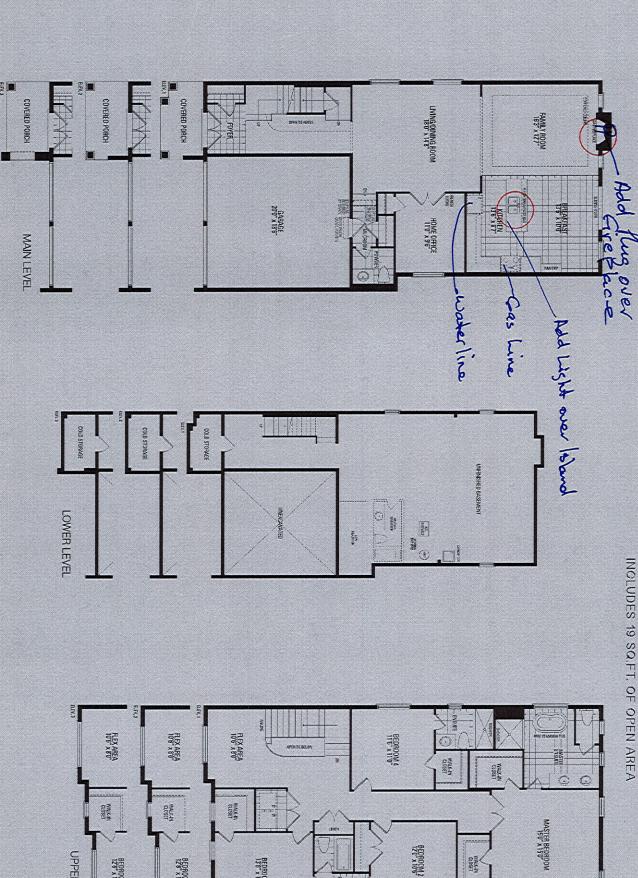

BEDROOM 3

WALK-IN

UPPER LEVEL

BEDROOM 3

BEDROOM 3