

100ct23 Note:


STRUCTURAL PREUMINARY


DCHASEDS: Luc Luc V		TRUCTION SUMMARY ill - Trinigroup Development Inc.	MET E VIII	T
CHASERS: Luo Luo A	and Shouwer Aing		001 1 0 2020	1.
LOT / PHASE	REG. PLAN #	HOUSE TYPE		
111/1		Villa 6 Elev 2		
FIRST FLOOR INCREA Oct23 Note:	SE CEILING HEIGHT FROM 9 I	FEET TO 10 FEET		
OMOTIONAL				
LESS CREDIT FROM P	URCHASER EXTRA SHEET IN	OFFER		


EXTRAS AS PER OFFER

The Vendor agrees that notwithstanding any other term or provision in this Agreement included in the Purchase Price and in addition to those items detailed in Schedule GP to the Agreement of Purchase and Sale, the Purchaser is entitled to a credit of Ten Worksheet Note:

This Document is Extremely Time Sensitive - Printed 10 Oct 23 at 11:33

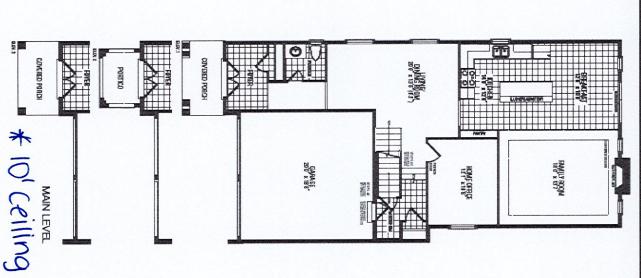

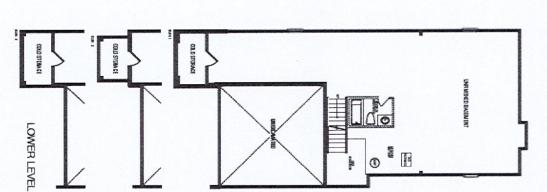

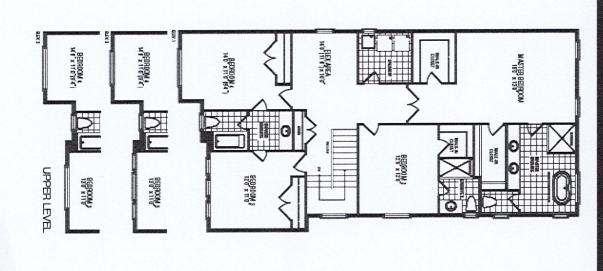

Orientation of home may be reversed and purchaser agrees to accept the same. Steps and porches may vary at any exterior entrance ways due to grading variance. Actual usable floor space may vary from the stated floor areas. All renderings are artist's concept. Dimensions, specifications and architectural detailing subject to modifications. Roofline and adjoining model types may vary due to sting. E. & O. E. September 2023.