

CONSTRUCTION SUMMARY

Legacy Hill - Trinigroup Development Inc.

RECEIVED

PURCHASERS: Ingrid Yuan-San LEE and Hoi Pong CHENG

NOV 01 2023

TEL:

LOT / PHASE	REG. PLAN #	HOUSE TYPE		
5 / 1		Villa 5 Elev 2		

CONSTRUCTION

3 - ENLARGED BASEMENT WINDOWS (MAY REQUIRE WINDOW WELLS) - WINDOW IS 30 INCHES X 24 INCHES

30Oct23 Note:

PROMOTIONAL

1 - PARTIAL REDEMPTION OF PROMOTIONAL PACKAGE \$1,950.00 BALANCE FORWARD \$8,050.00 TO BE USED AT A LATER DATE. ORIGINAL PROMOTIONAL PACKAGE OF \$10,000.00 AS PER SCHEDULE PE.

30Oct23 Note:

EXTRAS AS PER OFFER

The Vendor agrees that notwithstanding any other term or provision in this Agreement included in the Purchase Price and in addition to those items detailed in Schedule GP to the Agreement of Purchase and Sale, the Purchaser is entitled to a credit of Ten

Worksheet Note:

Complete Central Air Conditioning

Worksheet Note:




This Document is Extremely Time Sensitive - Printed 30 Oct 23 at 14:59

Villa 5 36" Lot

Elev. 1: 2,881 sq.ft. Elev. 2: 2,871 sq.ft. Elev. 3: 2,873 sq.ft.
Includes 19 sq.ft. of Open Area

LH

Lot 5 Trinigroup

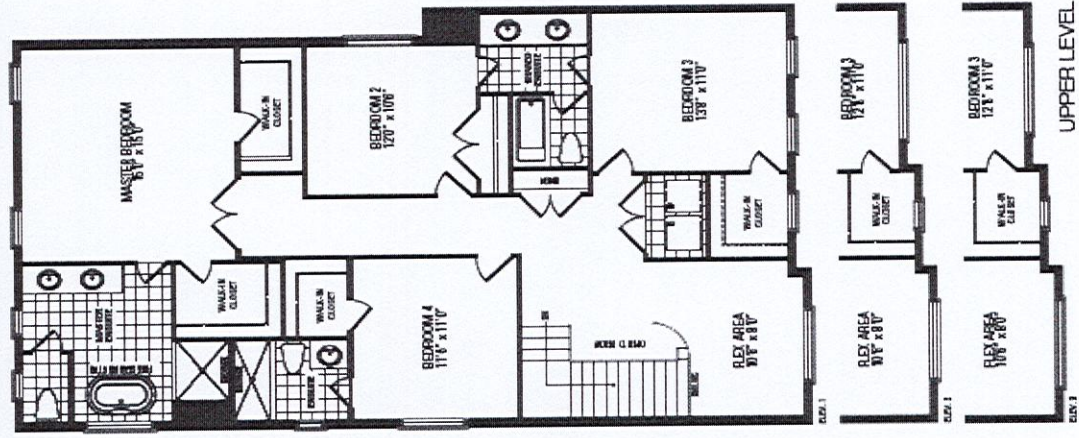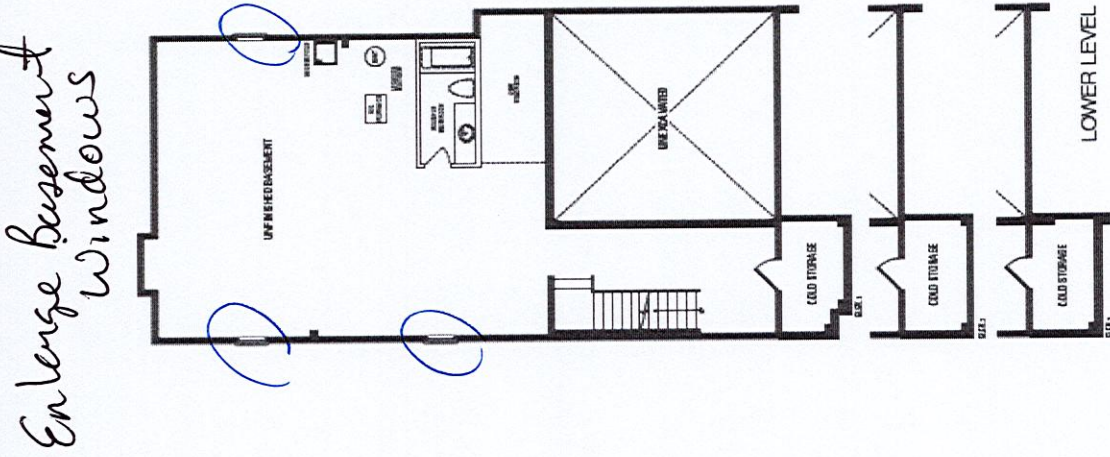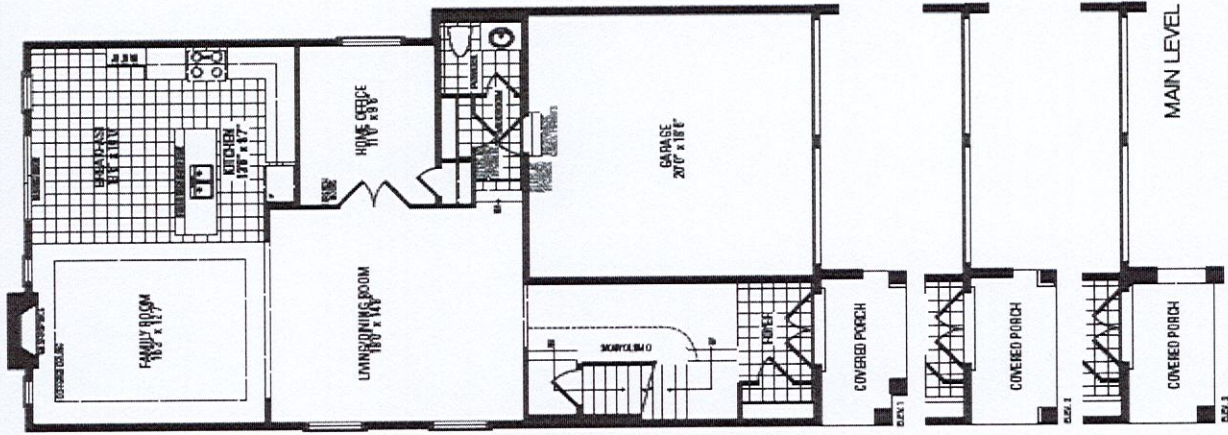

Orientation of home may be reversed and purchaser agrees to accept the same. Steps and porches may vary at any exterior entrance ways due to grading variance. Actual usable floor space may vary from the stated floor areas. All renderings are artist's concept. Dimensions, specifications and architectural detailing subject to modifications. Roofline and adjoining model types may vary due to siting. E. & O. E. September 2023