

SITE NAME: TRINIGROUP				WOB				DATE: Jun-23				WINTER NATURAL AIR CHANGE RATE 0.380				HEAT LOSS ΔT °F. 78				CSA-F280-12			
BUILDER: GREENPARK HOMES				TYPE: ROSE 9				GFA: 3466				SUMMER NATURAL AIR CHANGE RATE 0.118				HEAT GAIN ΔT °F. 13				SB-12 PACKAGE A1			
ROOM USE				MBR				ENS				WIC				BED-2				BED-3			
EXP. WALL				47				8				0				14				26			
CLG. HT.				9				9				9				9				9			
FACTORS																							
GRS.WALL AREA				423				72				0				126				234			
GLAZING				LOSS GAIN				LOSS GAIN				LOSS GAIN				LOSS GAIN				LOSS GAIN			
NORTH				21.8 16.0				0 0 0				0 0 0				18 392 288				0 0 0			
EAST				21.8 41.6				0 0 0				0 0 0				38 828 1579				49 1067 2036			
SOUTH				21.8 24.9				0 0 0				0 0 0				0 0 0				12 261 299			
WEST				21.8 41.6				56 1220 2327				18 392 748				0 0 0				0 0 0			
SKYLT.				38.1 101.5				0 0 0				0 0 0				0 0 0				0 0 0			
DOORS				20.5 3.4				0 0 0				0 0 0				0 0 0				0 0 0			
NET EXPOSED WALL				4.6 0.8				367 1677 276				54 247 41				108 493 81				196 895 147			
NET EXPOSED BSMT WALL ABOVE GR				3.7 0.6				0 0 0				0 0 0				0 0 0				0 0 0			
EXPOSED CLG				1.3 0.6				421 553 247				150 197 88				76 100 45				269 353 158			
NO ATTIC EXPOSED CLG				2.8 1.3				0 0 0				0 0 0				0 0 0				10 28 13			
EXPOSED FLOOR				2.6 0.4				0 0 0				0 0 0				0 0 0				210 548 90			
BASEMENT/CRAWL HEAT LOSS								0				0				0				0			
SLAB ON GRADE HEAT LOSS								0				0				0				0			
SUBTOTAL HT LOSS				3450				836				100				1239				2101			
SUB TOTAL HT GAIN				2850				877				45				527				1895			
LEVEL FACTOR / MULTIPLIER				0.20 0.32				0.20 0.32				0.20 0.32				0.20 0.32				0.20 0.32			
AIR CHANGE HEAT LOSS				1108				269				32				398				675			
AIR CHANGE HEAT GAIN				157				48				2				29				105			
DUCT LOSS				0				0				0				0				0			
DUCT GAIN				0				0				0				0				0			
HEAT GAIN PEOPLE				240				2				480				0				1			
HEAT GAIN APPLIANCES/LIGHTS				644				0				0				644				644			
TOTAL HT LOSS BTU/H				4558				1104				132				1637				2776			
TOTAL HT GAIN x 1.3 BTU/H				5371				1203				61				1872				3749			

ROOM USE				HOME				LIV/DIN				KIT				FAM				LAUN				FOY				MUD				BATH	
EXP. WALL				21				35				47				33				34				9				24				53	
CLG. HT.				10				10				10				10				10				10				10				131	
FACTORS	
GRS.WALL AREA				210				350				470				330				340				90				240				131	
GLAZING				LOSS GAIN				LOSS GAIN				LOSS GAIN				LOSS GAIN				LOSS GAIN				LOSS GAIN				LOSS GAIN				LOSS GAIN	
NORTH				21.8	16.0	0	0	0	28	610	447	0	0	

SITE NAME: TRINIGROUP
BUILDER: GREENPARK HOMESWOB
TYPE: ROSE 9

DATE: Jun-23

GFA: 3466 LO# 101733

HEATING CFM 1504 COOLING CFM 1504
TOTAL HEAT LOSS 63,570 TOTAL HEAT GAIN 49,152
AIR FLOW RATE CFM 23.66 AIR FLOW RATE CFM 30.6furnace pressure 0.6
furnace filter 0.05
a/c coil pressure 0.2
available pressure
for s/a & r/a 0.35#*GOODMAN
GMEC960804CNA 80AFUE = 96 %
INPUT (BTU/H) = 80,000
OUTPUT (BTU/H) = 76,800

RUN COUNT	4th	3rd	2nd	1st	Bas
S/A	0	0	15	10	5
R/A	0	0	5	2	1

All S/A diffusers 4"x10" unless noted otherwise on layout.


All S/A runs 5"Ø unless noted otherwise on layout.

plenum pressure s/a 0.18 r/a pressure 0.17
max s/a dif press. loss 0.02 r/a grille press. Loss 0.02
min adjusted pressure s/a 0.16 adjusted pressure r/a 0.15FAN SPEED 868
LOW 978
MEDLOW 1112
MEDIUM 1504
MEDIUM HIGH 1615
HIGHDESIGN CFM = 1504
CFM @ .6" E.S.P.

TEMPERATURE RISE 47 °F

RUN #	1	2	3	4	5	6	7	8	9	10	11	12	13	14	15	16	17	18	19	20	21	22	23	24
ROOM NAME	MBR	ENS	WIC	BED-2	BED-3	BED-4	ENS-2	ENS-3	WIC-3	MBR	ENS-4	HOME	LIV/DIN	KIT	KIT	FAM	LAUN	LIV/DIN	FOY	MUD	BAS	BAS	BAS	BAS
RM LOSS MBH.	2.28	1.10	0.13	1.64	1.39	1.66	0.55	2.55	0.87	2.28	1.25	2.23	2.21	2.48	2.48	1.70	2.69	2.21	1.83	1.69	4.25	4.25	4.25	4.25
CFM PER RUN HEAT	54	26	3	39	33	39	13	60	21	54	30	53	52	59	59	40	64	52	43	40	101	101	101	101
RM GAIN MBH.	2.69	1.20	0.06	1.87	1.87	1.83	0.26	3.06	0.86	2.69	0.49	2.62	2.15	2.40	2.40	1.71	1.80	2.15	2.61	0.25	1.28	1.28	1.28	1.28
CFM PER RUN COOLING	82	37	2	57	57	56	8	94	26	82	15	80	66	73	73	52	55	66	80	8	39	39	39	39
ADJUSTED PRESSURE	0.16	0.17	0.17	0.17	0.17	0.17	0.17	0.16	0.17	0.16	0.17	0.17	0.17	0.17	0.17	0.17	0.17	0.17	0.17	0.17	0.16	0.16	0.16	0.16
ACTUAL DUCT LGH.	38	53	43	36	61	56	18	48	50	48	69	43	23	22	32	38	51	11	30	42	59	24	29	10
EQUIVALENT LENGTH	110	140	160	170	180	130	120	160	130	150	170	150	100	130	170	190	150	120	120	110	140	120	150	130
TOTAL EFFECTIVE LENGTH	148	193	203	206	241	186	138	208	180	198	239	193	123	152	202	228	201	131	150	152	199	144	179	140
ADJUSTED PRESSURE	0.11	0.09	0.08	0.08	0.07	0.09	0.12	0.08	0.1	0.08	0.07	0.09	0.14	0.11	0.09	0.08	0.09	0.13	0.11	0.11	0.08	0.11	0.09	0.12
ROUND DUCT SIZE	6	4	4	5	5	6	4	6	4	6	4	5	5	5	5	5	5	5	6	4	6	6	6	6
HEATING VELOCITY (ft/min)	275	298	34	286	242	199	149	306	241	275	344	389	382	433	433	294	470	382	219	459	515	515	515	515
COOLING VELOCITY (ft/min)	418	424	23	419	419	286	92	479	298	418	172	587	485	536	536	382	404	485	408	92	199	199	199	199
OUTLET GRILL SIZE	4X10	3X10	3X10	3X10	3X10	4X10	3X10	4X10	3X10	4X10	3X10	3X10	3X10	3X10	3X10	3X10	3X10	3X10	4X10	3X10	4X10	4X10	4X10	4X10
TRUNK	C	B	B	E	D	B	E	D	B	C	A	D	D	C	B	B	A	E	D	A	A	C	C	E

RUN #	25	26	27	28	29	30
ROOM NAME	ENS-WC	BED-3	BED-4	FAM	BED-4	BAS
RM LOSS MBH.	0.67	1.39	1.66	1.70	1.66	4.25
CFM PER RUN HEAT	16	33	39	40	39	101
RM GAIN MBH.	0.54	1.87	1.83	1.71	1.83	1.28
CFM PER RUN COOLING	17	57	56	52	56	39
ADJUSTED PRESSURE	0.17	0.17	0.17	0.17	0.17	0.16
ACTUAL DUCT LGH.	59	62	60	48	43	22
EQUIVALENT LENGTH	170	210	190	140	120	100
TOTAL EFFECTIVE LENGTH	229	272	250	188	163	122
ADJUSTED PRESSURE	0.08	0.06	0.07	0.09	0.11	0.13
ROUND DUCT SIZE	4	6	5	5	5	6
HEATING VELOCITY (ft/min)	184	168	286	294	286	515
COOLING VELOCITY (ft/min)	195	291	411	382	411	199
OUTLET GRILL SIZE	3X10	4X10	3X10	3X10	3X10	4X10
TRUNK	A	D	A	A	E	E

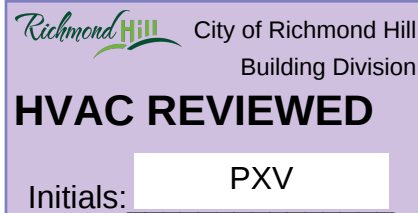

Richmond Hill City of Richmond Hill
Building Division
HVAC REVIEWED
Initials: PXV

SUPPLY AIR TRUNK SIZE

	TRUNK	STATIC	ROUND	RECT			VELOCITY		TRUNK	STATIC	ROUND	RECT			VELOCITY
	CFM	PRESS.	DUCT	DUCT			(ft/min)		CFM	PRESS.	DUCT	DUCT			(ft/min)
TRUNK A	360	0.07	9.9	12	x	8	540	TRUNK G	0	0.00	0	0	x	8	0
TRUNK B	607	0.07	12	16	x	8	683	TRUNK H	0	0.00	0	0	x	8	0
TRUNK C	1046	0.07	14.7	26	x	8	724	TRUNK I	0	0.00	0	0	x	8	0
TRUNK D	434	0.06	11	14	x	8	558	TRUNK J	0	0.00	0	0	x	8	0
TRUNK E	828	0.06	14	22	x	8	677	TRUNK K	0	0.00	0	0	x	8	0
TRUNK F	0	0.00	0	0	x	8	0	TRUNK L	0	0.00	0	0	x	8	0

RETURN AIR TRUNK SIZE

	TRUNK CFM	STATIC PRESS.	ROUND DUCT	RECT DUCT		VELOCITY (ft/min)	
TRUNK O	0	0.06	0	0	x	8	0
TRUNK P	0	0.06	0	0	x	8	0
TRUNK Q	0	0.06	0	0	x	8	0
TRUNK R	0	0.06	0	0	x	8	0
TRUNK S	0	0.06	0	0	x	8	0
TRUNK T	0	0.06	0	0	x	8	0
TRUNK U	0	0.06	0	0	x	8	0
TRUNK V	0	0.06	0	0	x	8	0
TRUNK W	140	0.06	7.2	8	x	8	315
TRUNK X	1504	0.06	17.6	28	x	12	645
TRUNK Y	825	0.06	14	22	x	8	675
TRUNK Z	420	0.06	10.9	14	x	8	540
DROP	1504	0.06	17.6	24	x	14	645

RETURN AIR #	1	2	3	4	5	6	7									BR
AIR VOLUME	0	0	0	0	0	0	0	0	0	0	0	0	0	0	0	239
PLENUM PRESSURE	0.15	0.15	0.15	0.15	0.15	0.15	0.15	0.15	0.15	0.15	0.15	0.15	0.15	0.15	0.15	0.15
ACTUAL DUCT LGH.	47	44	48	59	53	21	57	1	1	1	1	1	1	1	1	14
EQUIVALENT LENGTH	165	155	145	175	195	145	150	0	0	0	0	0	0	0	0	135
TOTAL EFFECTIVE LH	212	199	193	234	248	166	207	1	1	1	1	1	1	1	1	149
ADJUSTED PRESSURE	0.07	0.07	0.08	0.06	0.06	0.09	0.07	14.80	14.80	14.80	14.80	14.80	14.80	14.80	14.80	0.10
ROUND DUCT SIZE	6.9	6.9	6.7	6.8	6.9	8.7	9.2	0	0	0	0	0	0	0	0	7.8
INLET GRILL SIZE	8	8	8	8	8	8	8	0	0	0	0	0	0	0	0	8
	X	X	X	X	X	X	X	X	X	X	X	X	X	X	X	X
INLET GRILL SIZE	14	14	14	14	14	30	30	0	0	0	0	0	0	0	0	24

CITY OF RICHMOND HILL
BUILDING DIVISION

05/01/2024

RECEIVED
Per: joshua.nabua

TYPE: ROSE 9
SITE NAME: TRINIGROUP

LO # 101733
WOB

RESIDENTIAL MECHANICAL VENTILATION DESIGN SUMMARY

COMBUSTION APPLIANCES		9.32.3.1(1)
a)	☒ Direct vent (sealed combustion) only	
b)	☐ Positive venting induced draft (except fireplaces)	
c)	☐ Natural draft, B-vent or induced draft gas fireplace	
d)	☐ Solid Fuel (including fireplaces)	
e)	☐ No Combustion Appliances	

HEATING SYSTEM	
☒ Forced Air	☐ Non Forced Air
☐ Electric Space Heat	

HOUSE TYPE		9.32.1(2)
☒ I	Type a) or b) appliance only, no solid fuel	
☐ II	Type I except with solid fuel (including fireplaces)	
☐ III	Any Type c) appliance	
☐ IV	Type I, or II with electric space heat	
☐	Other: Type I, II or IV no forced air	

SYSTEM DESIGN OPTIONS		O.N.H.W.P.
☐ 1	Exhaust only/Forced Air System	
☐ 2	HRV with Ducting/Forced Air System	
☒ 3	HRV Simplified/connected to forced air system	
☐ 4	HRV with Ducting/non forced air system	
☐	Part 6 Design	

TOTAL VENTILATION CAPACITY		9.32.3.3(1)
Basement + Master Bedroom	<u>2</u> @ 21.2 cfm	<u>42.4</u> cfm
Other Bedrooms	<u>3</u> @ 10.6 cfm	<u>31.8</u> cfm
Kitchen & Bathrooms	<u>6</u> @ 10.6 cfm	<u>63.6</u> cfm
Other Rooms	<u>6</u> @ 10.6 cfm	<u>63.6</u> cfm
Table 9.32.3.A. TOTAL		<u>201.4</u> cfm

PRINCIPAL VENTILATION CAPACITY REQUIRED		9.32.3.4.(1)
1 Bedroom	31.8	cfm
2 Bedroom	47.7	cfm
3 Bedroom	63.6	cfm
4 Bedroom	79.5	cfm
5 Bedroom	95.4	cfm
TOTAL		<u>79.5</u> cfm

SUPPLEMENTAL VENTILATION CAPACITY		9.32.3.5.
Total Ventilation Capacity	<u>201.4</u>	cfm
Less Principal Ventil. Capacity	<u>79.5</u>	cfm
Required Supplemental Capacity	<u>121.9</u>	cfm

PRINCIPAL EXHAUST FAN CAPACITY	
Model:	VANEE V150H
Location:	BSMT
<u>79.5</u> cfm	☒ HVI Approved

PRINCIPAL EXHAUST HEAT LOSS CALCULATION			
CFM	ΔT °F	FACTOR	% LOSS
79.5 CFM	X 78 F	X 1.08	X 0.25

SUPPLEMENTAL FANS		BY INSTALLING CONTRACTOR	
Location	Model	cfm	HVI
ENS	BY INSTALLING CONTRACTOR	50	☒
ENS-2	BY INSTALLING CONTRACTOR	50	☒
ENS-4	BY INSTALLING CONTRACTOR	50	☒

HEAT RECOVERY VENTILATOR		9.32.3.11.
Model:	VANEE V150H	
<u>150</u> cfm high	<u>35</u> cfm low	
<u>75</u> % Sensible Efficiency	☒ HVI Approved	
@ 32 deg F (0 deg C)		

LOCATION OF INSTALLATION	
Lot:	Concession
Township	Plan:
Address	
Roll #	Building Permit #

BUILDER:	
GREENPARK HOMES	
Name:	
Address:	City of Richmond Hill
City:	Building Division
Telephone #:	
Fax #:	

INSTALLING CONTRACTOR	
Initials:	PXV
Name:	
Address:	
City:	
Telephone #:	Fax #:

DESIGNER CERTIFICATION	
I hereby certify that this ventilation system has been designed in accordance with the Ontario Building Code.	
Name:	HVAC Designs Ltd.
Signature:	<i>Michael O'Rourke</i>
HRAI #	001820
Date:	June-23

I REVIEW AND TAKE RESPONSIBILITY FOR THE DESIGN WORK AND AM QUALIFIED IN THE APPROPRIATE CATEGORY AS AN "OTHER DESIGNER" UNDER DIVISION C, 3.2.5 OF THE BUILDING CODE.

INDIVIDUAL BCIN: 19669

MICHAEL O'ROURKE


Michael O'Rourke

CITY OF RICHMOND HILL
BUILDING DIVISION

05/01/2024

RECEIVED
Per: joshua.nabua

CSA F280-12 Residential Heat Loss and Heat Gain Calculations	
Formula Sheet (For Air Leakage / Ventilation Calculation)	
LO#: 101733		Model: ROSE 9		Builder: GREENPARK HOMES	
				Date: 6/29/2023	
Volume Calculation			Air Change & Delta T Data	
House Volume <table border="1" style="width:100%; border-collapse: collapse;"> <thead> <tr> <th>Level</th> <th>Floor Area (ft²)</th> <th>Floor Height (ft)</th> <th>Volume (ft³)</th> </tr> </thead> <tbody> <tr><td>Bsmt</td><td>1606</td><td>9</td><td>14454</td></tr> <tr><td>First</td><td>1606</td><td>10</td><td>16060</td></tr> <tr><td>Second</td><td>1860</td><td>9</td><td>16740</td></tr> <tr><td>Third</td><td>0</td><td>9</td><td>0</td></tr> <tr><td>Fourth</td><td>0</td><td>9</td><td>0</td></tr> <tr><td colspan="3" style="text-align: right;">Total:</td><td>47,254.0 ft³</td></tr> <tr><td colspan="3" style="text-align: right;">Total:</td><td>1338.1 m³</td></tr> </tbody> </table>			Level	Floor Area (ft²)	Floor Height (ft)	Volume (ft³)	Bsmt	1606	9	14454	First	1606	10	16060	Second	1860	9	16740	Third	0	9	0	Fourth	0	9	0	Total:			47,254.0 ft³	Total:			1338.1 m³	<table border="1" style="width:100%; border-collapse: collapse;"> <tr> <td style="width: 80%;">WINTER NATURAL AIR CHANGE RATE</td> <td style="width: 20%;">0.380</td> </tr> <tr> <td>SUMMER NATURAL AIR CHANGE RATE</td> <td>0.118</td> </tr> </table> <table border="1" style="width:100%; border-collapse: collapse;"> <tr> <th colspan="5" style="text-align: center;">Design Temperature Difference</th> </tr> <tr> <th></th> <th>Tin °C</th> <th>Tout °C</th> <th>ΔT °C</th> <th>ΔT °F</th> </tr> <tr> <td>Winter DTDh</td> <td>22</td> <td>-21</td> <td>43</td> <td>78</td> </tr> <tr> <td>Summer DTDc</td> <td>24</td> <td>31</td> <td>7</td> <td>13</td> </tr> </table>			WINTER NATURAL AIR CHANGE RATE	0.380	SUMMER NATURAL AIR CHANGE RATE	0.118	Design Temperature Difference						Tin °C	Tout °C	ΔT °C	ΔT °F	Winter DTDh	22	-21	43	78	Summer DTDc	24	31	7	13
Level	Floor Area (ft²)	Floor Height (ft)	Volume (ft³)	
Bsmt	1606	9	14454	
First	1606	10	16060	
Second	1860	9	16740	
Third	0	9	0	
Fourth	0	9	0	
Total:			47,254.0 ft³	
Total:			1338.1 m³	
WINTER NATURAL AIR CHANGE RATE	0.380	
SUMMER NATURAL AIR CHANGE RATE	0.118	
Design Temperature Difference	
	Tin °C	Tout °C	ΔT °C	ΔT °F	
Winter DTDh	22	-21	43	78	
Summer DTDc	24	31	7	13	
5.2.3.1 Heat Loss due to Air Leakage			6.2.6 Sensible Gain due to Air Leakage	
$HL_{airb} = LR_{airh} \times \frac{V_b}{3.6} \times DTD_h \times 1.2$ 0.380 x 371.69 x 43 °C x 1.2 = 7324 W = 24988 Btu/h			$HG_{salb} = LR_{airc} \times \frac{V_b}{3.6} \times DTD_c \times 1.2$ = 0.118 x 371.69 x 7 °C x 1.2 = 376 W = 1281 Btu/h	
5.2.3.2 Heat Loss due to Mechanical Ventilation			6.2.7 Sensible heat Gain due to Ventilation	
$HL_{vairb} = PVC \times DTD_h \times 1.08 \times (1 - E)$ 80 CFM x 78 °F x 1.08 x 0.25 = 1670 Btu/h			$HL_{vairb} = PVC \times DTD_h \times 1.08 \times (1 - E)$ 80 CFM x 13 °F x 1.08 x 0.25 = 275 Btu/h	
5.2.3.3 Calculation of Air Change Heat Loss for Each Room (Floor Multiplier Section)	
$HL_{airr} = Level\ Factor \times HL_{airbv} \times \{(HL_{agcr} + HL_{bgcr}) \div (HL_{agclevel} + HL_{bgclevel})\}$ <table border="1" style="width:100%; border-collapse: collapse;"> <thead> <tr> <th>Level</th> <th>Level Factor (LF)</th> <th>HLairve Air Leakage + Ventilation Heat Loss (Btu/h)</th> <th>Level Conductive Heat Loss: (HL_{clevel})</th> <th>Air Leakage Heat Loss Multiplier (LF x HLairbv / HLlevel)</th> </tr> </thead> <tbody> <tr><td>1</td><td>0.5</td><td rowspan="5" style="text-align: center; vertical-align: middle;">24,988</td><td>8,760</td><td>1.426</td></tr> <tr><td>2</td><td>0.3</td><td>13,733</td><td>0.546</td></tr> <tr><td>3</td><td>0.2</td><td>15,556</td><td>0.321</td></tr> <tr><td>4</td><td>0</td><td>0</td><td>0.000</td></tr> <tr><td>5</td><td>0</td><td>0</td><td>0.000</td></tr> </tbody> </table>						Level	Level Factor (LF)	HLairve Air Leakage + Ventilation Heat Loss (Btu/h)	Level Conductive Heat Loss: (HL _{clevel})	Air Leakage Heat Loss Multiplier (LF x HLairbv / HLlevel)	1	0.5	24,988	8,760	1.426	2	0.3	13,733	0.546	3	0.2	15,556	0.321	4	0	0	0.000	5	0	0	0.000																														
Level	Level Factor (LF)	HLairve Air Leakage + Ventilation Heat Loss (Btu/h)	Level Conductive Heat Loss: (HL _{clevel})	Air Leakage Heat Loss Multiplier (LF x HLairbv / HLlevel)	
1	0.5	24,988	8,760	1.426	
2	0.3		13,733	0.546	
3	0.2		15,556	0.321	
4	0		0	0.000	
5	0		0	0.000	
*HLairbv = Air leakage heat loss + ventilation heat loss *For a balanced or supply only ventilation system HLairve = 0	

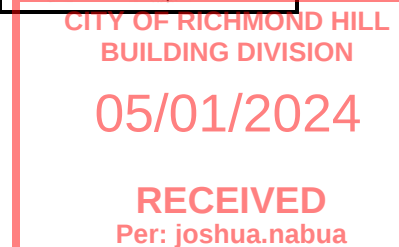Michael O'Rourke
BCIN# 19669


HEAT LOSS AND GAIN SUMMARY SHEET

MODEL: ROSE 9	WOB	BUILDER: GREENPARK HOMES
SFQT: 3466	LO# 101733	SITE: TRINIGROUP

DESIGN ASSUMPTIONS

HEATING	°F	COOLING	°F
OUTDOOR DESIGN TEMP.	-6	OUTDOOR DESIGN TEMP.	88
INDOOR DESIGN TEMP.	72	INDOOR DESIGN TEMP. (MAX 75°F)	75
		WINDOW SHGC	0.50

BUILDING DATA

ATTACHMENT:	DETACHED	# OF STORIES (+BASEMENT):	3
FRONT FACES:	EAST	ASSUMED (Y/N):	Y
AIR CHANGES PER HOUR:	3.57	ASSUMED (Y/N):	Y
AIR TIGHTNESS CATEGORY:	AVERAGE	ASSUMED (Y/N):	Y
WIND EXPOSURE:	SHELTERED	ASSUMED (Y/N):	Y
HOUSE VOLUME (ft³):	47254.0	ASSUMED (Y/N):	Y
INTERNAL SHADING:	BLINDS/CURTAINS	ASSUMED OCCUPANTS:	5
INTERIOR LIGHTING LOAD (Btu/h/ft²):	1.27	DC BRUSHLESS MOTOR (Y/N):	Y
FOUNDATION CONFIGURATION	BCIN_1	DEPTH BELOW GRADE:	6.0 ft
LENGTH: 50.0 ft	WIDTH: 42.0 ft	EXPOSED PERIMETER:	131.0 ft
WOB INSULATION CONFIGURATION	SCB_9	WOB EXPOSED PERIMETER	53.0 ft

2012 OBC - COMPLIANCE PACKAGE

Component

Compliance Package A1

	Nominal	Min. Eff.
Ceiling with Attic Space Minimum RSI (R)-Value	60	59.22
Ceiling Without Attic Space Minimum RSI (R)-Value	31	27.65
Exposed Floor Minimum RSI (R)-Value	31	29.80
Walls Above Grade Minimum RSI (R)-Value	22	17.03
Basement Walls Minimum RSI (R)-Value	20 ci	21.12
Below Grade Slab Entire surface > 600 mm below grade Minimum RSI (R)-Value	-	-
Edge of Below Grade Slab ≤ 600 mm Below Grade Minimum RSI (R)-Value	10	10
Heated Slab or Slab ≤ 600 mm below grade Minimum RSI (R)-Value	10	11.13
Windows and Sliding Glass Doors Maximum U-Value	0.28	-
Skylights Maximum U-Value	0.49	-
Space Heating Equipment Minimum AFUE	96%	-
HRV/ERV Minimum Efficiency	75%	-
Domestic Hot Water Heater Minimum EF	0.8	-

INDIVIDUAL BCIN: 19669
MICHAEL O'ROURKE




CITY OF RICHMOND HILL
BUILDING DIVISION

05/01/2024

RECEIVED
Per: joshua.nabua

Residential Foundation Thermal Load Calculator

Supplemental tool for CAN/CSA-F280

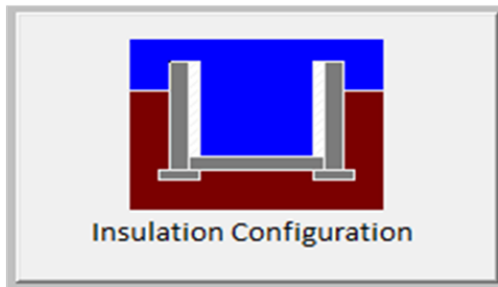Weather Station Description		
Province:	Ontario	
Region:	Richmond Hill	
Site Description		
Soil Conductivity:	Normal conductivity: dry sand, loam, clay	
Water Table:	Normal (7-10 m, 23-33 ft)	
Foundation Dimensions		
Floor Length (m):	4.6	
Floor Width (m):	12.8	
Exposed Perimeter (m):	39.9	
Wall Height (m):	2.7	
Depth Below Grade (m):	1.58	
Window Area (m ²):	0.4	
Door Area (m ²):	0.0	
Radiant Slab		
Heated Fraction of the Slab:	0	
Fluid Temperature (°C):	33	
Design Months		
Heating Month	1	
Foundation Loads		
Heating Load (Watts):		835

TYPE: ROSE 9
LO# 101733

WOB

Michael O'Rourke BCIN #19669


CITY OF RICHMOND HILL
BUILDING DIVISION

05/01/2024


RECEIVED
Per: joshua.nabua

Residential Slab on Grade Thermal Load Calculator

Supplemental tool for CAN/CSA-F280

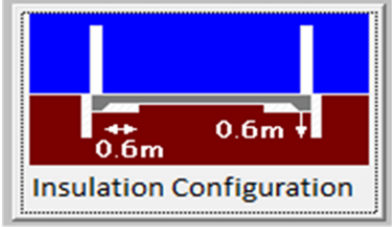Weather Station Description		
Province:	Ontario	
Region:	Richmond Hill	
Site Description		
Soil Conductivity:	Normal conductivity: dry sand, loam, clay	
Water Table:	Normal (7-10 m, 23-33 ft)	
Foundation Dimensions		
Length (m):	1.5	
Width (m):	13.1	
Exposed Perimeter (m):	16.2	
Radiant Slab		
Heated Fraction of the Slab:	0	
Fluid Temperature (°C):	33	
Design Months		
Heating Month	1	
Results		
Heating Load (Watts):		225

TYPE: ROSE 9
LO# 101733

WOB

Michael O'Rourke BCIN# 19669

CITY OF RICHMOND HILL
BUILDING DIVISION

05/01/2024


RECEIVED
Per: joshua.nabua

Air Infiltration Residential Load Calculator

Supplemental tool for CAN/CSA-F280

Weather Station Description				
Province:	Ontario			
Region:	Richmond Hill			
Weather Station Location:	Open flat terrain, grass			
Anemometer height (m):	10			
Local Shielding				
Building Site:	Suburban, forest			
Walls:	Heavy			
Flue:	Heavy			
Highest Ceiling Height (m):	8.53			
Building Configuration				
Type:	Detached			
Number of Stories:	Two			
Foundation:	Full			
House Volume (m ³):	1338.1			
Air Leakage/Ventilation				
Air Tightness Type:	Present (1961-) (3.57 ACH)			
Custom BDT Data:	ELA @ 10 Pa.	1783.7 cm ²		
	3.57	ACH @ 50 Pa		
Mechanical Ventilation (L/s):	Total Supply	Total Exhaust		
	37.5	37.5		
Flue Size				
Flue #:	#1	#2	#3	#4
Diameter (mm):	0	0	0	0
Natural Infiltration Rates				
Heating Air Leakage Rate (ACH/H):	0.380			
Cooling Air Leakage Rate (ACH/H):	0.118			

TYPE: ROSE 9
LO# 101733


WOB

Michael O'Rourke BCIN# 19669

CITY OF RICHMOND HILL
BUILDING DIVISION

05/01/2024


RECEIVED
Per: joshua.nabua

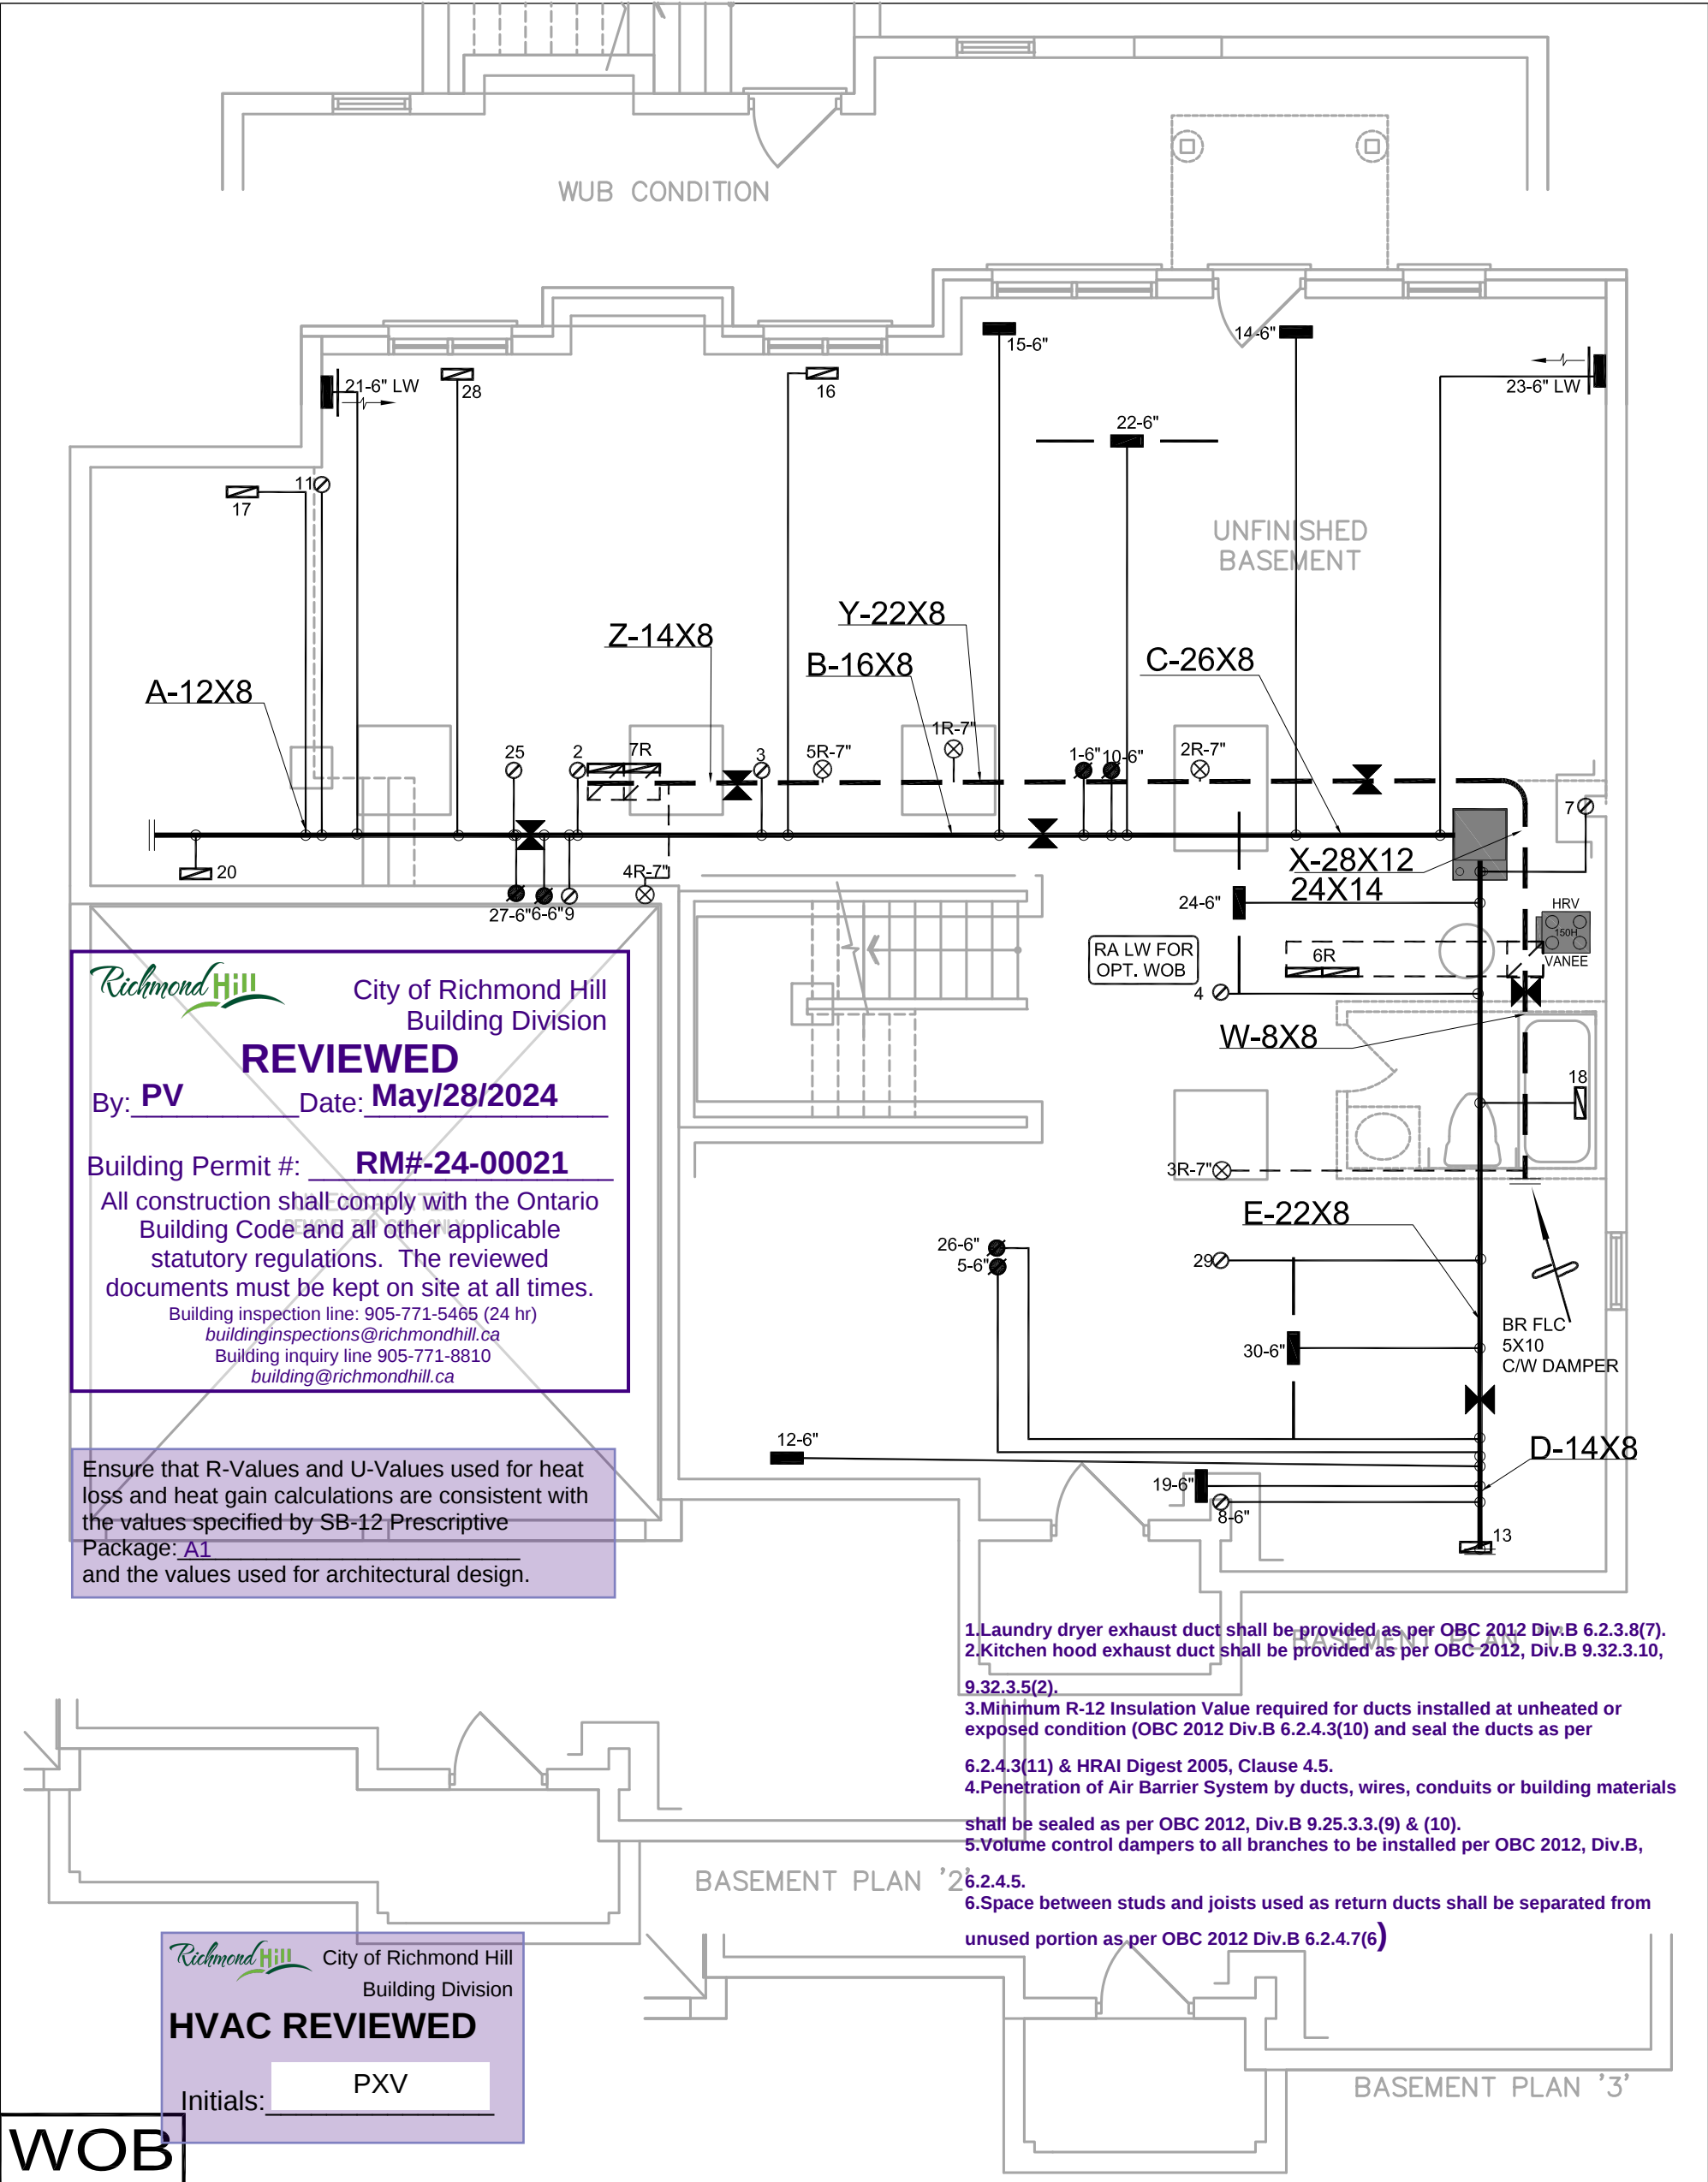

1. Laundry dryer exhaust duct shall be provided as per OBC 2012 Div.B 6.2.3.8(7).
2. Kitchen hood exhaust duct shall be provided as per OBC 2012, Div.B 9.32.3.10, 9.32.3.5(2).
3. Minimum R-12 Insulation Value required for ducts installed at unheated or exposed condition (OBC 2012 Div.B 6.2.4.3(10) and seal the ducts as per 6.2.4.3(11) & HRAI Digest 2005, Clause 4.5.
4. Penetration of Air Barrier System by ducts, wires, conduits or building materials shall be sealed as per OBC 2012, Div.B 9.25.3.3.(9) & (10).
5. Volume control dampers to all branches to be installed per OBC 2012, Div.B, 6.2.4.5.
6. Space between studs and joists used as return ducts shall be separated from unused portion as per OBC 2012 Div.B 6.2.4.7(6)

HVAC LEGEND								3.		
SYMBOL	DESCRIPTION	SYMBOL	DESCRIPTION	SYMBOL	DESCRIPTION	SYMBOL	DESCRIPTION	2.		
	SUPPLY AIR GRILLE		6" SUPPLY AIR BOOT ABOVE		14"x8" RETURN AIR GRILLE		RETURN AIR STACK ABOVE	1.		
	SUPPLY AIR GRILLE 6" BOOT		SUPPLY AIR STACK FROM 2nd FLOOR		30"x8" RETURN AIR GRILLE		RETURN AIR STACK 2nd FLOOR	No.	Description	Date
	SUPPLY AIR BOOT ABOVE		6" SUPPLY AIR STACK 2nd FLOOR		FRA- FLOOR RETURN AIR GRILLE		REDUCER	REVISIONS		
ALL DRAWINGS, CALCULATIONS AND SPECIFICATIONS ARE THE PROPERTY OF HVAC DESIGNS LTD.© AND MAY NOT BE REPRODUCED, MODIFIED OR ALTERED WITHOUT EXPRESSED WRITTEN CONSENT. THE DRAWINGS ARE DATED AND USE OF THESE DRAWINGS AFTER ONE YEAR FROM THE DATED NOTED IS NOT AUTHORIZED. CONTRACTOR SHALL CHECK ALL CONDITIONS BEFORE PROCEEDING WITH WORK. LATEST MUNICIPAL APPROVED DRAWINGS ONLY TO BE USED DURING INSTALLATION OF HEATING SYSTEM. HVAC DESIGNS LTD. IS NOT LIABLE FOR ANY CLAIMS ARISING FROM UNAUTHORIZED USE OF THE DRAWINGS OR FROM ANY CHANGES TO ACCEPTED STANDARDS AND/OR THE ONTARIO BUILDING CODE.						I Michael O'Rourke have reviewed and take responsibility for the design work and am qualified under division C.3.2.5 of the building code.		Michael O'Rourke BCIN # 19669 HVAC Designs Ltd.		
Client		GREEN PARK HOMES		Project Name		TRINIGROUP RICHMOND HILL, ONTARIO		WOB ROSE 9		3466 sqft
375 Finley Ave. Suite 202 - Ajax, Ontario L1S 2E2 Tel. 905.619.2300 - 905.420.5300 Fax 905.619.2375 Email: info@hvacdesigns.ca Web: www.hvacdesigns.ca Specializing in Residential Mechanical Design Services		Installation to comply with the latest Ontario Building Code. All supply branch outlets shall be equipped with a manual balancing damper. Ductwork which passes through the garage or unheated spaces shall be adequately insulated and be gas-proofed.		HEAT LOSS 65240 BTU/H UNIT DATA		# OF RUNS S/A R/A FANS		Sheet Title		
MAKE GOODMAN		MODEL GMEC960804CNA		INPUT 80 MBTU/H		OUTPUT 76.8 MBTU/H		BASEMENT HEATING LAYOUT		
COOLING 3.5 TONS		FAN SPEED 1504 cfm @ 0.6" w.c.		3RD FLOOR		2ND FLOOR 15		CITY OF RICHMOND HILL BUILDING DIVISION		
				1ST FLOOR 10		BASEMENT 5		Date JUNE/2023		
								Scale 3/16" = 1'-0"		
								BCIN# 19669		
								LO# 101733		
								Per: joshua.nabua		

7. Combustion air supply shall be provided to the furnace and hot water tank.
- 8.HRV installation, testing, startup and commissioning shall be in compliance with OBC 2012, Div.B 9.32.3.11, 9.32.3.11(7)&(10)
9. HRV duct connection shall be in compliance with OBC 2012 Div.B 9.32.3.6(3) & 9.32.3.4(7).
10. Supply air grill at finished basement shall be at low level. Return air grill for finished or unfinished basement shall be at low level. HRAI digest 2005, clause 7.7(3).

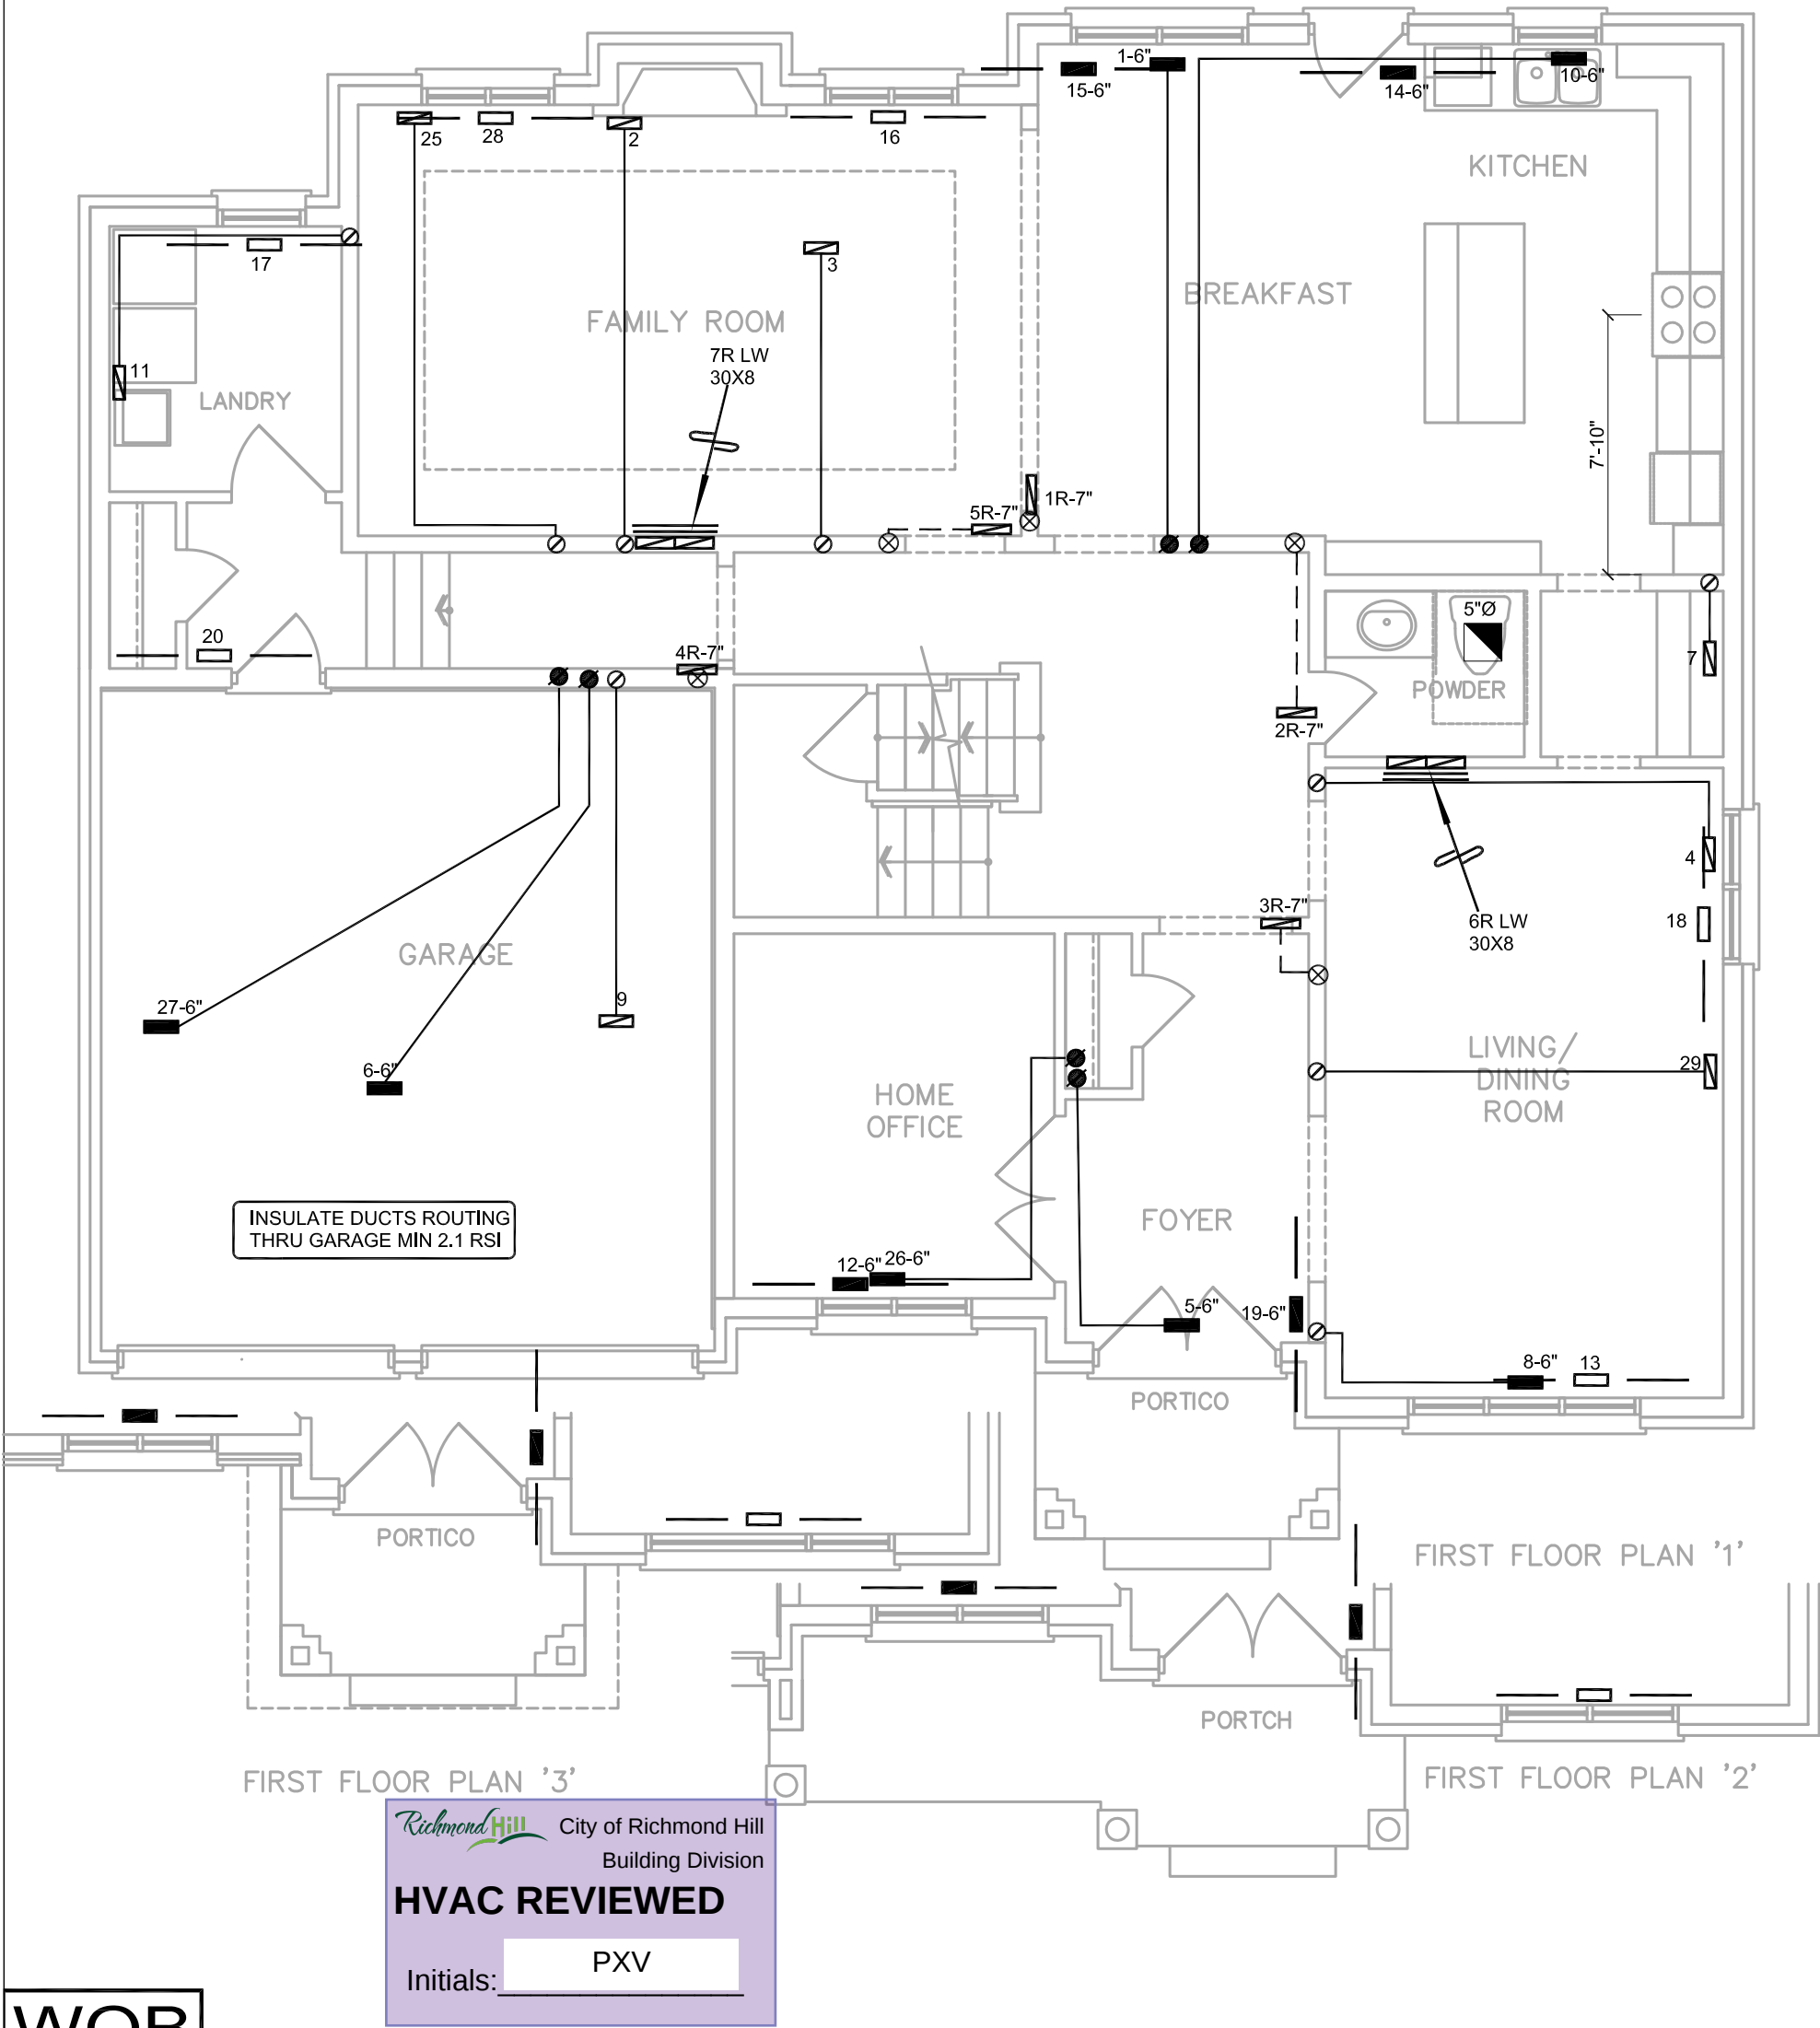


WOB

HVAC LEGEND								3.		
SYMBOL	DESCRIPTION	SYMBOL	DESCRIPTION	SYMBOL	DESCRIPTION	SYMBOL	DESCRIPTION	2.		
	SUPPLY AIR GRILLE		6" SUPPLY AIR BOOT ABOVE		14"x8" RETURN AIR GRILLE		RETURN AIR STACK ABOVE	1.		
	SUPPLY AIR GRILLE 6" BOOT		SUPPLY AIR STACK FROM 2nd FLOOR		30"x8" RETURN AIR GRILLE		RETURN AIR STACK 2nd FLOOR	No.	Description	Date
	SUPPLY AIR BOOT ABOVE		6" SUPPLY AIR STACK 2nd FLOOR		FRA- FLOOR RETURN AIR GRILLE		REDUCER	REVISIONS		
ALL DRAWINGS, CALCULATIONS AND SPECIFICATIONS ARE THE PROPERTY OF HVAC DESIGNS LTD.© AND MAY NOT BE REPRODUCED, MODIFIED OR ALTERED WITHOUT EXPRESSED WRITTEN CONSENT. THE DRAWINGS ARE DATED AND USE OF THESE DRAWINGS AFTER ONE YEAR FROM THE DATED NOTED IS NOT AUTHORIZED. CONTRACTOR SHALL CHECK ALL CONDITIONS BEFORE PROCEEDING WITH WORK. LATEST MUNICIPAL APPROVED DRAWINGS ONLY TO BE USED DURING INSTALLATION OF HEATING SYSTEM. HVAC DESIGNS LTD. IS NOT LIABLE FOR ANY CLAIMS ARISING FROM UNAUTHORIZED USE OF THE DRAWINGS OR FROM ANY CHANGES TO ACCEPTED STANDARDS AND/OR THE ONTARIO BUILDING CODE.						I Michael O'Rourke have reviewed and take responsibility for the design work and am qualified under division C.3.2.5 of the building code.		Michael O'Rourke BCIN # 19669 HVAC Designs Ltd.		PACKAGE A1
Client GREEN PARK HOMES		375 Finley Ave. Suite 202 - Ajax, Ontario L1S 2E2 Tel. 905.619.2300 - 905.420.5300 Fax 905.619.2375 Email: info@hvacdsgns.ca Web: www.hvacdesigns.ca Specializing in Residential Mechanical Design Services Installation to comply with the latest Ontario Building Code. All supply branch outlets shall be equipped with a manual balancing damper. Ductwork which passes through the garage or unheated spaces shall be adequately insulated and be gas-proofed.				Sheet Title FIRST FLOOR HEATING LAYOUT		CITY OF RICHMOND HILL BUILDING DIVISION		
Project Name TRINIGROUP RICHMOND HILL, ONTARIO						Date JUNE/2023				
WOB ROSE 9						Scale 3/16" = 1'-0"				
						BCIN# 19669				
						LO# 101733				
3466 sqft										

13.Exterior insulation effective R-Value for wall, roof or exposed floor shall be maintained at the respective location where duct or sanitary pipes are routed inside exterior envelope.

14. Return air intake shall be provided as recommended in HRAI Digest 2005 Section 4.7 Return air inlet should be positioned so that short circuiting of supply air is avoided. A high and low wall return air combination shall be provided when a combined cooling & heating system is installed.

15. For simplified HRV/ERV installation, with stale air and fresh air connected to return air plenum, stale air intake and fresh air supply shall be separated minimum 3' or as recommended by HRV/ERV Manufacturer.

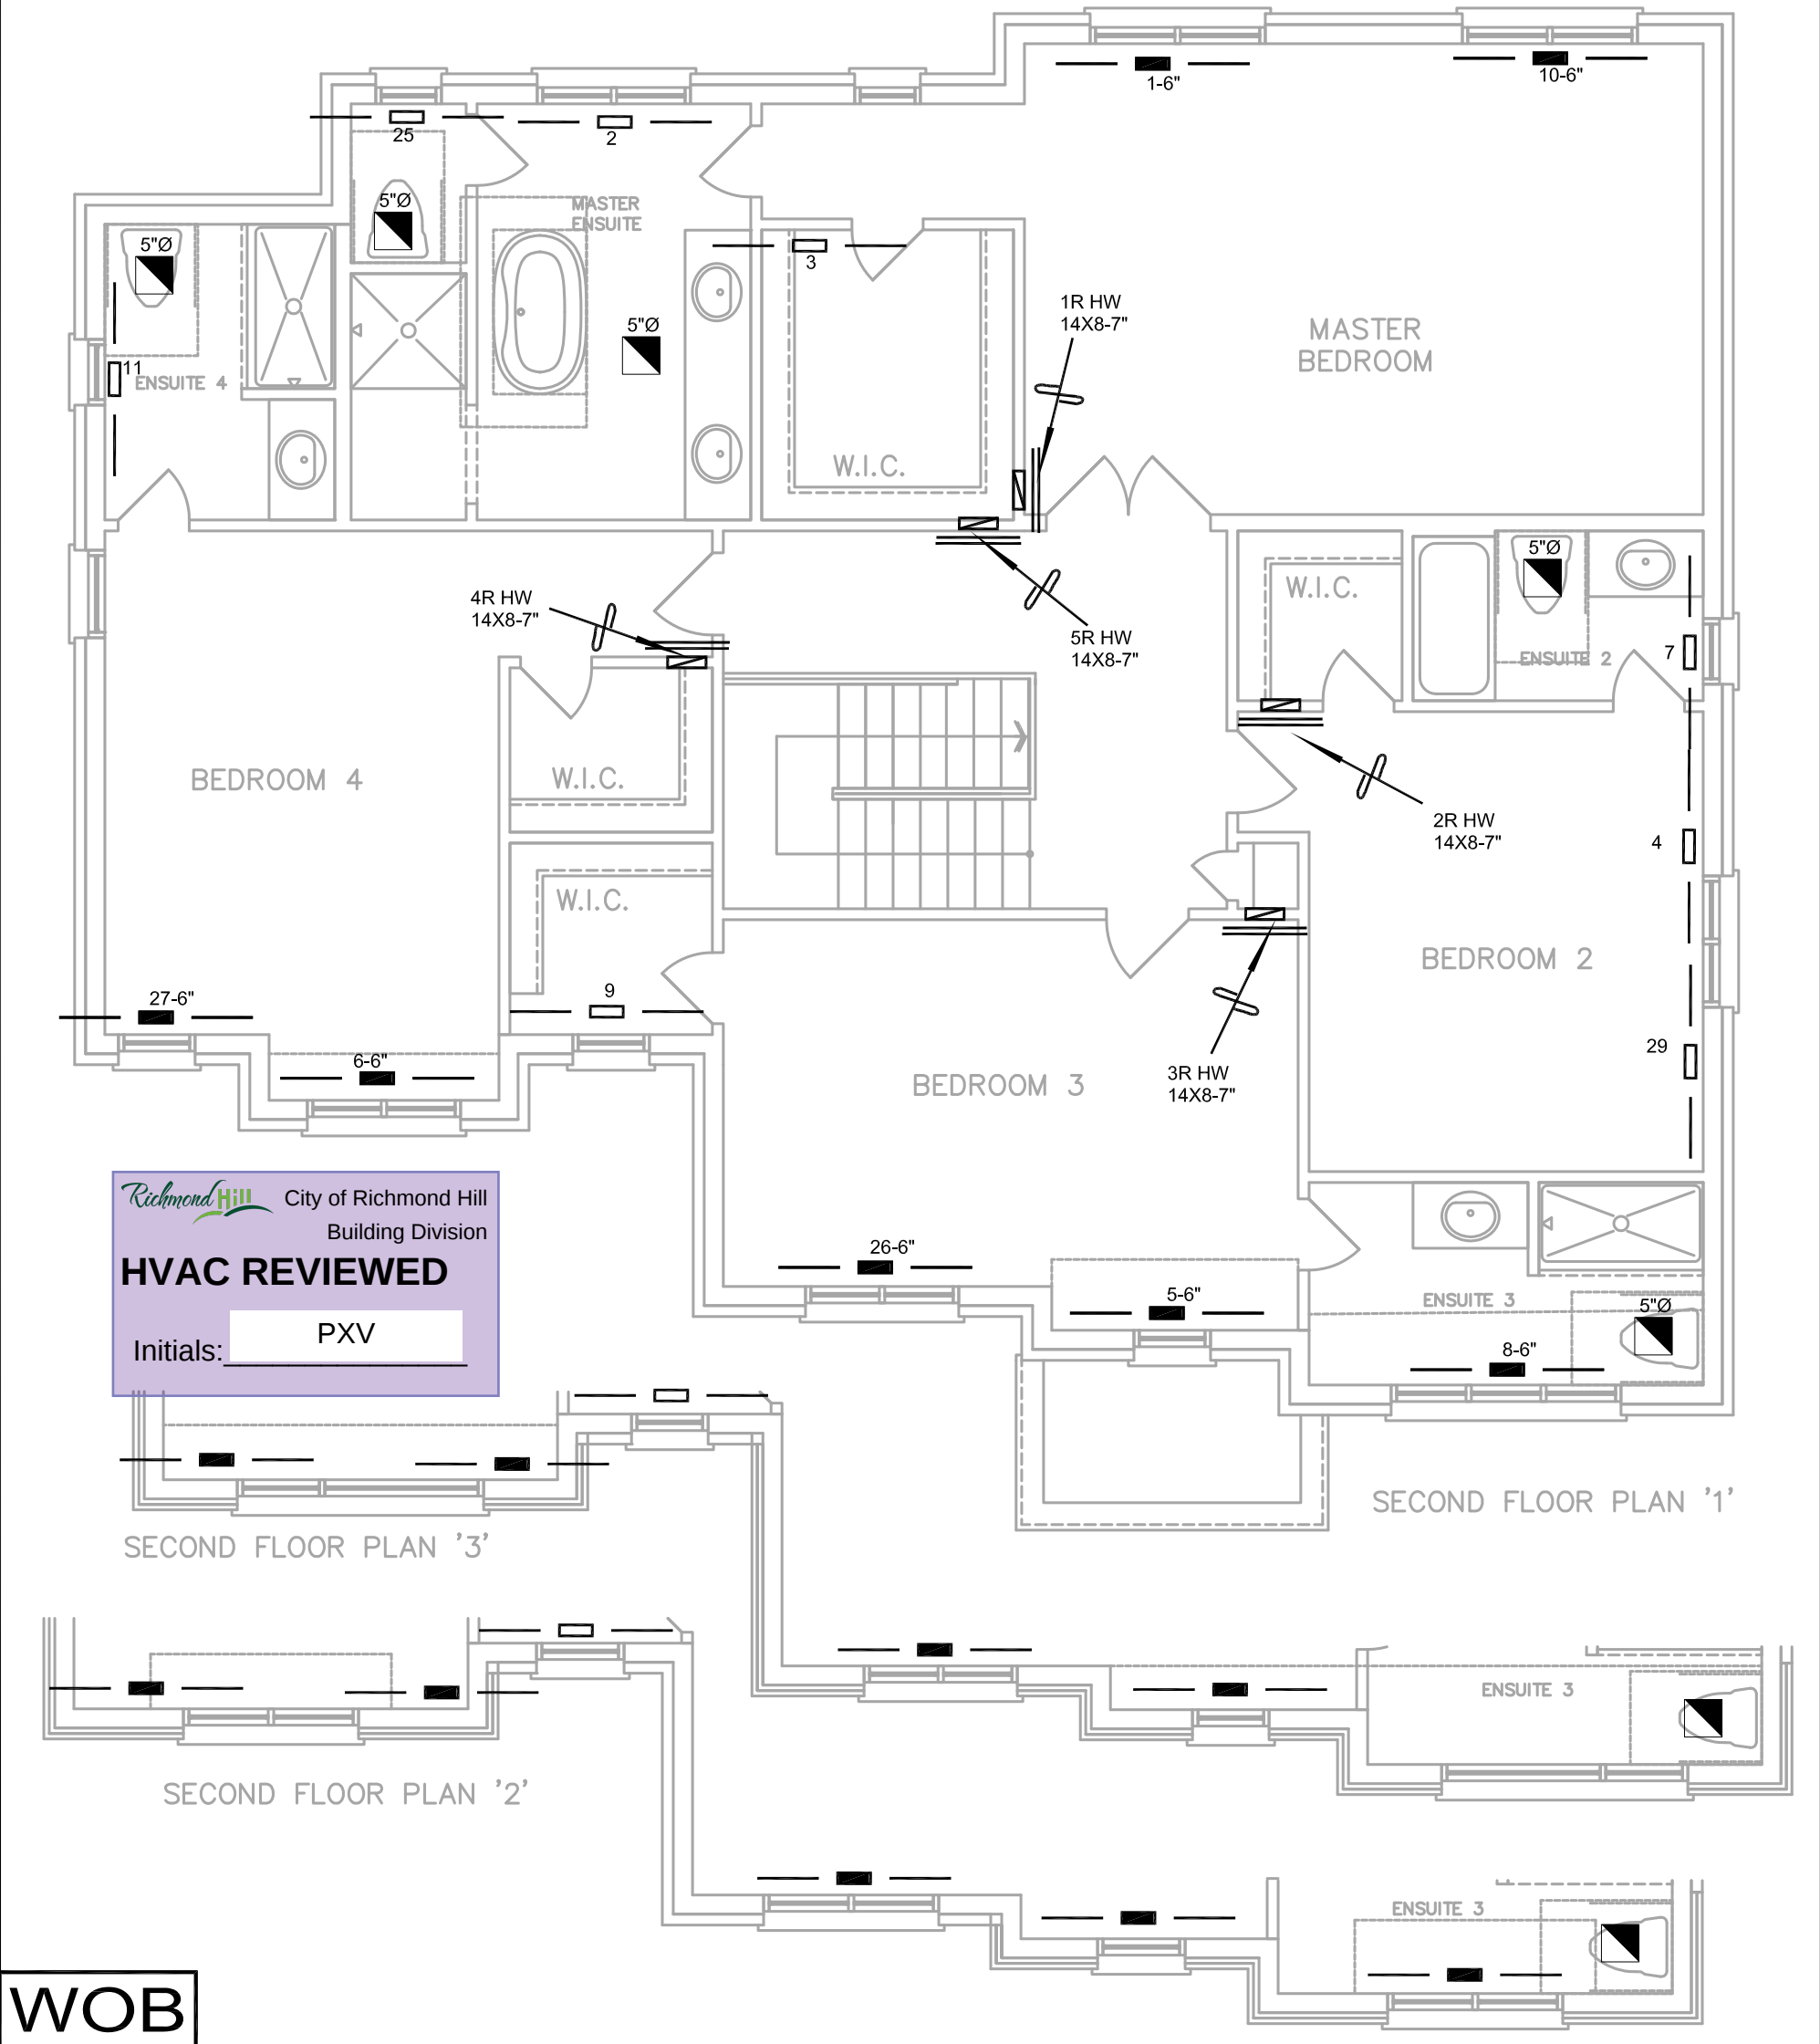

WOB

HVAC LEGEND								3.		
SYMBOL	DESCRIPTION	SYMBOL	DESCRIPTION	SYMBOL	DESCRIPTION	SYMBOL	DESCRIPTION	2.		
	SUPPLY AIR GRILLE		6" SUPPLY AIR BOOT ABOVE		14"x8" RETURN AIR GRILLE		RETURN AIR STACK ABOVE	1.		
	SUPPLY AIR GRILLE 6" BOOT		SUPPLY AIR STACK FROM 2nd FLOOR		30"x8" RETURN AIR GRILLE		RETURN AIR STACK 2nd FLOOR	No.	Description	Date
	SUPPLY AIR BOOT ABOVE		6" SUPPLY AIR STACK 2nd FLOOR		FRA- FLOOR RETURN AIR GRILLE		REDUCER	REVISIONS		
ALL DRAWINGS, CALCULATIONS AND SPECIFICATIONS ARE THE PROPERTY OF HVAC DESIGNS LTD.© AND MAY NOT BE REPRODUCED, MODIFIED OR ALTERED WITHOUT EXPRESSED WRITTEN CONSENT. THE DRAWINGS ARE DATED AND USE OF THESE DRAWINGS AFTER ONE YEAR FROM THE DATED NOTED IS NOT AUTHORIZED. CONTRACTOR SHALL CHECK ALL CONDITIONS BEFORE PROCEEDING WITH WORK. LATEST MUNICIPAL APPROVED DRAWINGS ONLY TO BE USED DURING INSTALLATION OF HEATING SYSTEM. HVAC DESIGNS LTD. IS NOT LIABLE FOR ANY CLAIMS ARISING FROM UNAUTHORIZED USE OF THE DRAWINGS OR FROM ANY CHANGES TO ACCEPTED STANDARDS AND/OR THE ONTARIO BUILDING CODE.								I Michael O'Rourke have reviewed and take responsibility for the design work and am qualified under division C.3.2.5 of the building code.		
Client								 Michael O'Rourke BCIN # 19669 HVAC Designs Ltd.		
GREEN PARK HOMES								PACKAGE A1		
Project Name								Sheet Title		
TRINIGROUP								SECOND FLOOR		
RICHMOND HILL, ONTARIO								HEATING		
WOB								CITY OF RICHMOND HILL BUILDING DIVISION		
ROSE 9								Date		
3466 sqft								JUNE/2023		
								Scale		
								3/16" = 1'-0"		
								BCIN# 19669		
								LO# 101733		
								Per: joshua.nabua		