

SITE NAME: TRINIGROUP		BUILDER: GREENPARK HOMES		TYPE: ROSE 9A		GFA: 3315		DATE: Dec-23 LO# 103548		WINTER NATURAL AIR CHANGE RATE 0.352		HEAT LOSS ΔT °F. 78		CSA-F280-12	
										SUMMER NATURAL AIR CHANGE RATE 0.110		HEAT GAIN ΔT °F. 13		SB-12 PACKAGE A1	
ROOM USE	EXP. WALL	CLG. HT.	FACTORS	MBR	ENS	WIC	BED-2	BED-3	BED-4	ENS-2	ENS-3	WIC-3	ENS-4	ENS-WC	
				45	8	0	11	26	34	9	22	5	17	8	
				9	9	9	9	9	9	9	9	9	9	9	
GRS.WALL AREA	LOSS	GAIN		405	72	0	99	234	306	81	198	45	153	72	
GLAZING	LOSS	GAIN		LOSS	GAIN	LOSS	GAIN	LOSS	GAIN	LOSS	GAIN	LOSS	GAIN	LOSS	GAIN
NORTH	21.8	16.0	0	0	0	0	0	0	0	8	174	128	0	0	0
EAST	21.8	41.6	0	0	0	0	0	0	0	48	1046	1994	12	261	499
SOUTH	21.8	24.9	0	0	0	0	0	0	0	0	0	0	0	0	0
WEST	21.8	41.6	56	1220	2327	18	392	748	0	0	0	0	0	0	0
SKYLT.	38.1	101.5	0	0	0	0	0	0	0	0	0	0	0	0	0
DOORS	20.5	3.4	0	0	0	0	0	0	0	0	0	0	0	0	0
NET EXPOSED WALL	4.6	0.8	349	1594	262	54	247	41	81	370	61	194	886	146	245
NET EXPOSED BSMT WALL ABOVE GR	3.7	0.6	0	0	0	0	0	0	0	0	0	0	0	0	0
EXPOSED CLG	1.3	0.6	421	553	247	150	197	88	76	100	45	218	286	128	266
NO ATTIC EXPOSED CLG	2.8	1.3	0	0	0	0	0	0	0	0	0	0	0	0	0
EXPOSED FLOOR	2.6	0.4	0	0	0	25	65	11	0	0	0	0	0	0	0
BASEMENT/CRAWL HEAT LOSS			0			0			0			0			0
SLAB ON GRADE HEAT LOSS			0			0			0			0			0
SUBTOTAL HT LOSS			3367			901			1049			2135			3520
SUB TOTAL HT GAIN			2837			887			477			1977			2818
LEVEL FACTOR / MULTIPLIER	0.20	0.28		0.20	0.28		0.20	0.28		0.20	0.28		0.20	0.28	
AIR CHANGE HEAT LOSS			934			250			291			592			976
AIR CHANGE HEAT GAIN			168			53			28			117			167
DUCT LOSS			0			115			0			450			167
DUCT GAIN			0			94			0			383			0
HEAT GAIN PEOPLE	240		2	480	0	0	0	0	1	240	1	240	1	240	0
HEAT GAIN APPLIANCES/LIGHTS			607			0			607			607			607
TOTAL HT LOSS BTU/H			4301			1266			1339			2727			4946
TOTAL HT GAIN x 1.3 BTU/H			5319			1344			61			1757			3823

ROOM USE	EXP. WALL	CLG. HT.	FACTORS	HOME	LIV/DIN	KIT	FAM	LAUN	FOY	MUD	WOD	BAS
				21	35	47	26	0	9	13	50	164
				10	10	10	10	9	10	10	9	9
GRS.WALL AREA	LOSS	GAIN		210	350	470	260	0	90	130	450	1134
GLAZING	LOSS	GAIN		LOSS	GAIN	LOSS	GAIN	LOSS	LOSS	GAIN	LOSS	GAIN
NORTH	21.8	16.0	0	0	0	28	610	447	0	0	0	0
EAST	21.8	41.6	28	610	1163	45	980	1870	45	980	1870	0
SOUTH	21.8	24.9	0	0	0	0	0	0	0	0	0	0
WEST	21.8	41.6	0	0	0	0	0	0	0	0	0	0
SKYLT.	38.1	101.5	0	0	0	0	0	0	0	0	0	0
DOORS	20.5	3.4	0	0	0	0	0	0	0	0	0	0
NET EXPOSED WALL	4.6	0.8	182	831	137	277	1265	208	408	1864	307	220
NET EXPOSED BSMT WALL ABOVE GR	3.7	0.6	0	0	0	0	0	0	0	0	0	0
EXPOSED CLG	1.3	0.6	0	0	0	0	0	0	0	0	0	0
NO ATTIC EXPOSED CLG	2.8	1.3	0	0	0	0	0	0	0	0	0	0
EXPOSED FLOOR	2.6	0.4	0	0	0	0	0	0	0	0	0	0
BASEMENT/CRAWL HEAT LOSS			0			0			0			0
SLAB ON GRADE HEAT LOSS			0			0			0			0
SUBTOTAL HT LOSS			1441			2856			3187			1876
SUB TOTAL HT GAIN			1300			2525			2043			1827
LEVEL FACTOR / MULTIPLIER	0.30	0.59		0.30	0.59		0.30	0.59		0.20	0.28	
AIR CHANGE HEAT LOSS			846			1676			1870			1101
AIR CHANGE HEAT GAIN			77			149			121			108
DUCT LOSS			0			0			0			0
DUCT GAIN			0			0			0			0
HEAT GAIN PEOPLE	240		0	0	0	0	0	0	0	0	0	0
HEAT GAIN APPLIANCES/LIGHTS			607			607			607			607
TOTAL HT LOSS BTU/H			2287			4532			5057			2978
TOTAL HT GAIN x 1.3 BTU/H			2580			4267			3602			3306

TOTAL HEAT GAIN BTU/H:

42846

TONS: 3.57

LOSS DUE TO VENTILATION LOAD BTU/H: 1670

STRUCTURAL HEAT LOSS: 57599

TOTAL COMBINED HEAT LOSS BTU/H: 59269


CITY OF RICHMOND HILL
BUILDING DIVISION

05/01/2024

SITE NAME: TRINIGROUP

BUILDER: GREENPARK HOMES

TYPE: ROSE 9A

DATE: Dec-23

GFA: 3315

LO# 103548

HEATING CFM 1504 COOLING CFM 1504
TOTAL HEAT LOSS 57,599 TOTAL HEAT GAIN 42,572
AIR FLOW RATE CFM 26.11 AIR FLOW RATE CFM 35.33

furnace pressure 0.6
furnace filter 0.05
a/c coil pressure 0.2
available pressure
for s/a & r/a 0.35

#*GOODMAN
GMEC960804CNA 80
FAN SPEED
LOW 868
MEDLOW 978
MEDIUM 1112
MEDIUM HIGH 1504
HIGH 1615

AFUE = 96 %
INPUT (BTU/H) = 80,000
OUTPUT (BTU/H) = 76,800

DESIGN CFM = 1504
CFM @ .6" E.S.P.

TEMPERATURE RISE 47 °F

RUN COUNT	4th	3rd	2nd	1st	Bas
S/A	0	0	16	9	5
R/A	0	0	5	2	1

All S/A diffusers 4"x10" unless noted otherwise on layout.

All S/A runs 5"Ø unless noted otherwise on layout.

RUN #	1	2	3	4	5	6	7	8	9	10	11	12	13	14	15	16	17	18	19	20	21	22	23	24
ROOM NAME	MBR	ENS	WIC	BED-2	BED-3	BED-4	ENS-2	ENS-3	WIC-3	MBR	ENS-4	HOME	LIV/DIN	KIT	KIT	FAM	LAUN	LIV/DIN	FOY	MUD	BAS	BAS	BAS	BAS
RM LOSS MBH.	2.15	1.27	0.13	1.34	1.36	1.65	0.76	2.44	0.81	2.15	1.21	2.29	2.27	2.53	2.53	1.49	0.13	2.27	1.88	0.94	3.84	3.84	3.84	3.84
CFM PER RUN HEAT	56	33	3	35	36	43	20	64	21	56	32	60	59	66	66	39	3	59	49	25	100	100	100	100
RM GAIN MBH.	2.66	1.34	0.06	1.76	1.91	1.83	0.31	3.01	0.86	2.66	0.49	2.58	2.13	1.80	1.80	1.65	0.85	2.13	2.62	0.13	0.44	0.44	0.44	0.44
CFM PER RUN COOLING	94	47	2	62	68	65	11	106	30	94	17	91	75	64	64	58	30	75	93	5	16	16	16	16
ADJUSTED PRESSURE	0.16	0.17	0.17	0.17	0.17	0.17	0.17	0.16	0.17	0.16	0.17	0.16	0.17	0.17	0.17	0.17	0.17	0.17	0.16	0.17	0.16	0.16	0.16	0.16
ACTUAL DUCT LGH.	38	53	43	36	61	56	18	48	50	48	59	43	23	22	32	38	22	11	30	42	41	24	14	10
EQUIVALENT LENGTH	110	140	160	170	180	130	120	160	130	150	170	150	100	130	170	190	150	120	120	110	160	120	140	130
TOTAL EFFECTIVE LENGTH	148	193	203	206	241	186	138	208	180	198	229	193	123	152	202	228	172	131	150	152	201	144	154	140
ADJUSTED PRESSURE	0.11	0.09	0.08	0.08	0.07	0.09	0.12	0.08	0.1	0.08	0.08	0.08	0.14	0.11	0.09	0.08	0.1	0.13	0.11	0.11	0.08	0.11	0.11	0.12
ROUND DUCT SIZE	6	5	4	5	6	6	4	6	4	6	4	6	5	6	6	5	4	5	6	4	6	6	6	6
HEATING VELOCITY (ft/min)	286	242	34	257	184	219	229	326	241	286	367	306	433	337	337	286	34	433	250	287	510	510	510	510
COOLING VELOCITY (ft/min)	479	345	23	455	347	331	126	540	344	479	195	464	551	326	326	426	344	551	474	57	82	82	82	82
OUTLET GRILL SIZE	4X10	3X10	3X10	3X10	4X10	4X10	3X10	4X10	3X10	4X10	3X10	4X10	3X10	4X10	4X10	3X10	3X10	3X10	4X10	3X10	4X10	4X10	4X10	4X10
TRUNK	C	B	B	E	D	B	E	D	B	C	A	D	D	C	B	B	E	E	D	A	B	C	C	E

RUN #	25	26	27	28	29	30
ROOM NAME	ENS-WC	BED-3	BED-4	FAM	BED-4	BAS
RM LOSS MBH.	0.64	1.36	1.65	1.49	1.65	3.84
CFM PER RUN HEAT	17	36	43	39	43	100
RM GAIN MBH.	0.55	1.91	1.83	1.65	1.83	0.44
CFM PER RUN COOLING	19	68	65	58	65	16
ADJUSTED PRESSURE	0.17	0.17	0.17	0.17	0.17	0.16
ACTUAL DUCT LGH.	59	62	60	48	43	22
EQUIVALENT LENGTH	170	210	190	140	120	100
TOTAL EFFECTIVE LENGTH	229	272	250	188	163	122
ADJUSTED PRESSURE	0.08	0.06	0.07	0.09	0.11	0.13
ROUND DUCT SIZE	4	6	6	5	5	6
HEATING VELOCITY (ft/min)	195	184	219	286	316	510
COOLING VELOCITY (ft/min)	218	347	331	426	477	82
OUTLET GRILL SIZE	3X10	4X10	4X10	3X10	3X10	4X10
TRUNK	A	D	A	A	E	E

SUPPLY AIR TRUNK SIZE								RETURN AIR TRUNK SIZE							
	TRUNK CFM	STATIC PRESS.	ROUND DUCT	RECT DUCT		VELOCITY (ft/min)			TRUNK CFM	STATIC PRESS.	ROUND DUCT	RECT DUCT		VELOCITY (ft/min)	
TRUNK A	199	0.07	7.9	8	x	8	448	TRUNK G	0	0.00	0	0	x	8	0
TRUNK B	568	0.07	11.7	16	x	8	639	TRUNK H	0	0.00	0	0	x	8	0
TRUNK C	1022	0.07	14.6	24	x	8	767	TRUNK I	0	0.00	0	0	x	8	0
TRUNK D	501	0.06	11.6	16	x	8	564	TRUNK J	0	0.00	0	0	x	8	0
TRUNK E	953	0.06	14.8	26	x	8	660	TRUNK K	0	0.00	0	0	x	8	0
TRUNK F	0	0.00	0	0	x	8	0	TRUNK L	0	0.00	0	0	x	8	0

RETURN AIR #	1	2	3	4	5	6	7								BR
AIR VOLUME	0	0	0	0	0	0	0	0	0	0	0	0	0	0	260
PLENUM PRESSURE	0.15	0.15	0.15	0.15	0.15	0.15	0.15	0.15	0.15	0.15	0.15	0.15	0.15	0.15	0.15
ACTUAL DUCT LGH.	47	44	48	59	53	21	57	1	1	1	1	1	1	1	14
EQUIVALENT LENGTH	165	155	145	175	195	145	150	0	0	0	0	0	0	0	135
TOTAL EFFECTIVE LH	212	199	193	234	248	166	207	1	1	1	1	1	1	1	149
ADJUSTED PRESSURE	0.07	0.07	0.08	0.06	0.06	0.09	0.07	14.80	14.80	14.80	14.80	14.80	14.80	14.80	0.10
ROUND DUCT SIZE	6.8	6.8	6.7	6.8	6.9	8.7	9.2	0	0	0	0	0	0	0	8
INLET GRILL SIZE	8	8	8	8	8	8	8	0	0	0	0	0	0	0	8
	X	X	X	X	X	X	X	X	X	X	X	X	X	X	X
INLET GRILL SIZE	14	14	14	14	14	30	30	0	0	0	0	0	0	0	24

	TRUNK CFM	STATIC PRESS.	ROUND DUCT	RECT DUCT		VELOCITY (ft/min)
TRUNK O	0	0.06	0	0	x	8
TRUNK P	0	0.06	0	0	x	8
TRUNK Q	0	0.06	0	0	x	8
TRUNK R	0	0.06	0	0	x	8
TRUNK S	0	0.06	0	0	x	8
TRUNK T	0	0.06	0	0	x	8
TRUNK U	0	0.06	0	0	x	8
TRUNK V	0	0.06	0	0	x	8
TRUNK W	140	0.06	7.2	8	x	8
TRUNK X	1504	0.06	17.6	28	x	12
TRUNK Y	804	0.06	13.9	22	x	8
TRUNK Z	420	0.06	10.9	14	x	8
DROP	1504	0.06	17.6	24	x	14

CITY OF RICHMOND HILL
BUILDING DIVISION

05/01/2024

RECEIVED
Per: joshua.nabua

TYPE: ROSE 9A
SITE NAME: TRINIGROUP

LO # 103548

RESIDENTIAL MECHANICAL VENTILATION DESIGN SUMMARY

COMBUSTION APPLIANCES		9.32.3.1(1)
a)	☒ Direct vent (sealed combustion) only	
b)	☐ Positive venting induced draft (except fireplaces)	
c)	☐ Natural draft, B-vent or induced draft gas fireplace	
d)	☐ Solid Fuel (including fireplaces)	
e)	☐ No Combustion Appliances	

HEATING SYSTEM	
☒ Forced Air	☐ Non Forced Air
☐ Electric Space Heat	

HOUSE TYPE		9.32.1(2)
☒ I	Type a) or b) appliance only, no solid fuel	
☐ II	Type I except with solid fuel (including fireplaces)	
☐ III	Any Type c) appliance	
☐ IV	Type I, or II with electric space heat	
☐ Other:	Type I, II or IV no forced air	

SYSTEM DESIGN OPTIONS		O.N.H.W.P.
☐ 1	Exhaust only/Forced Air System	
☐ 2	HRV with Ducting/Forced Air System	
☒ 3	HRV Simplified/connected to forced air system	
☐ 4	HRV with Ducting/non forced air system	
☐	Part 6 Design	

TOTAL VENTILATION CAPACITY		9.32.3.3(1)
Basement + Master Bedroom	<u>2</u> @ 21.2 cfm	<u>42.4</u> cfm
Other Bedrooms	<u>3</u> @ 10.6 cfm	<u>31.8</u> cfm
Kitchen & Bathrooms	<u>6</u> @ 10.6 cfm	<u>63.6</u> cfm
Other Rooms	<u>6</u> @ 10.6 cfm	<u>63.6</u> cfm
Table 9.32.3.A.	TOTAL	<u>201.4</u> cfm

PRINCIPAL VENTILATION CAPACITY REQUIRED		9.32.3.4.(1)
1 Bedroom	31.8	cfm
2 Bedroom	47.7	cfm
3 Bedroom	63.6	cfm
4 Bedroom	79.5	cfm
5 Bedroom	95.4	cfm
TOTAL	79.5	cfm

SUPPLEMENTAL VENTILATION CAPACITY		9.32.3.5.
Total Ventilation Capacity	<u>201.4</u>	cfm
Less Principal Ventil. Capacity	<u>79.5</u>	cfm
Required Supplemental Capacity	<u>121.9</u>	cfm

PRINCIPAL EXHAUST FAN CAPACITY	
Model:	VANEE V150H
Location:	BSMT
<u>79.5</u> cfm	☒ HVI Approved

PRINCIPAL EXHAUST HEAT LOSS CALCULATION				
CFM	ΔT °F	FACTOR	% LOSS	
79.5 CFM	X 78 F	X 1.08	X	0.25

SUPPLEMENTAL FANS		BY INSTALLING CONTRACTOR		
Location	Model	cfm	HVI	Sones
ENS	BY INSTALLING CONTRACTOR	50	☒	3.5
ENS-2	BY INSTALLING CONTRACTOR	50	☒	3.5
ENS-4	BY INSTALLING CONTRACTOR	50	☒	3.5

HEAT RECOVERY VENTILATOR		9.32.3.11.
Model:	VANEE V150H	
<u>150</u> cfm high	<u>35</u> cfm low	
<u>75</u> % Sensible Efficiency	☒ HVI Approved	
@ 32 deg F (0 deg C)		

LOCATION OF INSTALLATION	
Lot:	Concession
Township	Plan:
Address	
Roll #	Building Permit #

BUILDER:	
GREENPARK HOMES	
Name:	
Address:	
City:	
Telephone #:	Fax #:

INSTALLING CONTRACTOR	
Name:	
Address:	
City:	
Telephone #:	Fax #:

DESIGNER CERTIFICATION	
I hereby certify that this ventilation system has been designed in accordance with the Ontario Building Code.	
Name:	HVAC Designs Ltd.
Signature:	<i>Michael O'Rourke</i>
HRAI #	001820
Date:	December-23

I REVIEW AND TAKE RESPONSIBILITY FOR THE DESIGN WORK AND AM QUALIFIED IN THE APPROPRIATE CATEGORY AS AN "OTHER DESIGNER" UNDER DIVISION C, 3.2.5 OF THE BUILDING CODE.
INDIVIDUAL BCIN: 19669 MICHAEL O'ROURKE

Michael O'Rourke

CITY OF RICHMOND HILL
BUILDING DIVISION

05/01/2024

RECEIVED
Per: joshua.nabua

CSA F280-12 Residential Heat Loss and Heat Gain Calculations

Formula Sheet (For Air Leakage / Ventilation Calculation)

LO#: 103548

Model: ROSE 9A

Builder: GREENPARK HOMES

Date: 2023-12-20

Volume Calculation

Air Change & Delta T Data

House Volume

Level	Floor Area (ft ²)	Floor Height (ft)	Volume (ft ³)
Bsmt	1466	9	13194
First	1466	10	14660
Second	1849	9	16641
Third	0	9	0
Fourth	0	9	0
Total:			44,495.0 ft ³
Total:			1260.0 m ³

WINTER NATURAL AIR CHANGE RATE	0.352
SUMMER NATURAL AIR CHANGE RATE	0.110

Design Temperature Difference				
	T _{in} °C	T _{out} °C	ΔT °C	ΔT °F
Winter DTD _h	22	-21	43	78
Summer DTD _c	24	31	7	13

5.2.3.1 Heat Loss due to Air Leakage

6.2.6 Sensible Gain due to Air Leakage

$$HL_{airb} = LR_{airh} \times \frac{V_b}{3.6} \times DTD_h \times 1.2$$

$$0.352 \times 349.99 \times 43^\circ\text{C} \times 1.2 = 6387 \text{ W}$$

$$= 21793 \text{ Btu/h}$$

$$HG_{salb} = LR_{airc} \times \frac{V_b}{3.6} \times DTD_c \times 1.2$$

$$0.110 \times 349.99 \times 7^\circ\text{C} \times 1.2 = 328 \text{ W}$$

$$= 1119 \text{ Btu/h}$$

5.2.3.2 Heat Loss due to Mechanical Ventilation

6.2.7 Sensible heat Gain due to Ventilation

$$HL_{vairb} = PVC \times DTD_h \times 1.08 \times (1 - E)$$

$$80 \text{ CFM} \times 78^\circ\text{F} \times 1.08 \times 0.25 = 1670 \text{ Btu/h}$$

$$HL_{vairb} = PVC \times DTD_h \times 1.08 \times (1 - E)$$

$$80 \text{ CFM} \times 13^\circ\text{F} \times 1.08 \times 0.25 = 275 \text{ Btu/h}$$

5.2.3.3 Calculation of Air Change Heat Loss for Each Room (Floor Multiplier Section)

$$HL_{airr} = \text{Level Factor} \times HL_{airbv} \times \{(HL_{agcr} + HL_{bgcr}) \div (HL_{agclevel} + HL_{bgclevel})\}$$

Level	Level Factor (LF)	HL _{airve} Air Leakage + Ventilation Heat Loss (Btu/h)	Level Conductive Heat Loss: (HL _{clevel})	Air Leakage Heat Loss Multiplier (LF x HL _{airbv} / HL _{level})
1	0.5	21,793	8,313	1.311
2	0.3		11,140	0.587
3	0.2		15,714	0.277
4	0		0	0.000
5	0		0	0.000

*HL_{airbv} = Air leakage heat loss + ventilation heat loss*For a balanced or supply only ventilation system HL_{airve} = 0Michael O'Rourke
BCIN# 19669CITY OF RICHMOND HILL
BUILDING DIVISION

05/01/2024

RECEIVED
Per: joshua.nabua

HEAT LOSS AND GAIN SUMMARY SHEET**MODEL:** ROSE 9A**BUILDER:** GREENPARK HOMES**SFQT:** 3315**LO#** 103548**SITE:** TRINIGROUP**DESIGN ASSUMPTIONS**

HEATING	°F	COOLING	°F
OUTDOOR DESIGN TEMP.	-6	OUTDOOR DESIGN TEMP.	88
INDOOR DESIGN TEMP.	72	INDOOR DESIGN TEMP. (MAX 75°F)	75
		WINDOW SHGC	0.50

BUILDING DATA

ATTACHMENT:	DETACHED	# OF STORIES (+BASEMENT):	3
FRONT FACES:	EAST	ASSUMED (Y/N):	Y
AIR CHANGES PER HOUR:	3.57	ASSUMED (Y/N):	Y
AIR TIGHTNESS CATEGORY:	AVERAGE	ASSUMED (Y/N):	Y
WIND EXPOSURE:	SHELTERED	ASSUMED (Y/N):	Y
HOUSE VOLUME (ft ³):	44495.0	ASSUMED (Y/N):	Y
INTERNAL SHADING:	BLINDS/CURTAINS	ASSUMED OCCUPANTS:	5
INTERIOR LIGHTING LOAD (Btu/h/ft ²):	1.27	DC BRUSHLESS MOTOR (Y/N):	Y
FOUNDATION CONFIGURATION	BCIN_1	DEPTH BELOW GRADE:	6.0 ft
LENGTH: 42.0 ft	WIDTH: 40.0 ft	EXPOSED PERIMETER:	164.0 ft

2012 OBC - COMPLIANCE PACKAGE**Component****Compliance Package
A1****Nominal Min. Eff.**

Ceiling with Attic Space Minimum RSI (R)-Value	60	59.22
Ceiling Without Attic Space Minimum RSI (R)-Value	31	27.65
Exposed Floor Minimum RSI (R)-Value	31	29.80
Walls Above Grade Minimum RSI (R)-Value	22	17.03
Basement Walls Minimum RSI (R)-Value	20 ci	21.12
Below Grade Slab Entire surface > 600 mm below grade Minimum RSI (R)-Value	-	-
Edge of Below Grade Slab ≤ 600 mm Below Grade Minimum RSI (R)-Value	10	10
Heated Slab or Slab ≤ 600 mm below grade Minimum RSI (R)-Value	10	11.13
Windows and Sliding Glass Doors Maximum U-Value	0.28	-
Skylights Maximum U-Value	0.49	-
Space Heating Equipment Minimum AFUE	96%	-
HRV/ERV Minimum Efficiency	75%	-
Domestic Hot Water Heater Minimum EF	0.8	-

INDIVIDUAL BCIN: 19669

MICHAEL O'ROURKE


CITY OF RICHMOND HILL
BUILDING DIVISION

05/01/2024

RECEIVED
Per: joshua.nabua

Residential Foundation Thermal Load Calculator

Supplemental tool for CAN/CSA-F280

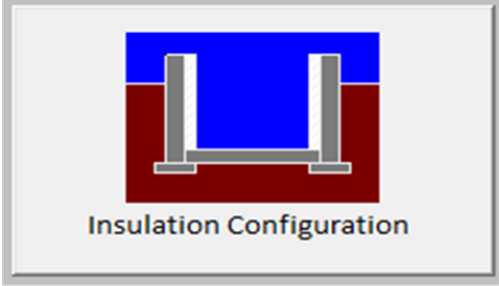Weather Station Description		
Province:	Ontario	
Region:	Richmond Hill	
Site Description		
Soil Conductivity:	Normal conductivity: dry sand, loam, clay	
Water Table:	Normal (7-10 m, 23-33 ft)	
Foundation Dimensions		
Floor Length (m):	12.8	 Insulation Configuration
Floor Width (m):	12.2	
Exposed Perimeter (m):	0.0	
Wall Height (m):	2.7	
Depth Below Grade (m):	1.83	
Window Area (m ²):	1.7	
Door Area (m ²):	0.0	
Radiant Slab		
Heated Fraction of the Slab:	0	
Fluid Temperature (°C):	33	
Design Months		
Heating Month	1	
Foundation Loads		
Heating Load (Watts):		1643

TYPE: ROSE 9A
LO# 103548

Michael O'Rourke BCIN #19669

CITY OF RICHMOND HILL
BUILDING DIVISION

05/01/2024


RECEIVED
Per: joshua.nabua

Air Infiltration Residential Load Calculator

Supplemental tool for CAN/CSA-F280

Weather Station Description				
Province:	Ontario			
Region:	Richmond Hill			
Weather Station Location:	Open flat terrain, grass			
Anemometer height (m):	10			
Local Shielding				
Building Site:	Suburban, forest			
Walls:	Heavy			
Flue:	Heavy			
Highest Ceiling Height (m):	7.62			
Building Configuration				
Type:	Detached			
Number of Stories:	Two			
Foundation:	Full			
House Volume (m ³):	1260.0			
Air Leakage/Ventilation				
Air Tightness Type:	Present (1961-) (3.57 ACH)			
Custom BDT Data:	ELA @ 10 Pa.	1679.6 cm ²		
	3.57	ACH @ 50 Pa		
Mechanical Ventilation (L/s):	Total Supply	Total Exhaust		
	37.5	37.5		
Flue Size				
Flue #:	#1	#2	#3	#4
Diameter (mm):	0	0	0	0
Natural Infiltration Rates				
Heating Air Leakage Rate (ACH/H):	0.352			
Cooling Air Leakage Rate (ACH/H):	0.110			

TYPE: ROSE 9A


LO# 103548

Michael O'Rourke BCIN# 19669

CITY OF RICHMOND HILL
BUILDING DIVISION

05/01/2024

RECEIVED
Per: joshua.nabua

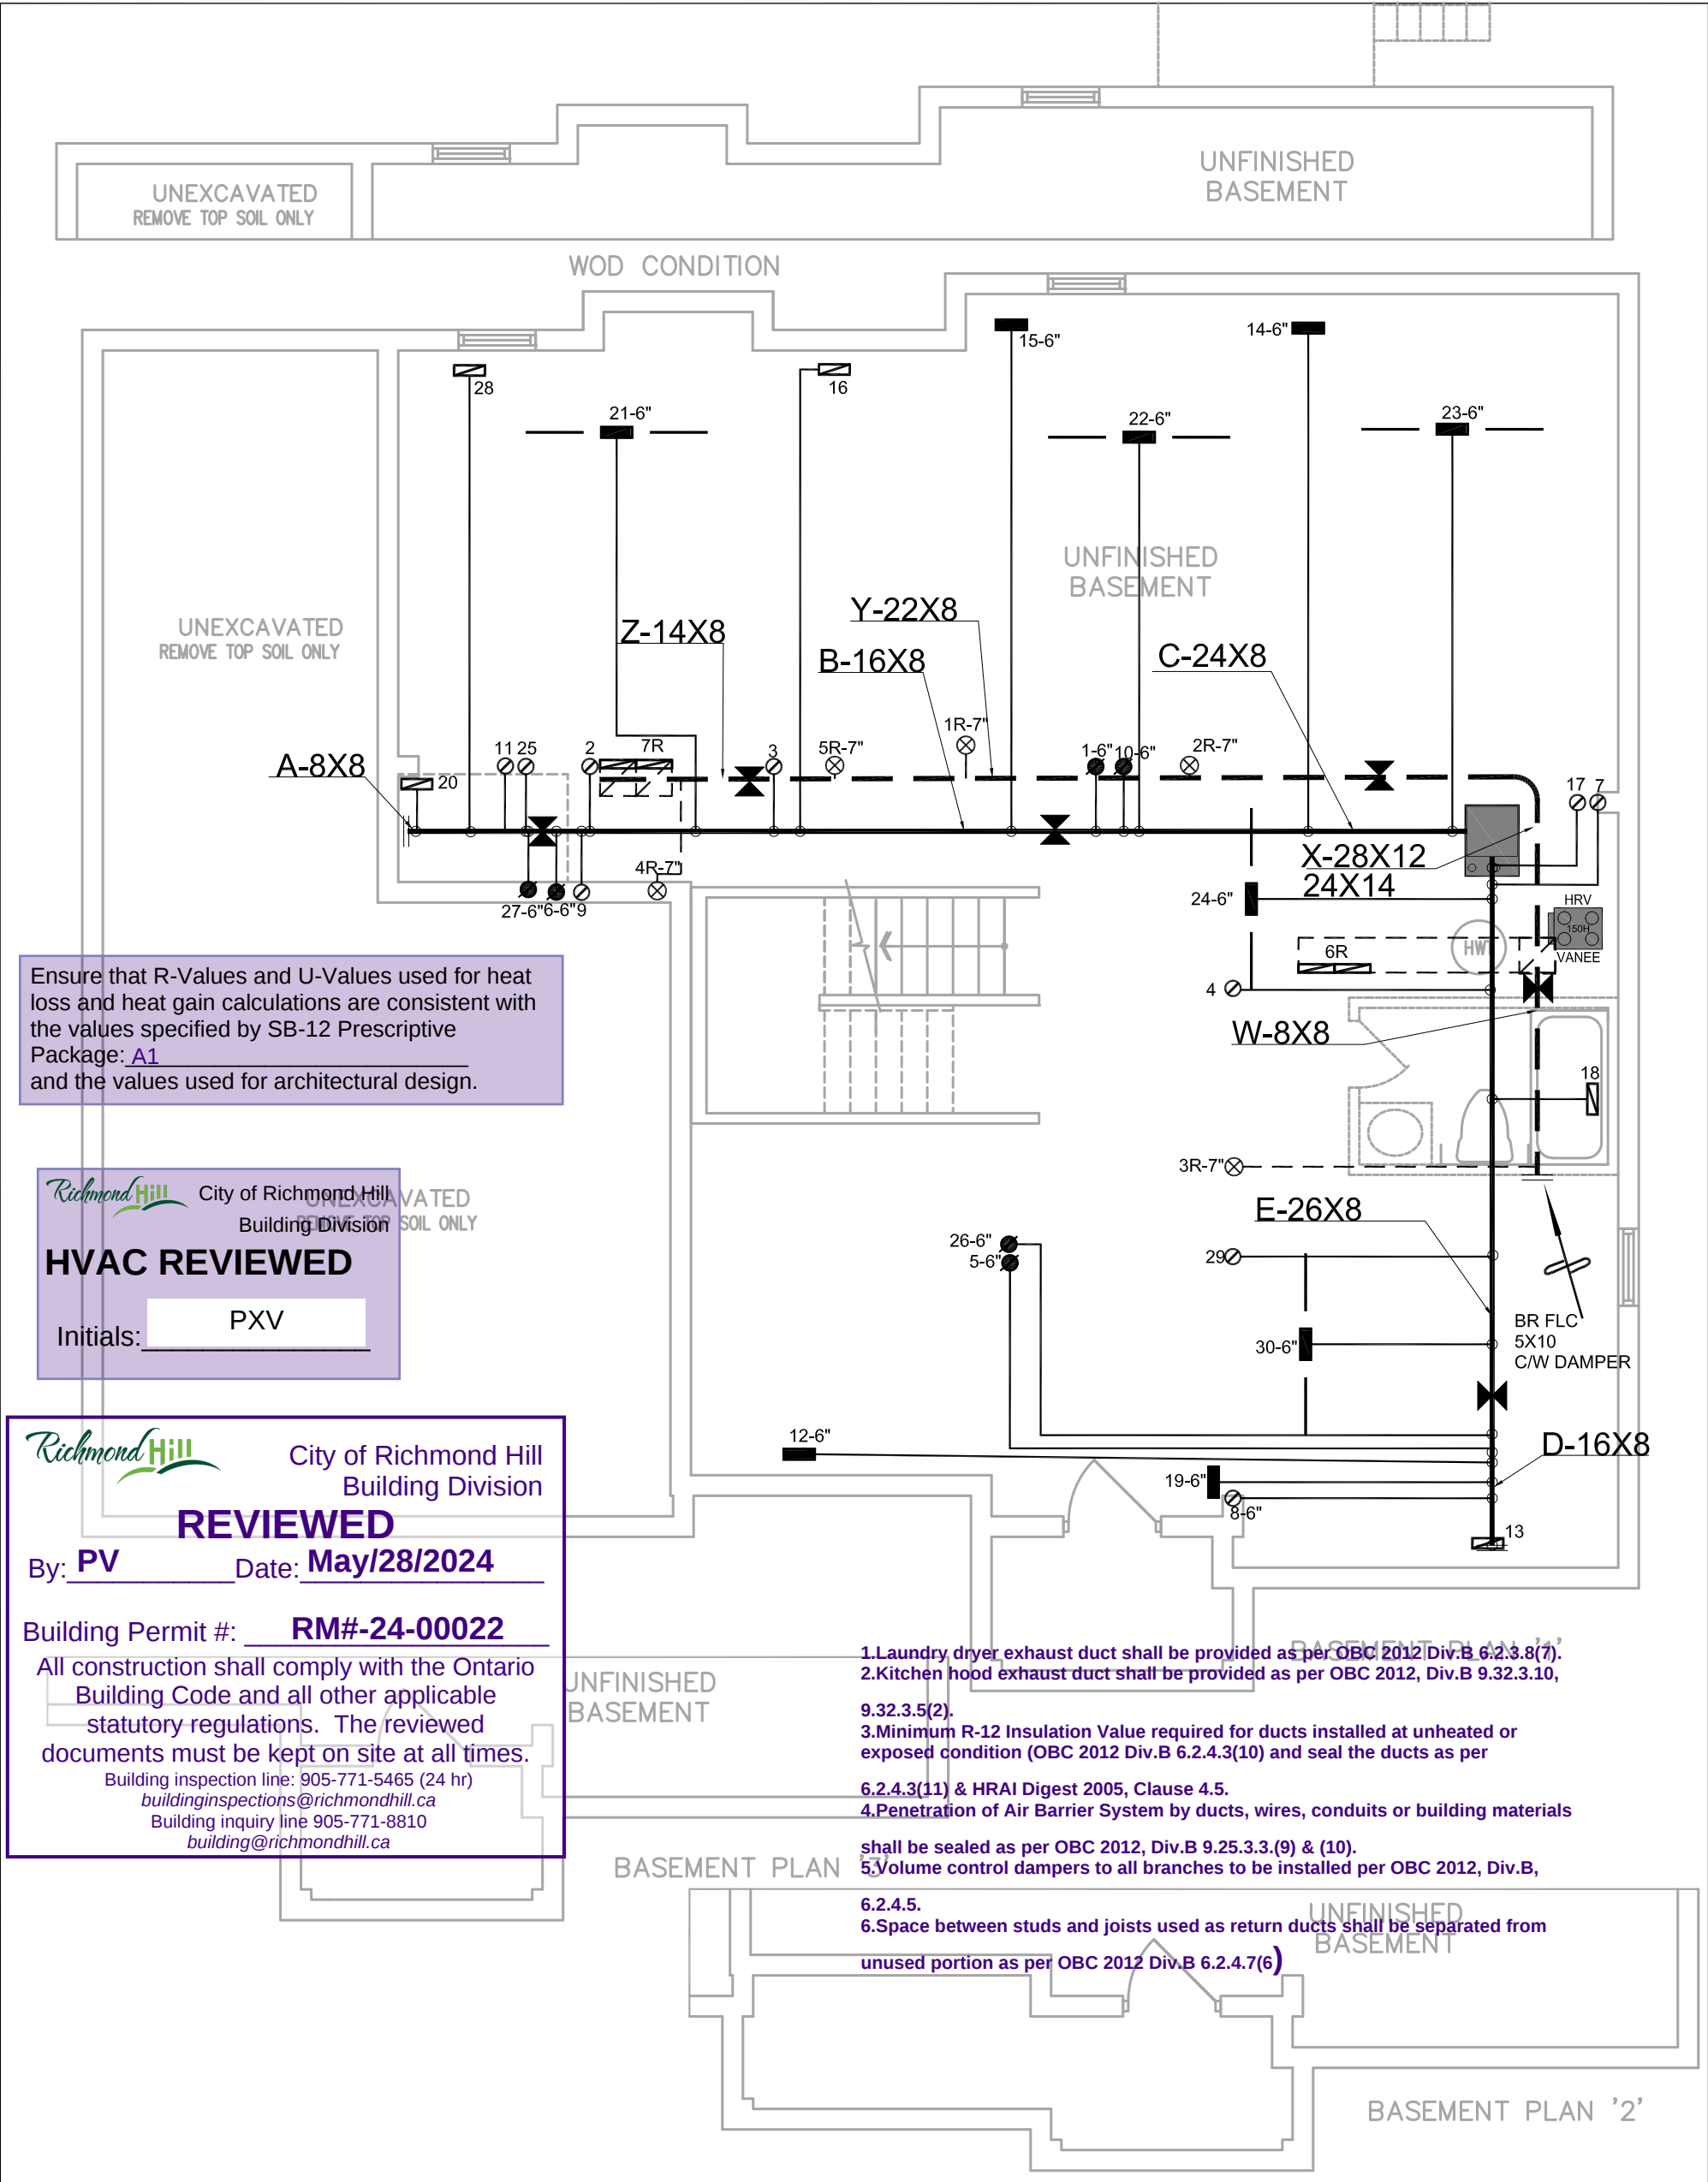

Ensure that R-Values and U-Values used for heat loss and heat gain calculations are consistent with the values specified by SB-12 Prescriptive Package: A1 and the values used for architectural design.



City of Richmond Hill
Building Division

HVAC REVIEWED

Initials:

PXV



City of Richmond Hill
Building Division

REVIEWED



By: PV Date: May/28/2024

Building Permit #: RM#-24-00022


All construction shall comply with the Ontario Building Code and all other applicable statutory regulations. The reviewed documents must be kept on site at all times.

Building inspection line: 905-771-5465 (24 hr)
buildinginspections@richmondhill.ca
Building inquiry line 905-771-8810
building@richmondhill.ca


- 1.Laundry dryer exhaust duct shall be provided as per OBC 2012 Div.B 6.2.3.8(7).
- 2.Kitchen hood exhaust duct shall be provided as per OBC 2012, Div.B 9.32.3.10, 9.32.3.5(2).
- 3.Minimum R-12 Insulation Value required for ducts installed at unheated or exposed condition (OBC 2012 Div.B 6.2.4.3(10) and seal the ducts as per 6.2.4.3(11) & HRAI Digest 2005, Clause 4.5.
- 4.Penetration of Air Barrier System by ducts, wires, conduits or building materials shall be sealed as per OBC 2012, Div.B 9.25.3.3.(9) & (10).
- 5.Volume control dampers to all branches to be installed per OBC 2012, Div.B, 6.2.4.5.
- 6.Space between studs and joists used as return ducts shall be separated from unused portion as per OBC 2012 Div.B 6.2.4.7(6)

  HVAC LEGEND								3.			
SYMBOL	DESCRIPTION	SYMBOL	DESCRIPTION	SYMBOL	DESCRIPTION	SYMBOL	DESCRIPTION	2.			
	SUPPLY AIR GRILLE		6" SUPPLY AIR BOOT ABOVE		14"x8" RETURN AIR GRILLE		RETURN AIR STACK ABOVE	1.			
	SUPPLY AIR GRILLE 6" BOOT		SUPPLY AIR STACK FROM 2nd FLOOR		30"x8" RETURN AIR GRILLE		RETURN AIR STACK 2nd FLOOR	No.	Description	Date	
	SUPPLY AIR BOOT ABOVE		6" SUPPLY AIR STACK 2nd FLOOR		FRA- FLOOR RETURN AIR GRILLE		REDUCER	REVISIONS			
ALL DRAWINGS, CALCULATIONS AND SPECIFICATIONS ARE THE PROPERTY OF HVAC DESIGNS LTD.© AND MAY NOT BE REPRODUCED, MODIFIED OR ALTERED WITHOUT EXPRESSED WRITTEN CONSENT. THE DRAWINGS ARE DATED AND USE OF THESE DRAWINGS AFTER ONE YEAR FROM THE DATED NOTED IS NOT AUTHORIZED. CONTRACTOR SHALL CHECK ALL CONDITIONS BEFORE PROCEEDING WITH WORK. LATEST MUNICIPAL APPROVED DRAWINGS ONLY TO BE USED DURING INSTALLATION OF HEATING SYSTEM. HVAC DESIGNS LTD. IS NOT LIABLE FOR ANY CLAIMS ARISING FROM UNAUTHORIZED USE OF THE DRAWINGS OR FROM ANY CHANGES TO ACCEPTED STANDARDS AND/OR THE ONTARIO BUILDING CODE.						I Michael O'Rourke have reviewed and take responsibility for the design work and am qualified under division C.3.2.5 of the building code.		 Michael O'Rourke BCIN # 19669 HVAC Designs Ltd.		PACKAGE A1	
Client		 375 Finley Ave. Suite 202 - Ajax, Ontario L1S 2E2 Tel. 905.619.2300 - 905.420.5300 Fax 905.619.2375 Email: info@hvacdesigns.ca Web: www.hvacdesigns.ca Specializing in Residential Mechanical Design Services				HEAT LOSS 59269 BTU/H		# OF RUNS S/A R/A FANS		Sheet Title	
GREEN PARK HOMES						UNIT DATA		3RD FLOOR		BASEMENT HEATING LAYOUT	
Project Name						GOODMAN		2ND FLOOR		CITY OF RICHMOND HILL BUILDING DIVISION	
TRINIGROUP						MODEL GMEC960804CNA		1ST FLOOR		Date DEC/2023	
RICHMOND HILL, ONTARIO						INPUT 80 MBTU/H		BASEMENT		Scale 3/16" = 1'-0"	
ROSE 9A		3315 sqft		OUTPUT 76.8 MBTU/H		ALL S/A DIFFUSERS 4" x10" UNLESS NOTED OTHERWISE ON LAYOUT. ALL S/A RUNS 5"Ø UNLESS NOTED OTHERWISE ON LAYOUT. UNDERCUT DOORS 1" min. FOR R/A		BCIN# 19669			
		Installation to comply with the latest Ontario Building Code. All supply branch outlets shall be equipped with a manual balancing damper. Ductwork which passes through the garage or unheated spaces shall be adequately insulated and be gas-proofed.				COOLING 3.5 TONS		LO# 103548			
						FAN SPEED 1504 cfm @ 0.6" w.c.		Per: joshua.nabua			


7. Combustion air supply shall be provided to the furnace and hot water tank.
- 8.HRV installation, testing, startup and commissioning shall be in compliance with OBC 2012, Div.B 9.32.3.11, 9.32.3.11(7)&(10)
9. HRV duct connection shall be in compliance with OBC 2012 Div.B 9.32.3.6(3) & 9.32.3.4(7).
10. Supply air grill at finished basement shall be at low level. Return air grill for finished or unfinished basement shall be at low level. HRAI digest 2005, clause 7.7(3).

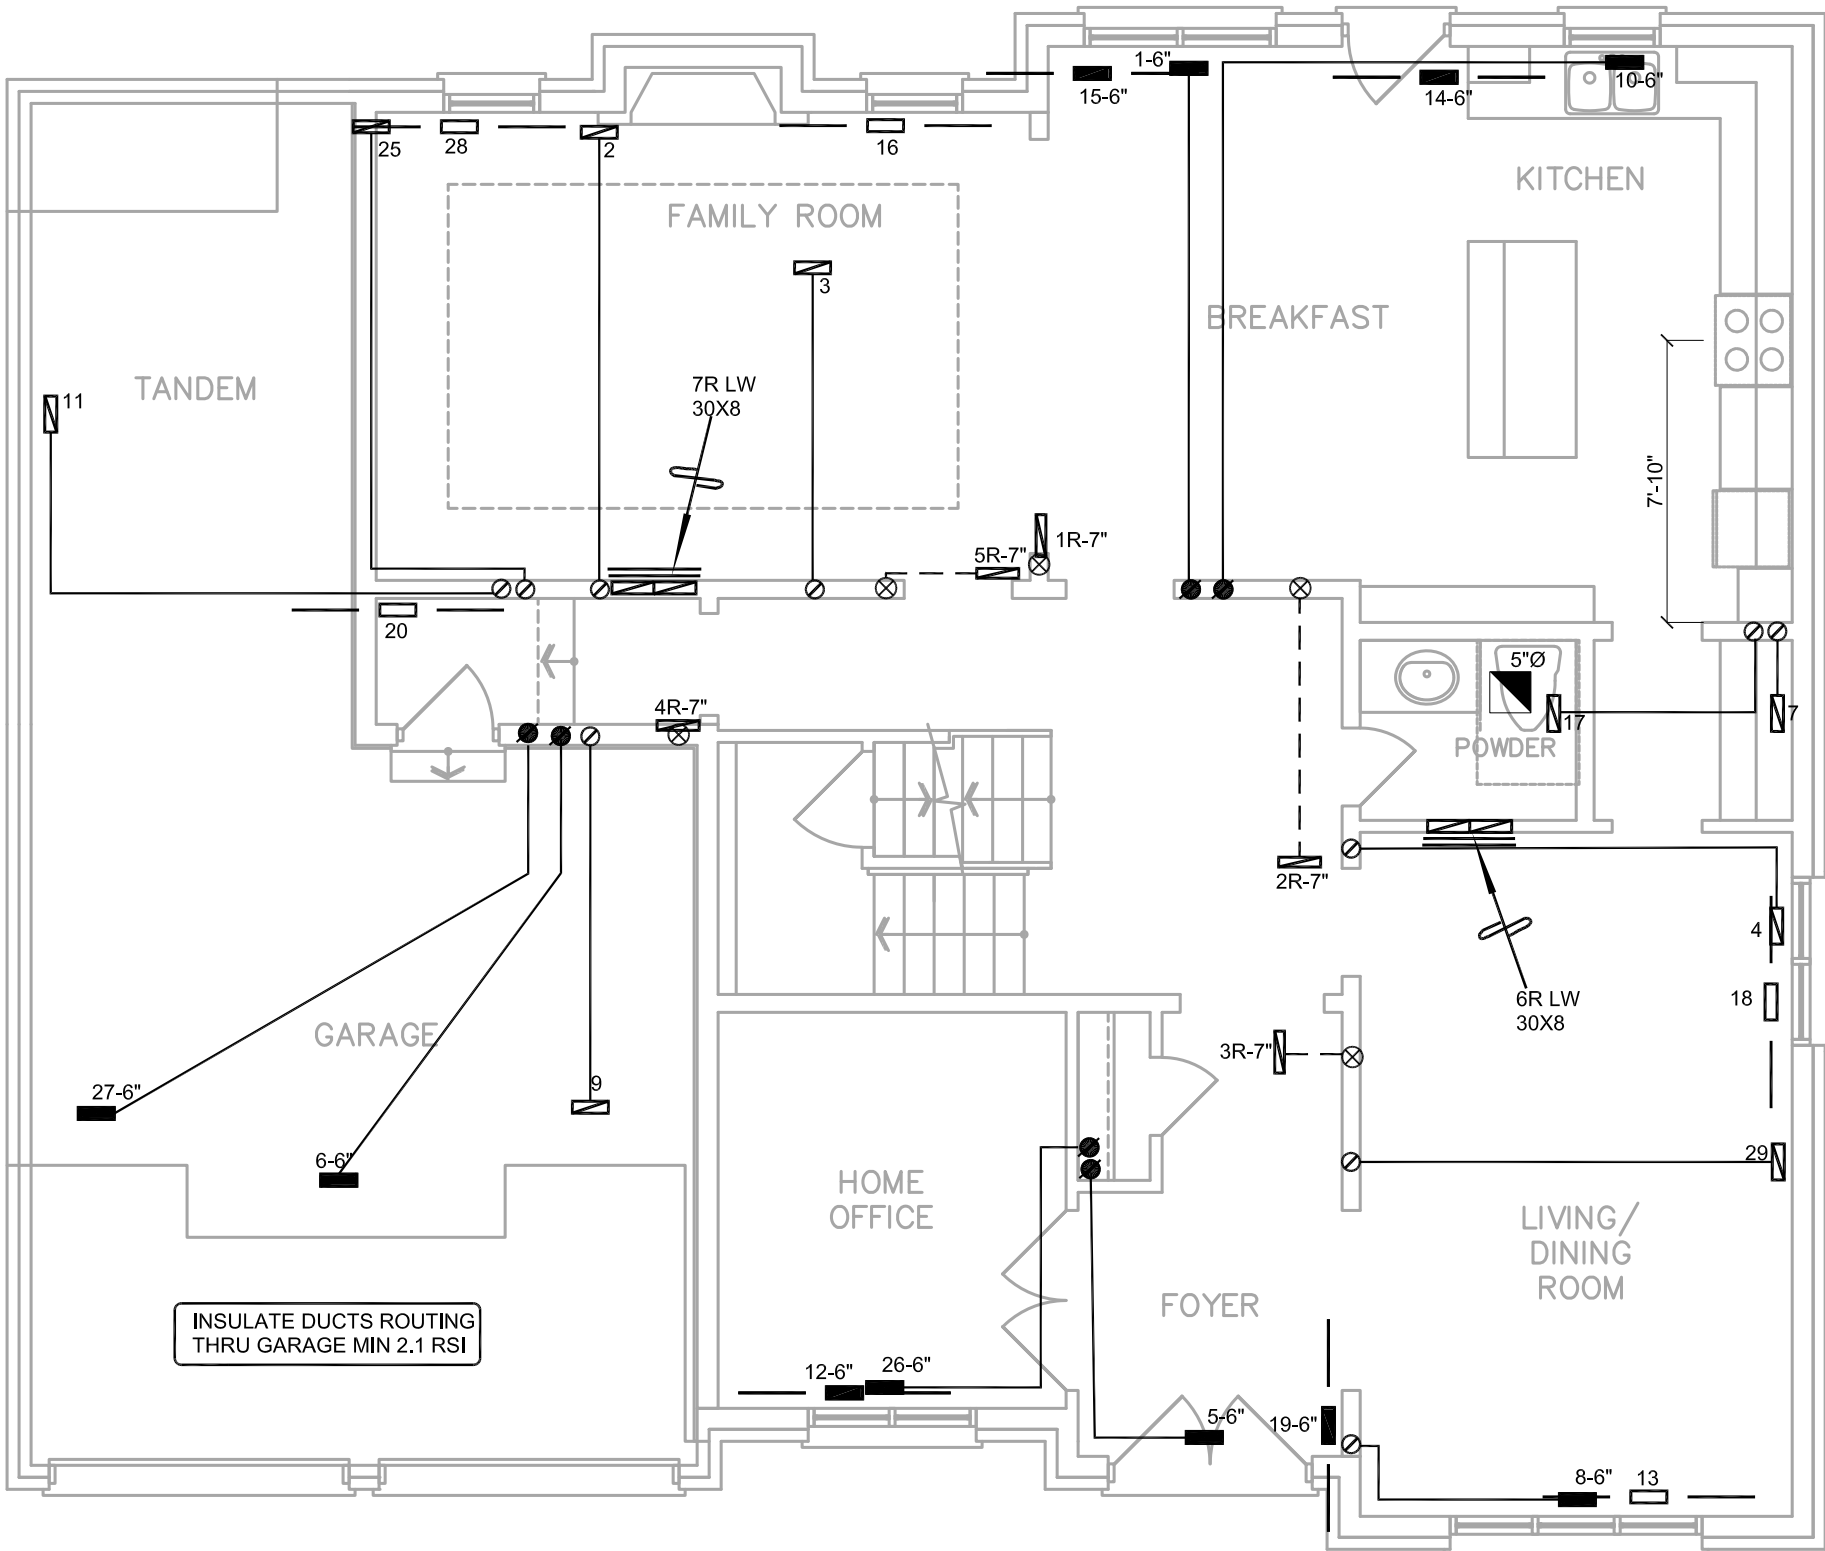

FIRST FLOOR PLAN '1'

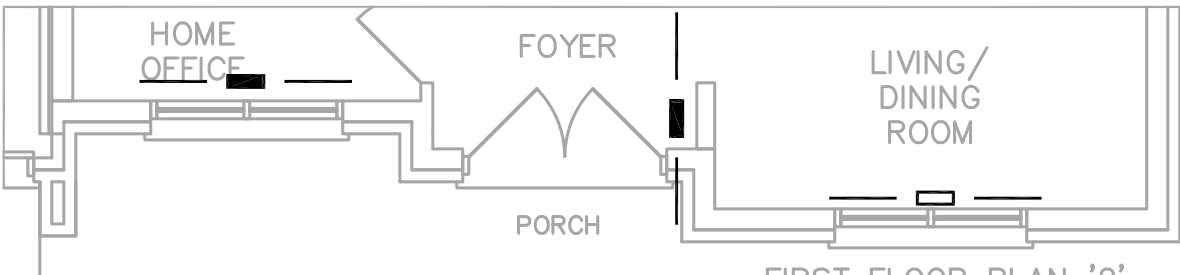

FIRST FLOOR PLAN '2'

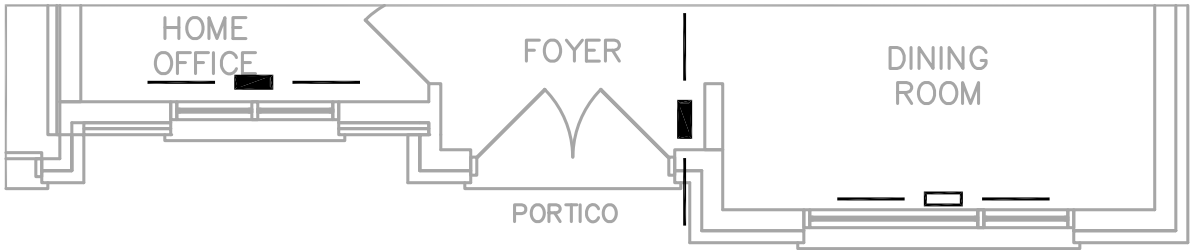

FIRST FLOOR PLAN '3'

City of Richmond Hill
Building Division

HVAC REVIEWED

Initials:

PXV

HVAC LEGEND								3.		
SYMBOL	DESCRIPTION	SYMBOL	DESCRIPTION	SYMBOL	DESCRIPTION	SYMBOL	DESCRIPTION	2.		
	SUPPLY AIR GRILLE		6" SUPPLY AIR BOOT ABOVE		14"x8" RETURN AIR GRILLE		RETURN AIR STACK ABOVE	1.		
	SUPPLY AIR GRILLE 6" BOOT		SUPPLY AIR STACK FROM 2nd FLOOR		30"x8" RETURN AIR GRILLE		RETURN AIR STACK 2nd FLOOR	No.	Description	Date
	SUPPLY AIR BOOT ABOVE		6" SUPPLY AIR STACK 2nd FLOOR		FRA- FLOOR RETURN AIR GRILLE		REDUCER	REVISIONS		

ALL DRAWINGS, CALCULATIONS AND SPECIFICATIONS ARE THE PROPERTY OF HVAC DESIGNS LTD.© AND MAY NOT BE REPRODUCED, MODIFIED OR ALTERED WITHOUT EXPRESSED WRITTEN CONSENT. THE DRAWINGS ARE DATED AND USE OF THESE DRAWINGS AFTER ONE YEAR FROM THE DATED NOTED IS NOT AUTHORIZED. CONTRACTOR SHALL CHECK ALL CONDITIONS BEFORE PROCEEDING WITH WORK. LATEST MUNICIPAL APPROVED DRAWINGS ONLY TO BE USED DURING INSTALLATION OF HEATING SYSTEM. HVAC DESIGNS LTD. IS NOT LIABLE FOR ANY CLAIMS ARISING FROM UNAUTHORIZED USE OF THE DRAWINGS OR FROM ANY CHANGES TO ACCEPTED STANDARDS AND/OR THE ONTARIO BUILDING CODE.

I Michael O'Rourke have reviewed and take responsibility for the design work and am qualified under division C.3.2.5 of the building code.


Michael O'Rourke BCIN # 19669
HVAC Designs Ltd.

PACKAGE A1

Client
GREEN PARK HOMES

Project Name
**TRINIGROUP
RICHMOND HILL, ONTARIO**

ROSE 9A **3315 sqft**



375 Finley Ave. Suite 202 - Ajax, Ontario
L1S 2E2 Tel. 905.619.2300 - 905.420.5300 Fax 905.619.2375
Email: info@hvacdesigns.ca
Web: www.hvacdesigns.ca
Specializing in Residential Mechanical Design Services

Installation to comply with the latest Ontario Building Code. All supply branch outlets shall be equipped with a manual balancing damper. Ductwork which passes through the garage or unheated spaces shall be adequately insulated and be gas-proofed.

Sheet Title
**FIRST FLOOR
HEATING
LAYOUT**

**CITY OF RICHMOND HILL
BUILDING DIVISION**

Date **DEC/2023**


Scale **3/16" = 1'-0"**
05/01/2024
BCIN# 19669

LO# 103548
Per: joshua.nabua

13.Exterior insulation effective R-Value for wall, roof or exposed floor shall be maintained at the respective location where duct or sanitary pipes are routed inside exterior envelope.

14. Return air intake shall be provided as recommended in HRAI Digest 2005 Section 4.7 Return air inlet should be positioned so that short circuiting of supply air is avoided. A high and low wall return air combination shall be provided when a combined cooling & heating system is installed.

15. For simplified HRV/ERV installation, with stale air and fresh air connected to return air plenum, stale air intake and fresh air supply shall be separated minimum 3' or as recommended by HRV/ERV Manufacturer.

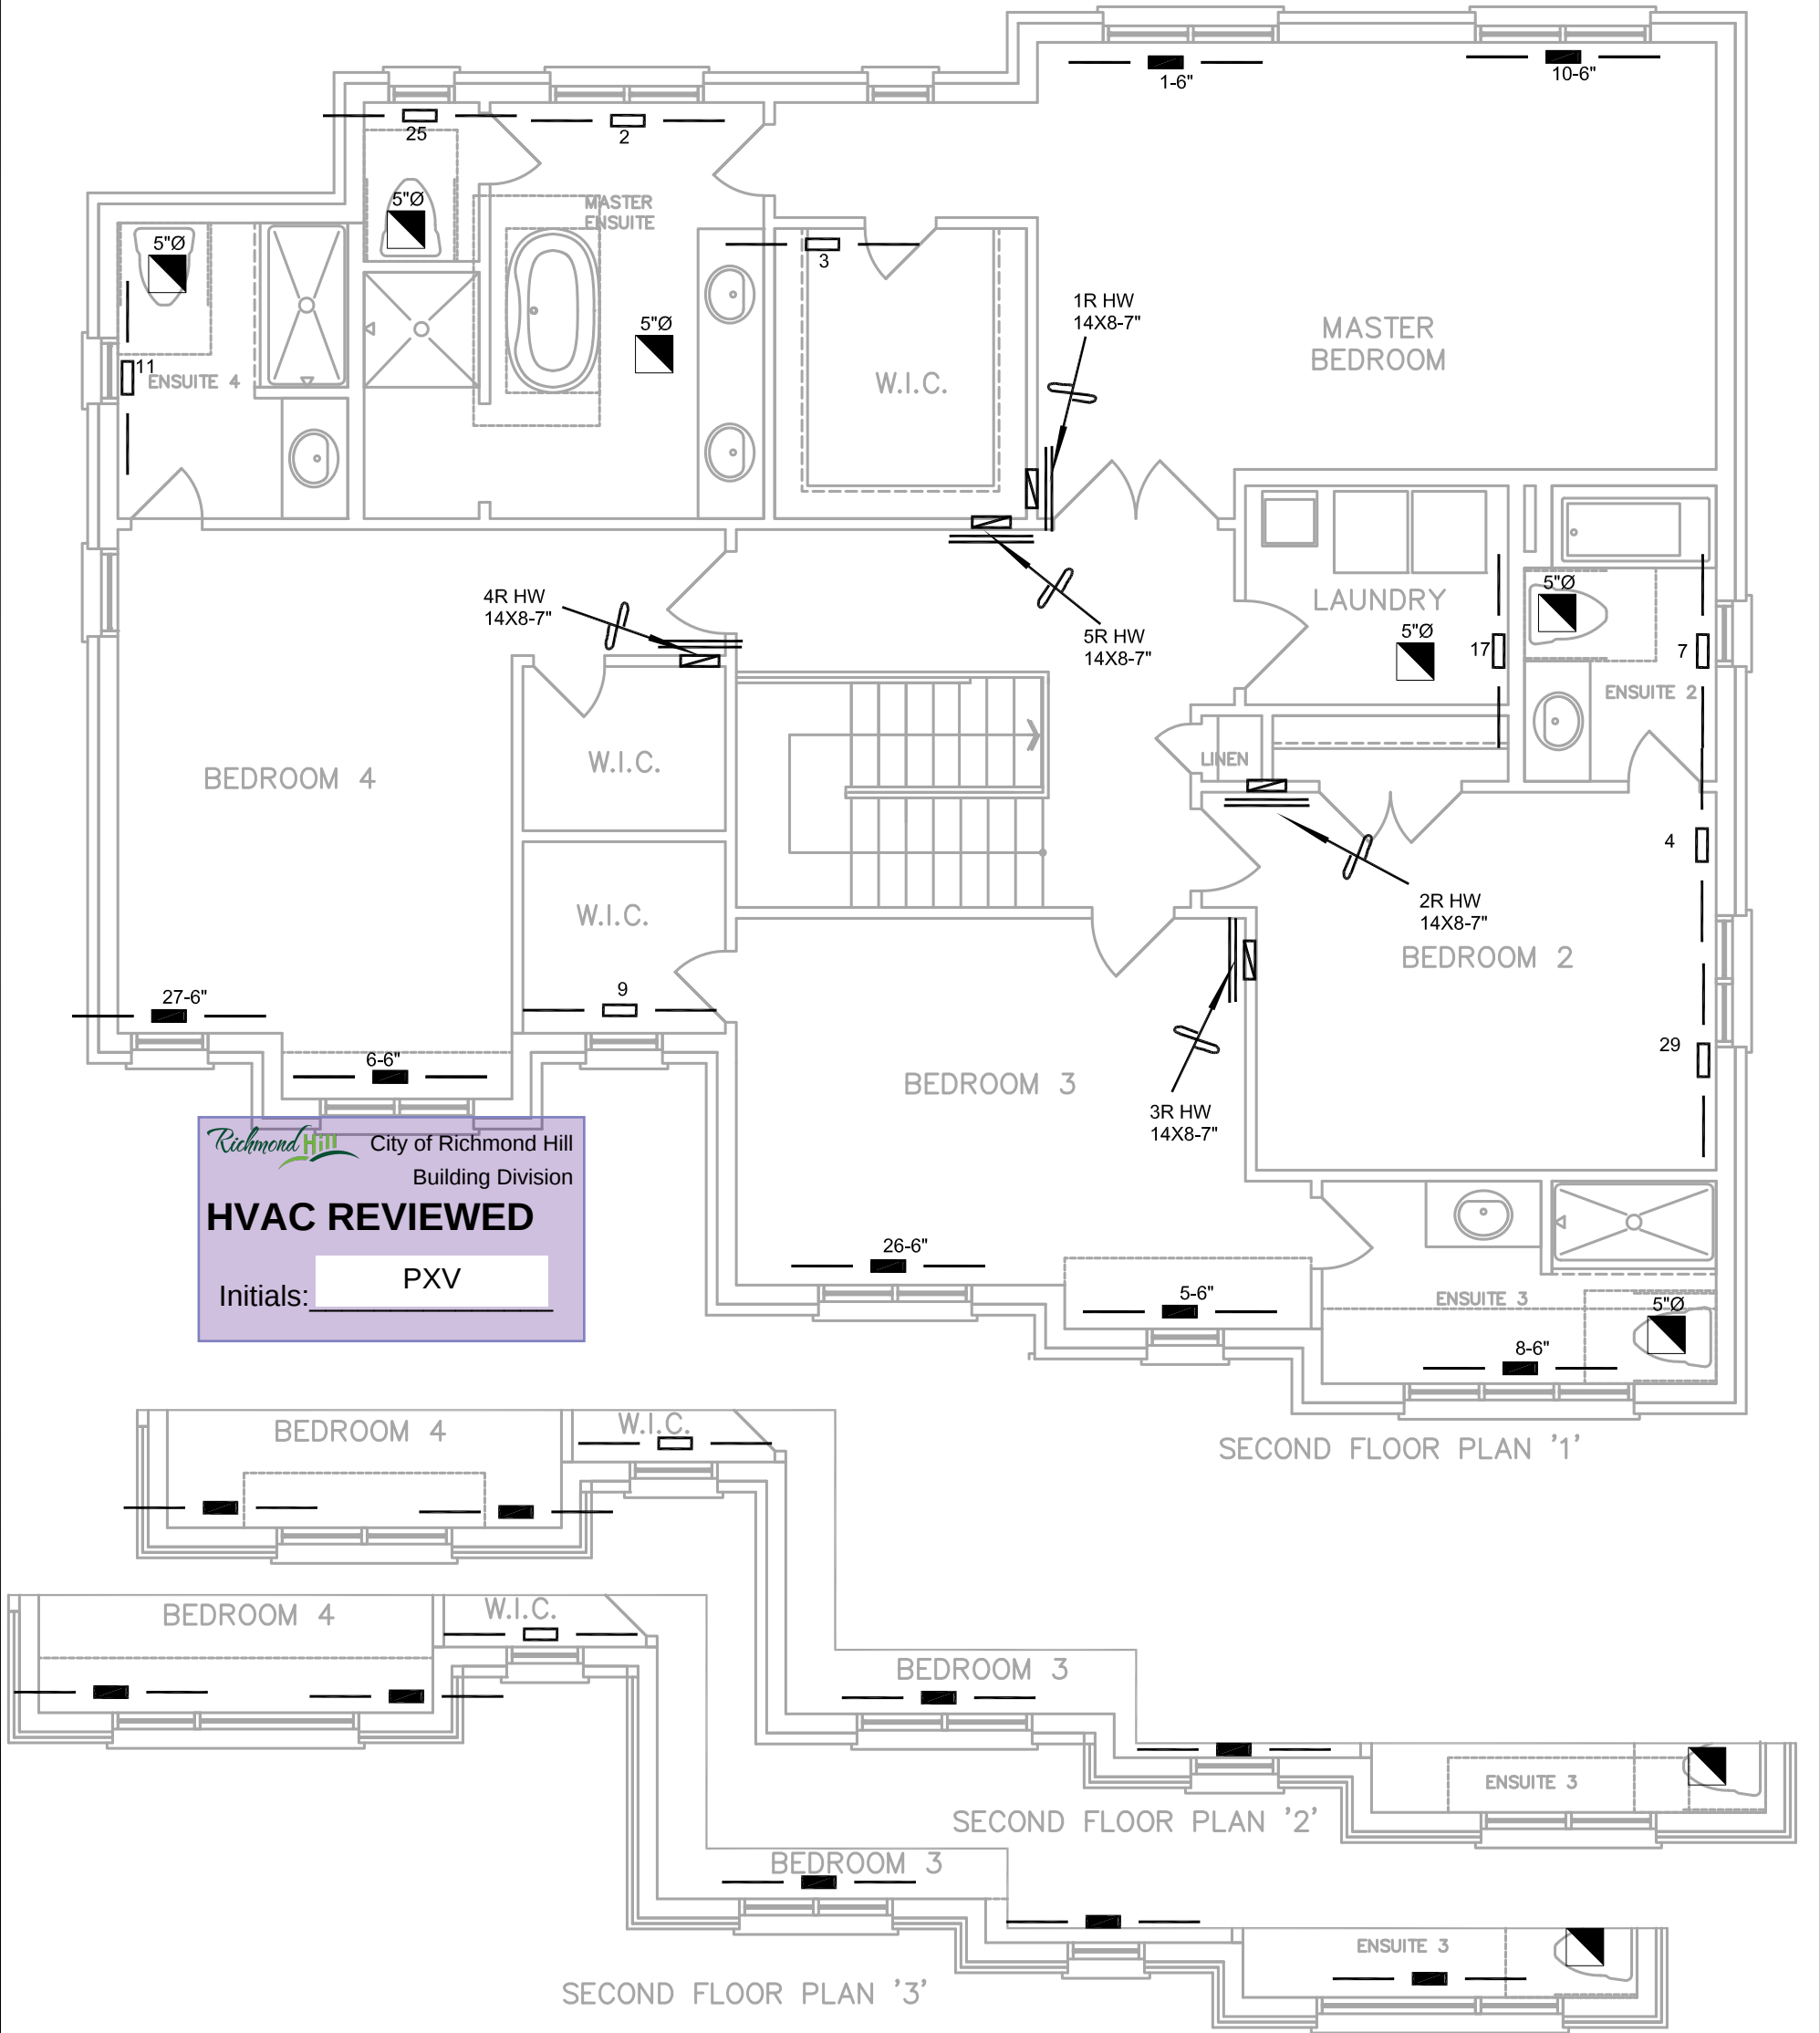

HVAC LEGEND							3.		
SYMBOL	DESCRIPTION	SYMBOL	DESCRIPTION	SYMBOL	DESCRIPTION	SYMBOL	DESCRIPTION	2.	
	SUPPLY AIR GRILLE		6" SUPPLY AIR BOOT ABOVE		14"x8" RETURN AIR GRILLE		RETURN AIR STACK ABOVE	1.	
	SUPPLY AIR GRILLE 6" BOOT		SUPPLY AIR STACK FROM 2nd FLOOR		30"x8" RETURN AIR GRILLE		RETURN AIR STACK 2nd FLOOR	No.	Description Date
	SUPPLY AIR BOOT ABOVE		6" SUPPLY AIR STACK 2nd FLOOR		FRA- FLOOR RETURN AIR GRILLE		REDUCER	REVISIONS	

ALL DRAWINGS, CALCULATIONS AND SPECIFICATIONS ARE THE PROPERTY OF HVAC DESIGNS LTD.© AND MAY NOT BE REPRODUCED, MODIFIED OR ALTERED WITHOUT EXPRESSED WRITTEN CONSENT. THE DRAWINGS ARE DATED AND USE OF THESE DRAWINGS AFTER ONE YEAR FROM THE DATED NOTED IS NOT AUTHORIZED. CONTRACTOR SHALL CHECK ALL CONDITIONS BEFORE PROCEEDING WITH WORK. LATEST MUNICIPAL APPROVED DRAWINGS ONLY TO BE USED DURING INSTALLATION OF HEATING SYSTEM. HVAC DESIGNS LTD. IS NOT LIABLE FOR ANY CLAIMS ARISING FROM UNAUTHORIZED USE OF THE DRAWINGS OR FROM ANY CHANGES TO ACCEPTED STANDARDS AND/OR THE ONTARIO BUILDING CODE.

I Michael O'Rourke have reviewed and take responsibility for the design work and am qualified under division C.3.2.5 of the building code.

Michael O'Rourke
Michael O'Rourke BCIN # 19669
HVAC Designs Ltd.

PACKAGE A1

Sheet Title
SECOND FLOOR HEATING LAYOUT

CITY OF RICHMOND HILL BUILDING DIVISION

Date DEC/2023

Scale 3/16" = 1'-0"

05/01/2024

BCIN# 19669

LO# 103548

Per: joshua.nabua

Client
GREEN PARK HOMES

Project Name
TRINIGROUP RICHMOND HILL, ONTARIO

ROSE 9A **3315 sqft**

HVACDESIGNS LTD.

375 Finley Ave. Suite 202 - Ajax, Ontario
L1S 2E2 Tel. 905.619.2300 - 905.420.5300 Fax 905.619.2375
Email: info@hvacdsgns.ca
Web: www.hvacdsgns.ca

Specializing in Residential Mechanical Design Services

Installation to comply with the latest Ontario Building Code. All supply branch outlets shall be equipped with a manual balancing damper. Ductwork which passes through the garage or unheated spaces shall be adequately insulated and be gas-proofed.