

HARRINGTON STREET


(BY REGISTERED PLAN 51M-1088)
PIN 58065-0811(LT)

SURVEYOR'S REAL PROPERTY REPORT

PART 1:

PLAN OF
LOTS 27, 28, 29, AND 30
REGISTERED PLAN 51M-1088
TOWN OF INNISFIL
COUNTY OF SIMCO

SCALE 1:300

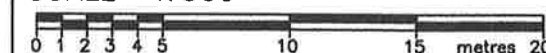

2021 © HUNT SURVEYS INC.

PART 2: THIS REPORT WAS PREPARED FOR
LORMEL HOMES.

TITLE SEARCH INDICATES THE FOLLOWING:
NO REGISTERED EASEMENTS OR RIGHTS-OF-WAY

METRIC: DISTANCES SHOWN ON THIS PLAN ARE IN METRES AND CAN BE CONVERTED TO FEET BY DIVIDING BY 0.3048

LEGEND

■	DENOTES	SURVEY MONUMENT FOUND
□	//	SURVEY MONUMENT PLANTED
SIB	//	STANDARD IRON BAR
IB	//	IRON BAR
P	//	REGISTERED PLAN 51M-1088
(1534)	//	DOUGLAS E. HUNT O.L.S.

BEARINGS: BEARINGS ARE ASTRONOMIC AND ARE REFERRED TO THE EASTERLY LIMIT OF HARRINGTON STREET, AS SHOWN ON PLAN 51M-1088 HAVING A BEARING OF N42°08'55"E.

SURVEYOR'S CERTIFICATE

I CERTIFY THAT:

1. This survey and plan are correct and in accordance with the Surveys Act, the Surveyors Act, the Land Titles Act and the regulations made under them.
2. The survey was completed on November 1, 2021.

DATE: November 12 , 2021

Douglas E. Hunt
Douglas E. Hunt
ONTARIO LAND SURVEYOR

HUNT SURVEYS INC.
ONTARIO LAND SURVEYORS

1234 REID STREET, UNIT 7/9A, RICHMOND HILL, ON.
L4B 2P2. Tel: (905) 764-8759 Fax: (905) 764-6812
Email : huntsurveys@rogers.com

SURVEY BY: E.S.	CHECKED BY: D.E.H	FILE: 65250 SRPR_27 to 30.dwg
CAD : O.C.	LOTS 27 to 30	PROJECT #: 065250 Ph 2 srpr

