


ASSOCIATION OF ONTARIO
LAND SURVEYORS
PLAN SUBMISSION FORM
2140749

THIS PLAN IS NOT VALID
UNLESS IT IS AN EMBOSSED
ORIGINAL COPY
ISSUED BY THE SURVEYOR
In accordance with
Regulation 1026, Section 29(3).

NOTE: ALL TIES ARE TO THE
CONCRETE FOUNDATION

SURVEYOR'S REAL PROPERTY REPORT
PART 1:
PLAN OF
LOTS 66, 67, 68, AND 70
REGISTERED PLAN 51M-1088
TOWN OF INNISFIL
COUNTY OF SIMCOE

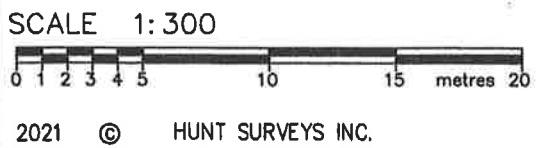

PART 2: THIS REPORT WAS PREPARED FOR
LORMEL HOMES.

TITLE SEARCH INDICATES THE FOLLOWING:
NO REGISTERED EASEMENTS OR RIGHTS-OF-WAY

METRIC: DISTANCES SHOWN ON THIS PLAN ARE IN
METRES AND CAN BE CONVERTED TO
FEET BY DIVIDING BY 0.3048

LEGEND		
■	DENOTES	SURVEY MONUMENT FOUND
□	//	SURVEY MONUMENT PLANTED
SIB	//	STANDARD IRON BAR
IB	//	IRON BAR
P	//	REGISTERED PLAN 51M-1088
(1534)	//	DOUGLAS E. HUNT O.L.S.

BEARINGS: BEARINGS ARE ASTRONOMIC AND ARE
REFERRED TO THE WESTERLY LIMIT OF HARRINGTON STREET, AS
SHOWN ON PLAN 51M-1088 HAVING A BEARING OF N42°08'55"E.

SURVEYOR'S CERTIFICATE
I CERTIFY THAT:
1. This survey and plan are correct and in accordance
with the Surveys Act, the Surveyors Act, the Land Titles
Act and the regulations made under them.
2. The survey was completed on November 1, 2021.
DATE: November 24, 2021
Douglas E. Hunt
Douglas E. Hunt
ONTARIO LAND SURVEYOR

HUNT SURVEYS INC.
ONTARIO LAND SURVEYORS

1234 REID STREET, UNIT 7/9A, RICHMOND HILL, ON.
L4B 2P2. Tel: (905) 764-8759 Fax: (905) 764-6812
Email: huntsurveys@rogers.com

SURVEY BY: E.S.	CHECKED BY: D.E.H	FILE: 65250 srpr_66 to 68, 70.dwg
CAD: O.C.	LOTS 66-68, 70	PROJECT #: 085250 Ph 2 srpr

