47' DESIGNS

The **Kahshe** / Elev. A & B

3000 sq.ft.

Lot 2-27,
PE-005

E.Raitha
Rasitha ehamparam (Aug 18, 2021 17:52 EDT)

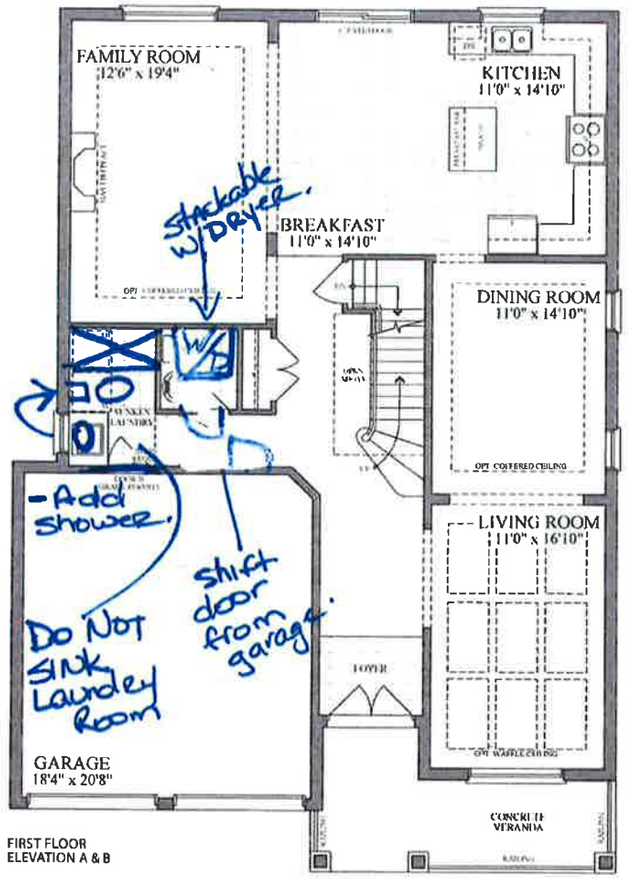

FIRST FLOOR
ELEVATION A & B

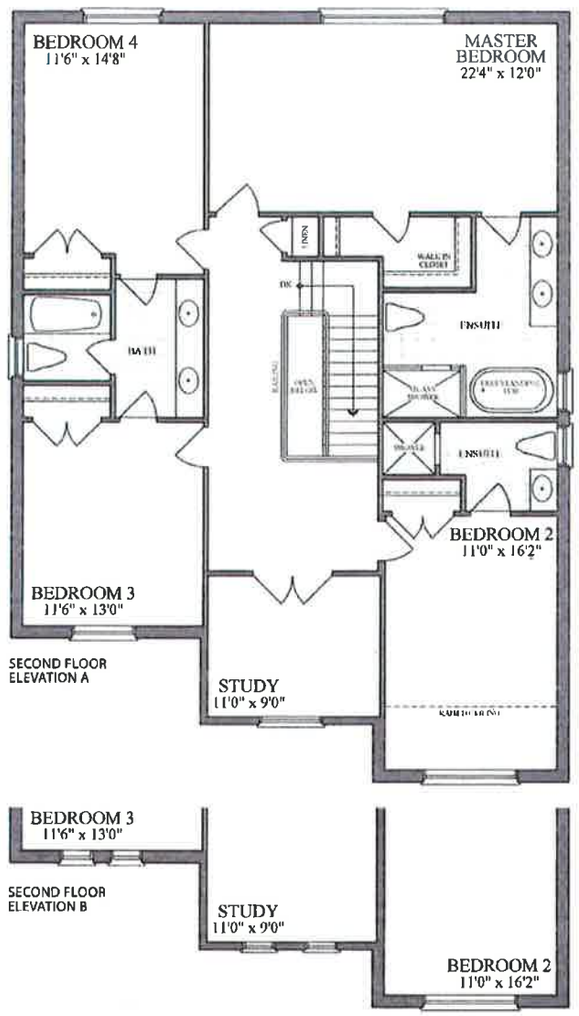

SECOND FLOOR
ELEVATION A

SECOND FLOOR
ELEVATION B

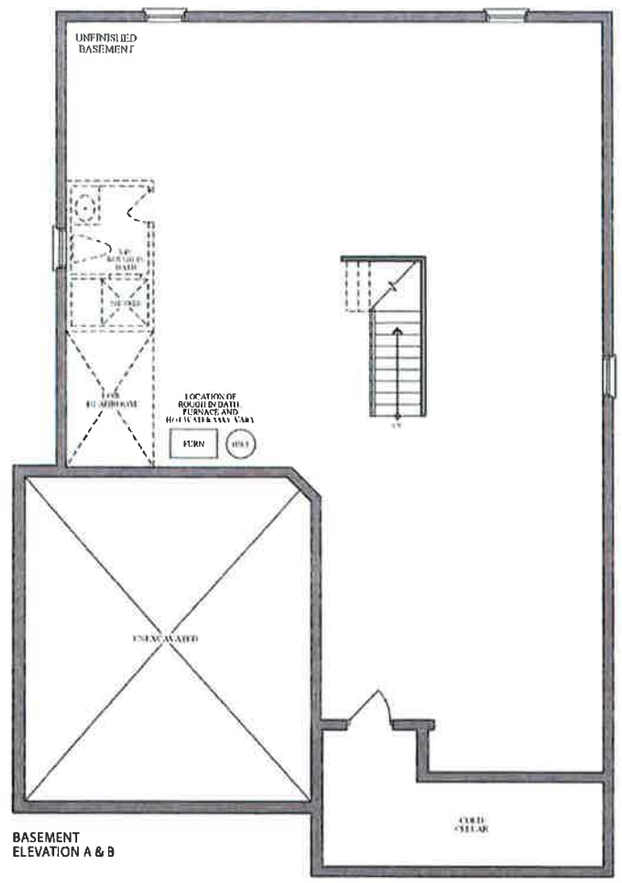

BASEMENT
ELEVATION A & B

the trails at CARSON'S CREEK

Plans and specifications are subject to change without notice. E. & O. E. Actual usable floor space may vary from the stated floor area. All renderings are artist's concept