


The Finlay / Elev. A & B
2515 sq.ft.

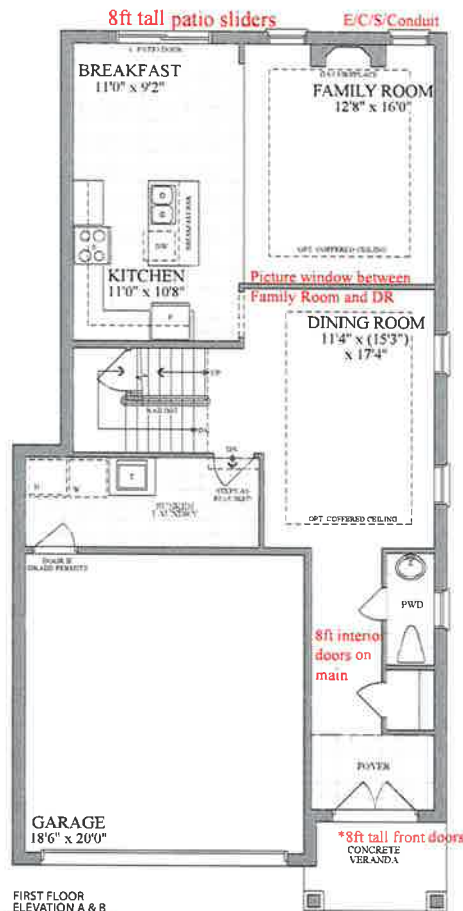


FIRST FLOOR
ELEVATION A & B
LOT 2-69, PE002, SKETCH
Van Viet Le
Purchaser: *Van Viet Le* (Sep 24, 2021 13:00 EDT)

Purchaser




Plans and specifications are subject to change without notice. E. & O. E. Actual usable floor space may vary from the stated floor area. All renderings are artist's concept.

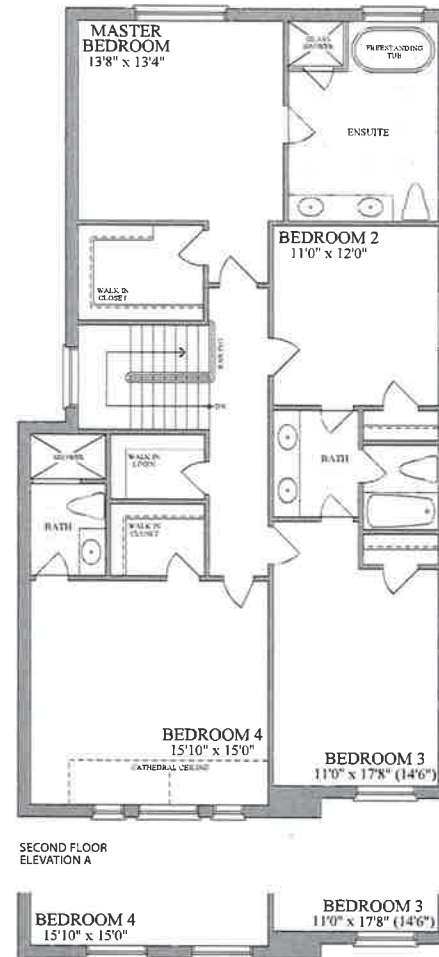

SECOND FLOOR
ELEVATION A

SECOND FLOOR
ELEVATION B

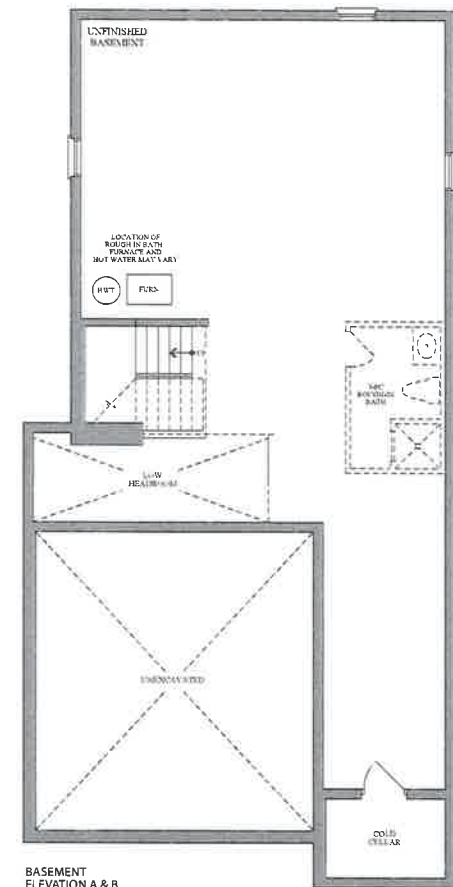

BASEMENT
ELEVATION A & B