



38'
DESIGNS

The Manitou / Elev. A & B
2480 sq.ft.

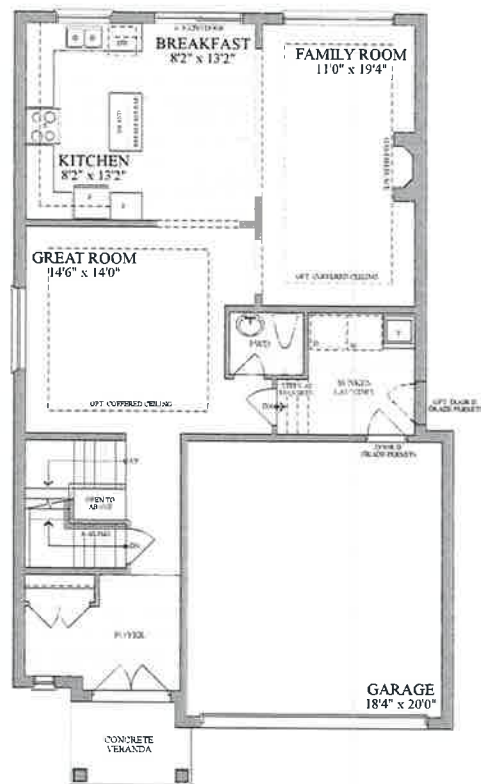


FIRST FLOOR
ELEVATION A & B

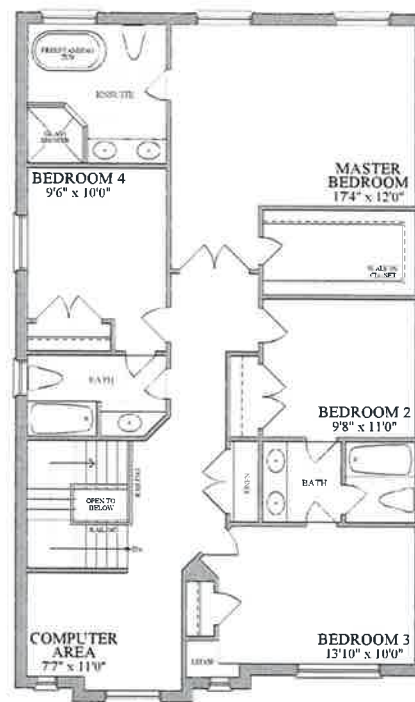

SECOND FLOOR
ELEVATION A



SECOND FLOOR
ELEVATION B

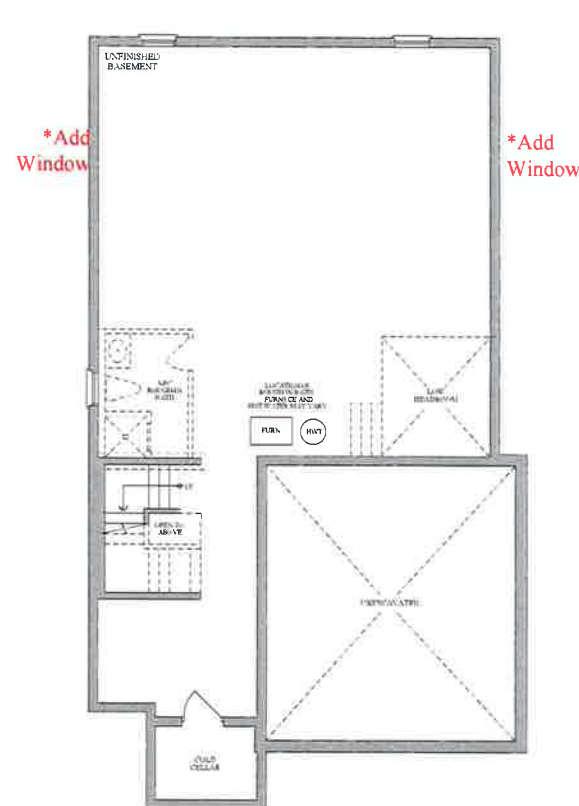

BASEMENT
ELEVATION A & B

LOT 5-34, PH5, PE002

PURCHASER: HIU TUNG CHAN (Oct 1, 2021 17:55 EDT)

PURCHASER: Hue Chan



Plans and specifications are subject to change without notice. E. & O. L. Actual usable floor space may vary from the stated floor area. All renderings are artist's concept.

