
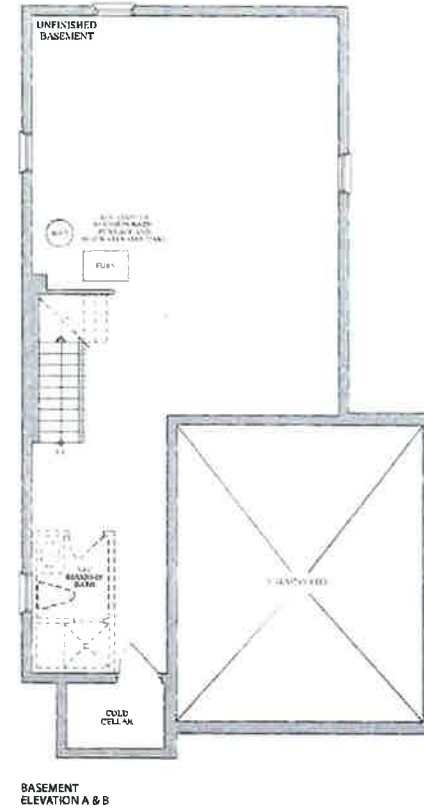


38'
DESIGNS

The **Buckhorn** / Elev. A & B
1800 sq.ft.

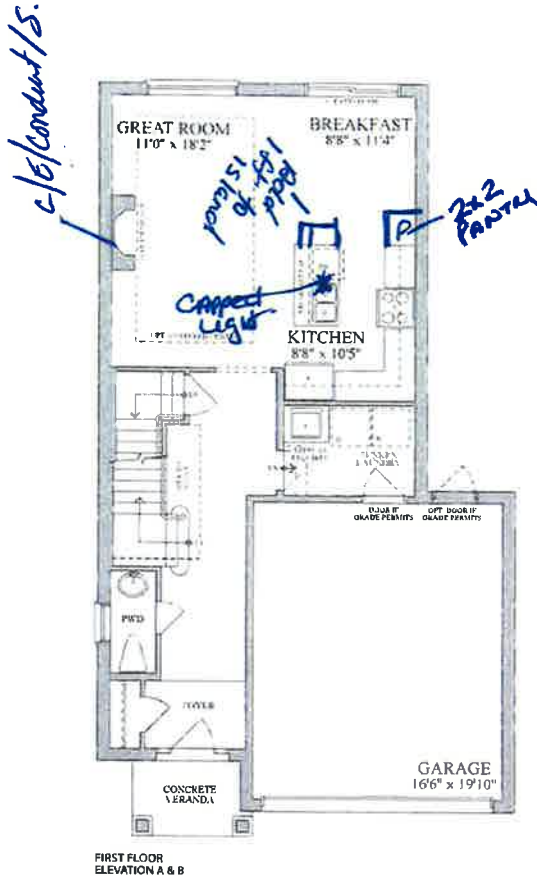

Plans and specifications are subject to change without notice. © 2021. All rights reserved. Floor space may vary from the stated floor area. All measurements are in feet and inches.

LOT 5-35, PH5, PE002, SKETCH

PURCHASER: Asya Levin
Asya Levin (Oct 6, 2021 21:20 EDT)