

38'
DESIGNS

2480 sq.ft.

The Manitou / Elev. A & B




Future Chimney
hood fan,
center vent
as much as
possible

Future: Look up!

Reduce size
of opening
between
Great Rm/
breakfast area

* Plus 3' ft of upper + lower cabinets

Future:
WALL OVENS

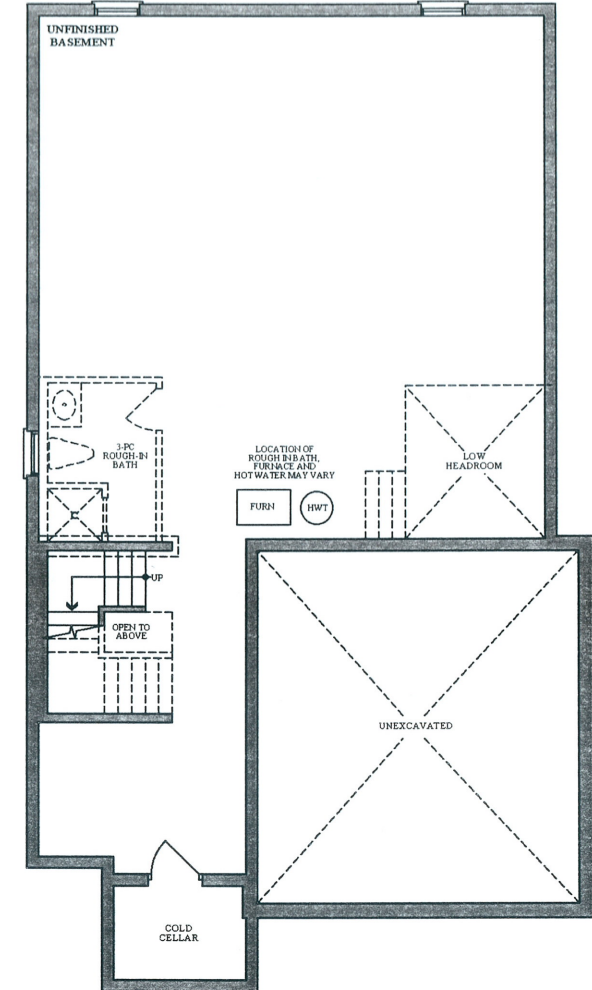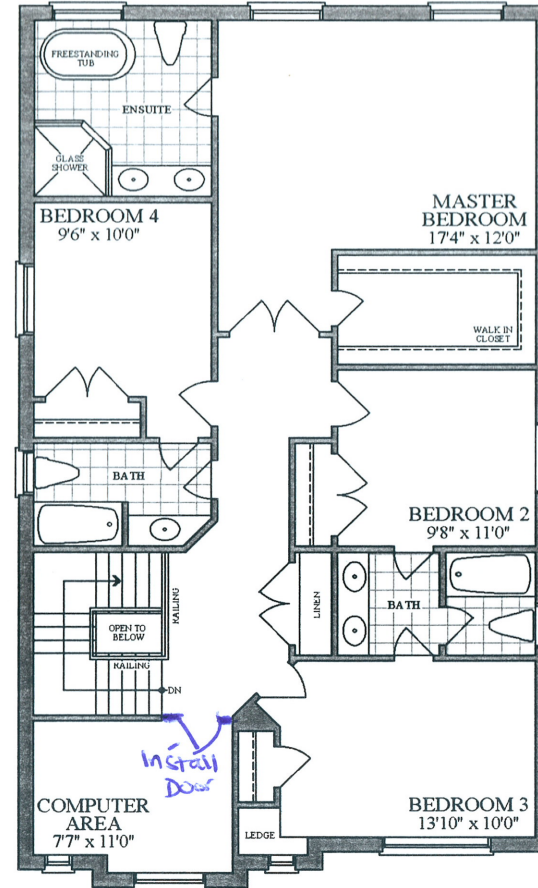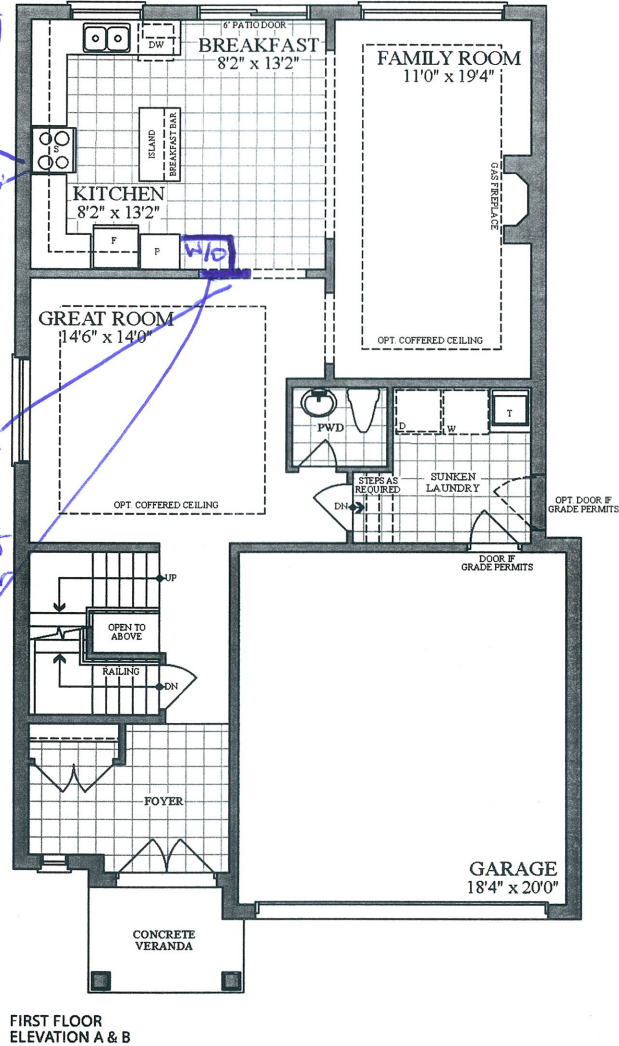

Plans and specifications are subject to change without notice. E. & O. E. Actual usable floor space may vary from the stated floor area. All renderings are artist's concept.