


38'
DESIGNS

The mantou / Elev. A & B
2480 sq.ft.

Remove wall, add railing & pickets
Add window at stairs between main & 2nd
Relocate closet - Remove wall, add railing & pickets

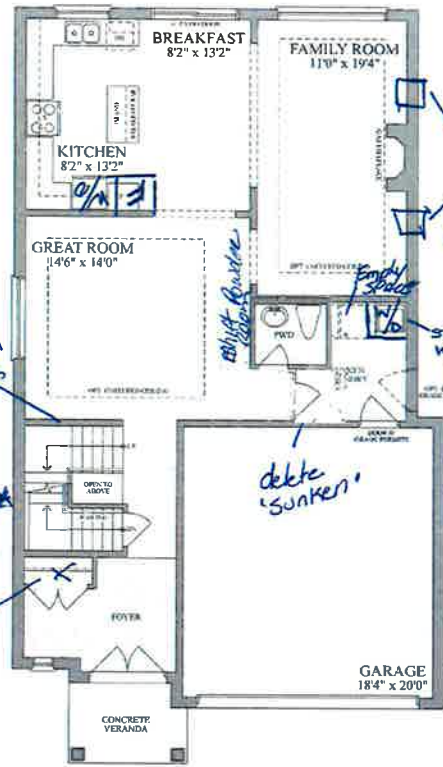


FIRST FLOOR
ELEVATION A & B



SECOND FLOOR
ELEVATION A



SECOND FLOOR
ELEVATION B

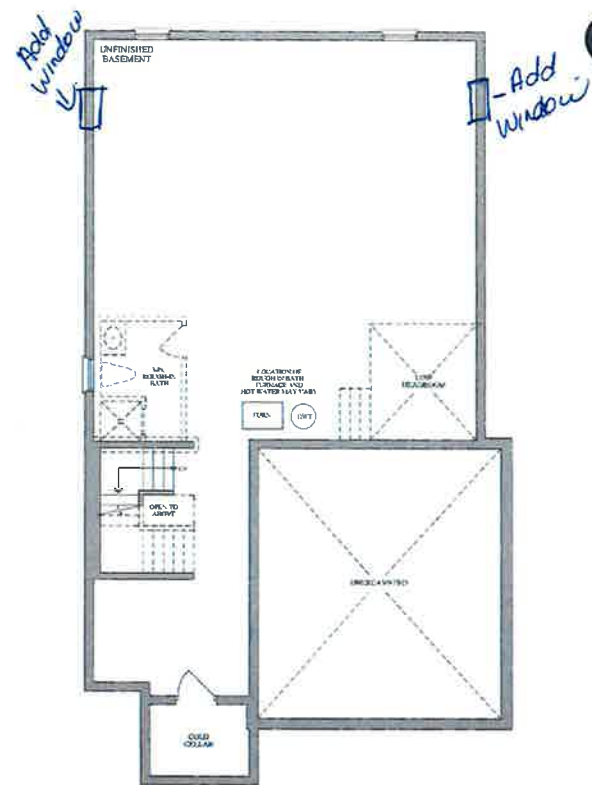

BASEMENT
ELEVATION A & B



Plans and specifications are subject to change without notice. E. & O. E. Actual usable floor space may vary from the stated floor area. No renderings are artist's concept.

LOT 5-76, PH5, PE003, SKETCH

Ali Afshar

PURCHASER: Ali Afshar (Oct 13, 2021 16:36 EDT)

Nargis Hussaini

PURCHASER: Nargis Hussaini (Oct 13, 2021 16:37 EDT)

