


38'
DESIGNS

The manitou / Elev. A & B
2480 sq.ft.

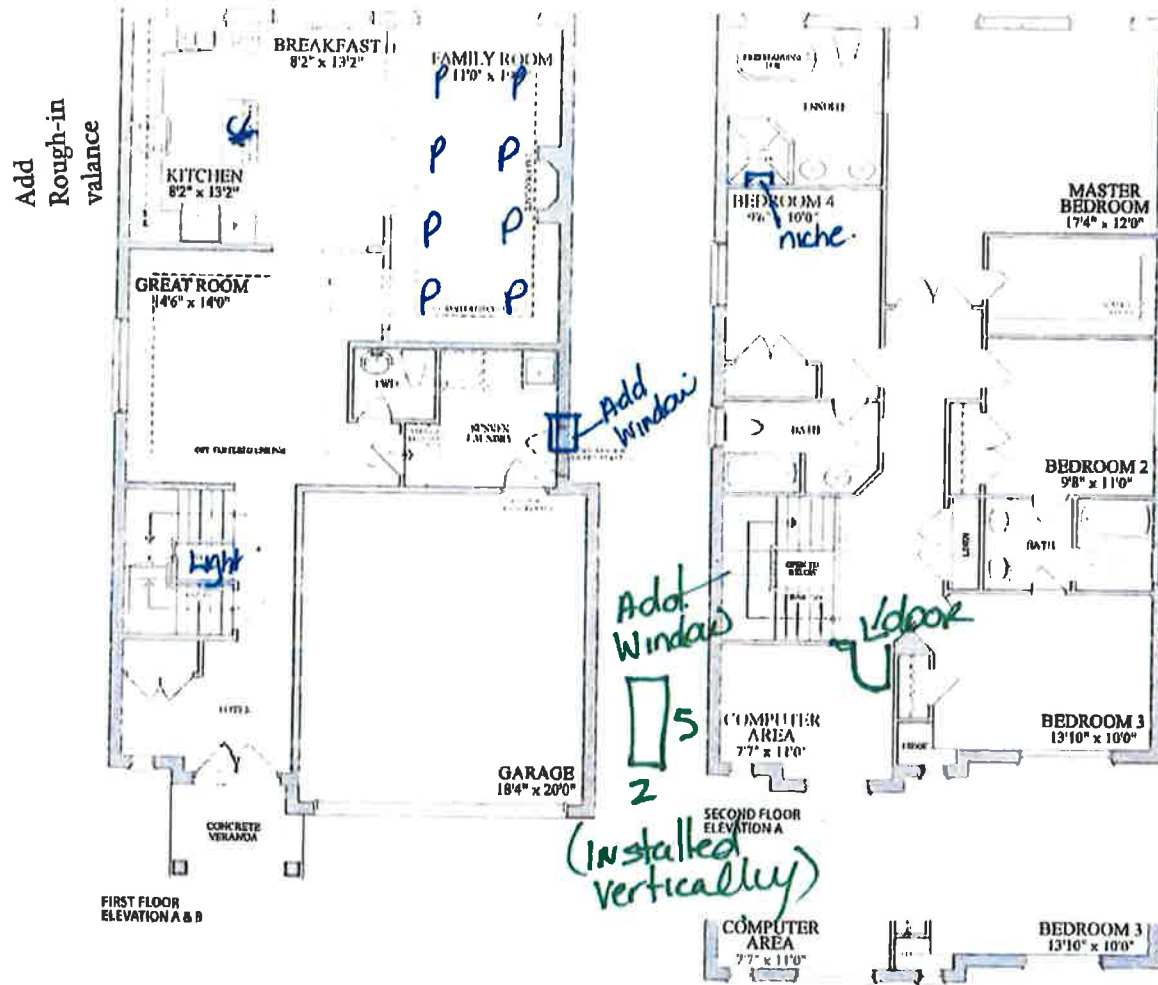

Please note: This is a conceptual sketch only. It is not a final plan. All dimensions are approximate. All rights reserved. All other trademarks are the property of their respective owners.




SECOND FLOOR
ELEVATION B

LOT 5-88, PE003, SKETCH

kenneth egede

Purchaser: kenneth egede (Nov 24, 2021 12:04 EST)

Purchaser: _____

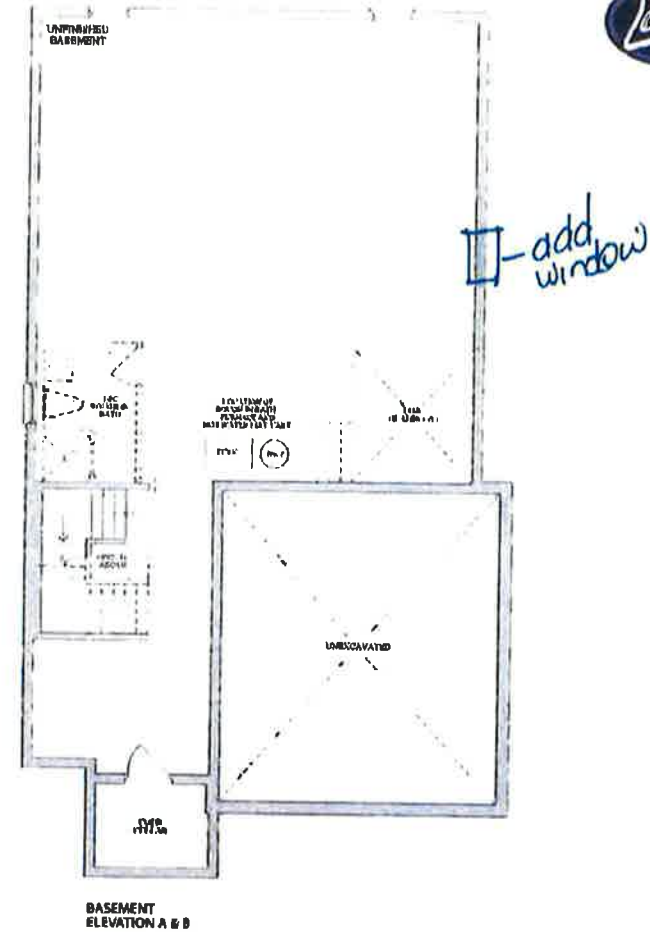

BASEMENT
ELEVATION A & B

LOT 5-88, PE003, SKETCH

kenneth egede

PURCHASER: kenneth egede (Nov 2, 2021 12:13 EDT)

PURCHASER: _____