
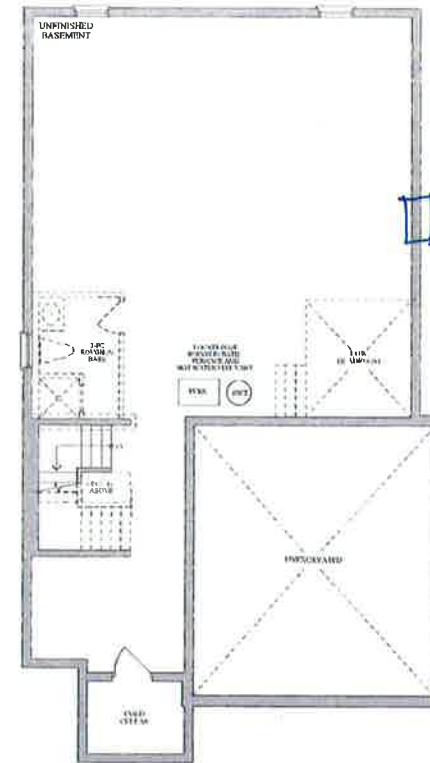


38'
DESIGNS

The Manitou / Elev. A & B
2480 sq.ft.

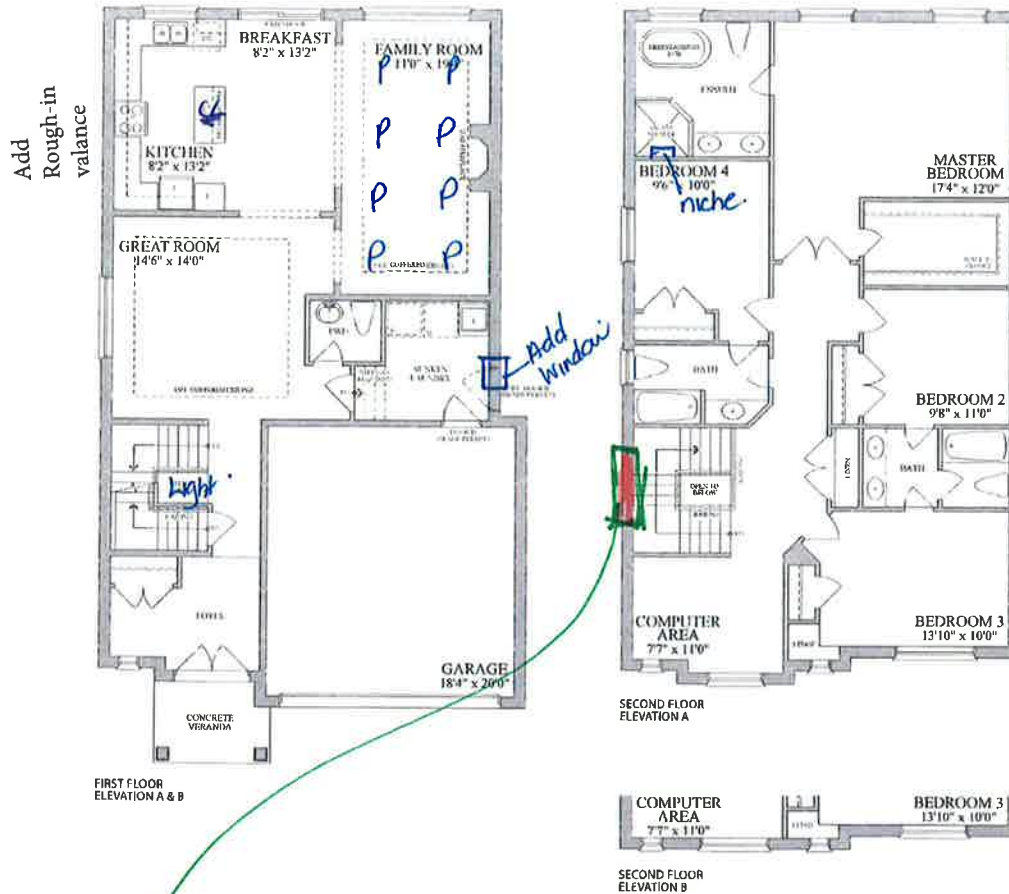


LOT 5-88, PE002, SKETCH

PURCHASER _____

PURCHASER _____

✓ The only option for a window at the stairs is a small 2x5 window

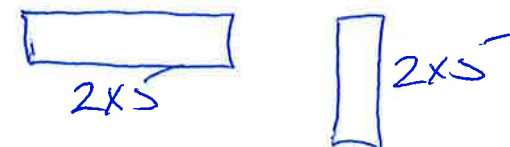

Cost is \$900⁰⁰ - Includes window, trim, labour.