LOT 109, Phase 3
BRADFORD

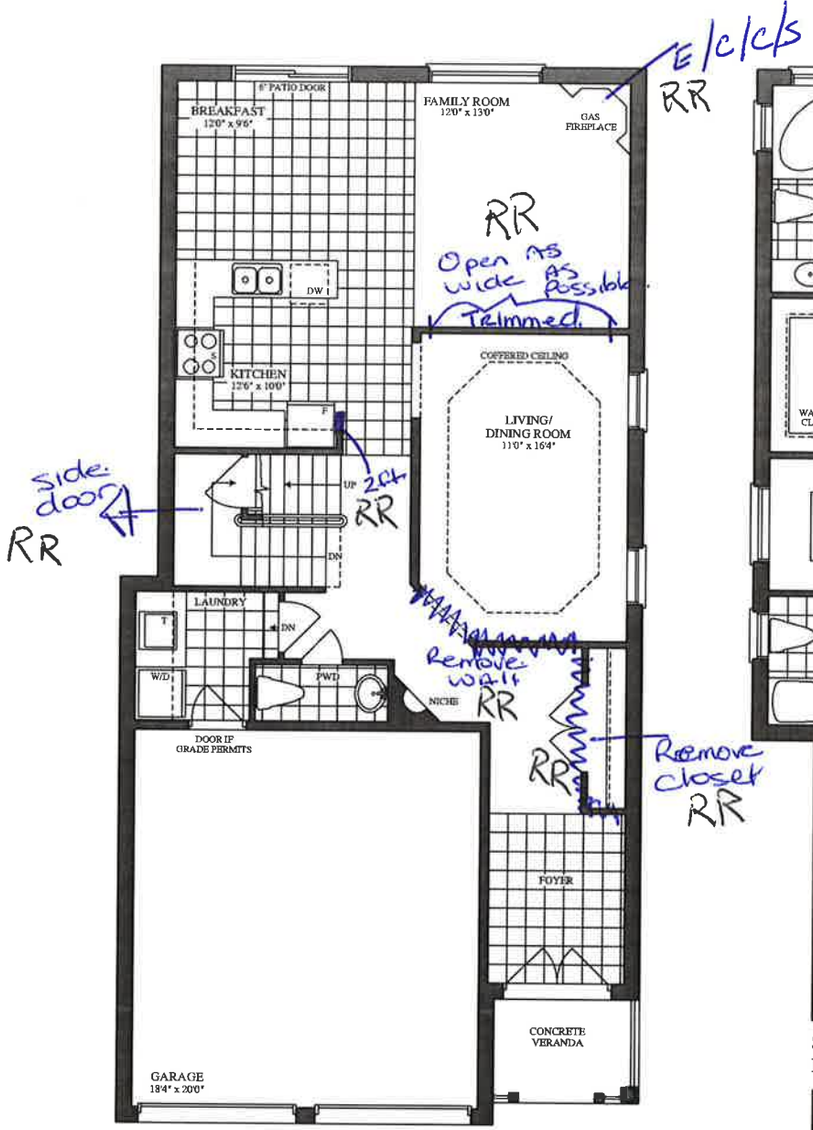

FIRST FLOOR
ELEVATION A, B, C

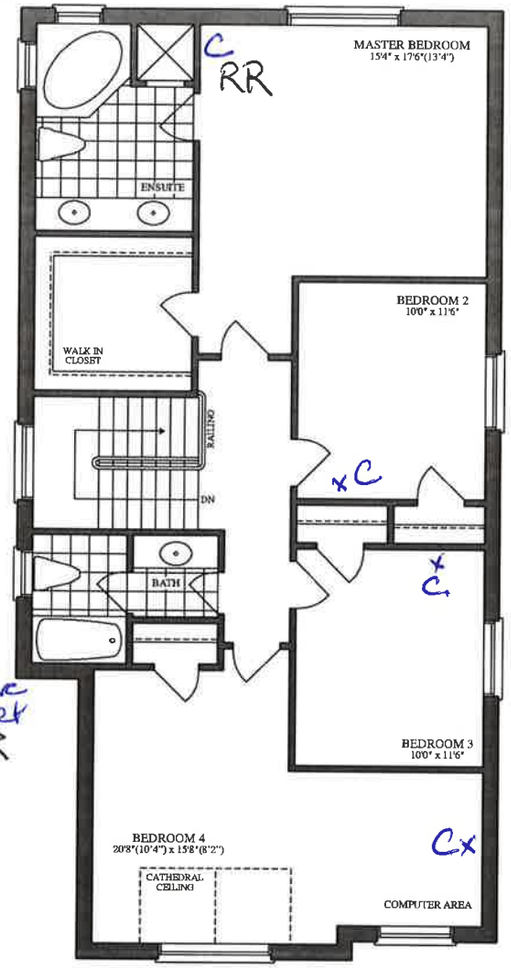

SECOND FLOOR
ELEVATION A

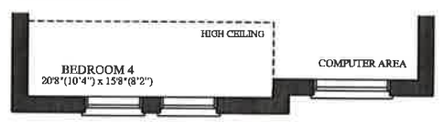

SECOND FLOOR
ELEVATION B

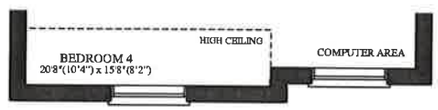

SECOND FLOOR
ELEVATION C

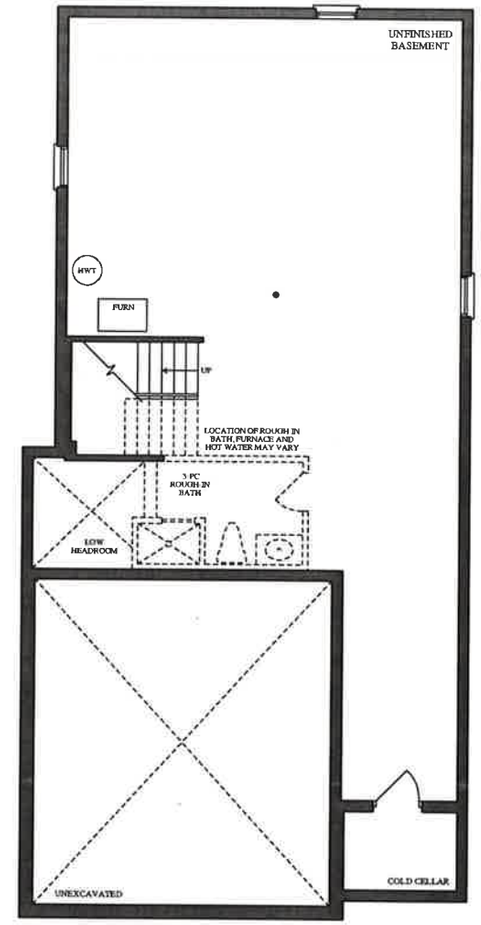
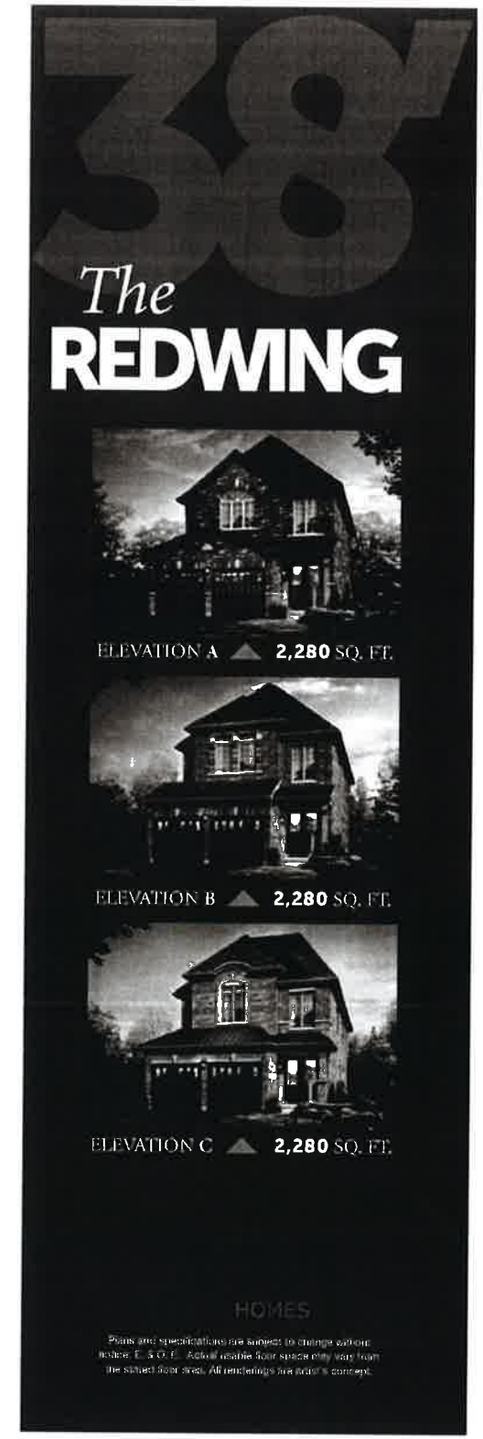
BASEMENT
ELEVATION A, B, C