


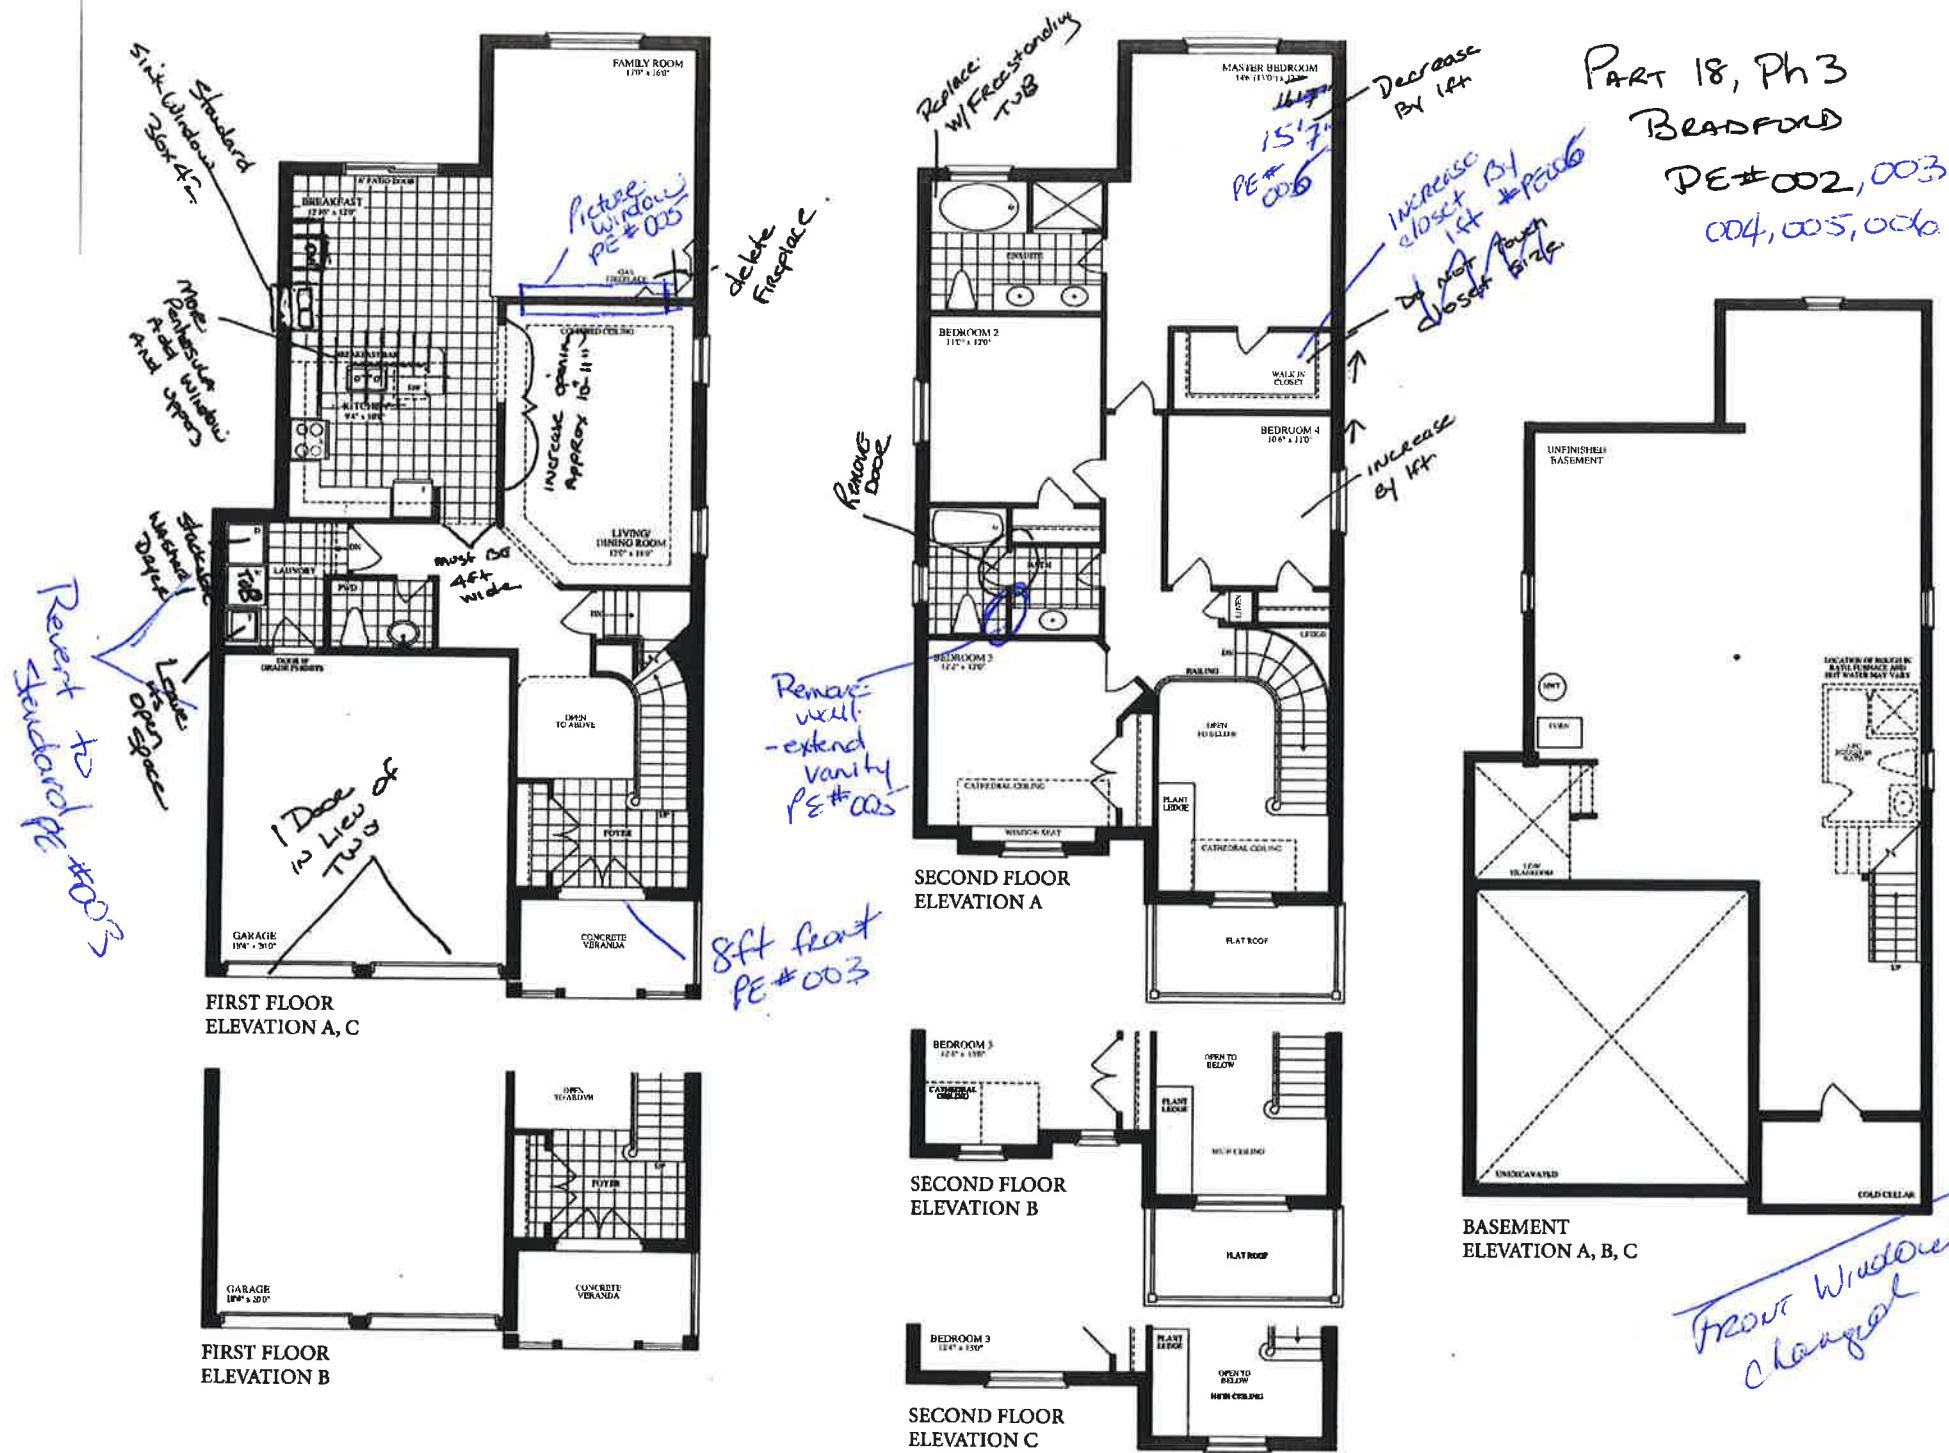

The HONEYWOOD



ELEVATION A 2,480 SQ. FT.



ELEVATION B 2,480 SQ. FT.



ELEVATION C 2,480 SQ. FT.

Some specifications are subject to change without notice. All dimensions are approximate and subject to change.