
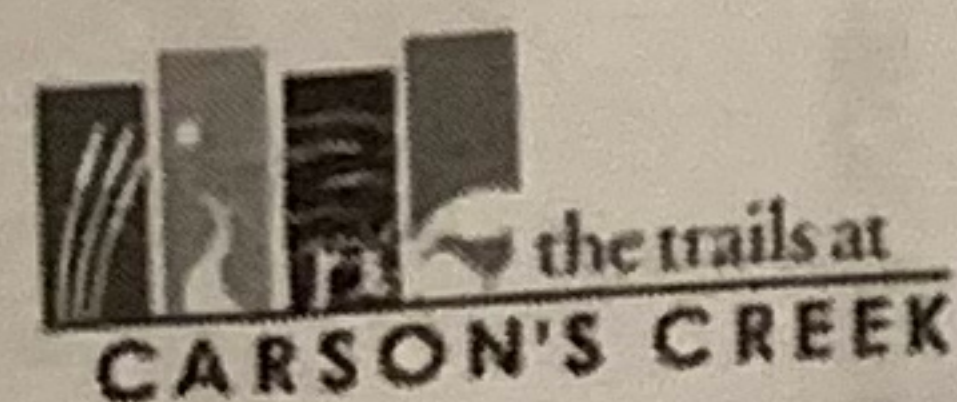
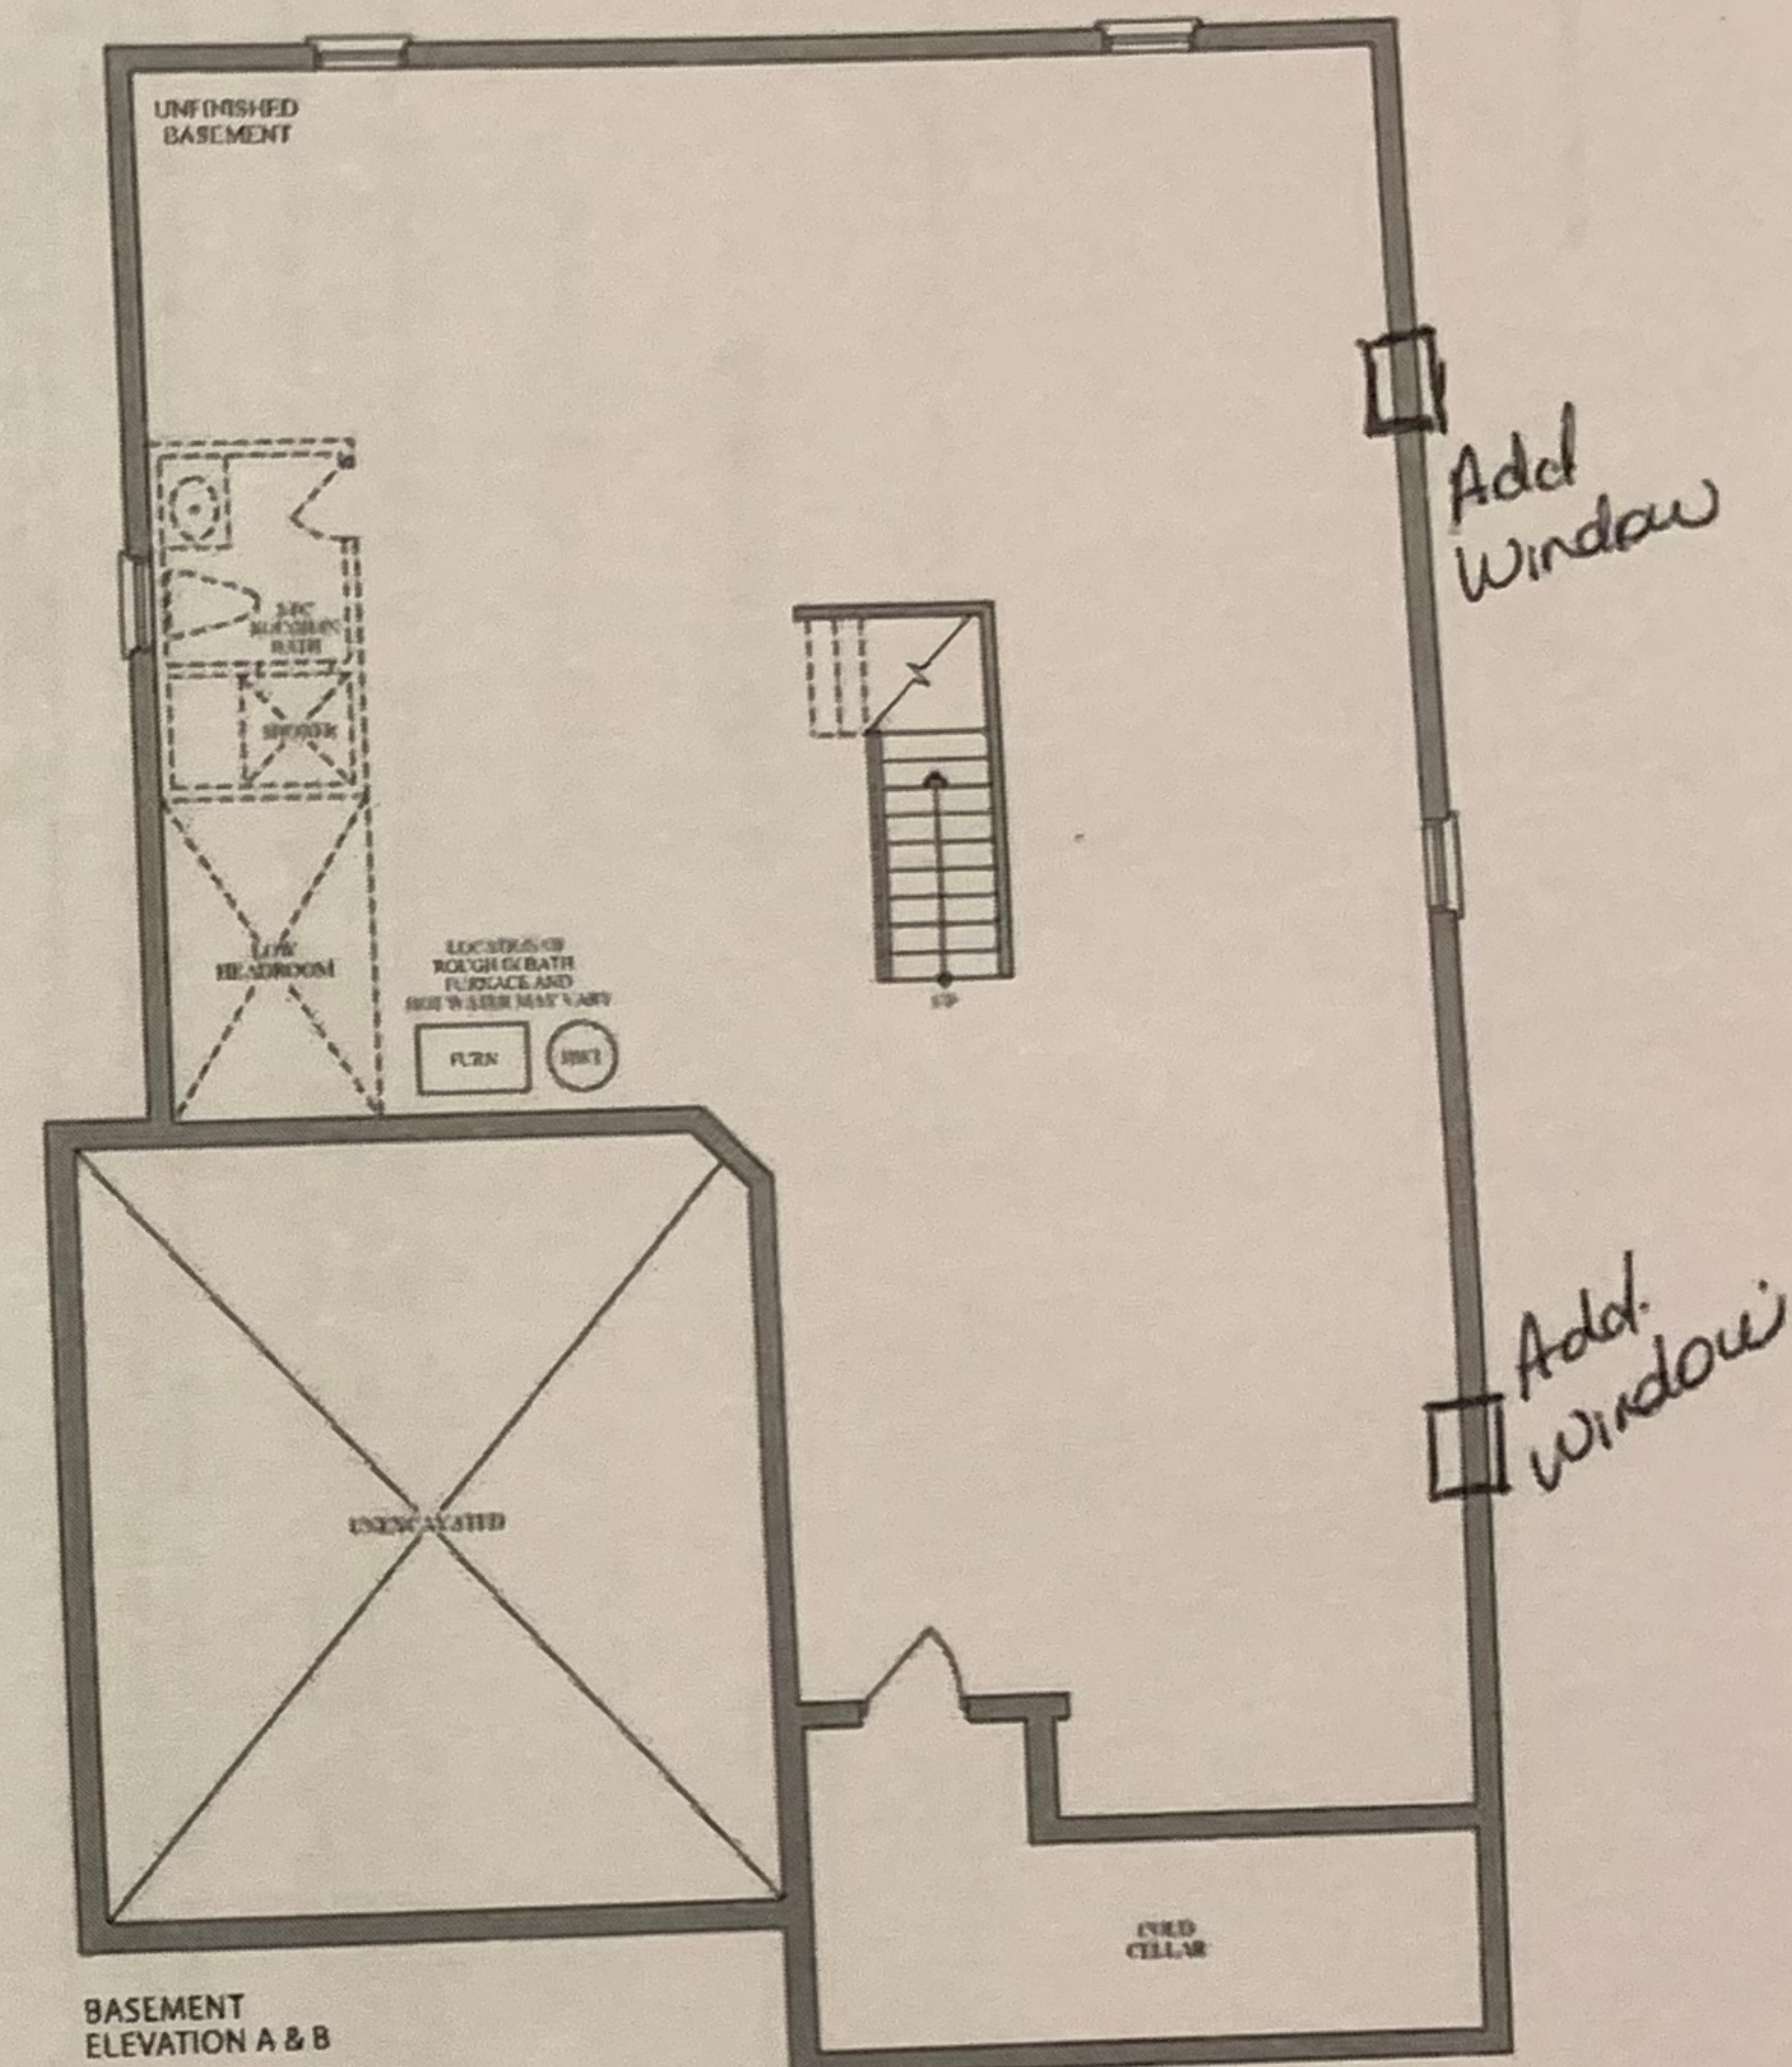
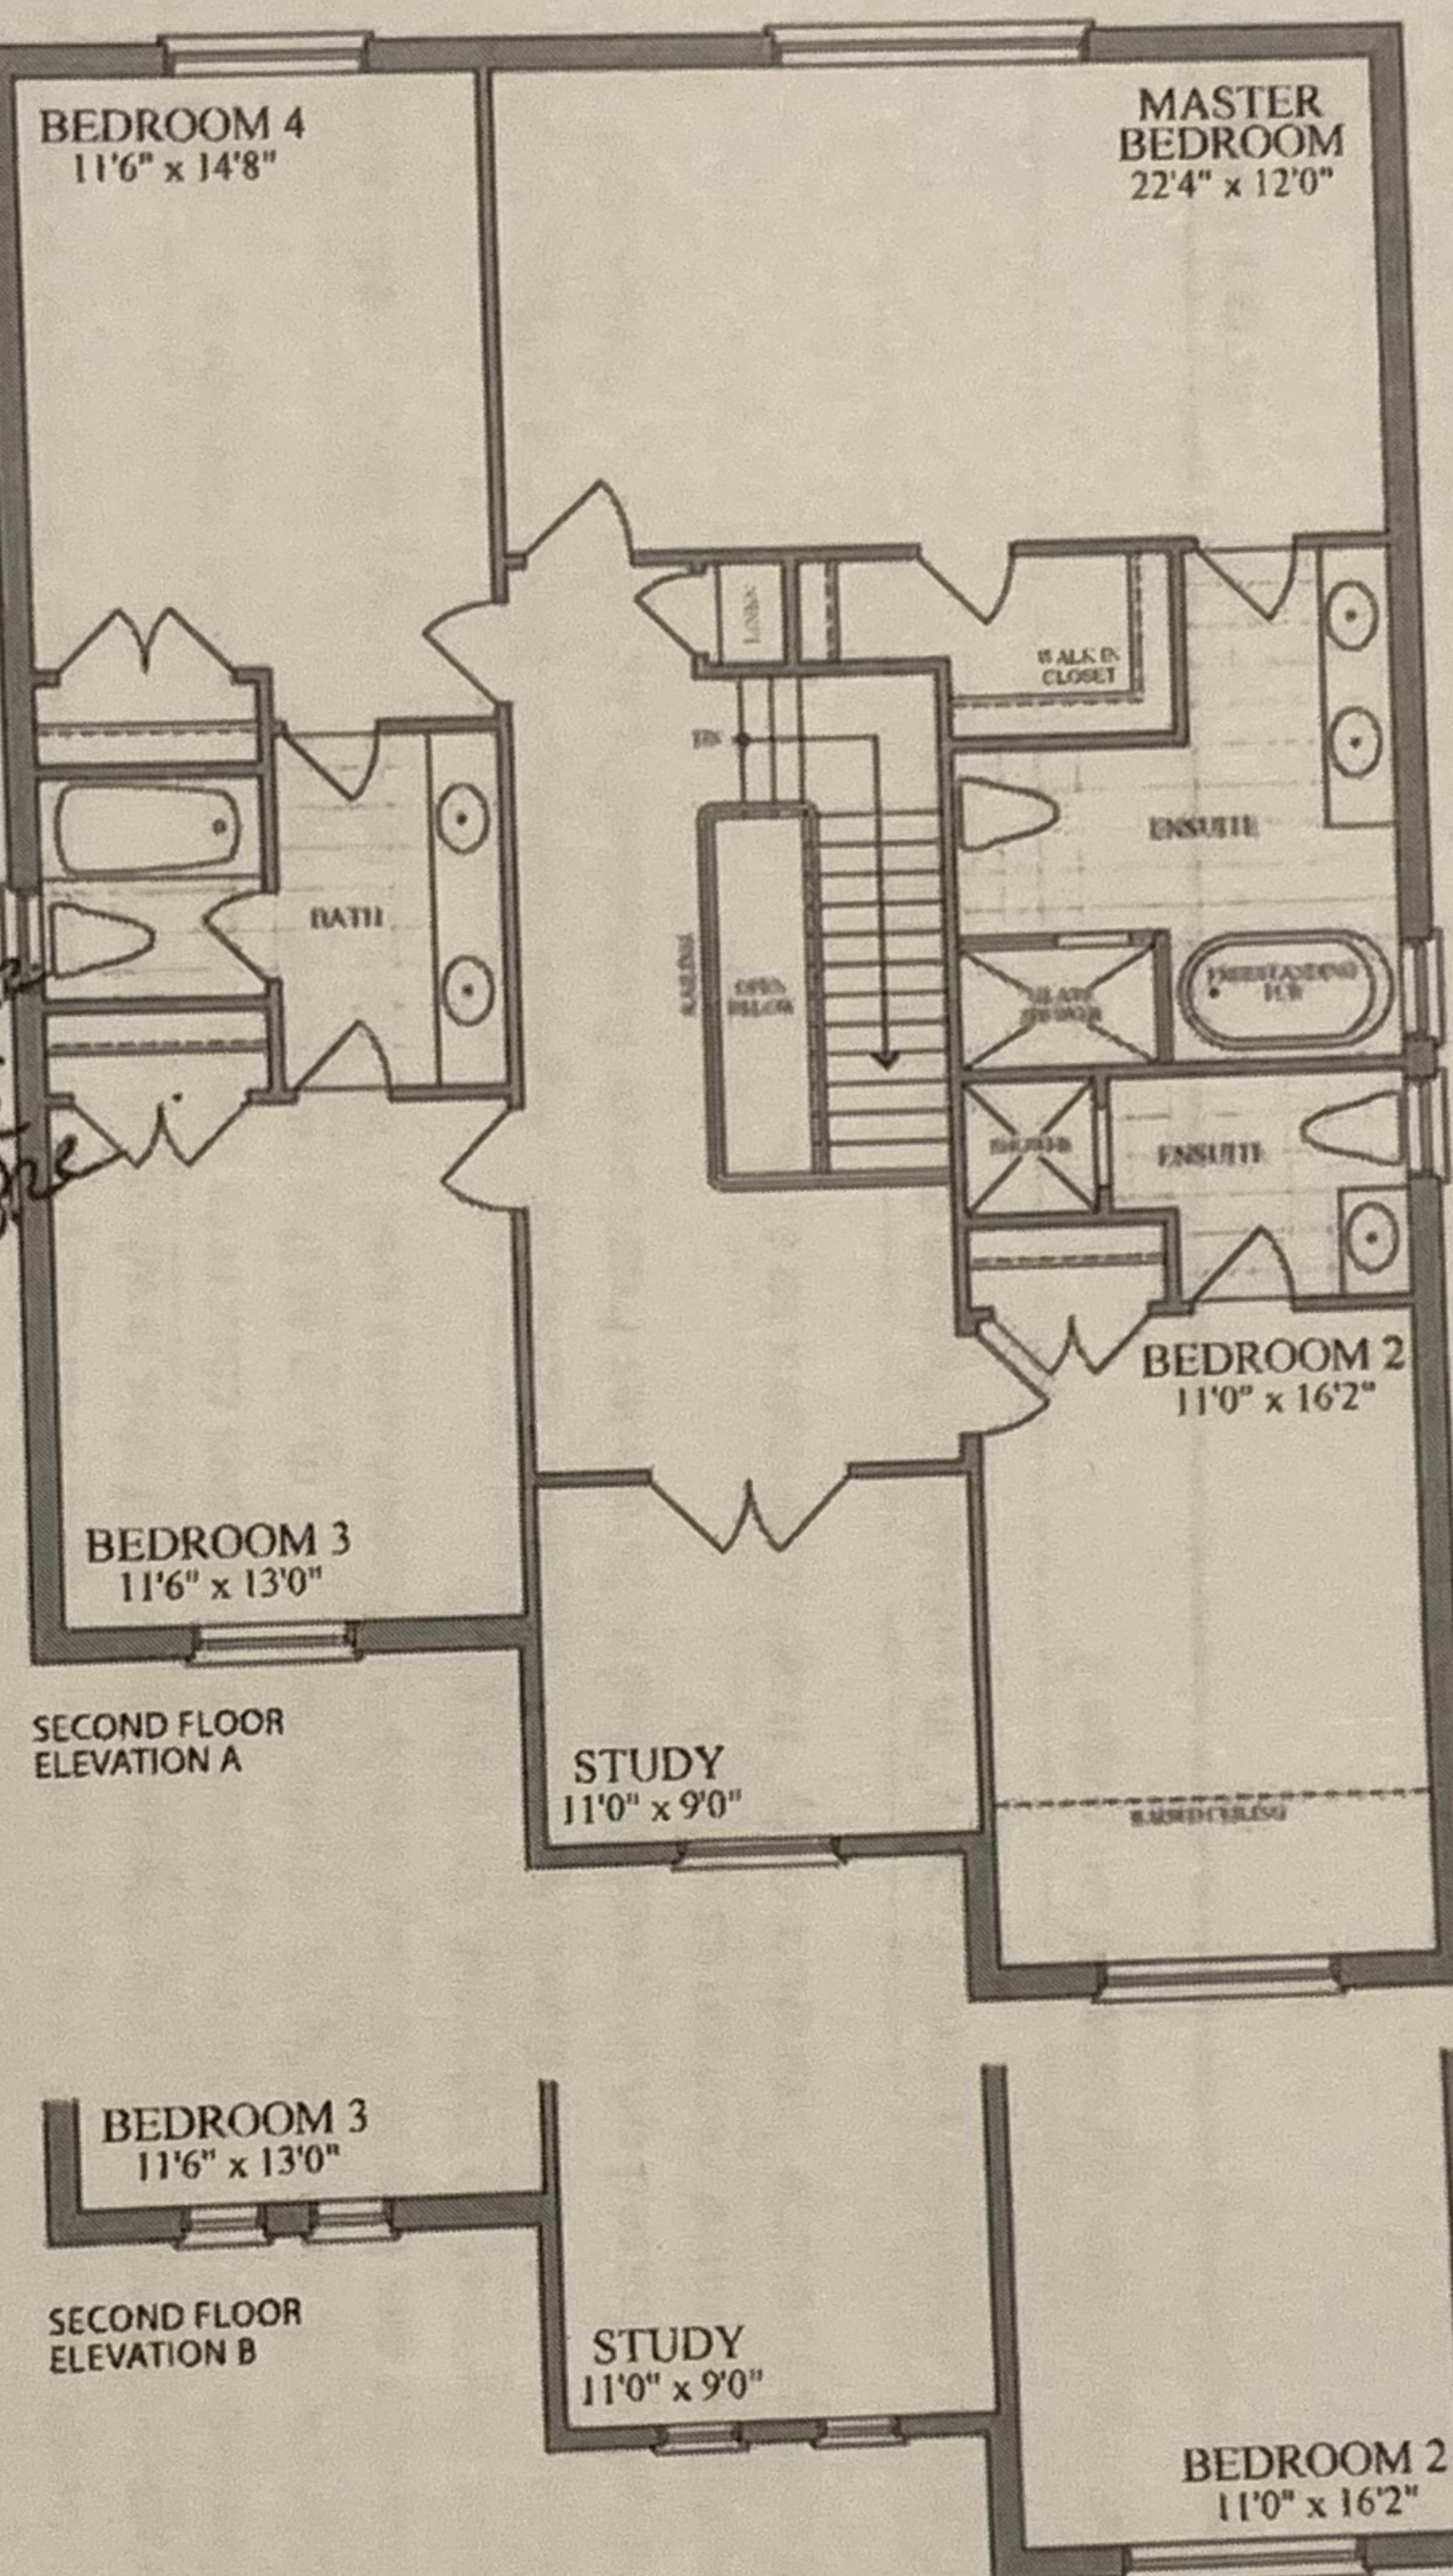


47'
DESIGNS

The Kahshe / Elev. A & B
3000 sq.ft.

Lot 2-27, Innisfil - PE002, SKETCH

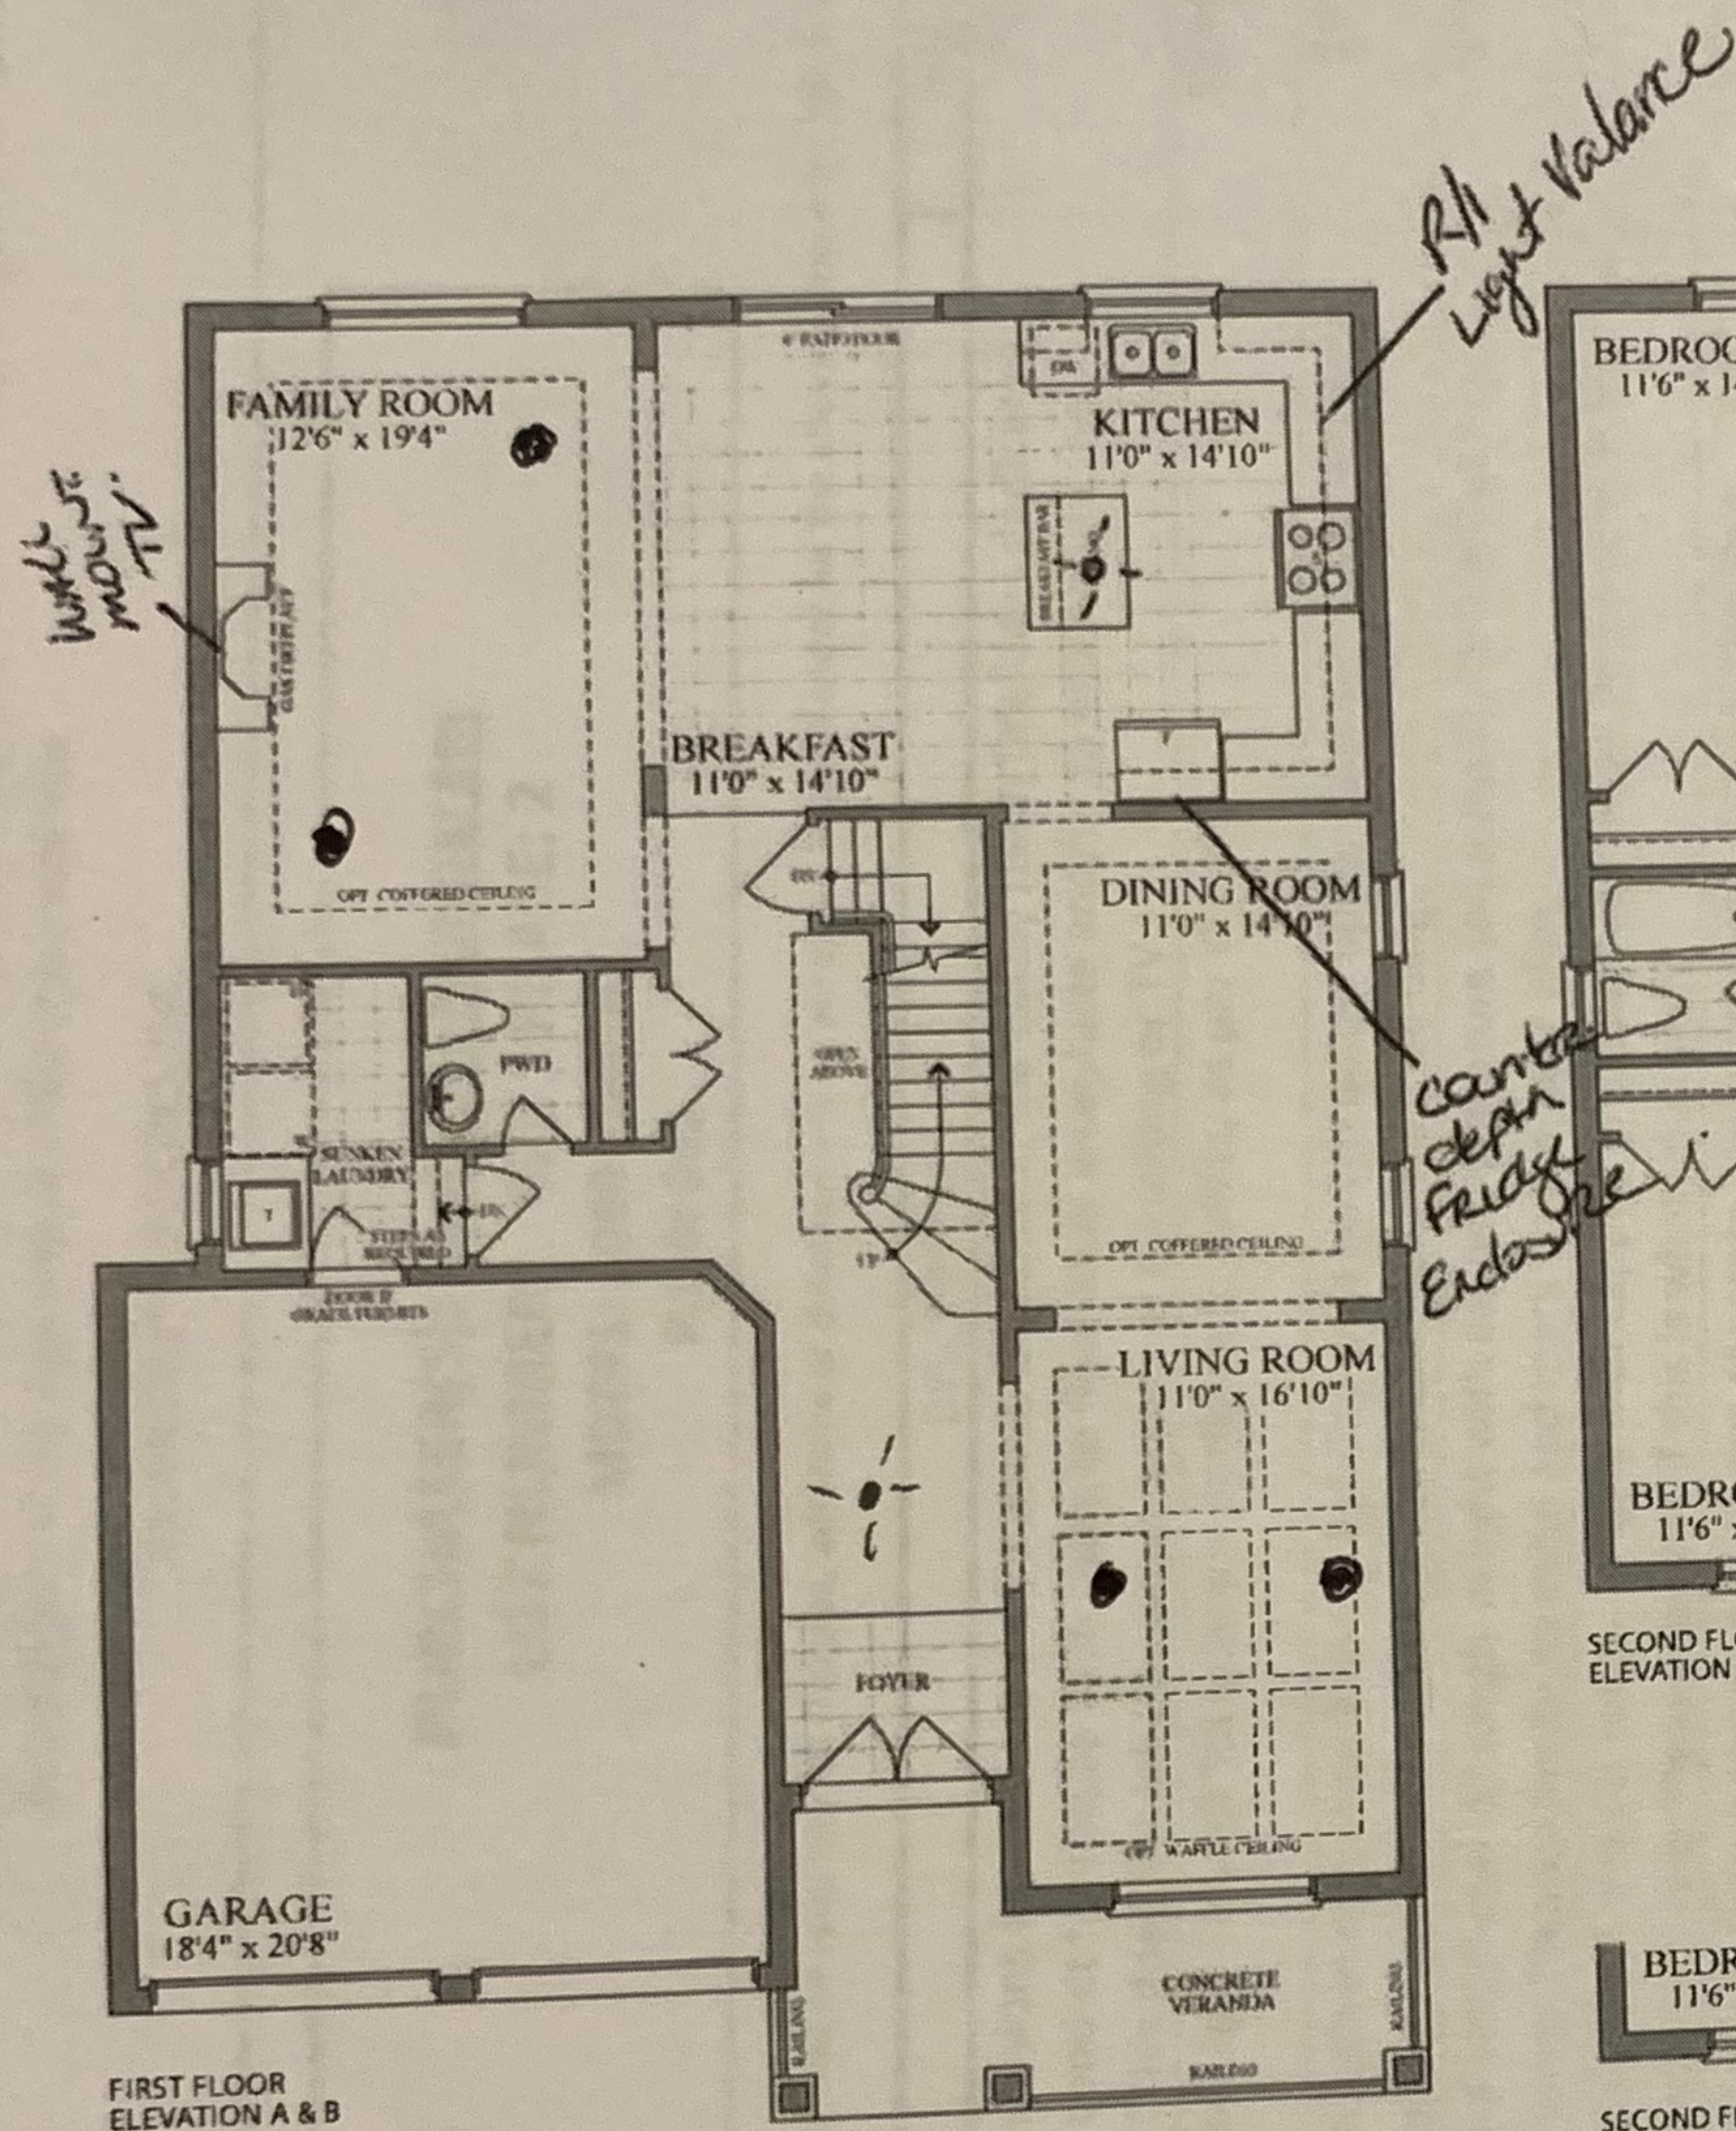

Plans and specifications are subject to change without notice. E. & D. E. Actual usable floor space may vary from the stated floor area. All renderings are artist's concept.

PURCHASER: SR