



forming part of the Agreement of Purchase and Sale

BELLAIRE PROPERTIES INC.

P.E.#: 003

[illegible]



- The Vendor will undertake to install the above extras but will not be liable to the purchaser if for any reason the work covered by the extra is not carried out. In that event, the price of the extra shall be refunded to the purchaser without any interest.
- It is understood and agreed that if the transaction of Purchase and Sale is not completed for any reason whatsoever, the total cost of this extra is not refundable.

PURCHASER

(Original verified at Head Office)

38'
DESIGNS

The Manitou / Elev. A & B
2480 sq.ft.

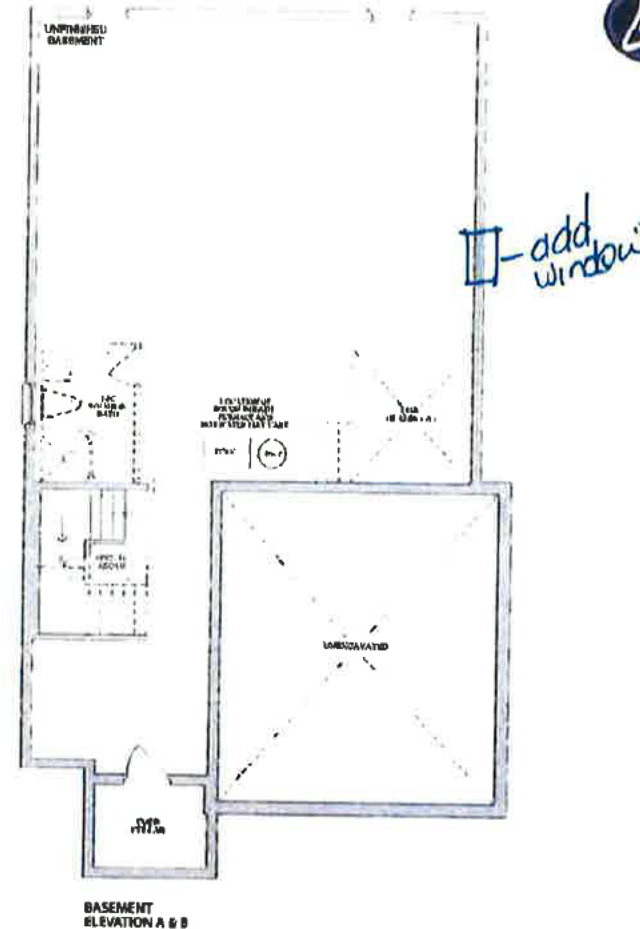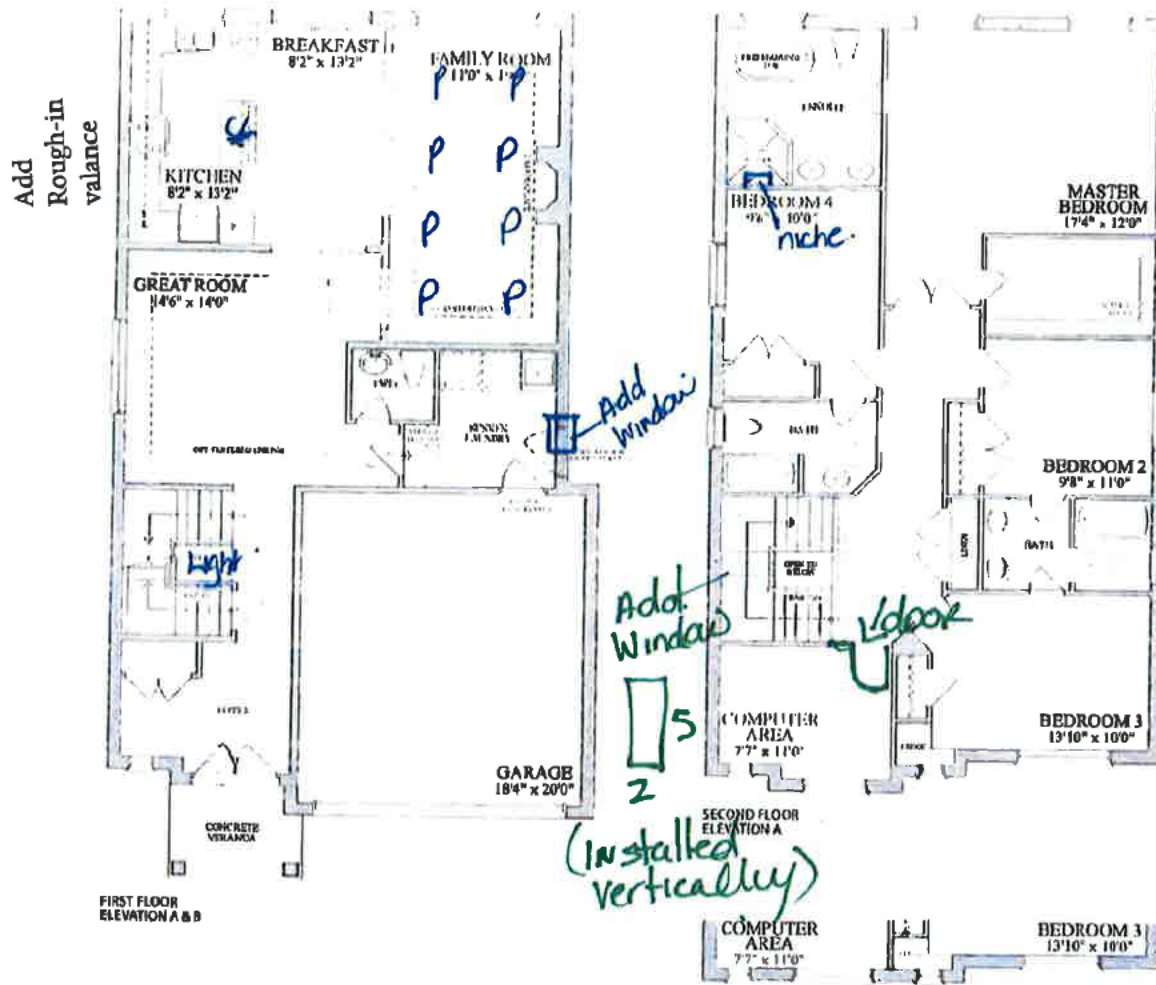

Please note that this is a sketch and not a final plan. All dimensions are approximate and subject to change without notice. All rights reserved.

LOT 5-88, PE003, SKETCH

kenneth egede

Purchaser: kenneth egede (Nov 24, 2021 12:04 EST)

Purchaser: _____

LOT 5-88, PE003, SKETCH

kenneth egede

PURCHASER: kenneth egede (Nov 2, 2021 12:13 EDT)

PURCHASER: _____