

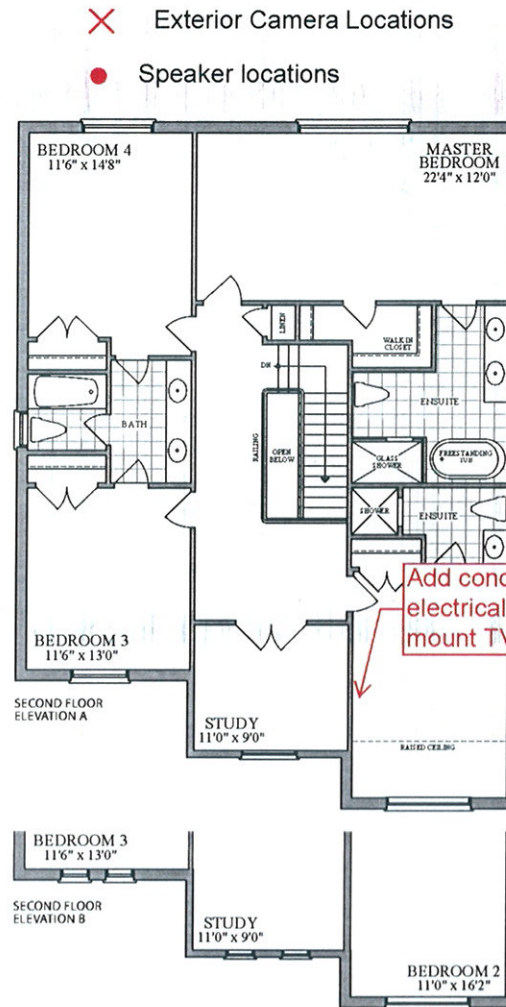


47'
DESIGNS

The Kahshe / Elev. A & B
3000 sq.ft.

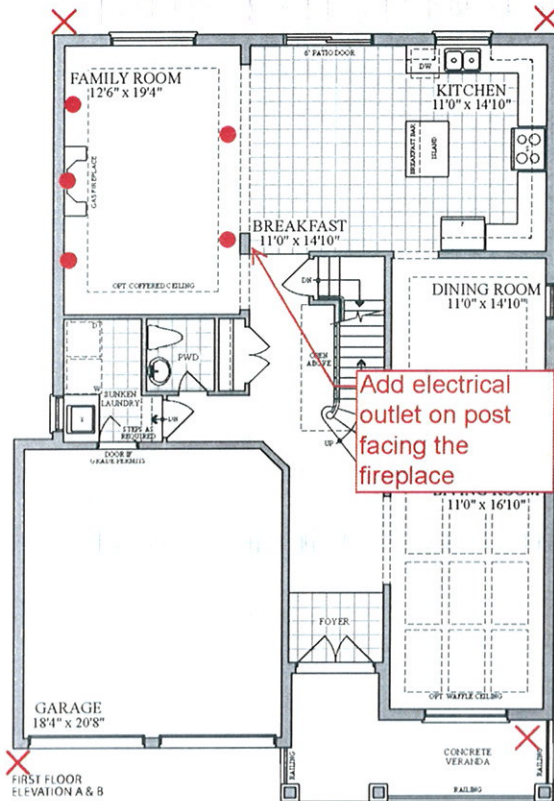

LOT 2-62, PH2, PE008
Purchaser: *[Signature]*
Purchaser: *[Signature]*

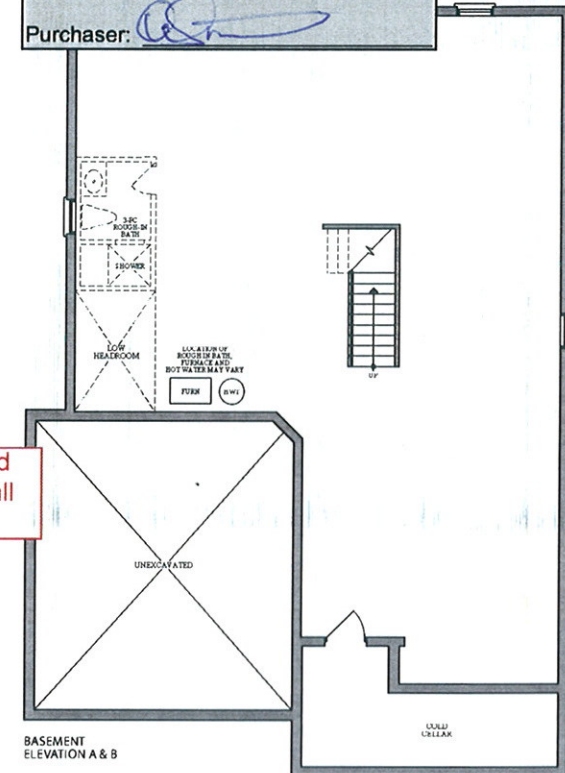

5 Rough-in speaker - \$500
4 rough-in camera - Cat6 - \$632



Plans and specifications are subject to change without notice. E & O E. Actual usable floor space may vary from the stated floor area. All renderings are artist's concept.