



38'
DESIGNS


The Manitou / Elev. A & B
2480 sq.ft.

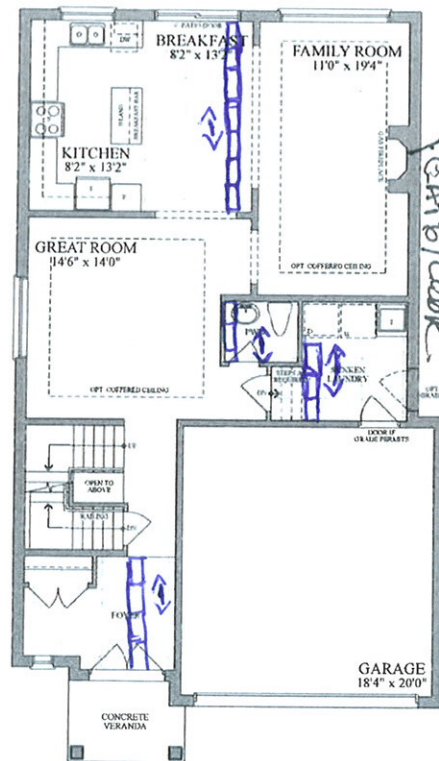


FIRST FLOOR
ELEVATION A & B

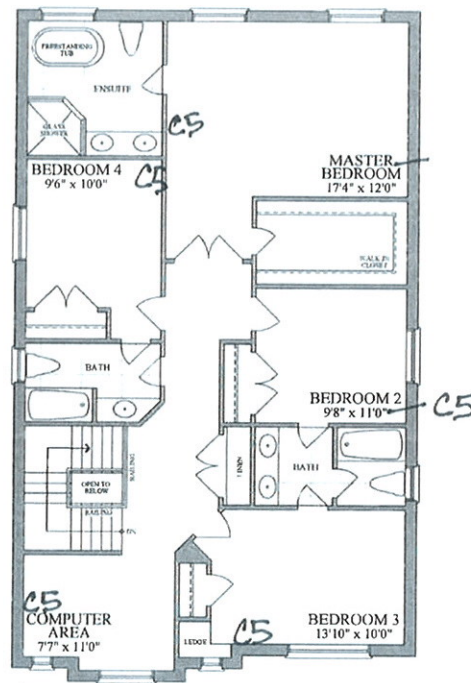

SECOND FLOOR
ELEVATION A

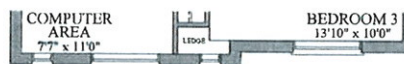

SECOND FLOOR
ELEVATION B

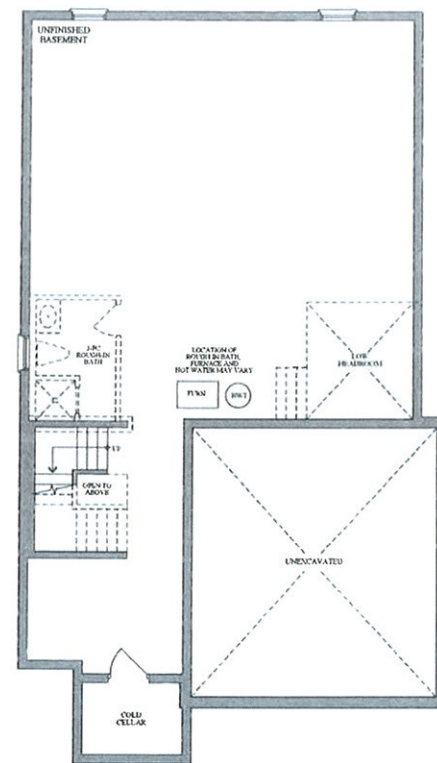

BASEMENT
ELEVATION A & B

PECOA sketch



Plans and specifications are subject to change without notice. E. & O. E. Actual usable floor space may vary from the stated floor area. All renderings are artist's concept.

Lot 1-183, Ph 1, R/i Locations

Purchaser's MAKSIM REMEROVSKY