


FIRST FLOOR
ELEVATION A & B

All standard locations for CAT5 cable

Tiles in Foyer, Pwd, & Kitchen/Breakfast to be installed stacked vertically

E/CONDUIT/C5

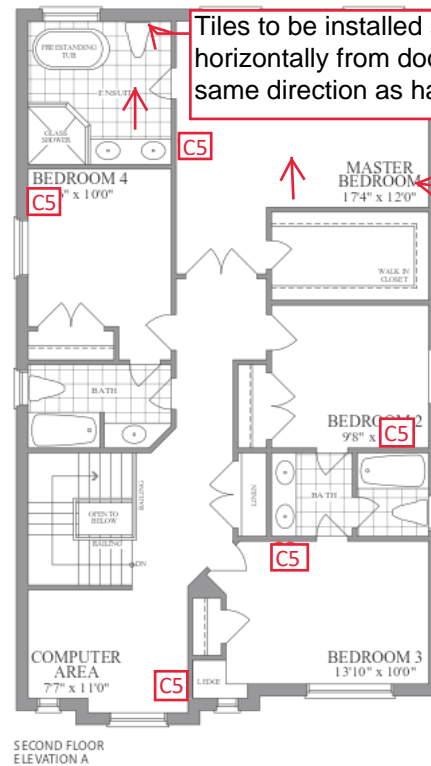

SECOND FLOOR
ELEVATION A


COMPUTER AREA
7'7" x 11'0"

SECOND FLOOR
ELEVATION B

BEDROOM 3
13'10" x 10'0"

Tiles to be installed stacked horizontally from door, to run in the same direction as hardwood

Hardwood to be installed front to back

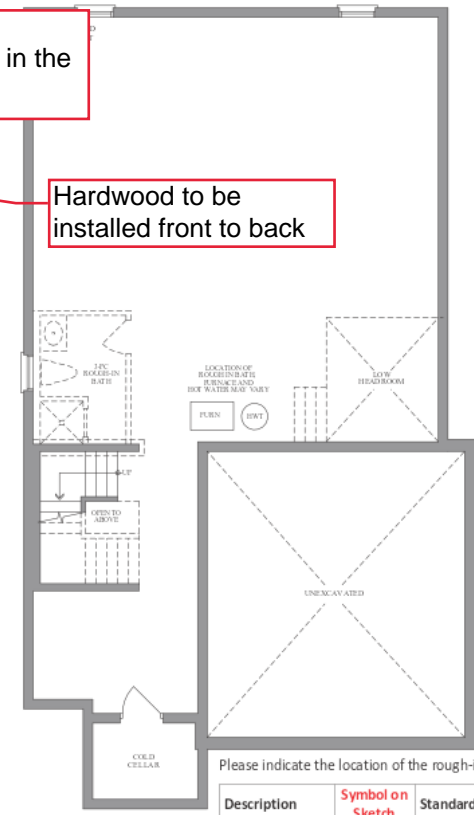

BASEMENT
ELEVATION A & B

Please indicate the location of the rough-ins on your plan

Description	Symbol on Sketch	Standard Locations
Cable (Rough-in)	C	Family room Or Great Room, all bedrooms, Study/Den/Computer, (as per model)
Cat5	C5	A Cat5 wire can replace the rough-in cable at no additional cost.
Cat6	C6	Upgrade - \$50 per location
Telephone (Rough-in)	T	Kitchen and Primary Ensuite
Smart-Wire (Cat5)	S	Can be installed a Purchaser's desired location

Lot #: 5-71, PH5

LOT 5-71, INNISFIL PE004

Purchaser's Initial(s): Mark Kamenetsky (May 19, 2022 02:33 EDT)

Elena Kamenetski (May 19, 2022 11:10 EDT)


LOT 5-71, PH5, PE004, SKETCH


Final Audit Report


2022-05-19


Created:	2022-05-18
By:	The Design Studio, Lormel Homes (design@lormelhomes.com)
Status:	Signed
Transaction ID:	CBJCHBCAABAATu5Hkigwy3P88-DvaDiCZbAcVlacFKUS


"LOT 5-71, PH5, PE004, SKETCH" History


 Document created by The Design Studio, Lormel Homes (design@lormelhomes.com)
2022-05-18 - 2:40:38 PM GMT


 Document emailed to Elena Kamenetski (elena.kamenetski@gmail.com) for signature
2022-05-18 - 2:45:26 PM GMT


 Document emailed to Mark Kamenetsky (markkam44@gmail.com) for signature
2022-05-18 - 2:45:26 PM GMT


 Email viewed by Elena Kamenetski (elena.kamenetski@gmail.com)
2022-05-18 - 2:45:33 PM GMT

 Email viewed by Mark Kamenetsky (markkam44@gmail.com)
2022-05-18 - 6:39:50 PM GMT

 Document e-signed by Mark Kamenetsky (markkam44@gmail.com)
Signature Date: 2022-05-19 - 6:33:56 AM GMT - Time Source: server

 Email viewed by Elena Kamenetski (elena.kamenetski@gmail.com)
2022-05-19 - 2:49:50 PM GMT

 Document e-signed by Elena Kamenetski (elena.kamenetski@gmail.com)
Signature Date: 2022-05-19 - 3:10:39 PM GMT - Time Source: server

 Agreement completed.
2022-05-19 - 3:10:39 PM GMT