



The Temagami / Elev. A & B  
3 Car Tandem 3068 sq.ft. - includes 478 sq. ft. of finished area in lower level  
2 Car Garage 3350 sq.ft. - includes 760 sq. ft. of finished area in lower level

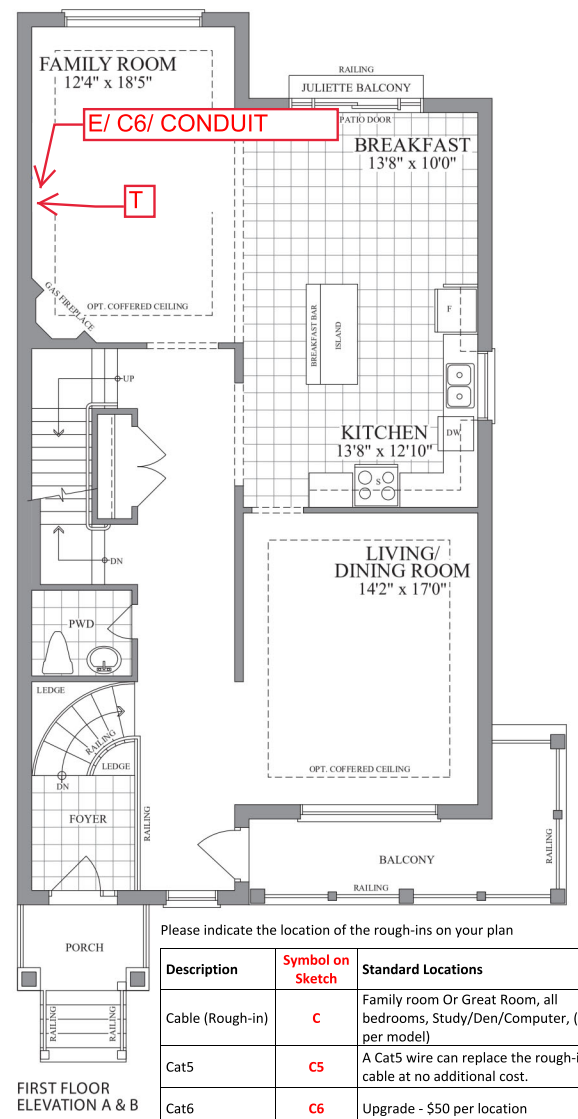


Please indicate the location of the rough-ins on your plan

Description	Symbol on Sketch	Standard Locations
Cable (Rough-in)	C	Family room Or Great Room, all bedrooms, Study/Den/Computer, (as per model)
Cat5	C5	A Cat5 wire can replace the rough-in cable at no additional cost.
Cat6	C6	Upgrade - \$50 per location
Telephone (Rough-in)	T	Kitchen and Primary Ensuite
Smart-Wire (Cat5)	S	Can be installed a Purchaser's desired location


FIRST FLOOR  
ELEVATION A & B

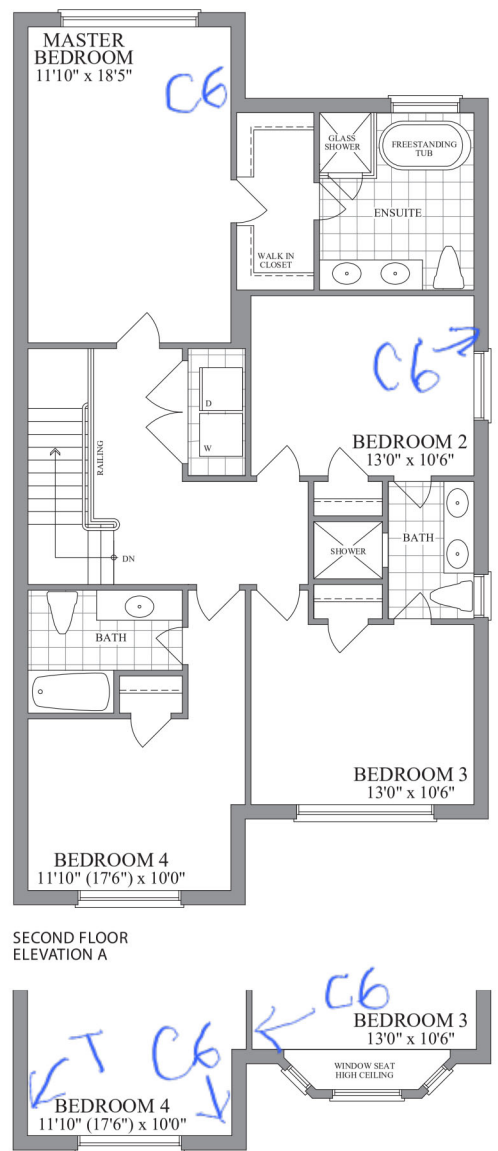


SECOND FLOOR  
ELEVATION A

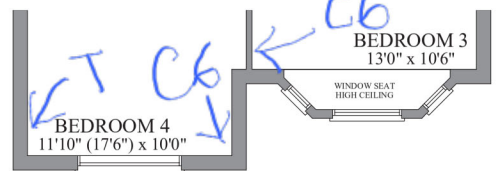

SECOND FLOOR  
ELEVATION B

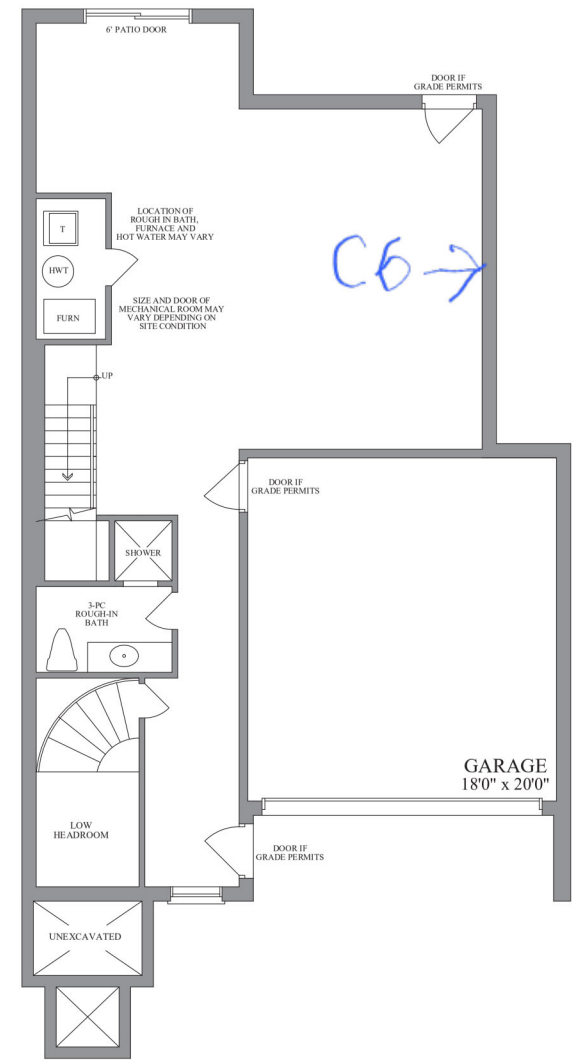

LOWER LEVEL  
ELEVATION A & B  
2 CAR GARAGE  
3350 SQ. FT. INCLUDES 760 SQ. FT.  
OF FINISHED AREA IN LOWER LEVEL

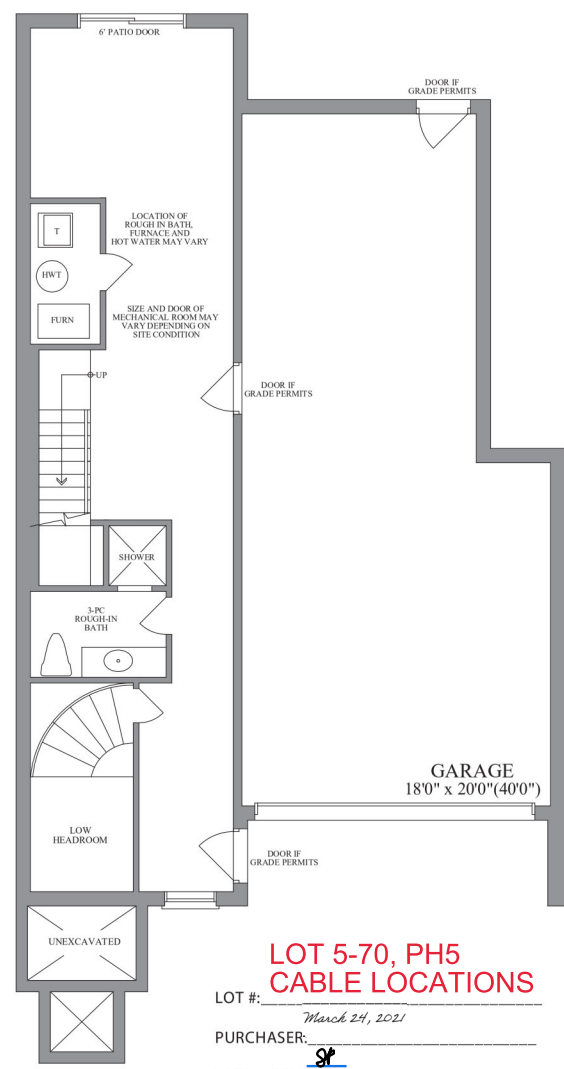

LOWER LEVEL  
ELEVATION A & B  
OPT. TANDEM 3 CAR GARAGE  
3068 SQ. FT. INCLUDES 478 SQ. FT.  
OF FINISHED AREA IN LOWER LEVEL

LOT 5-70, PH5  
CABLE LOCATIONS  
LOT #: \_\_\_\_\_  
PURCHASER: \_\_\_\_\_  
PURCHASER: \_\_\_\_\_



Plans and specifications are subject to change without notice. E. & O. E. Actual usable floor space may vary from the stated floor area. All renderings are artist's concept.