
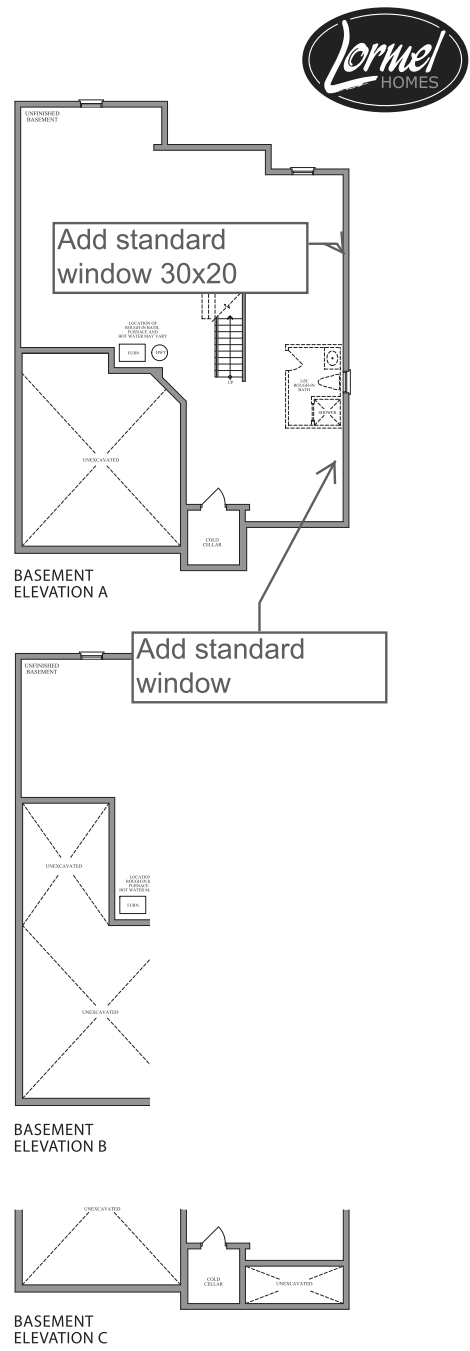
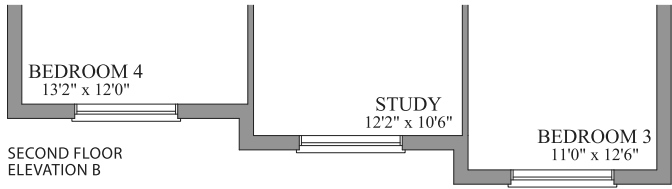
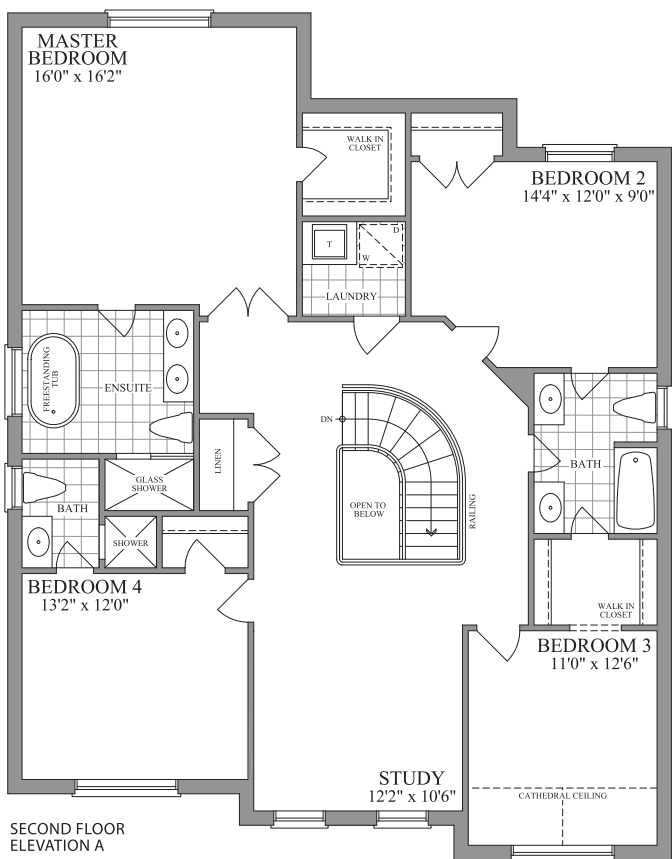


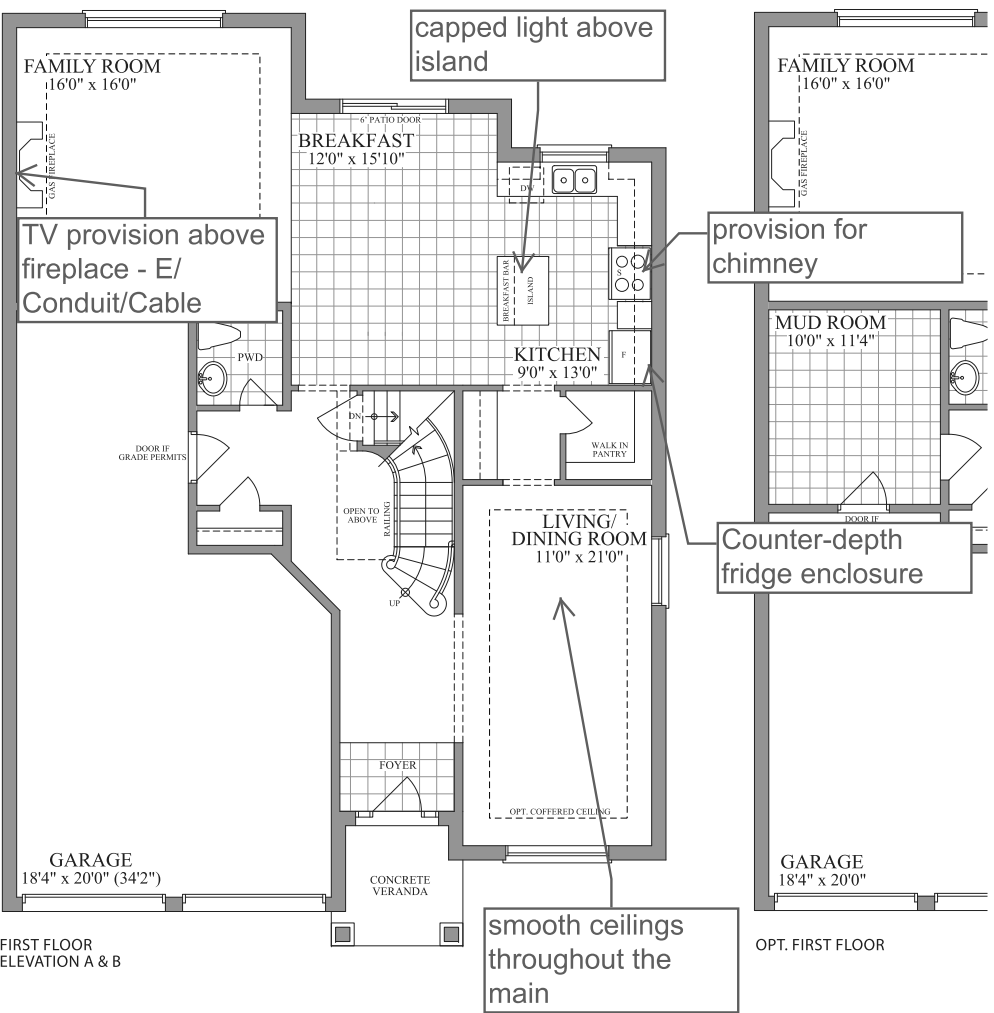

LOT 5-25, PH5, PE002

Purchaser: Ranjit Sandhu (May 6, 2022 09:02 EDT)

Purchaser: Kulwinder sidhu (May 6, 2022 15:11 EDT)

Plans and specifications are subject to change without notice. E. & O. E. Actual usable floor space may vary from the stated floor area. All renderings are artist's concept.

