



38'
DESIGNS

The manitou / Elev. A & B
2480 sq.ft.

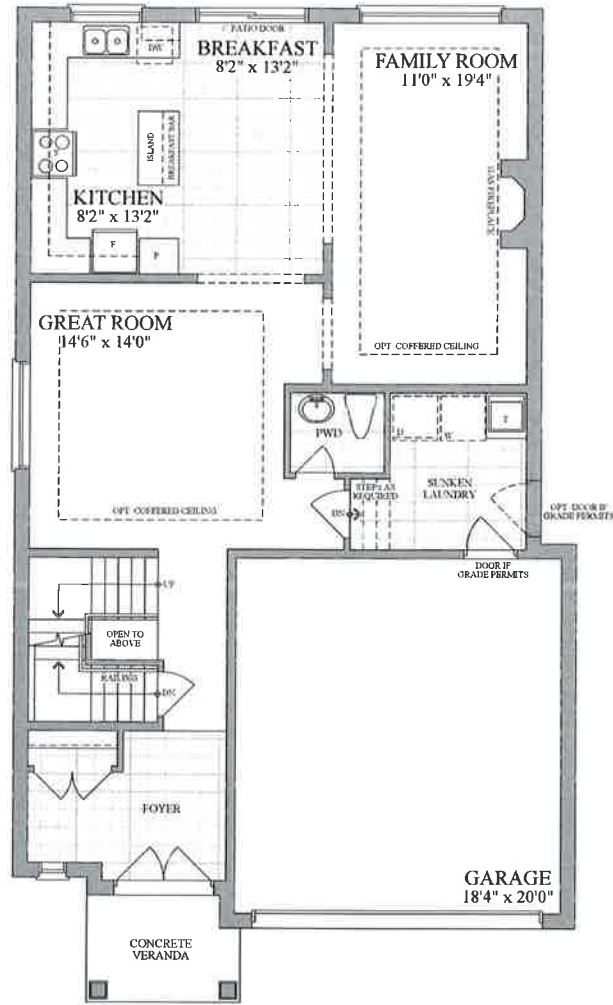


FIRST FLOOR
ELEVATION A & B

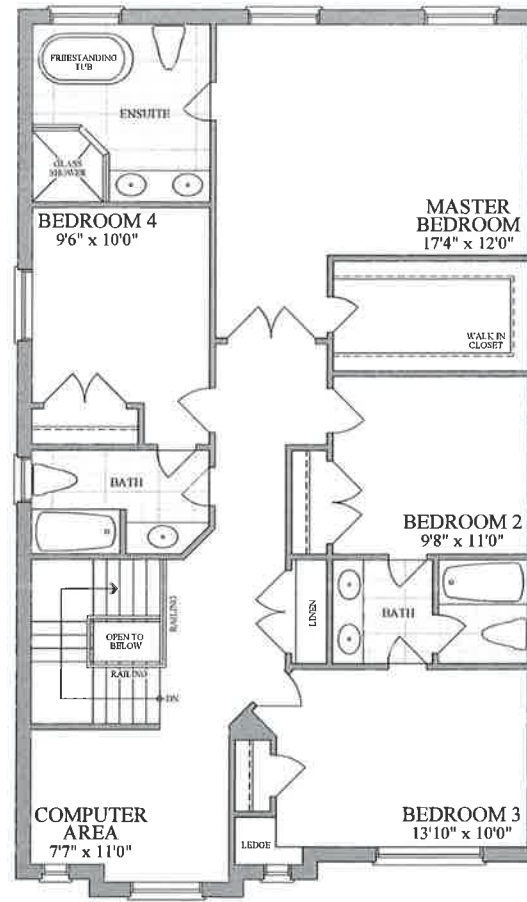

SECOND FLOOR
ELEVATION A



SECOND FLOOR
ELEVATION B

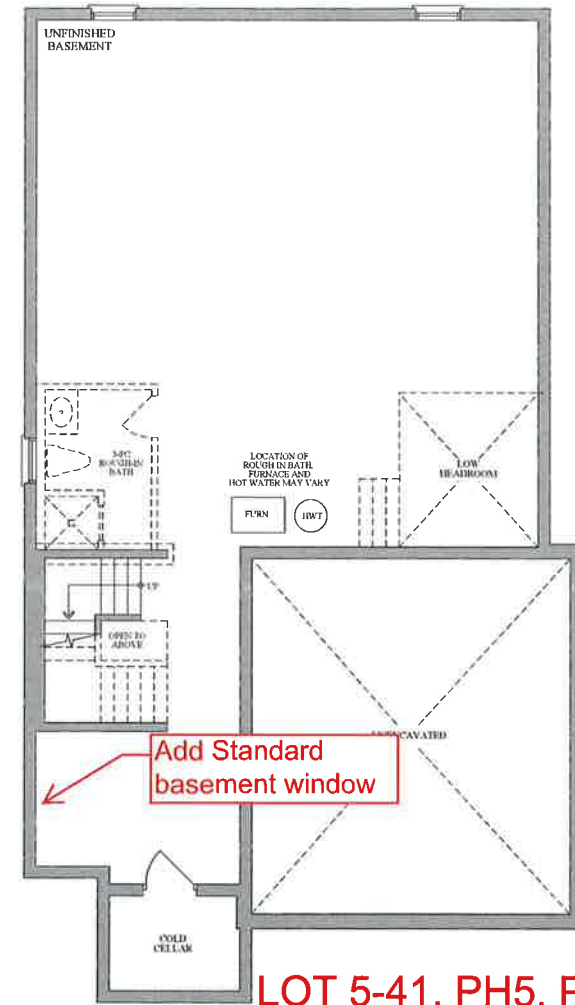

BASEMENT
ELEVATION A & B



003

LOT 5-41, PH5, PE002, SKETCH

Purchaser: Sarbjit sandhu (May 6, 2022 23:47 EDT)

Purchaser: _____



Plans and specifications are subject to change without notice, E. & O. E. Actual usable floor space may vary from the stated floor area. All renderings are artist's concept.