


38'
DESIGNS

The Manitou / Elev. A & B
2480 sq.ft.

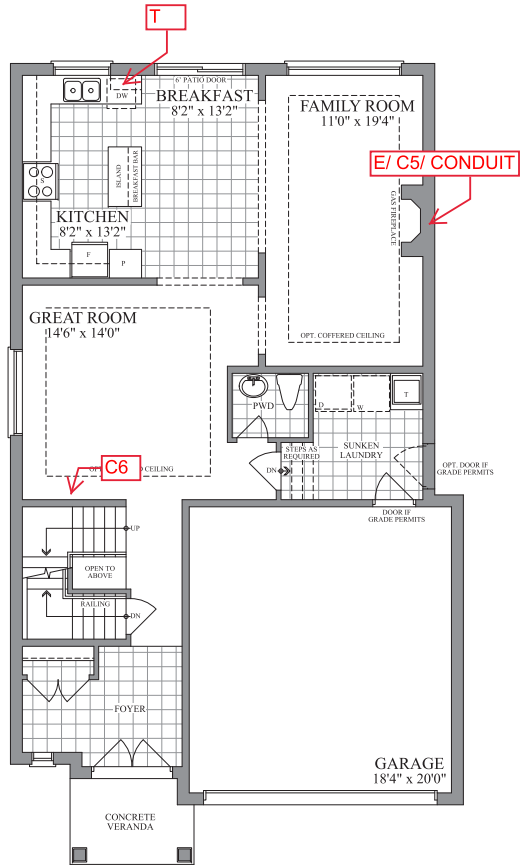


FIRST FLOOR
ELEVATION A & B


LOT 5-88, PH5, CABLE LOCATIONS

PURCHASER: kenneth egede
kenneth egede (Jun 14, 2022 14:22 EDT)


PURCHASER: Omobolaji Egede
Omobolaji Egede (Jun 14, 2022 16:08 EDT)

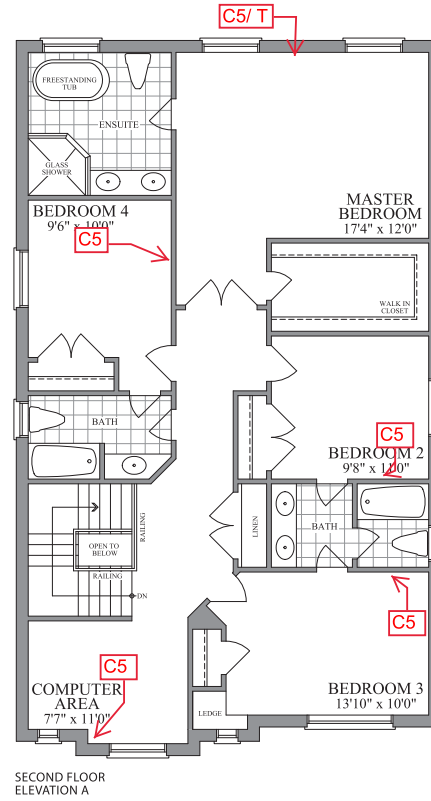

SECOND FLOOR
ELEVATION A

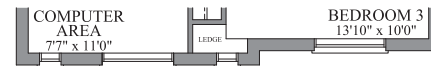

SECOND FLOOR
ELEVATION B

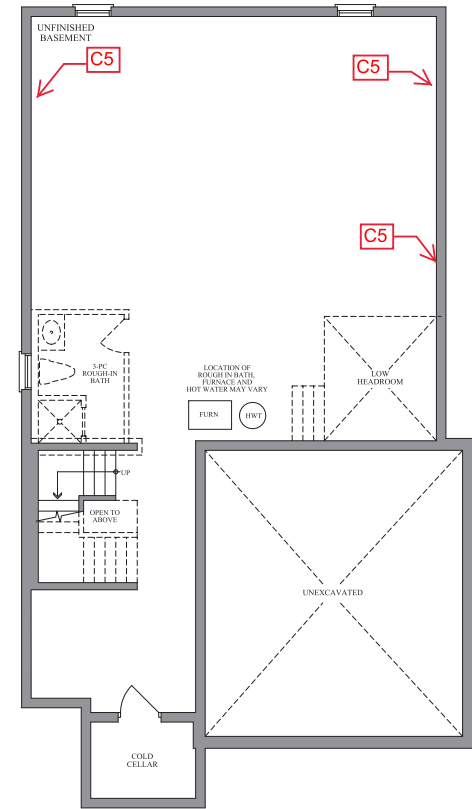

BASEMENT
ELEVATION A & B



Plans and specifications are subject to change without notice. E. & O. E. Actual usable floor space may vary from the stated floor area. All renderings are artist's concept.