REVISED LAYOUT KITCHEN - OPTION 1

LOT 5-30, PH5, PE002, SKETCH

PURCHASER: Fouzia sultana (Jul 19, 2022 17:27 EDT)

PURCHASER: Riaz Qamar (Jul 19, 2022 17:26 EDT)

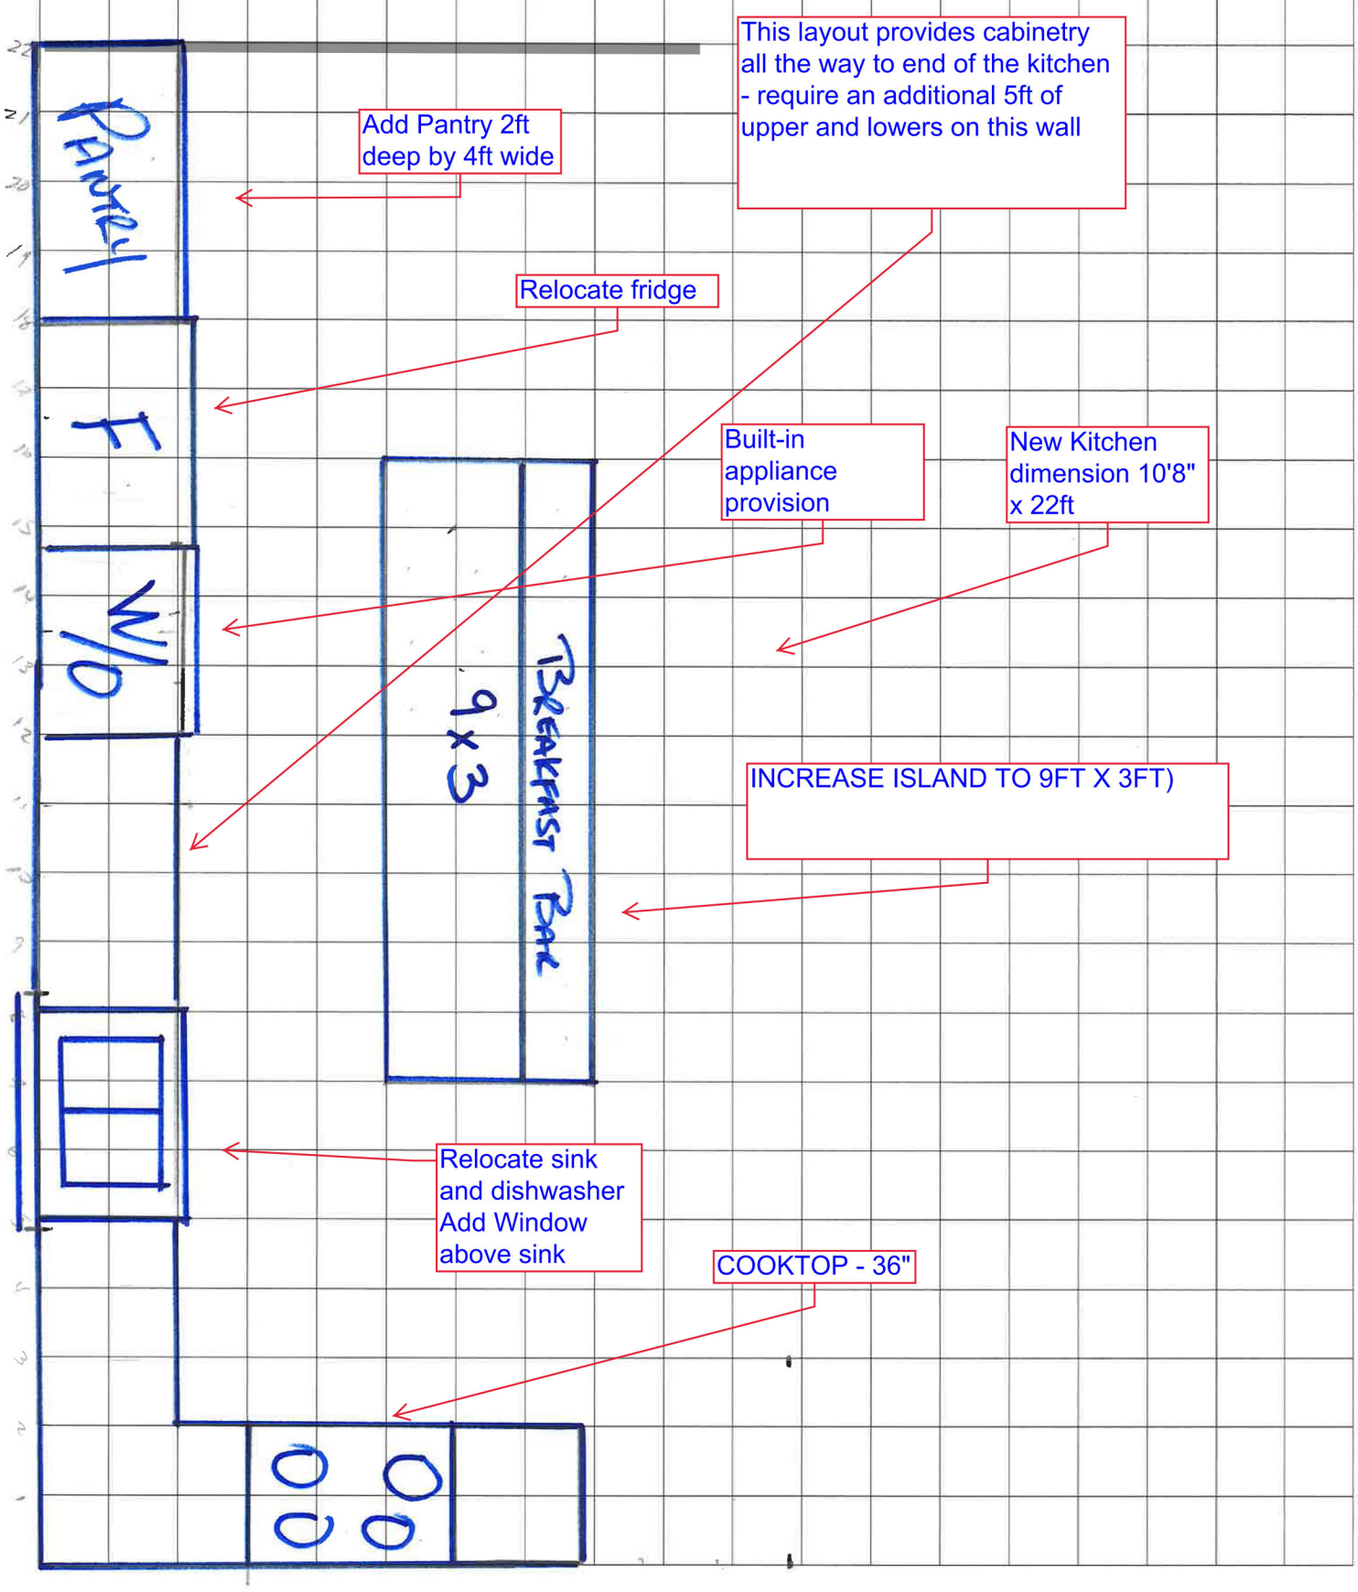

INSPIRATION HUT - 1.0CM GRID