




## Elev. A & B

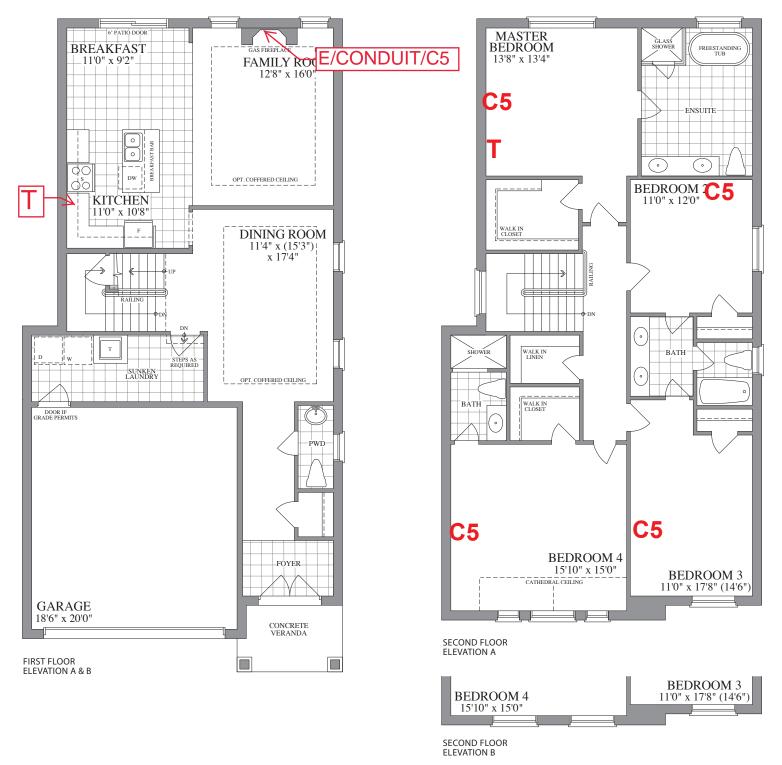

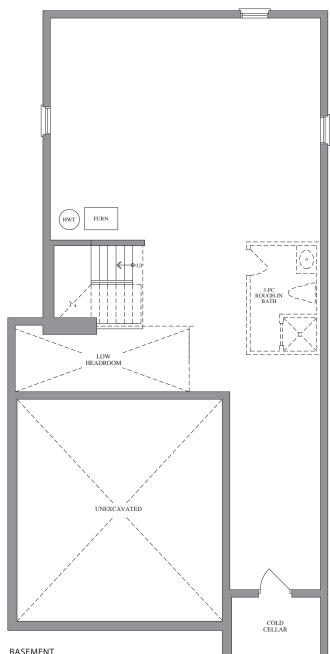

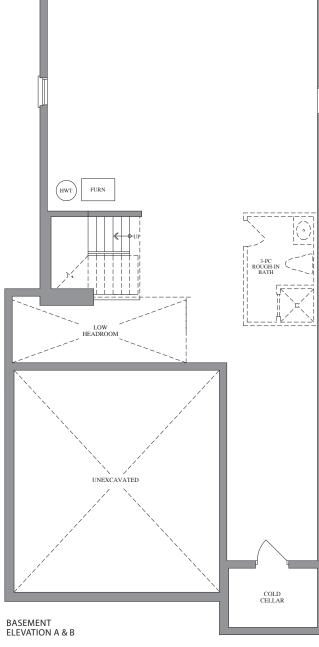

5-32 LOT #:

**PURCHASER:** 

PURCHASER:



Plans and specifications are subject to change without notice. E. & O. E. Actual usable floor space may vary from the stated f loor area. All renderings are artist's concept.