



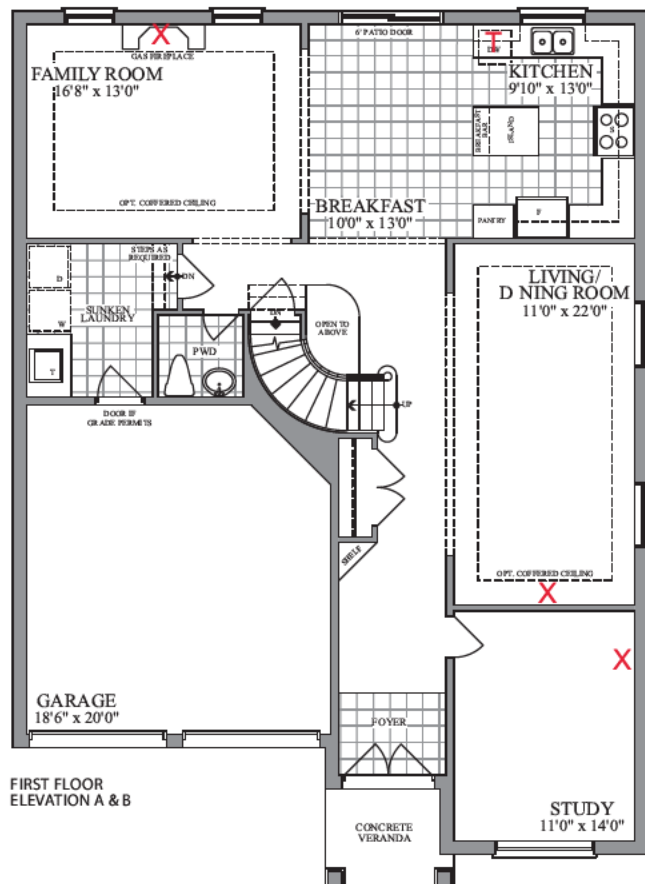


FIRST FLOOR  
ELEVATION A & B

Please indicate the location of the rough-ins on your plan


| Description          | Symbol on Sketch | Standard Locations                                                          |
|----------------------|------------------|-----------------------------------------------------------------------------|
| Cable (Rough-in)     | C                | Family room Or Great Room, all bedrooms, Study/Den/Computer, (as per model) |
| Cat5                 | C5               | A Cat5 wire can replace the rough-in cable at no additional cost.           |
| Cat6                 | C6               | Upgrade - \$50 per location                                                 |
| Telephone (Rough-in) | T                | Kitchen and Primary Ensuite                                                 |
| Smart-Wire (Cat5)    | S                | Can be installed a Purchaser's desired location                             |

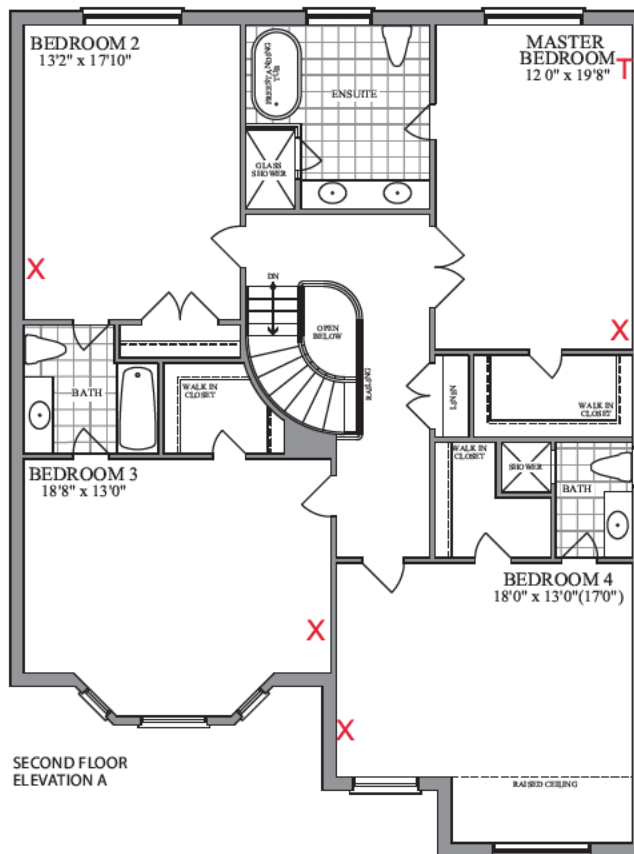

SECOND FLOOR  
ELEVATION A

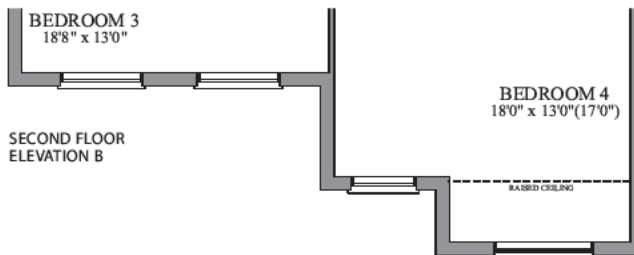

SECOND FLOOR  
ELEVATION B

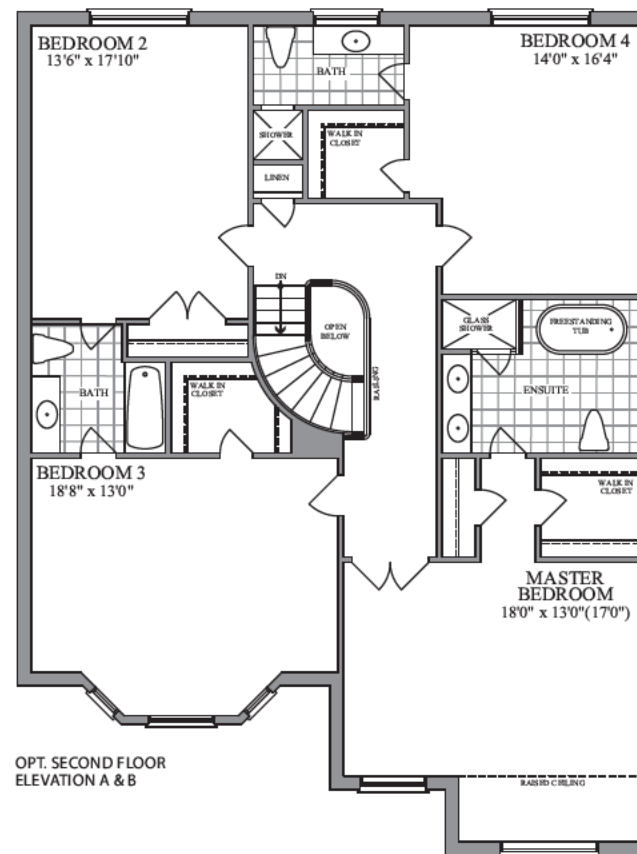


OPT. SECOND FLOOR  
ELEVATION A & B

LOT # 66

PURCHASER: Usman (Mar 3, 2022 14:23 EST)

PURCAHSER: \_\_\_\_\_

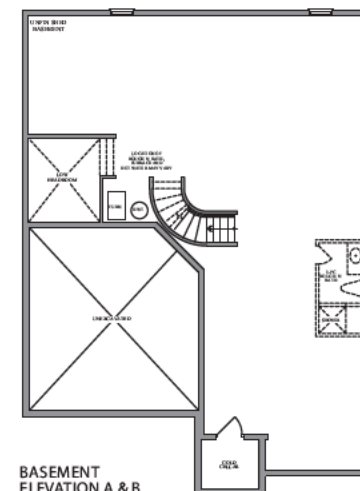

BASEMENT  
ELEVATION A & B