
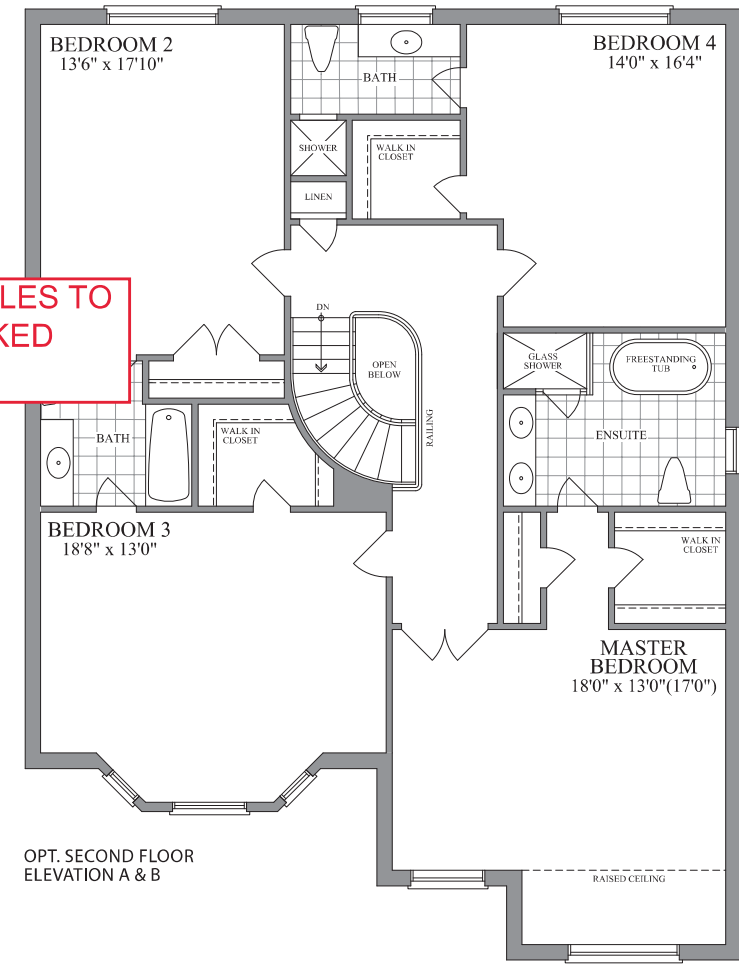
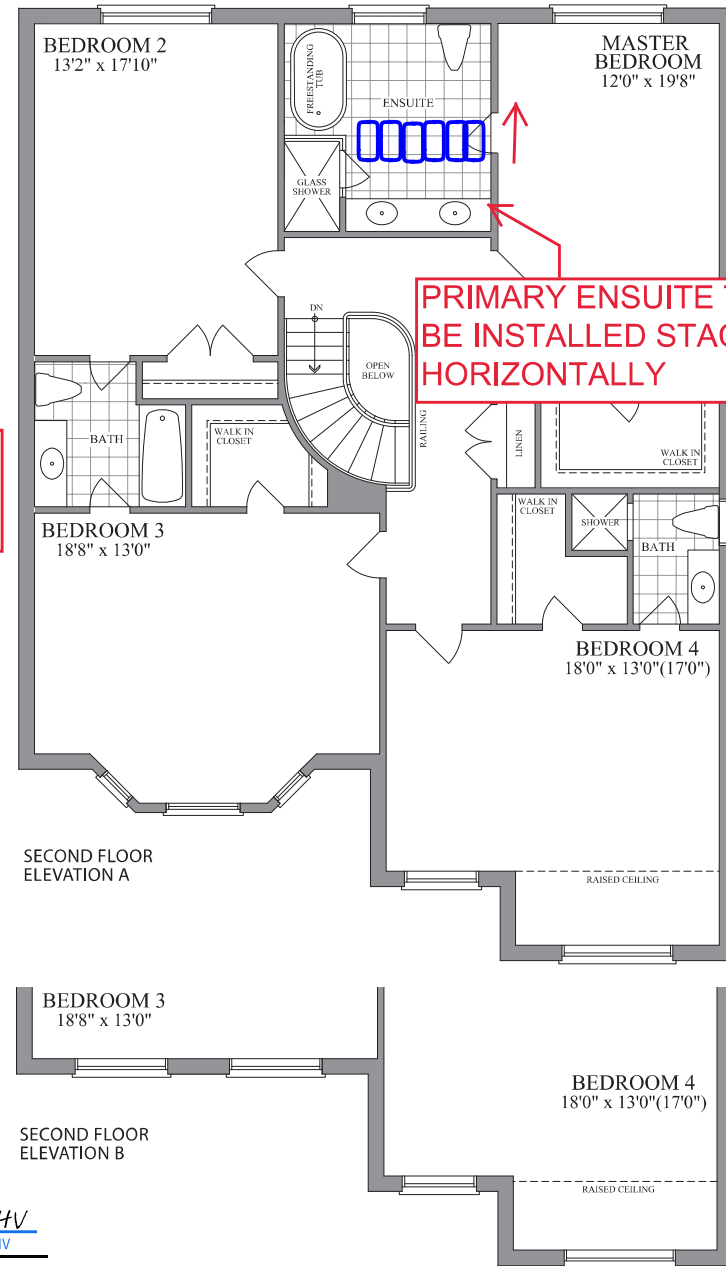


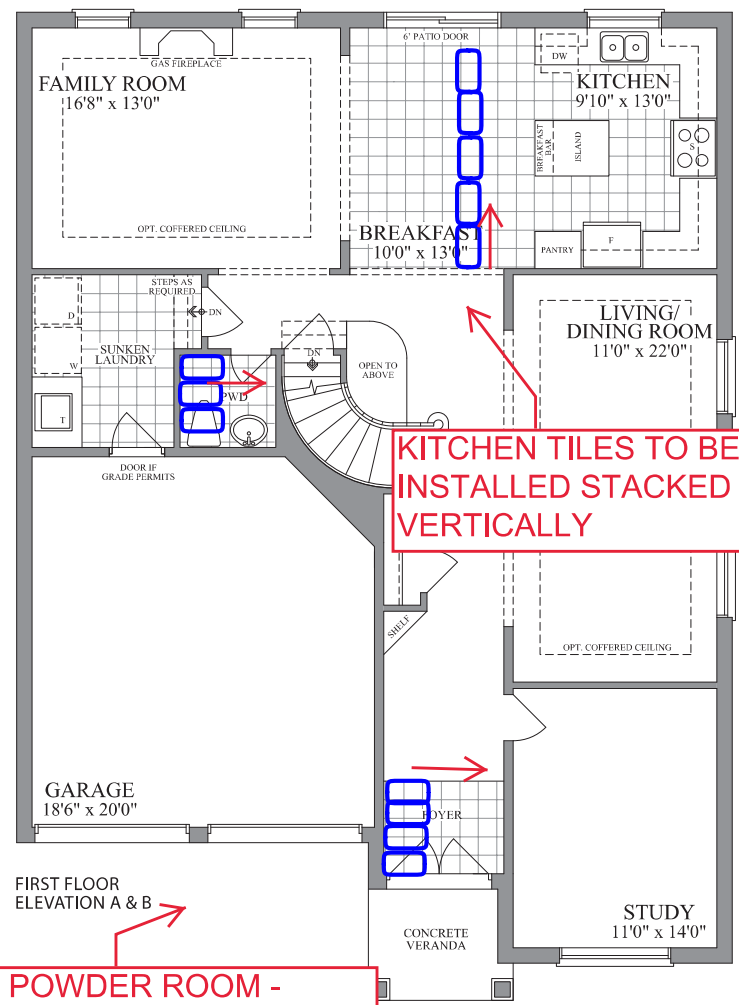

Purchaser's Initial(s): A.D. gd R.D. HV
A.D. GD RD HV