
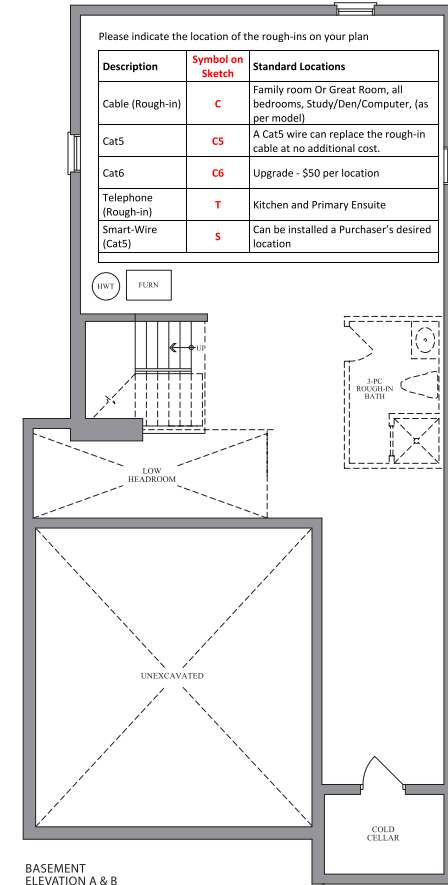
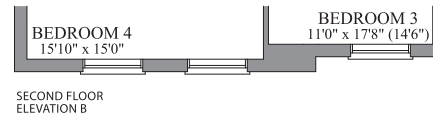
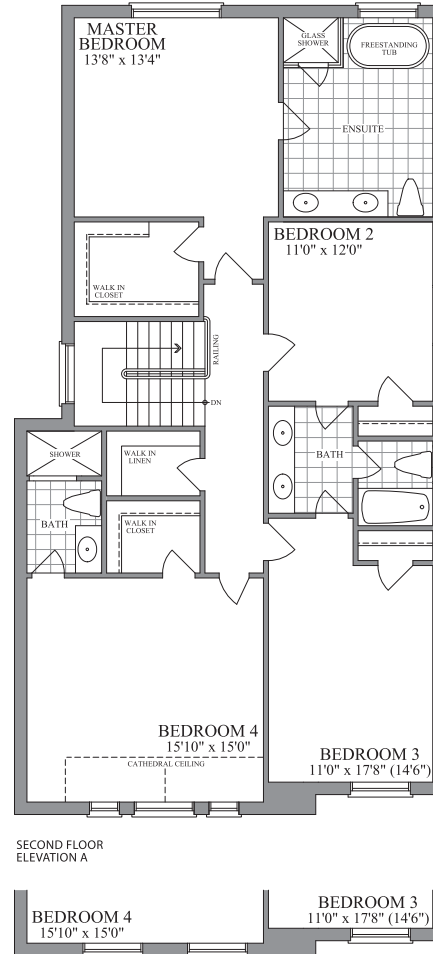


38'
DESIGNS

The Finlay / Elev. A & B
2515 sq.ft.

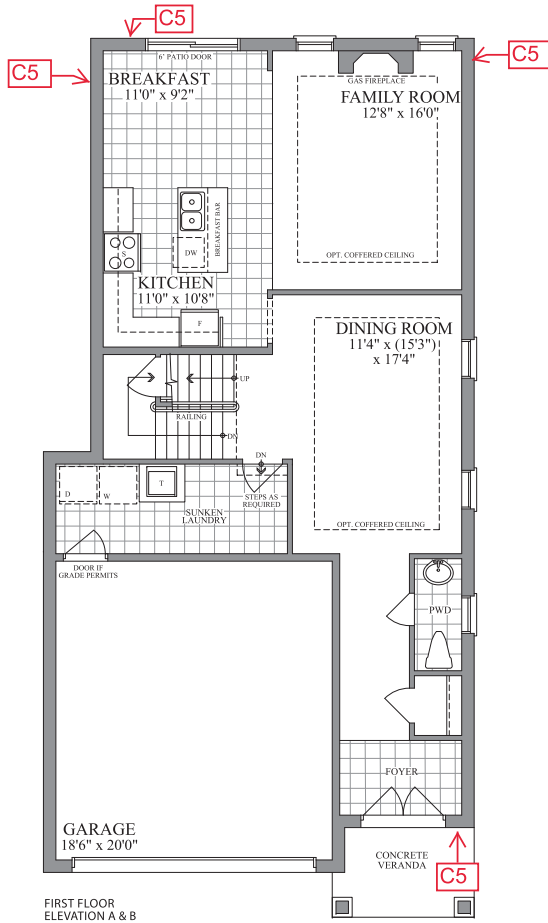

Please indicate the location of the rough-ins on your plan

Description	Symbol on Sketch	Standard Locations
Cable (Rough-in)	C	Family room Or Great Room, all bedrooms, Study/Den/Computer, (as per model)
Cat5	C5	A Cat5 wire can replace the rough-in cable at no additional cost.
Cat6	C6	Upgrade - \$50 per location
Telephone (Rough-in)	T	Kitchen and Primary Ensuite
Smart-Wire (Cat5)	S	Can be installed a Purchaser's desired location

LOT #: 5-30, PH5, PE004, EXTERIOR CAMERAS

PURCHASER: Riaz Qamar
Riaz Qamar (Jan 12, 2023 11:16 EST)





PURCHASER: Fouzia sultana
Fouzia sultana (Jan 12, 2023 15:19 EST)



Plans and specifications are subject to change without notice. E. & O. E. Actual usable floor space may vary from the stated floor area. All renderings are artist's concept.

38'
DESIGNS

The Finlay / Elev. A & B
2515 sq.ft.

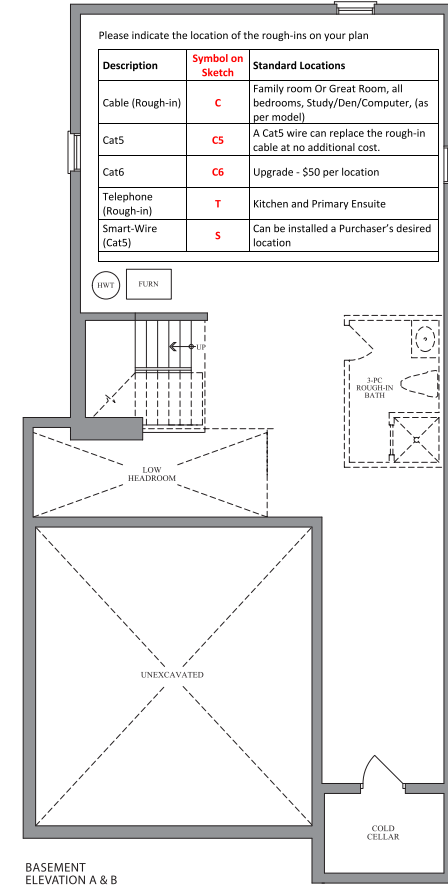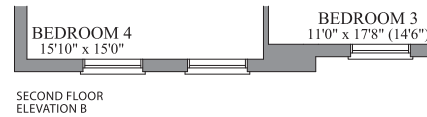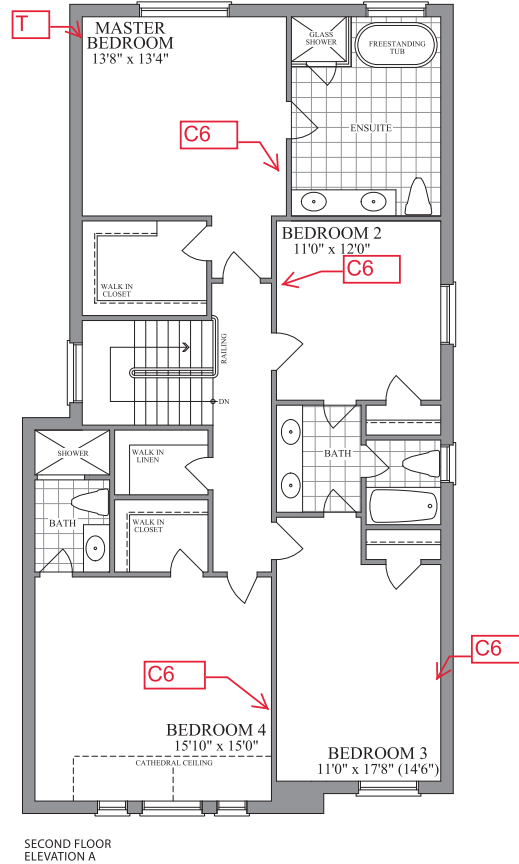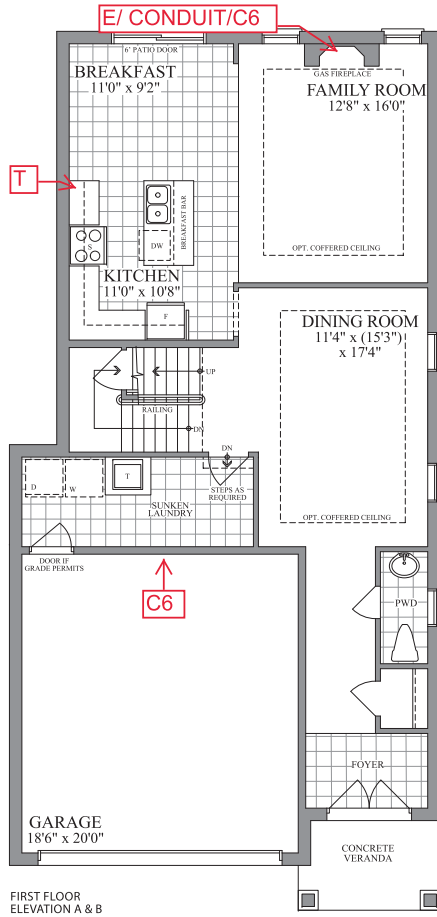

Please indicate the location of the rough-ins on your plan

Description	Symbol on Sketch	Standard Locations
Cable (Rough-in)	C	Family room Or Great Room, all bedrooms, Study/Den/Computer, (as per model)
Cat5	CS	A Cat5 wire can replace the rough-in cable at no additional cost.
Cat6	C6	Upgrade - \$50 per location
Telephone (Rough-in)	T	Kitchen and Primary Ensuite
Smart-Wire (Cat5)	S	Can be installed a Purchaser's desired location

LOT #: 5-30, PH5, PE004, CABLE LOCATIONS

PURCHASER: Riaz Qamar
Riaz Qamar (Jan 12, 2023 11:16 EST)

PURCHASER: Fouzia sultana
Fouzia sultana (Jan 12, 2023 15:19 EST)



Plans and specifications are subject to change without notice. E. & O. E. Actual usable floor space may vary from the stated floor area. All renderings are artist's concept.