
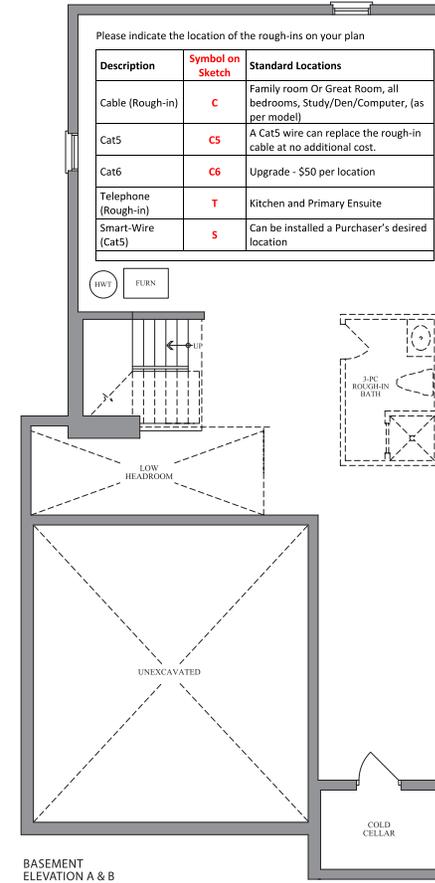
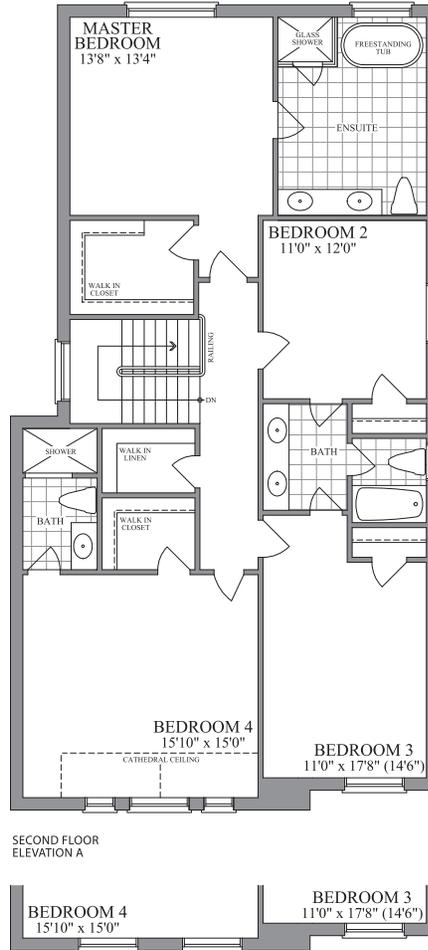


38'
DESIGNS

The **Finlay** / Elev. A & B
2515 sq.ft.

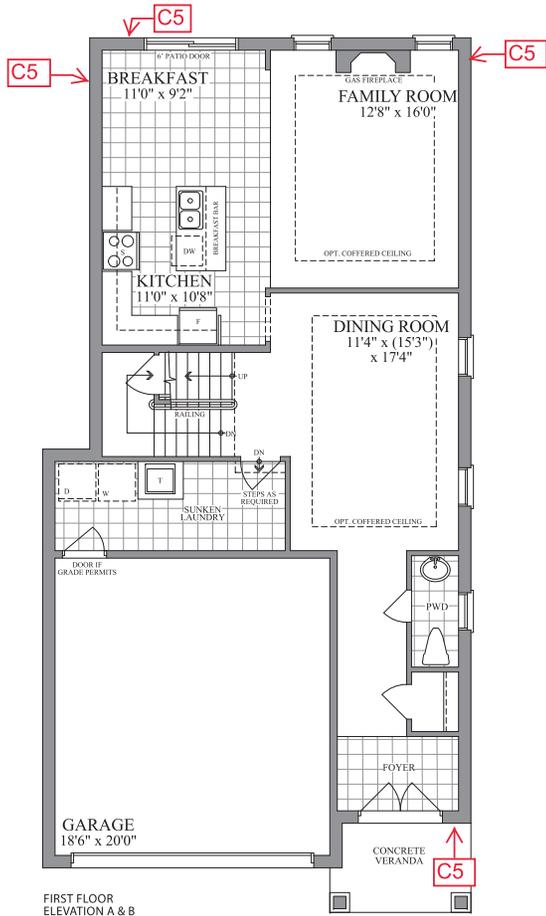

Plans and specifications are subject to change without notice. E. & O. E. Actual usable floor space may vary from the stated floor area. All renderings are artist's concept.




LOT #: **5-30, PH5, PE004, EXTERIOR CAMERAS**

PURCHASER: Riaz Qamar
Riaz Qamar (Jan 12, 2023 11:16 EST)

PURCHASER: Fouzia sultana
Fouzia sultana (Jan 12, 2023 15:19 EST)

38'
DESIGNS

The **Finlay** / Elev. A & B
2515 sq.ft.

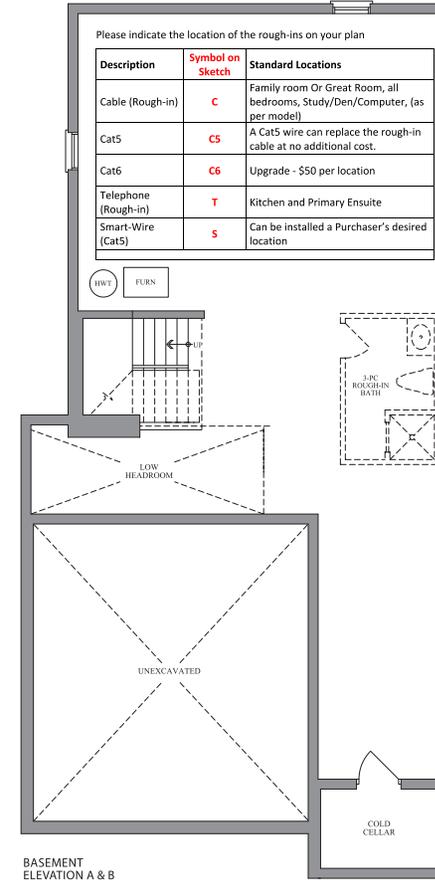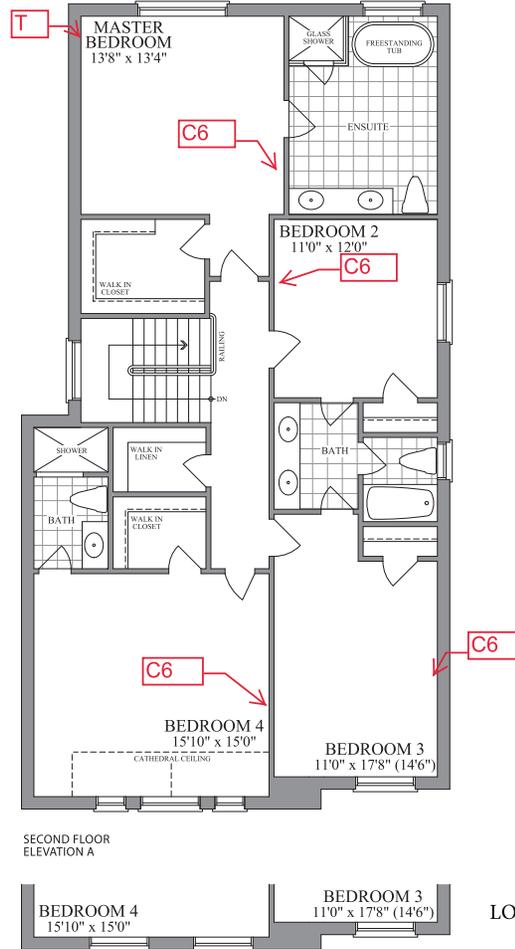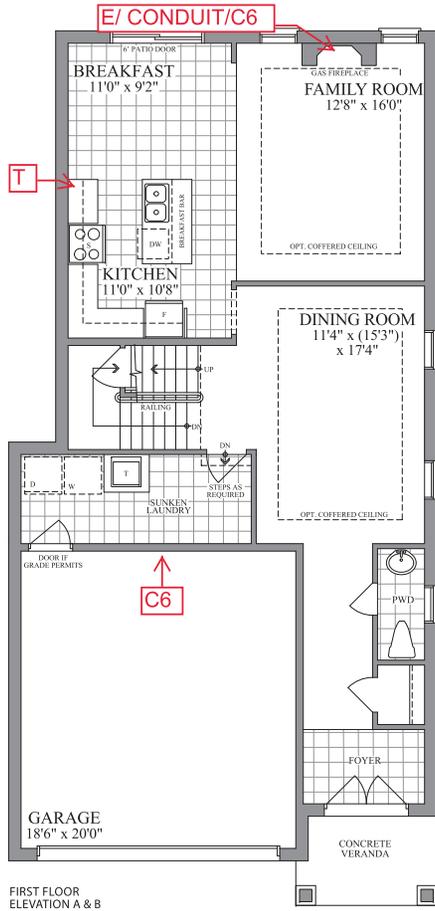

LOT #: **5-30, PH5, PE004, CABLE LOCATIONS**

PURCHASER: Riaz Qamar
Riaz Qamar (Jan 12, 2023 11:16 EST)

PURCHASER: Fouzia sultana
Fouzia sultana (Jan 12, 2023 15:19 EST)



Plans and specifications are subject to change without notice. E. & O. E. Actual usable floor space may vary from the stated floor area. All renderings are artist's concept.