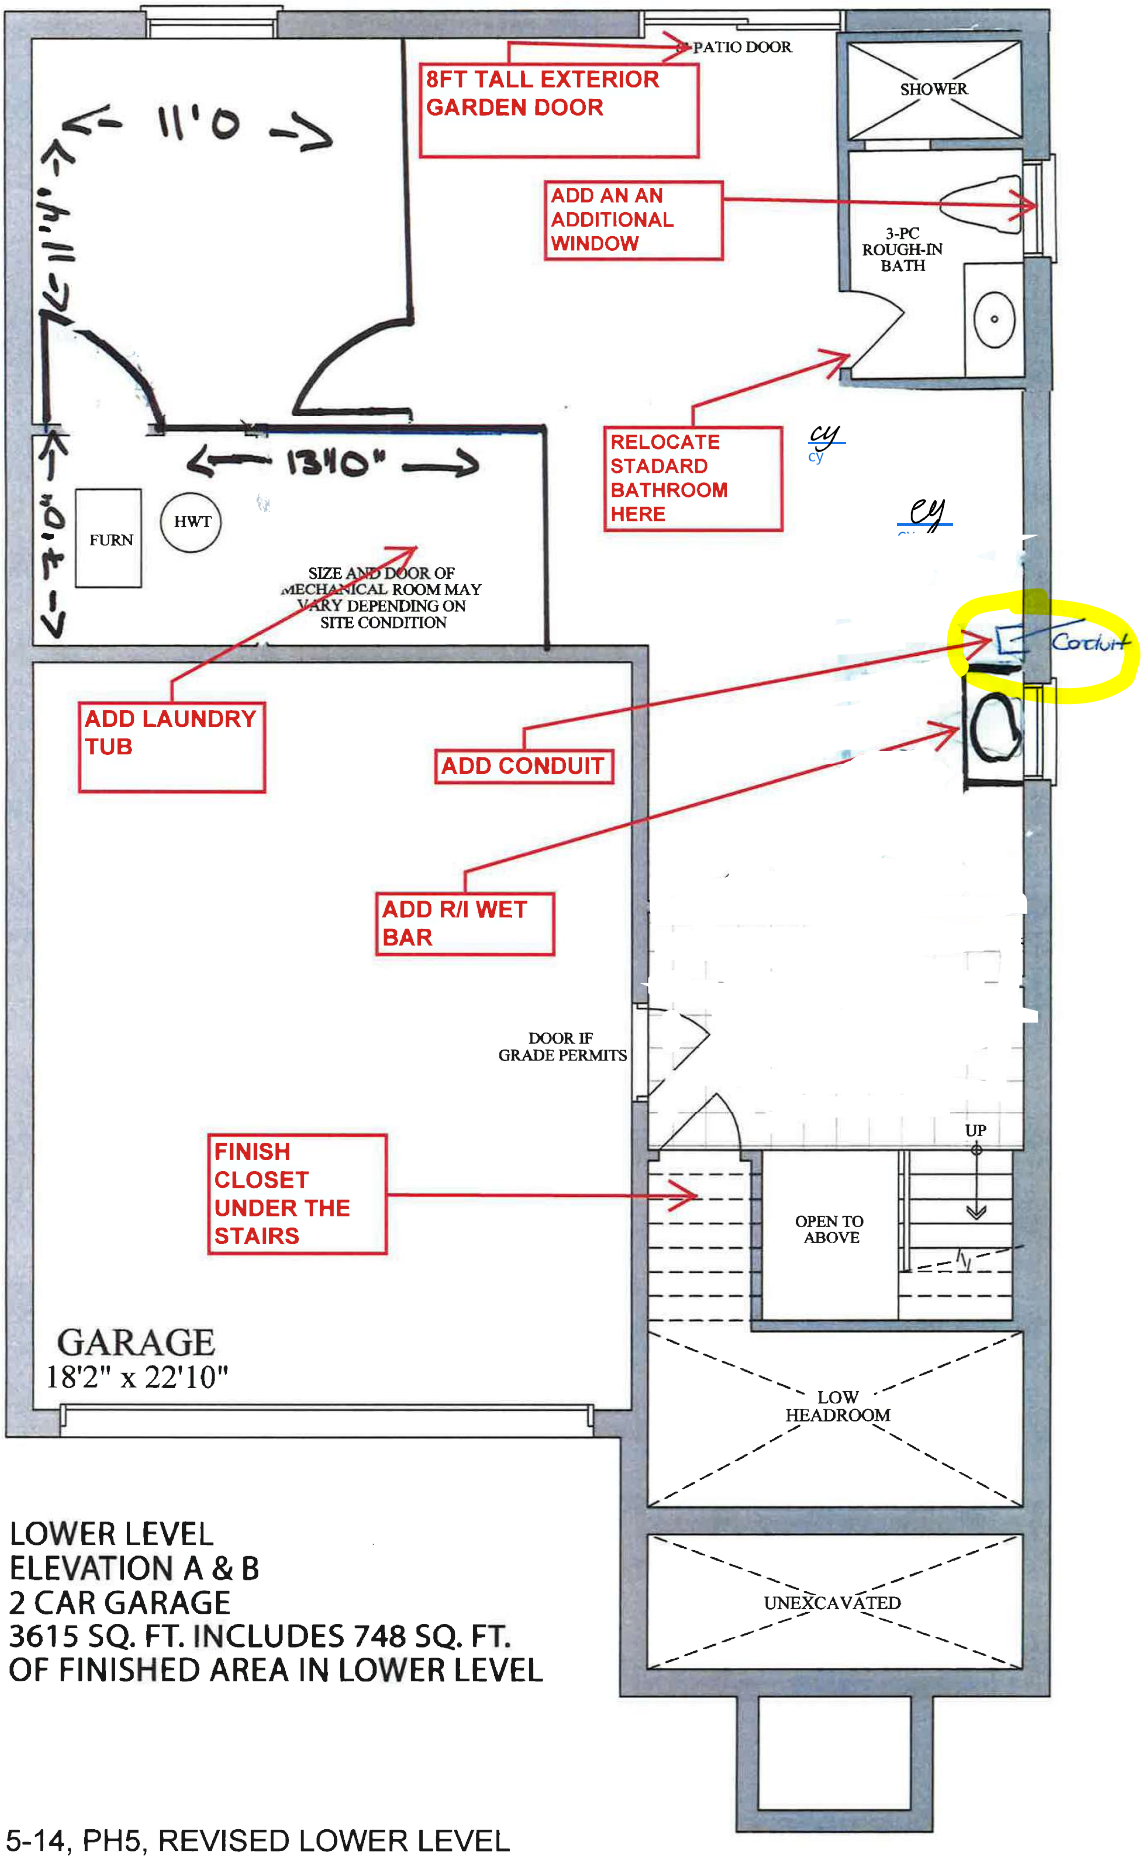

LOWER LEVEL
ELEVATION A & B
2 CAR GARAGE
3615 SQ. FT. INCLUDES 748 SQ. FT.
OF FINISHED AREA IN LOWER LEVEL

LOT 5-14, PH5, REVISED LOWER LEVEL

Candace Yenkanna (Jan 21, 2023 11:53 EST)

charles yenkanna
charles yenkanna (Jan 21, 2023 02:12 EST)