47' DESIGNS

The Madawaska / Elev. A & B

3190 sq.ft.

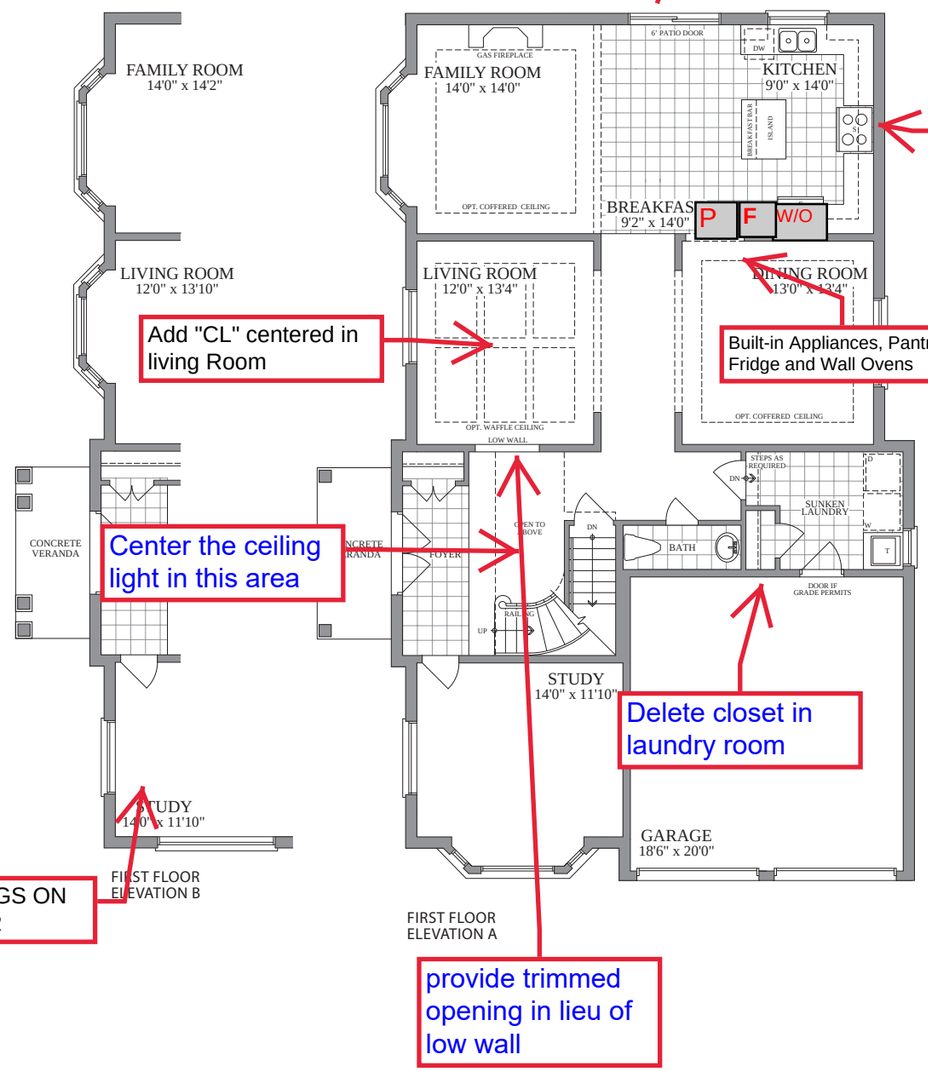

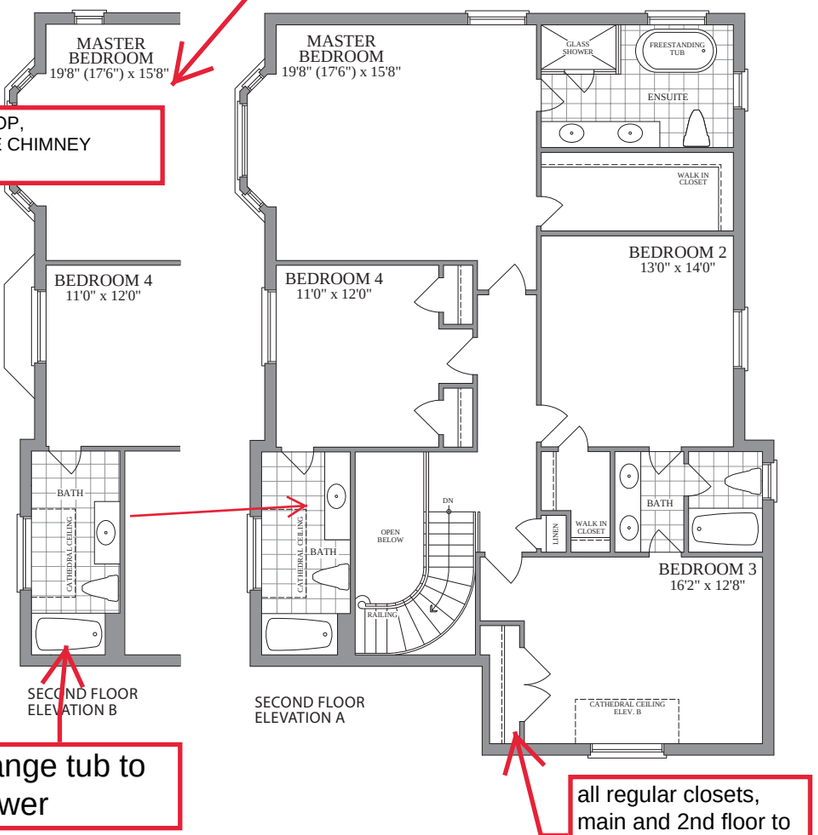

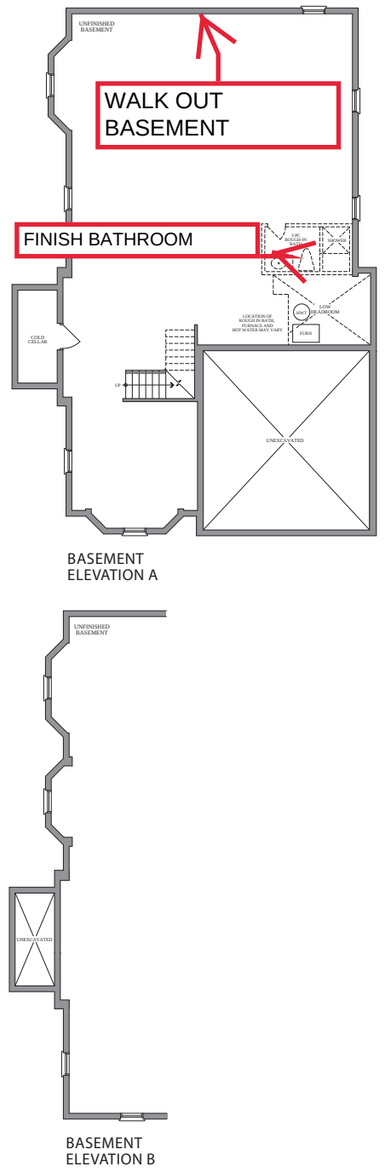

8ft tall exterior double doors

9FT CEILINGS ON 2ND FLOOR

COOKTOP, FUTURE CHIMNEY 8" VENT

Add "CL" centered in living Room

Built-in Appliances, Pantry, Fridge and Wall Ovens

Center the ceiling light in this area

Delete closet in laundry room

Change tub to shower

all regular closets, main and 2nd floor to receive light with auto switch (not linen)

10FT CEILINGS ON MAIN FLOOR

provide trimmed opening in lieu of low wall

LOT 5-24, PH5, INNISFIL, PE002 and PE005

PURCHASER:_____

PURCHASER:_____

the trails at CARSON'S CREEK

Plans and specifications are subject to change without notice. E. & O. E. Actual usable floor space may vary from the stated floor area. All renderings are artist's concept.