



LIBERTY

131B CARLAUREN RD., WOODBRIDGE, ONTARIO L4L 8A8

TEL: (905) 856-7678 • FAX: (905) 856-7379

www.libertycustomcabinetry.com

QUOTATION

DATE:


JOB NO.

TO: LORMEL

SHIP TO: INMISAL

TYPE OF CABINETS:	FINISH OF CABINETS:	HARDWARE:	COUNTERTOP: <u>✓</u>	INSTALLATION: ☐ WITH ☐ WITHOUT
HOUSE TYPE:	REMARKS:			

5-7

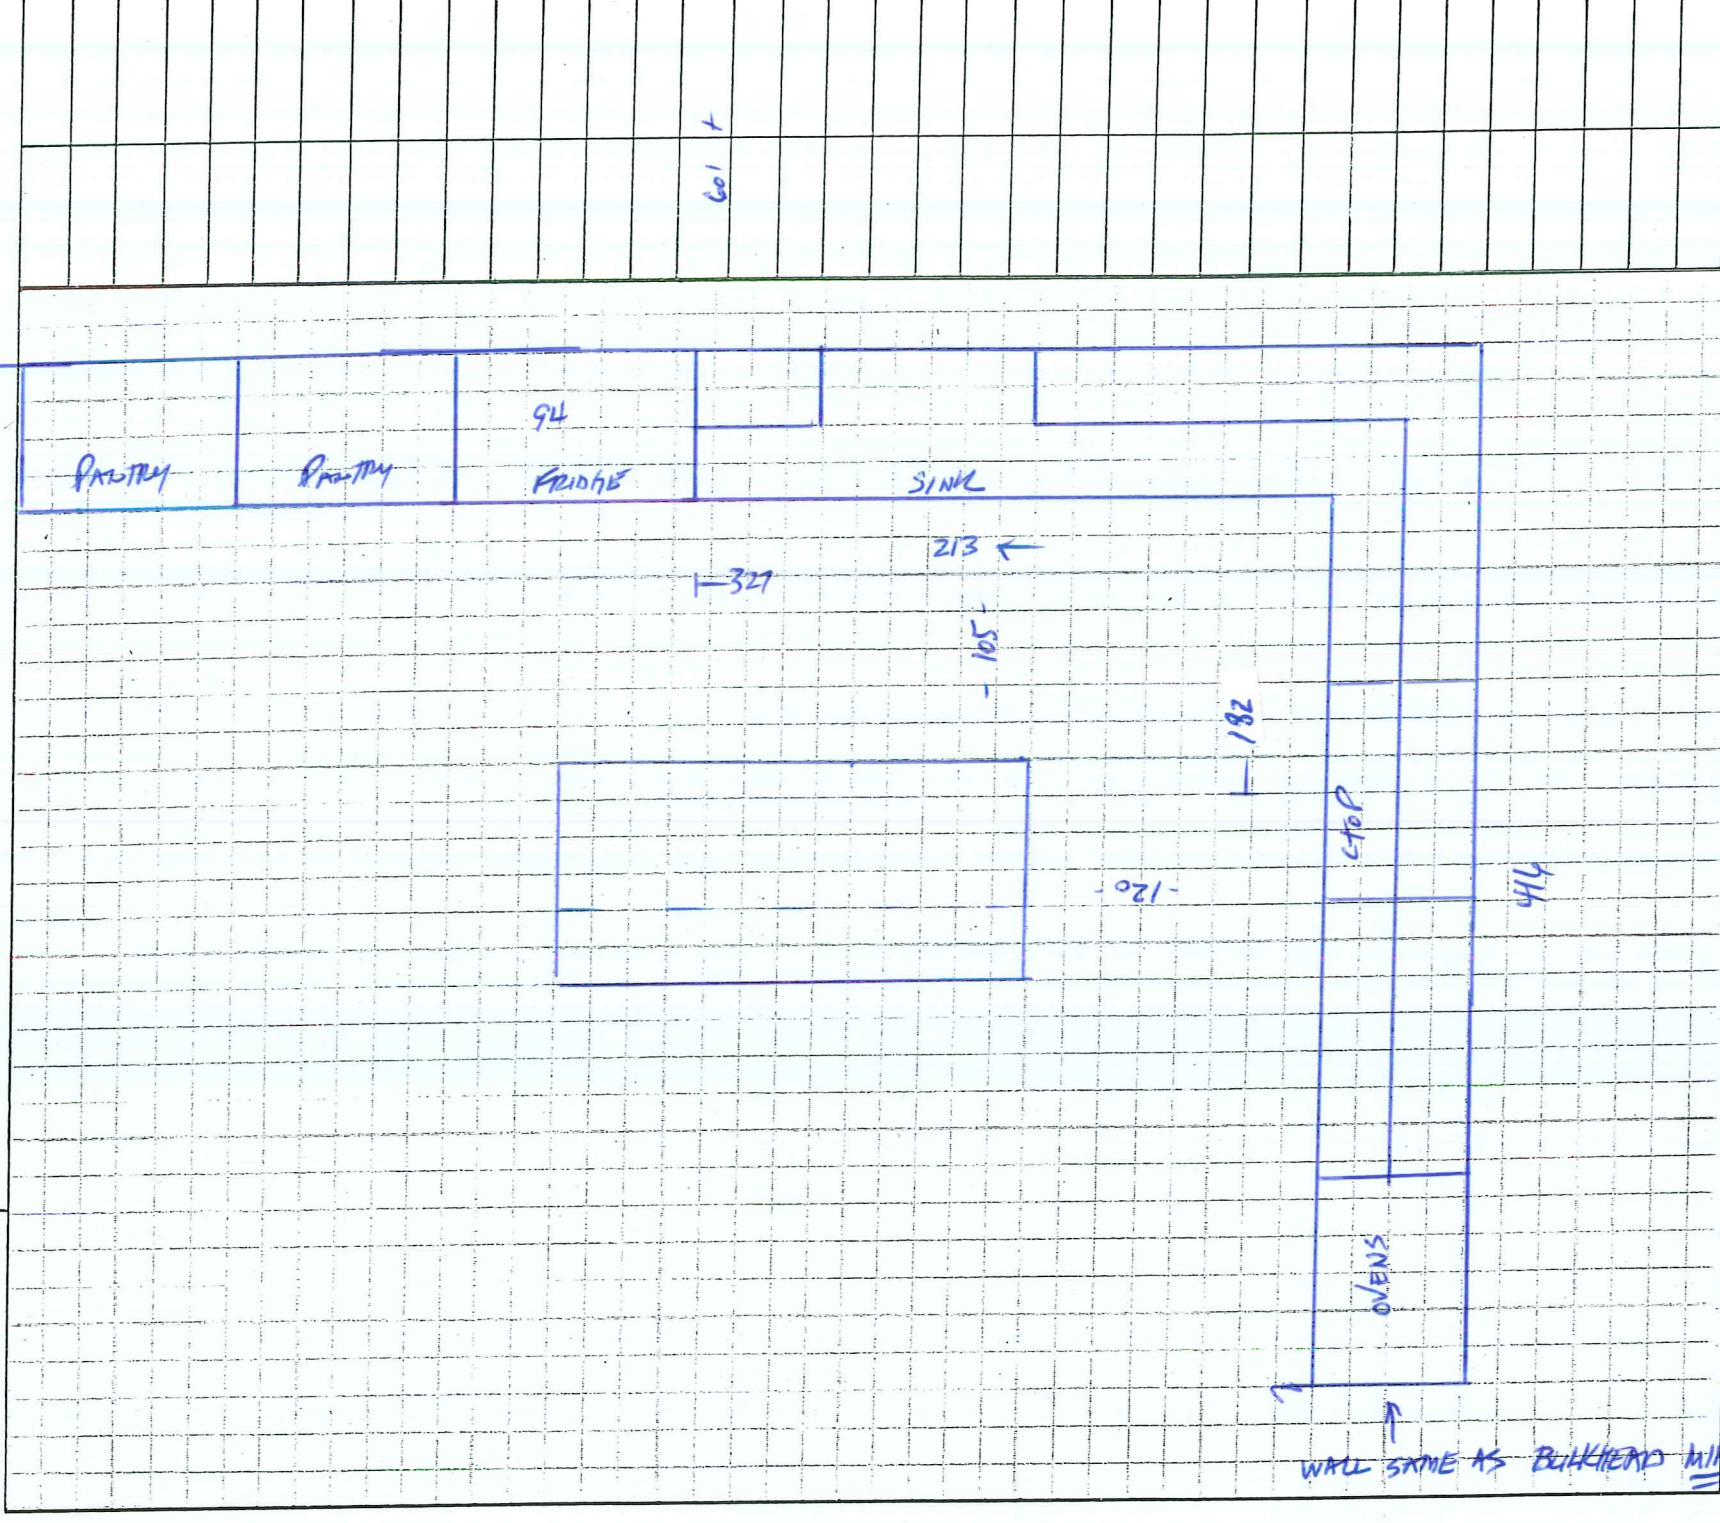

All prices subject to confirmation from head office. Goods delivered shall be checked and inspected on delivery. We shall not be responsible for any claims or complaints after this inspection.

All agreements are contingent upon strikes, accidents, and delays beyond our control. Please provide our installer with template for sinkholes or \$100.00 will be charged for callback.

ACCEPTED DATE:

TERMS:

LAYOUT THOROUGHLY EXPLAINED AND FULLY UNDERSTOOD

TOTAL \$

CUSTOMER SIGNATURE

SALESMAN'S SIGNATURE