
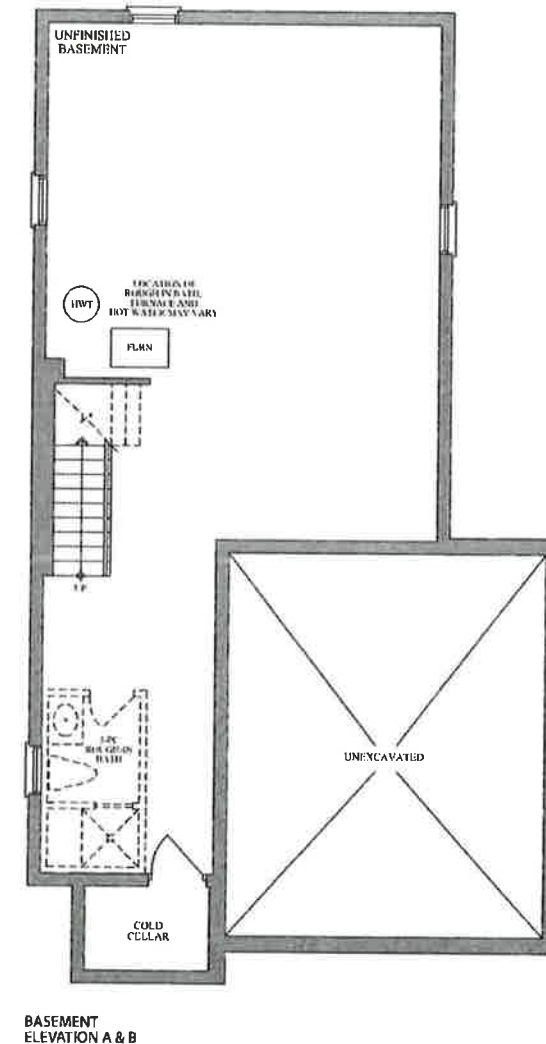


38'
DESIGNS

The Buckhorn / Elev. A & B
1800 sq.ft.

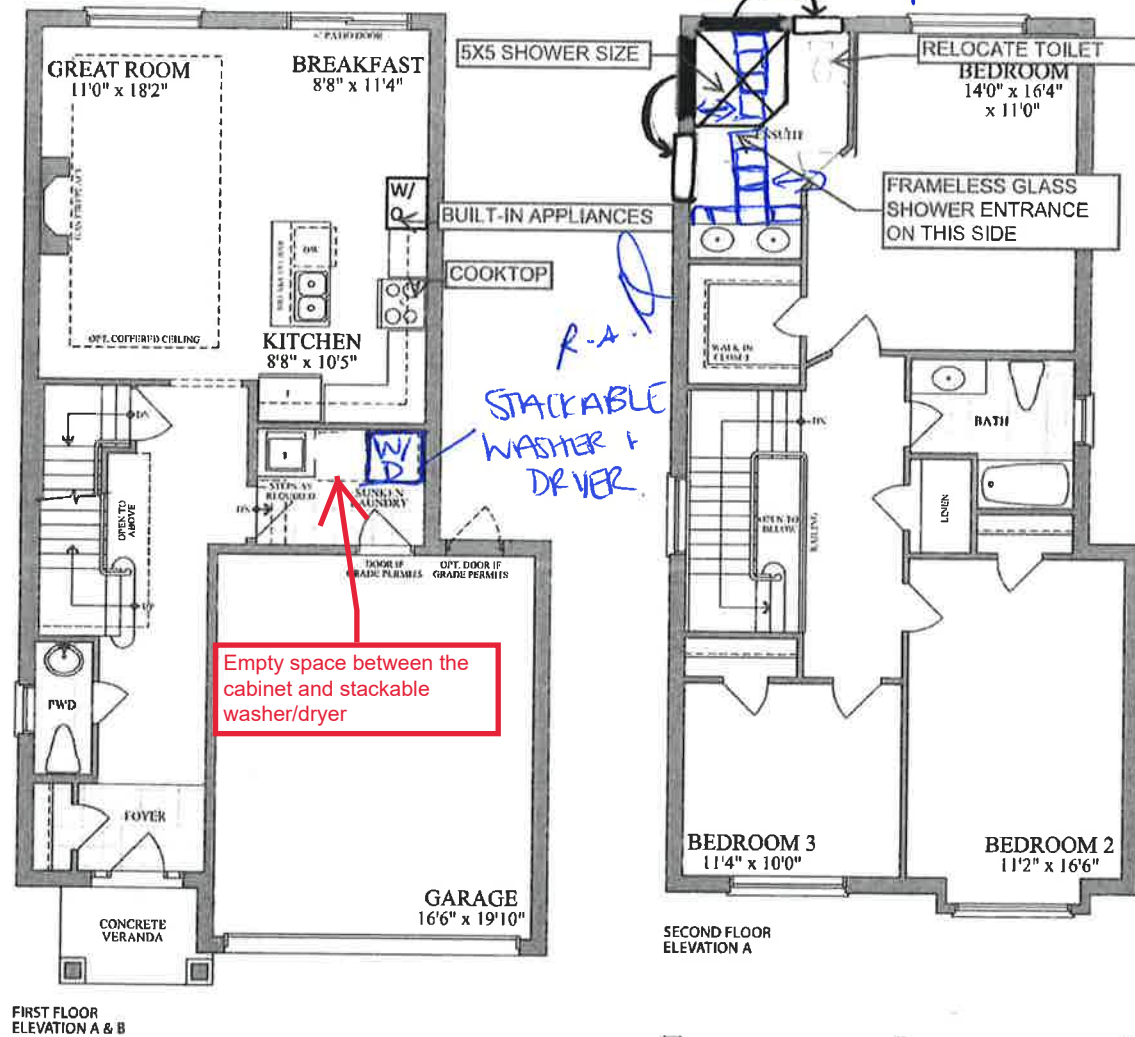

LOT 5-11
PURCHASER: Rob Agnew (May 10, 2022 11:46 EDT)

PURCHASER: nania orpha (May 10, 2022 17:39 EDT)



Plans and specifications are subject to change without notice. © 2011 E. Actual usable floor space may vary from the stated floor area.

floor area. All renderings are artist's concept.