

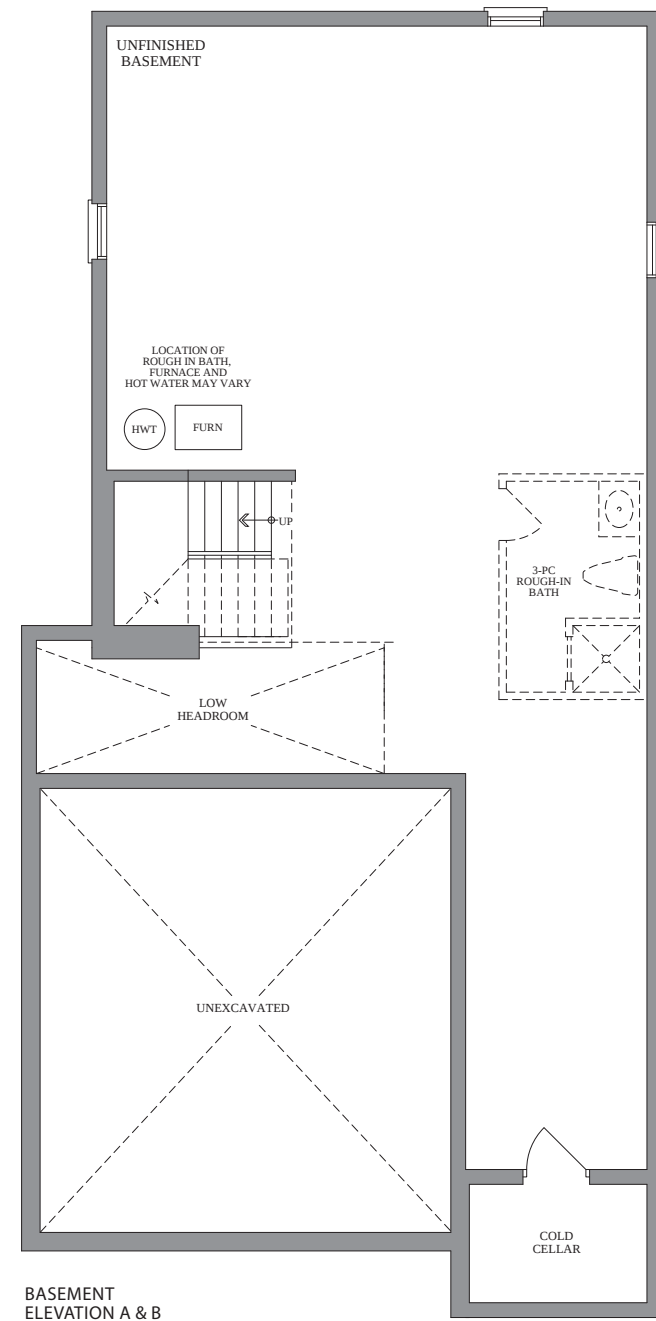


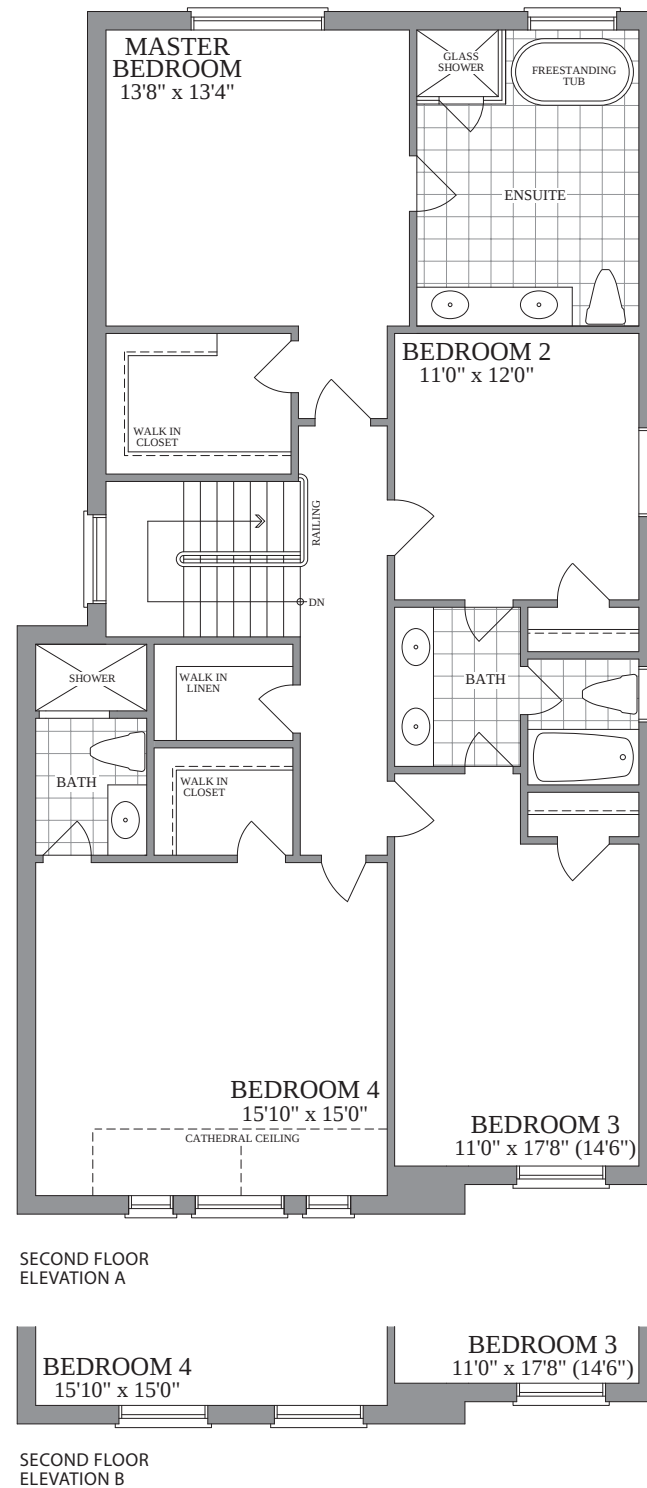

From: [Sohail Munir](#)
To: [Luana Casale](#)
Cc: [Lormel Homes - Design Studio](#); [Melanie Tan](#)
Subject: Re: LOT 5-36, PH5, REVISED FINLAY FLOOR PLAN - LAUNDRY ROOM
Date: Sunday, April 16, 2023 11:42:25 PM
Attachments: [image005.png](#)
[image006.png](#)
[image007.png](#)
[image008.png](#)

Please proceed with the new suggested location.

Thankyou!!!!

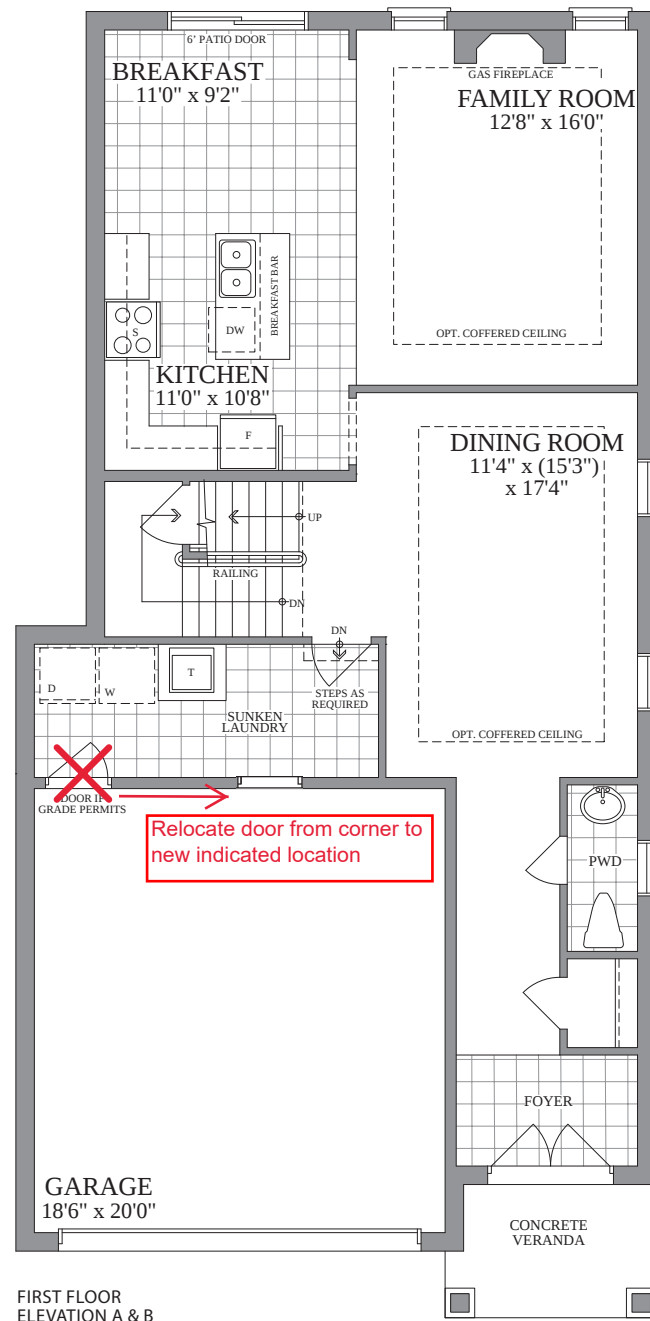


Sohail Munir
Salesperson

☐ 416-567-5590 ☐ 905-470-9800

☐ sohailmrealtor@gmail.com

☐ www.munirhomes.com

 

On Thu, Apr 13, 2023 at 5:22 PM Luana Casale <luana@lormelhomes.com> wrote:

Good afternoon, I hope this email finds you well.

Please see attachment to view a copy of your floorplan, specifically the laundry room

The plan has the door from the house to garage situated directly in front of the dryer. It seems however the spacing between the two may feel tight, especially when opening the dryer door and in the event the garage door opens.

Our construction team has suggested shifting the door to the garage as suggested the attached drawing. It's a good change and allows more space for dryer's door swing.

Please advise by email if you agree to make the switch to the suggested location or prefer to leave as per the original. We need to my Monday April 17th. If we do not hear back from you, then we will proceed with the standard layout and no further change will be accommodated afterwards.

Regards,



Luana Schiraldi

Sales, Marketing & Decor Manager

The Design Studio

331 Cityview Blvd., Unit 3

Vaughan, ON L4H 3M3

Tel: (905) 832-3326 (Ext 503) Fax:(905) 832-3327

luana@LormelHomes.com

www.LormelHomes.com



CONFIDENTIALITY NOTICE: This email message, including any attachments, is for the sole use of the intended recipient(s) and may contain confidential and privileged information. Any unauthorized review, use, disclosure or distribution is prohibited. If you are not the intended recipient, please reply to the sender by email and destroy all copies of the original message.